


① STA 65+87, 15.0' RT
 INSTALL
 1-12X8 TEE (FLGXFLG)
 2-12-INCH GV (FLGXMJ)
 1-8 INCH GV (FLGXMJ)
 THRUST BLOCK AS REQ'D


FILED
 Date: 3/19/2005 By: JLD
 This survey consists of:
 Map:
 Narrative:
 Corner Rpt:
 DOUGLAS COUNTY
 SURVEYOR

NOTE:
 FOR CLARITY, DRIVEWAYS ARE NOT SHOWN.
 CONTRACTOR TO COORDINATE w/OWNER
 FOR LOCATION & WIDTH.

CALL BEFORE YOU DIG 1
ONE CALL (800) 332-2344
 OAR 952-001-0010 THROUGH
 OAR 952-001-0090

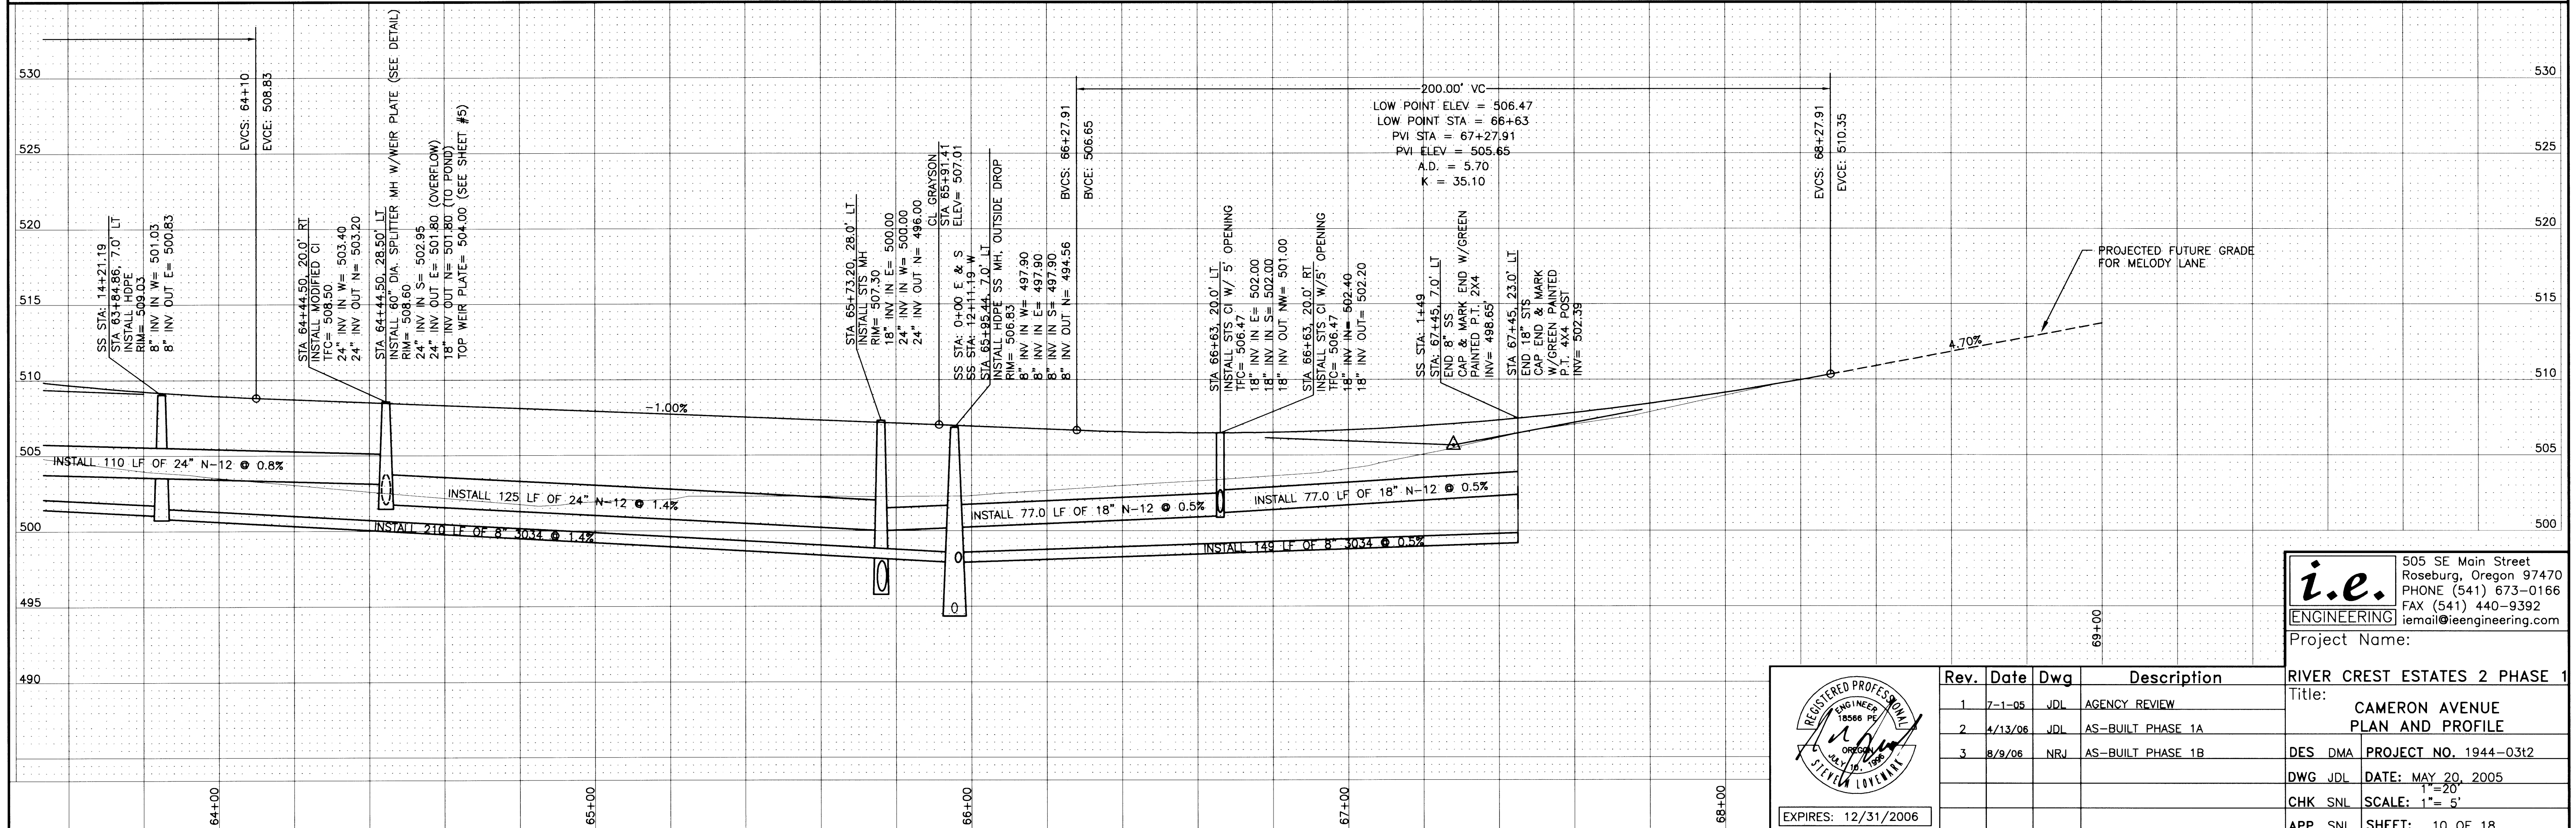

i.e. ENGINEERING
 505 SE Main Street
 Roseburg, Oregon 97470
 PHONE (541) 673-0166
 FAX (541) 440-9392
 iemail@ieengineering.com

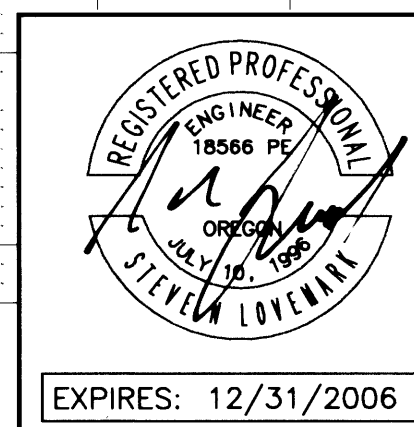

Rev.	Date	Dwg	Description
1	7-1-05	JDL	AGENCY REVIEW
2	4/13/06	JDL	AS-BUILT PHASE 1A
3	8/9/06	NRJ	AS-BUILT PHASE 1B

Project Name:
RIVER CREST ESTATES 2 PHASE 1
 Title:
**CAMERON AVENUE
 PLAN AND PROFILE**
 DES DMA PROJECT NO. 1944-0312
 DWG JDL DATE: MAY 20, 2005
 CHK SNL SCALE: 1" = 5'
 APP SNL SHEET: 10 OF 18

288BPPR2