
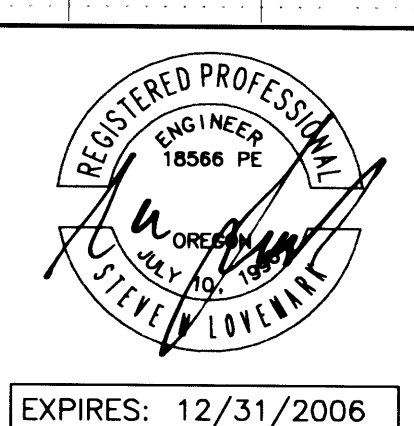


FILED
 Date: 3/19/2008 By: JF
 This survey consists of:
 Map:
 Narrative:
 Corner Rpt:
 DOUGLAS COUNTY
 SURVEYOR

NOTE:
 FOR CLARITY, DRIVEWAYS ARE NOT SHOWN. S,
 CONTRACTOR TO COORDINATE W/OWNER
 FOR LOCATION & WIDTH.

CALL BEFORE YOU DIG I
 ONE CALL: (800) 332-2344
 OAR 952-001-0010 THROUGH
 OAR 952-001-0090

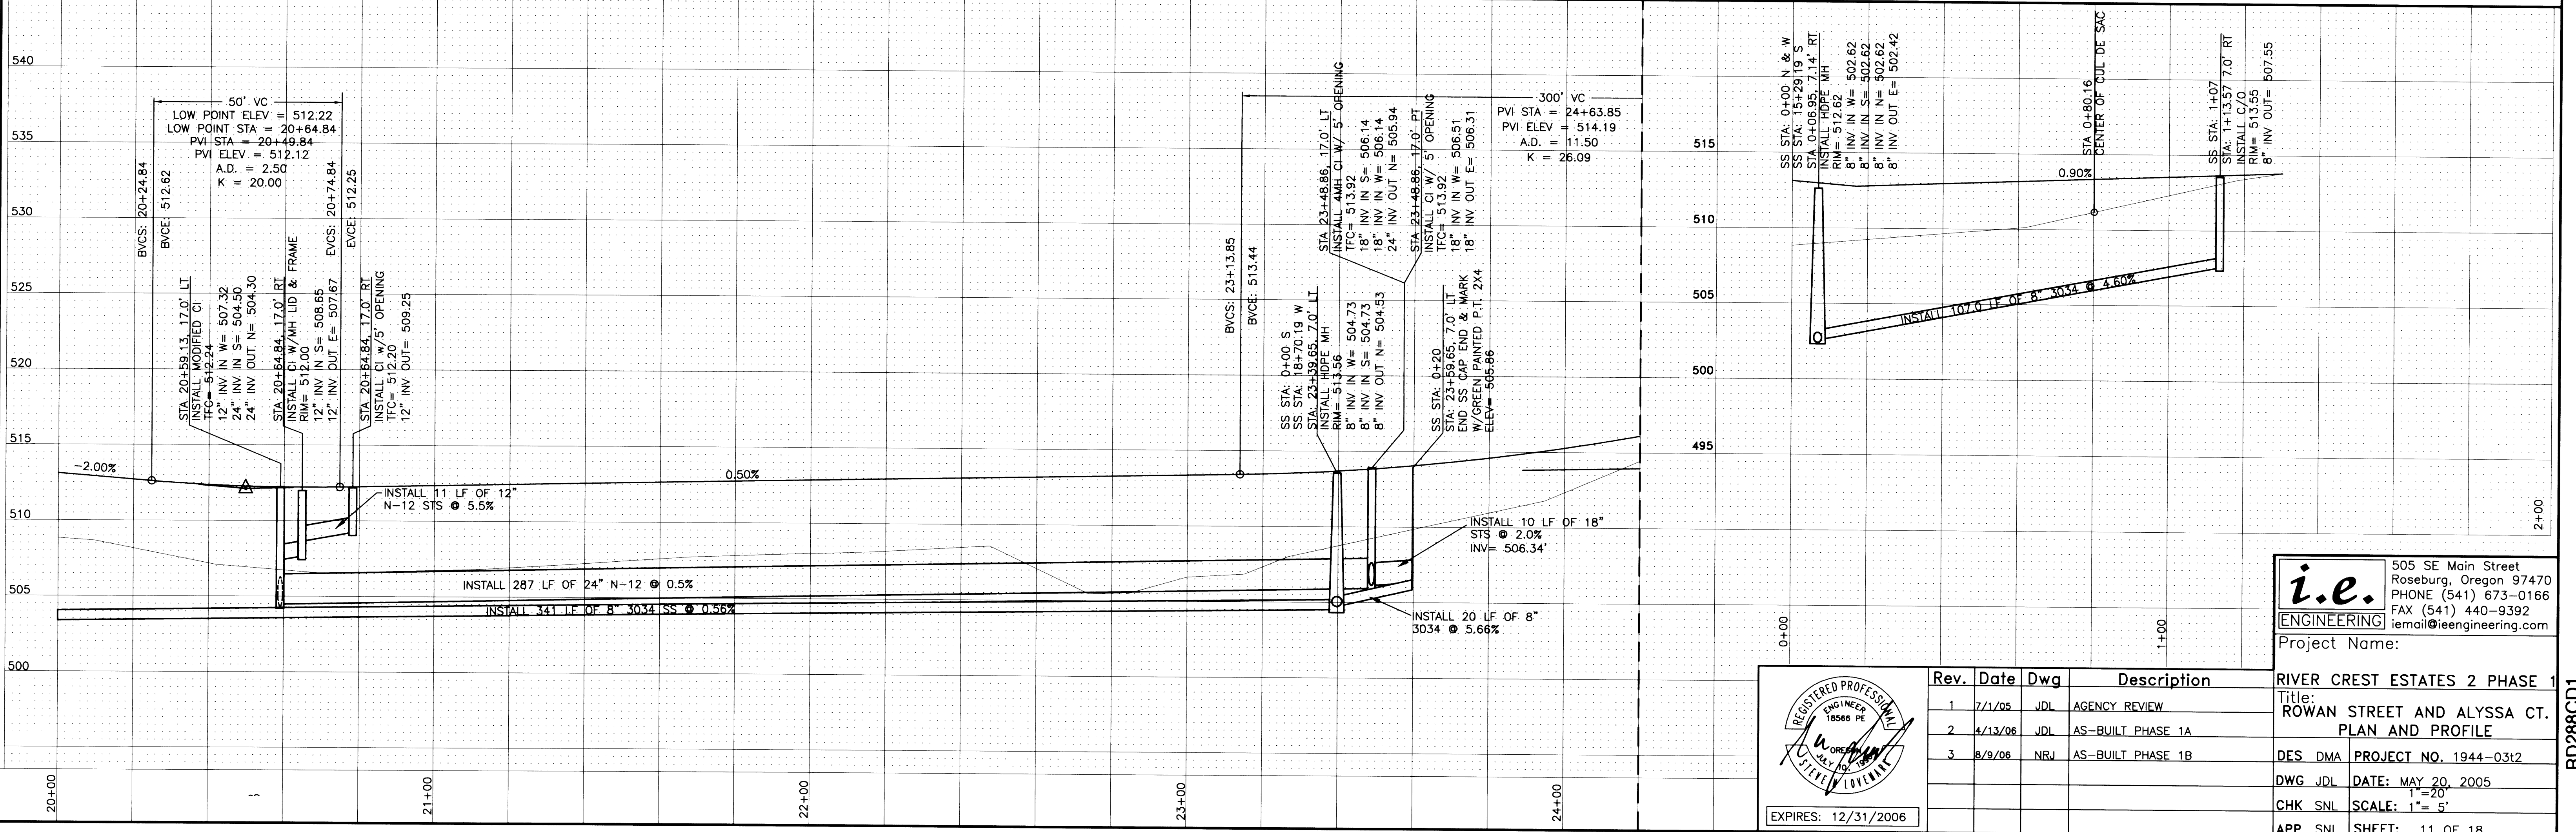

Rev.	Date	Dwg	Description
1	7/1/05	JDL	AGENCY REVIEW
2	4/13/06	JDL	AS-BUILT PHASE 1A
3	8/9/06	NRJ	AS-BUILT PHASE 1B

i.e.
 ENGINEERING
 Project Name: RIVER CREST ESTATES 2 PHASE 1
 Title: ROWAN STREET AND ALYSSA CT.
 PLAN AND PROFILE
 DES. DMA PROJECT NO. 1944-0312
 DWG JDL DATE: MAY 20, 2005
 1"=20'
 CHK SNL SCALE: 1"=5'
 APP SNL SHEET: 11 OF 18

CO. RD. # 288C & 288D

CO. RD. 288C & 288D PLAN & PROFILE

RD288CD1

DO NOT DUPLICATE