


FILED
Date: 3/19/2008 By: J.P.
This Survey consists of:
Map _____
Narrative _____
Corner Rpt. _____
DOUGLAS COUNTY
SURVEYOR

HATCH KEY
PHASE 1A

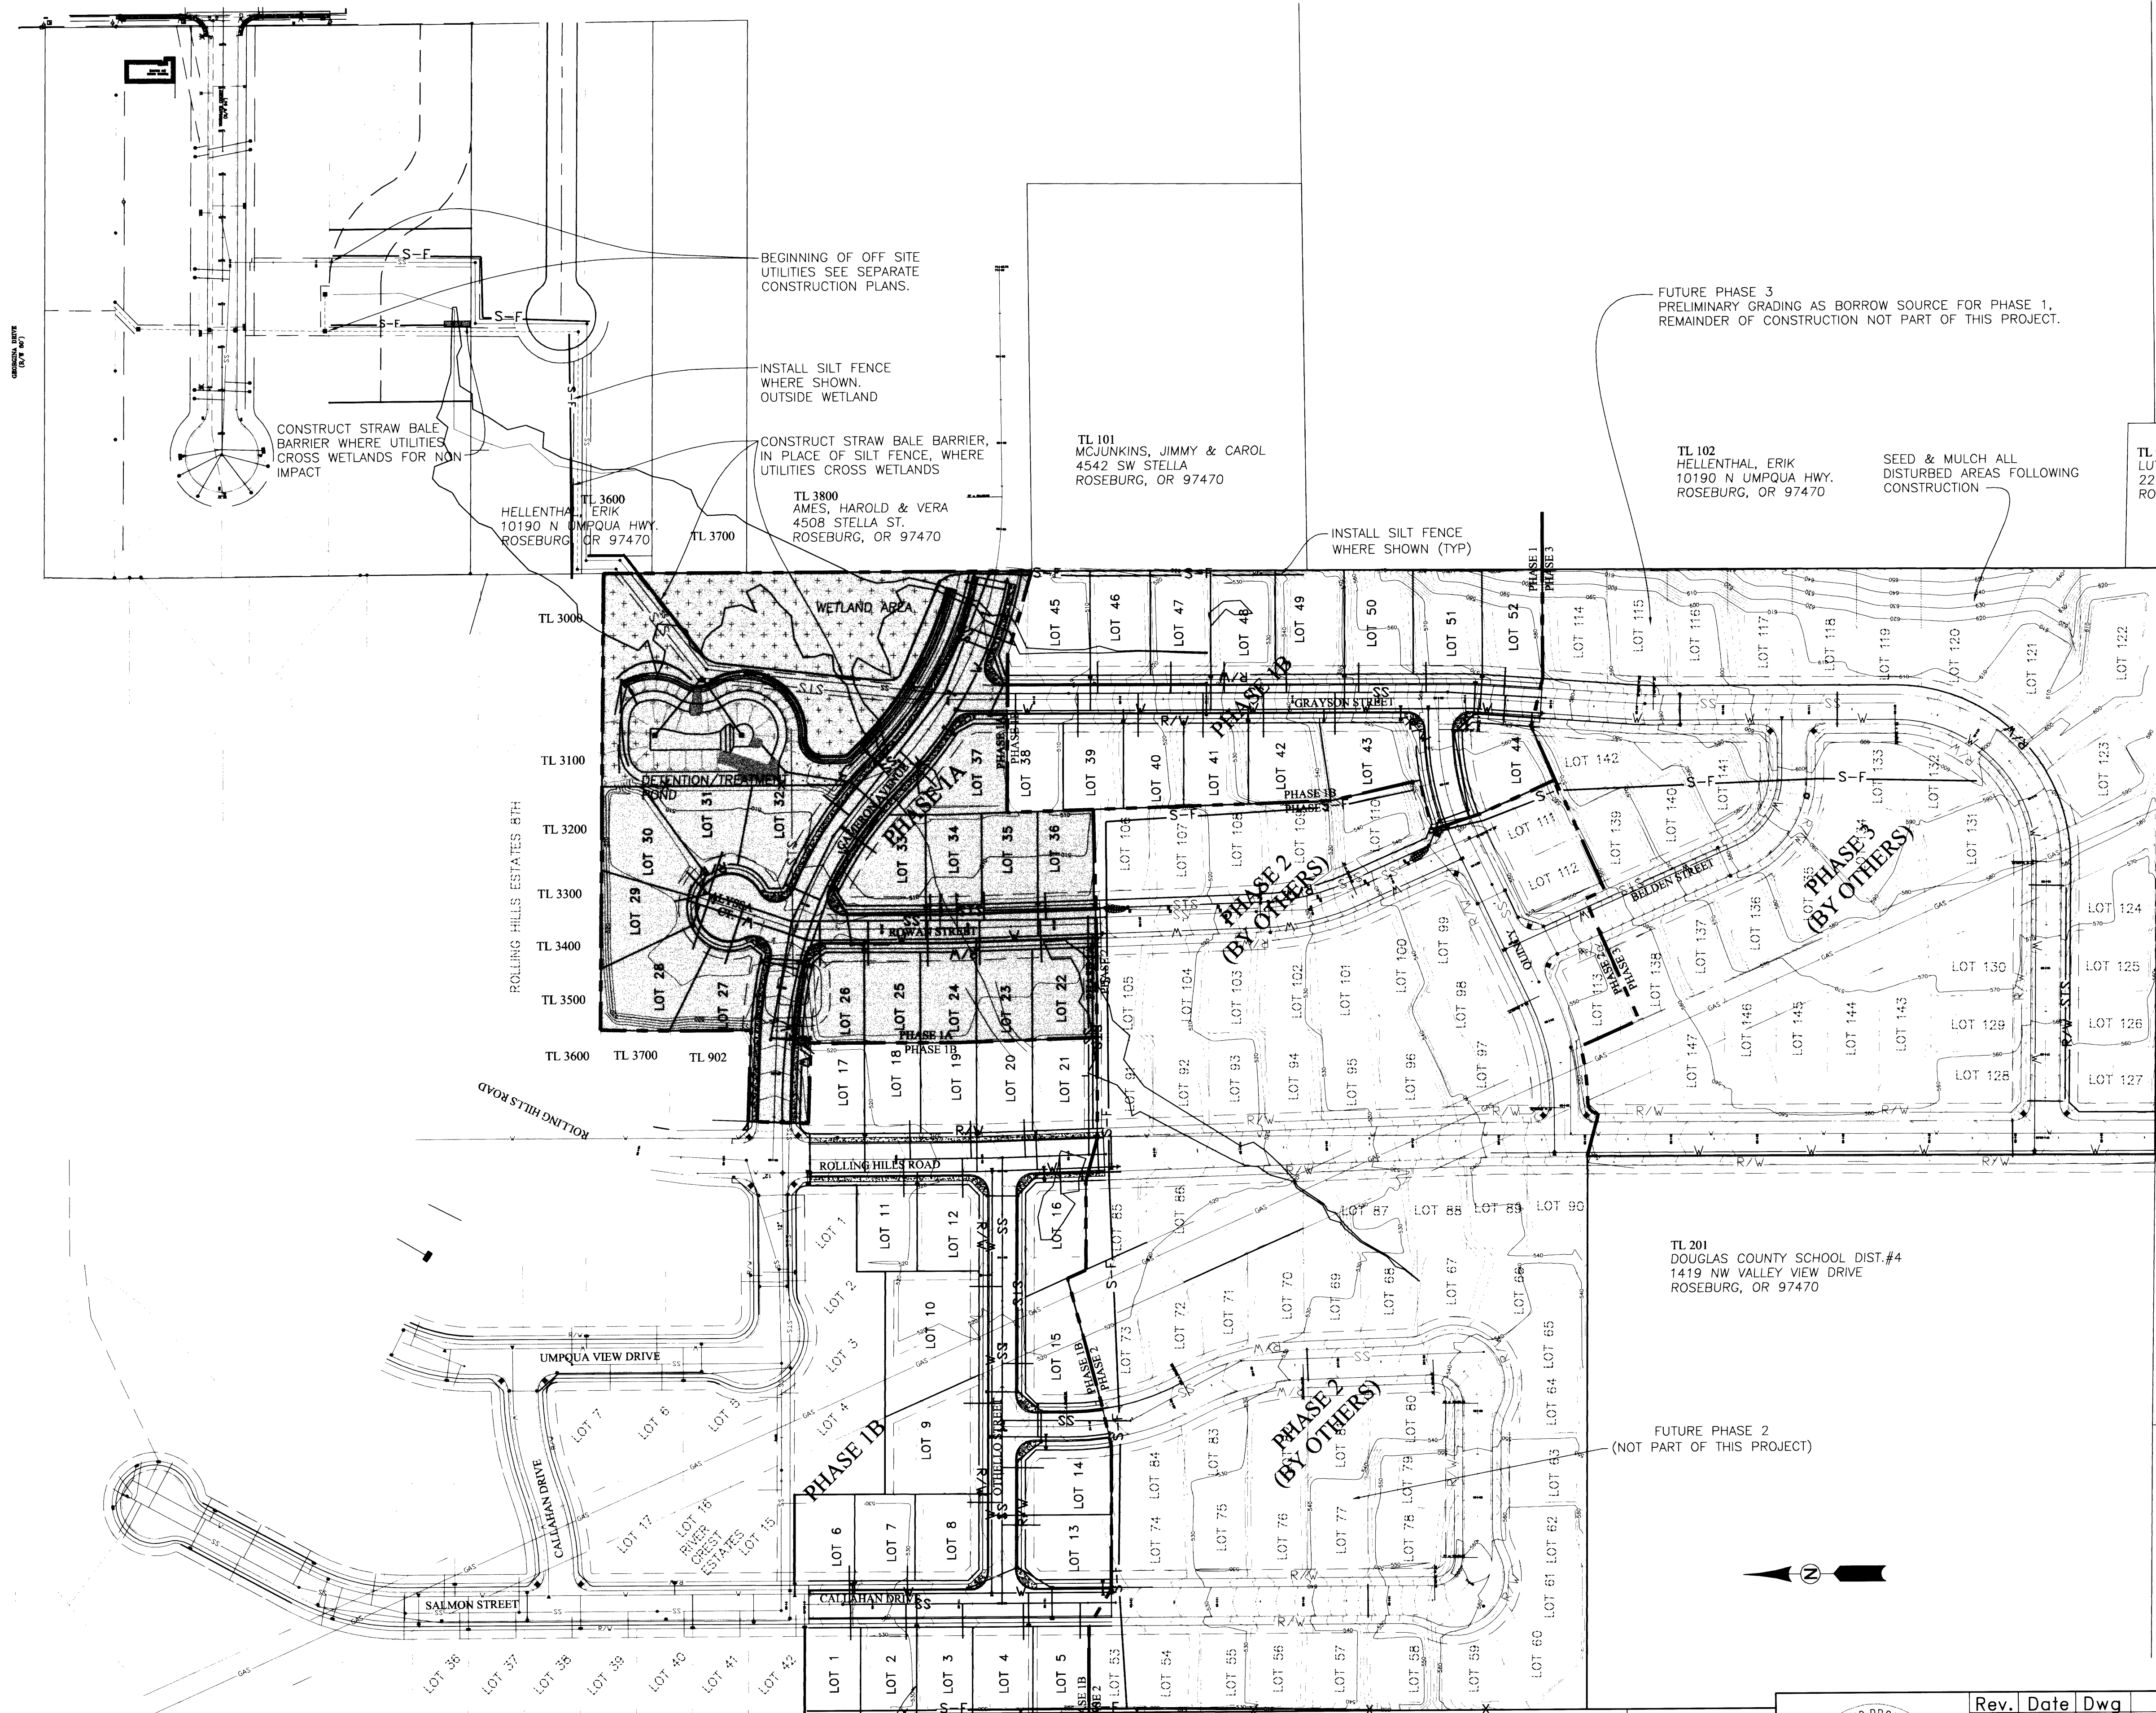

TL 100
BODFIELD, ARLENE
2548 SW LANDERS LN.
ROSEBURG, OR 97470

TL 4800
CALKINS, GARY & KATHRYN
14229 SPANAWAY LOOP RD.
TACOMA, WA 98444

TL 301
DOUGLAS COUNTY SCHOOL DIST.#4
1419 NW VALLEY VIEW DRIVE
ROSEBURG, OR 97470


TL 401
DOUGLAS COUNTY SCHOOL DIST.#4
1419 NW VALLEY VIEW DRIVE
ROSEBURG, OR 97470

CALL BEFORE YOU DIG 1
ONE CALL (800) 332-2344
OAR 952-001-0010 THROUGH
OAR 952-001-0090

i.e.
ENGINEERING
505 SE Main Street
Roseburg, Oregon 97470
PHONE (541) 673-0166
FAX (541) 440-9392
iermail@ieengineering.com

Rev.		Date	Dwg	Description
1	7/1/05	JDL	AGENCY REVIEW	
2	4/13/06	JDL	AS-BUILT PHASE 1A	
3	8/9/06	NRJ	AS-BUILT PHASE 1B	

Project Name:	RIVER CREST ESTATES 2 PHASE 1
Title:	PHASE 1, 2, & 3 FG CONTOURS & EROSION CONTROL
DES DMA	PROJECT NO. 1944-0312
DWG JDL	DATE: MAY 20, 2005
CHK SNL	SCALE: AS SHOWN
APP SNL	SHEET: 3 OF 18

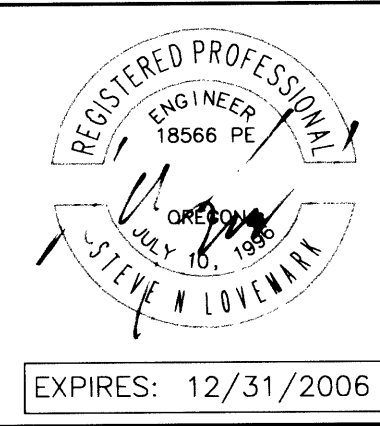

TL 300
SCEVERS, RONNIE
4620 SE HOLEGATE
ROSEBURG, OR 97470

TL 700
WPI #4 LLC
4610 HOLEGATE
ROSEBURG, OR 97470

TL 402
WPI #4 LLC
4610 HOLEGATE ST.
ROSEBURG, OR 97470

Co. Rd. # 366, 375J, 375N, 375O, 288B, 288C, 288D

F.G. CONTOURS & EROSION CONTROL CO. RDS.
366 375J 375N 375O 288B 288C 288D

375288ER