

FILED  
 Date: 10/13/2008  
 This survey was made by:  
 Map:  
 Narrative:  
 Corner Rpt:  
 DOUGLAS COUNTY  
 SURVEYOR


W R G  
 DESIGN INC  
 5415 SW Westgate Dr, Ste 100 Portland, OR 97221  
 Tel: 503.419.2500 Fax: 503.419.2800  
 PLANNERS • ENGINEERS • LANDSCAPE ARCHITECTS • SURVEYORS

ROWAN DR. STORM PLAN STA 22+53.85 - 27+94.89  
 RIVER CREST ESTATES 2 - PHASE 2  
 HAYDEN HOMES  
 Green District, Oregon

AS-BUILT  
 BASED ON CHANGES IDENTIFIED DURING CONSTRUCTION AS OF 3/7/08



DATE: 10/12/08  
 DRAWN: MDB  
 DESIGNED: MDB  
 CHECKED: KBR  
 PROJECT #: HAYDEN0800  
 SHEET TITLE: ROWAN STORM PLAN  
 SHEET NUMBER: C224  
 OF 4 SHEETS

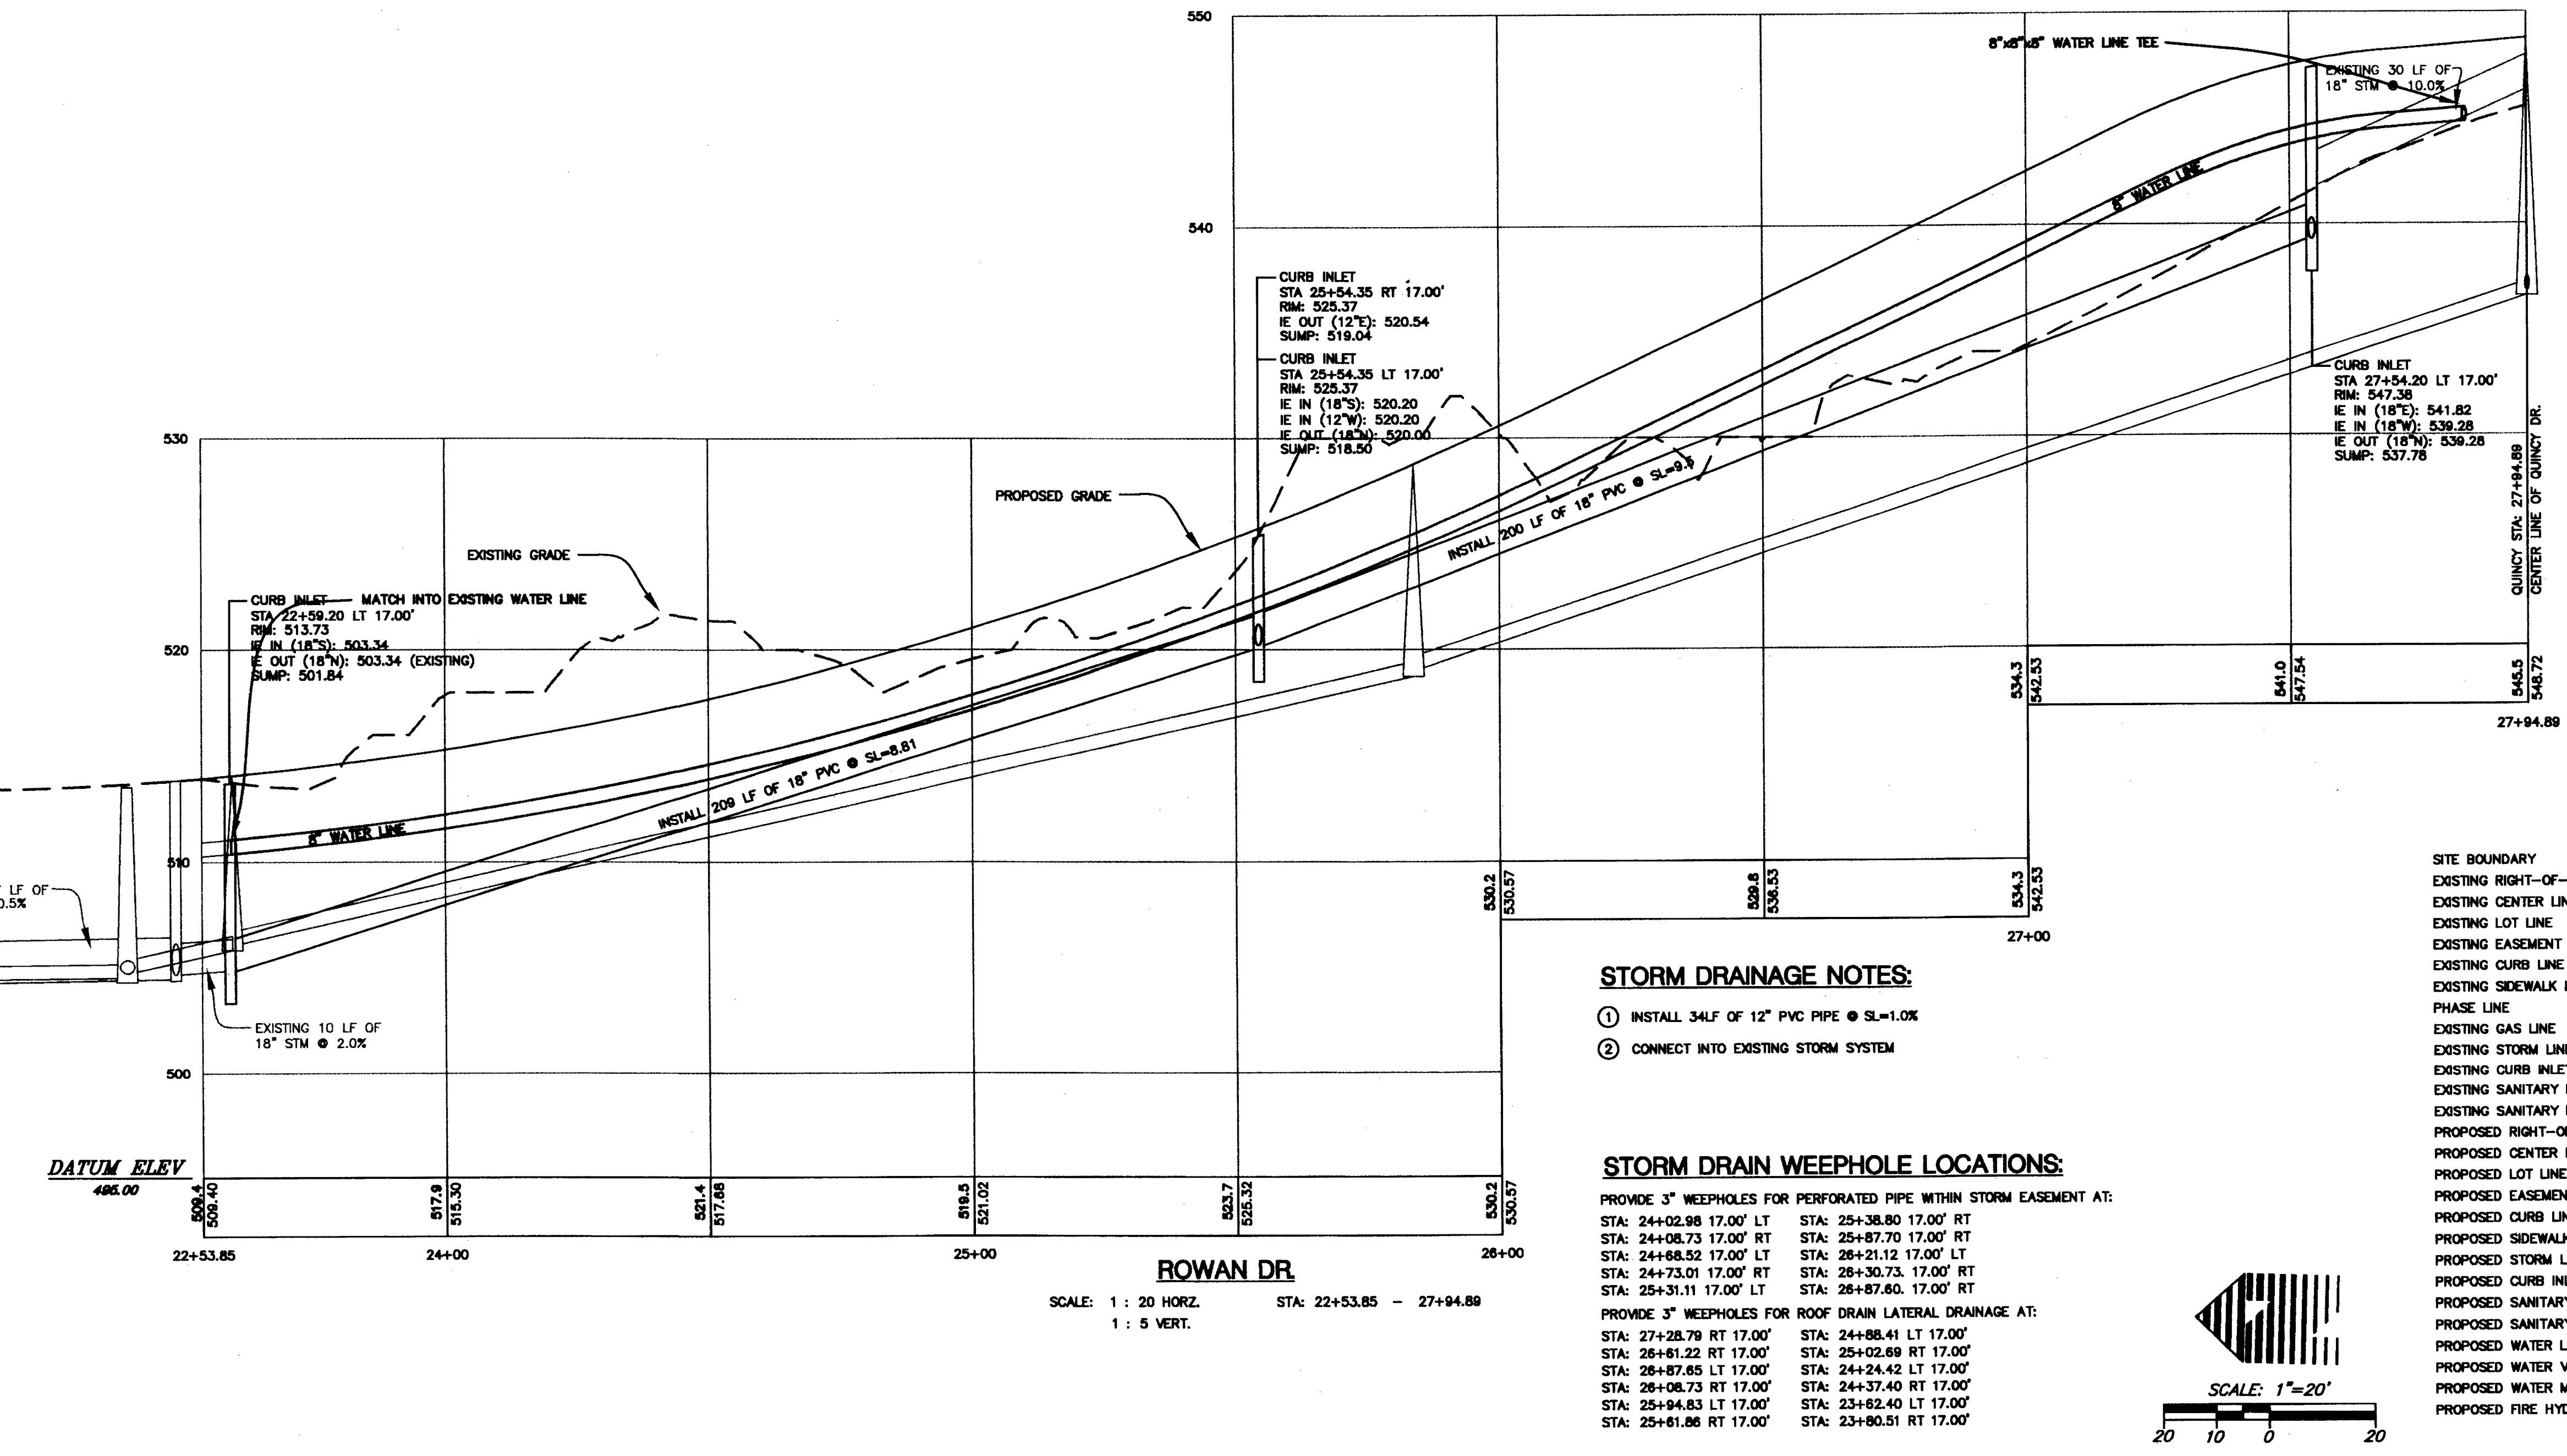

Co. Rd. # 288D MP 0.07 - 0.17

CO. RD. 288D

SS288D07