




DOUGLAS COUNTY OREGON AS CONSTRUCTED GRADING & SURFACING CLOVER LANE #294

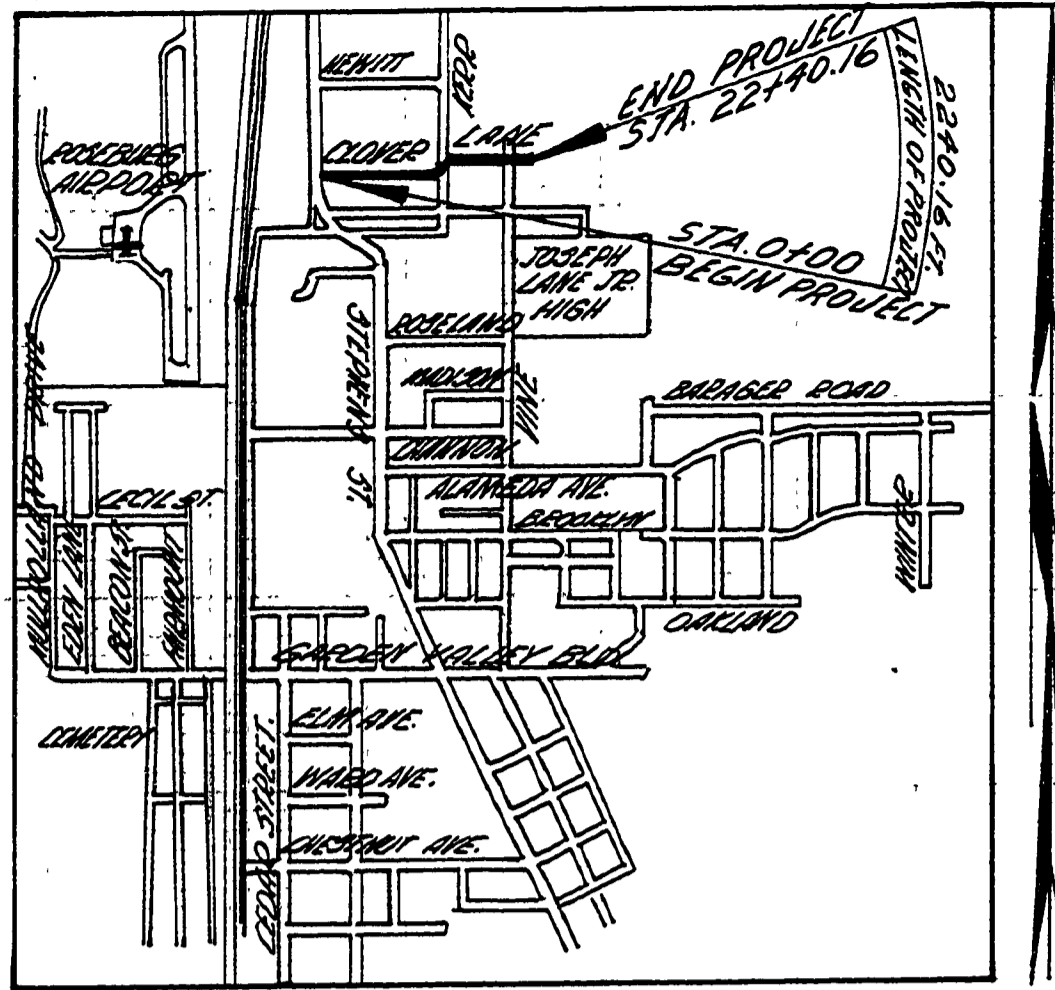

VICINITY MAP
NORTH ROSEBURG

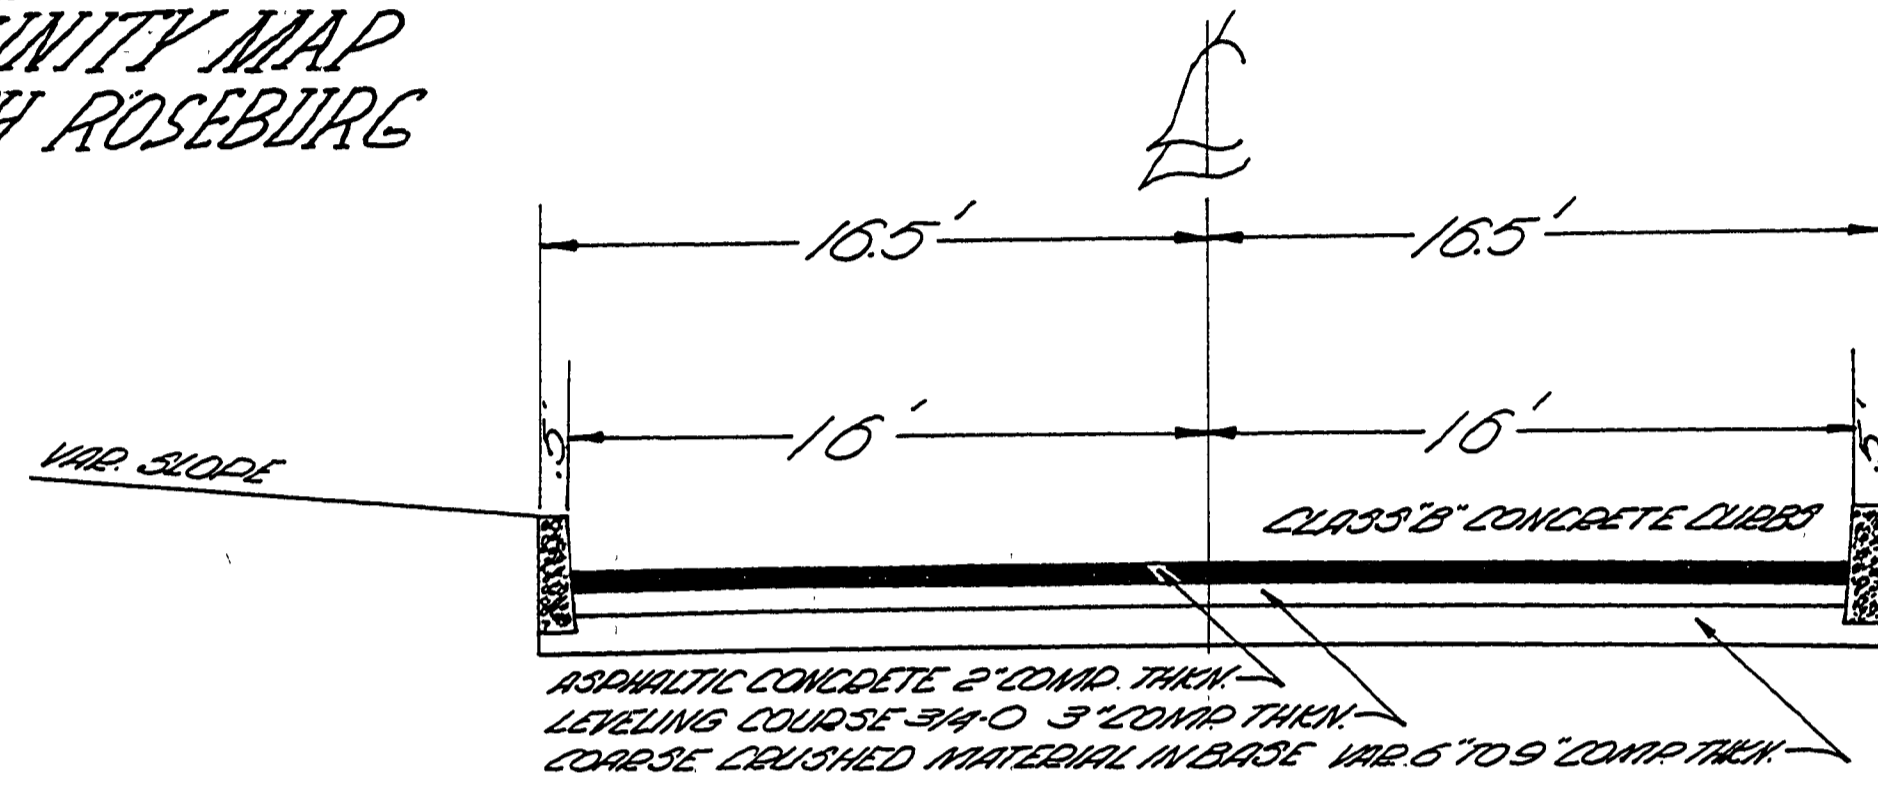

TYPICAL SECTION

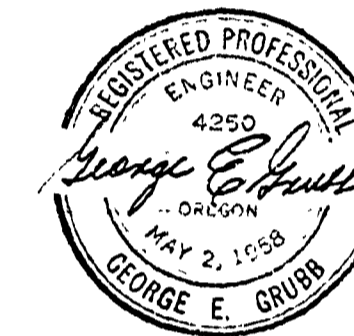

APPROVED BY DOUGLAS COUNTY
BOARD OF COMMISSIONERS THIS
28th DAY OF March 1967

Stanford Buell
Commissioner

Paul D. ...
Commissioner

Ray E. ...
Commissioner

George E. Grubb 3/28/67
County Engineer Date

FILED
RECEIVED

MAR 29 1967

COUNTY SURVEYOR
DOUGLAS COUNTY, ORE.

SHEET 1 OF 3

00000040