




TYPICAL SECTION
STA. L 9+50.00 TO STA. L 20+50.00
STA. L 20+50.00 TO STA. L 22+41.74, TAPER SECTION
STA. C 5+00.00 TO STA. C 7+45.10, INTERSECTION

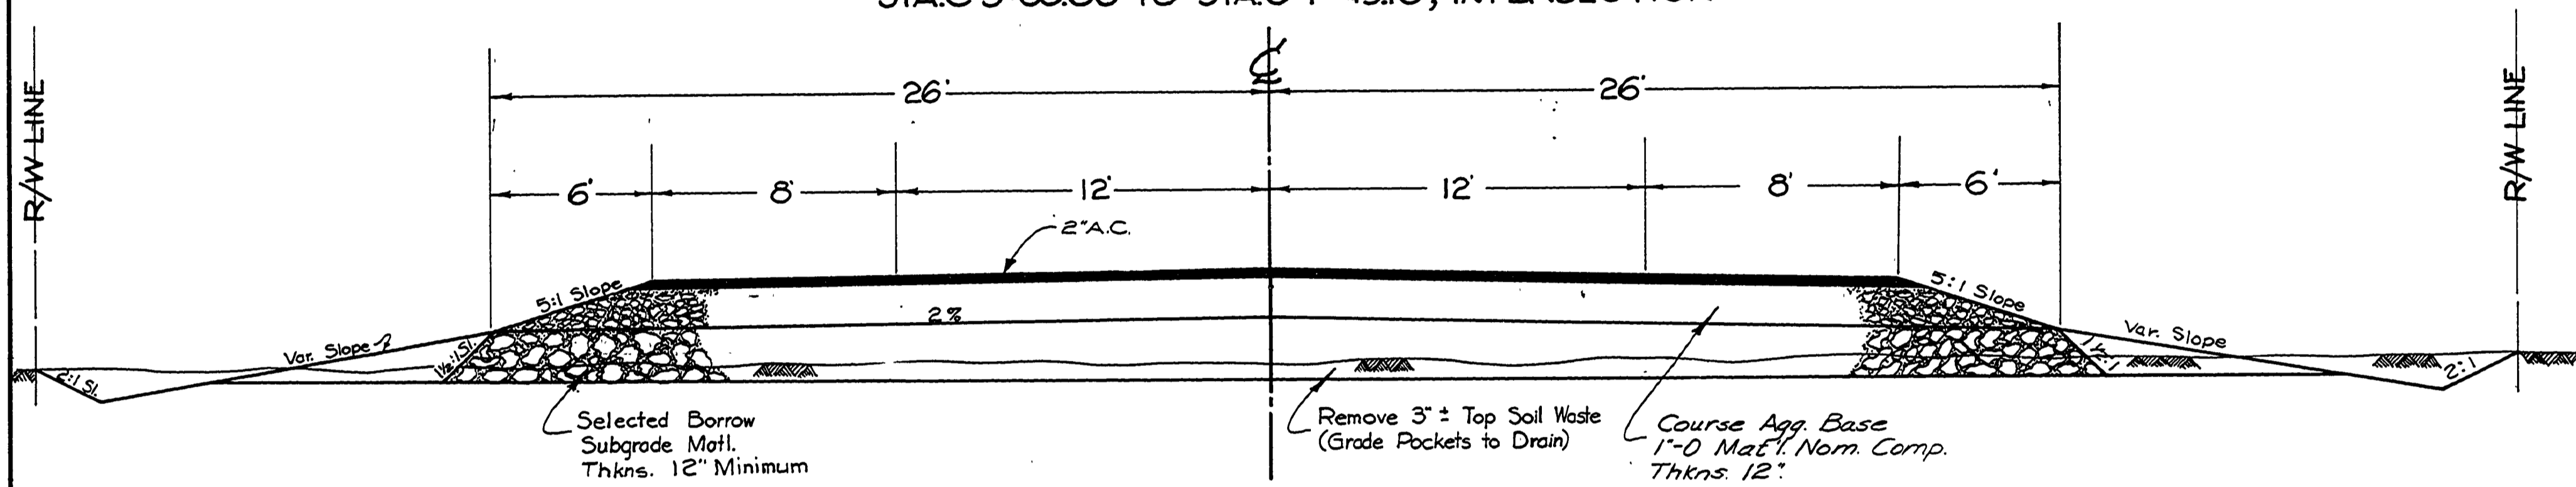

TYPICAL SECTION
STA. L 22+41.74 TO STA. L 53+00.00
STA. L 53+00.00 TO STA. L 58+25 SPECIAL DITCH RT. ONLY

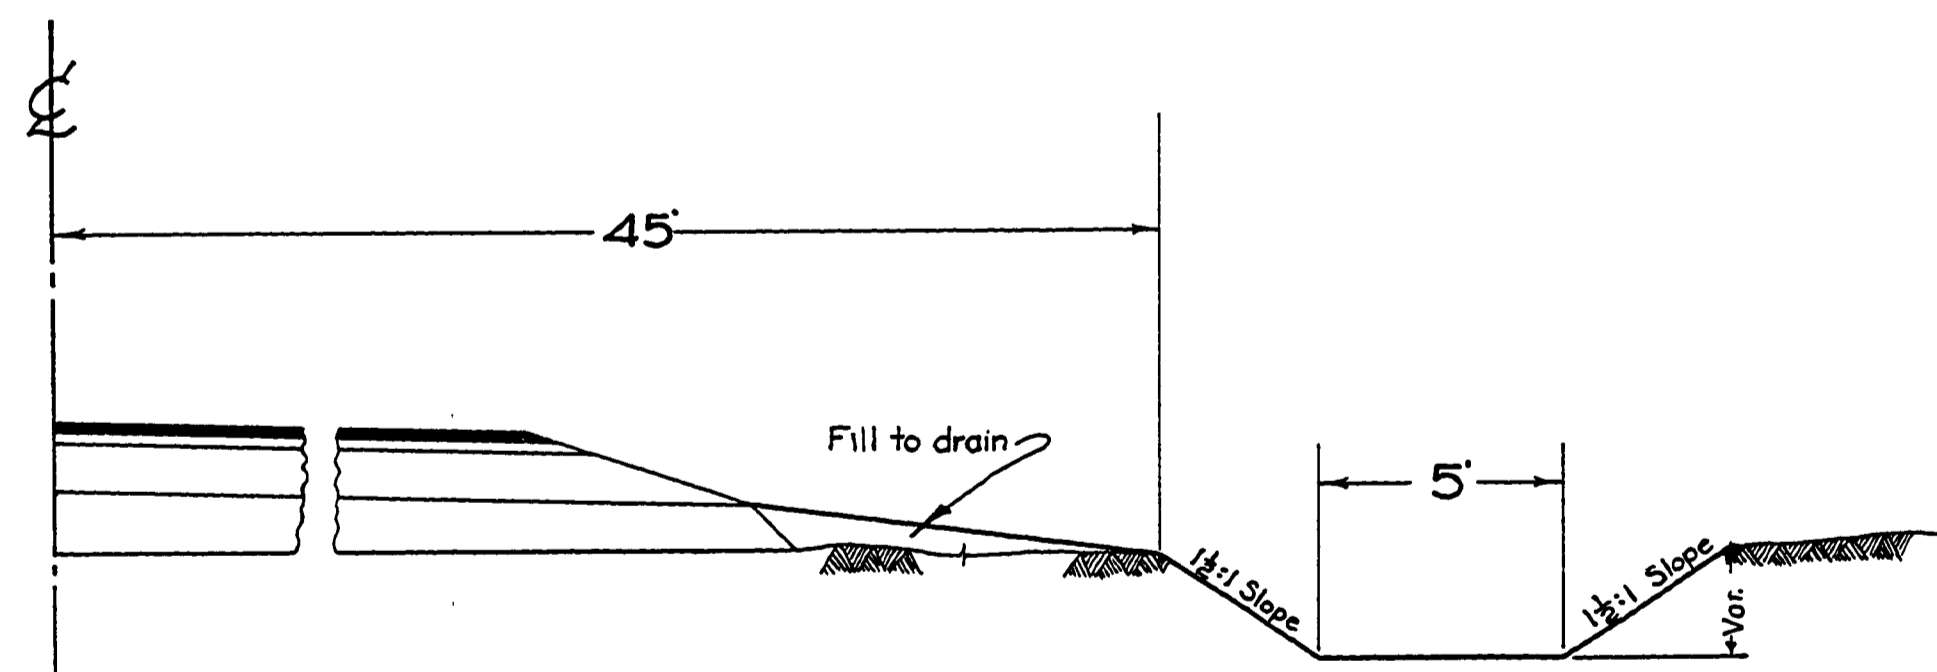

CHANNEL CHANGE TYPICAL SECTION
STA. L 22+00.00 TO STA. L 22+50.00

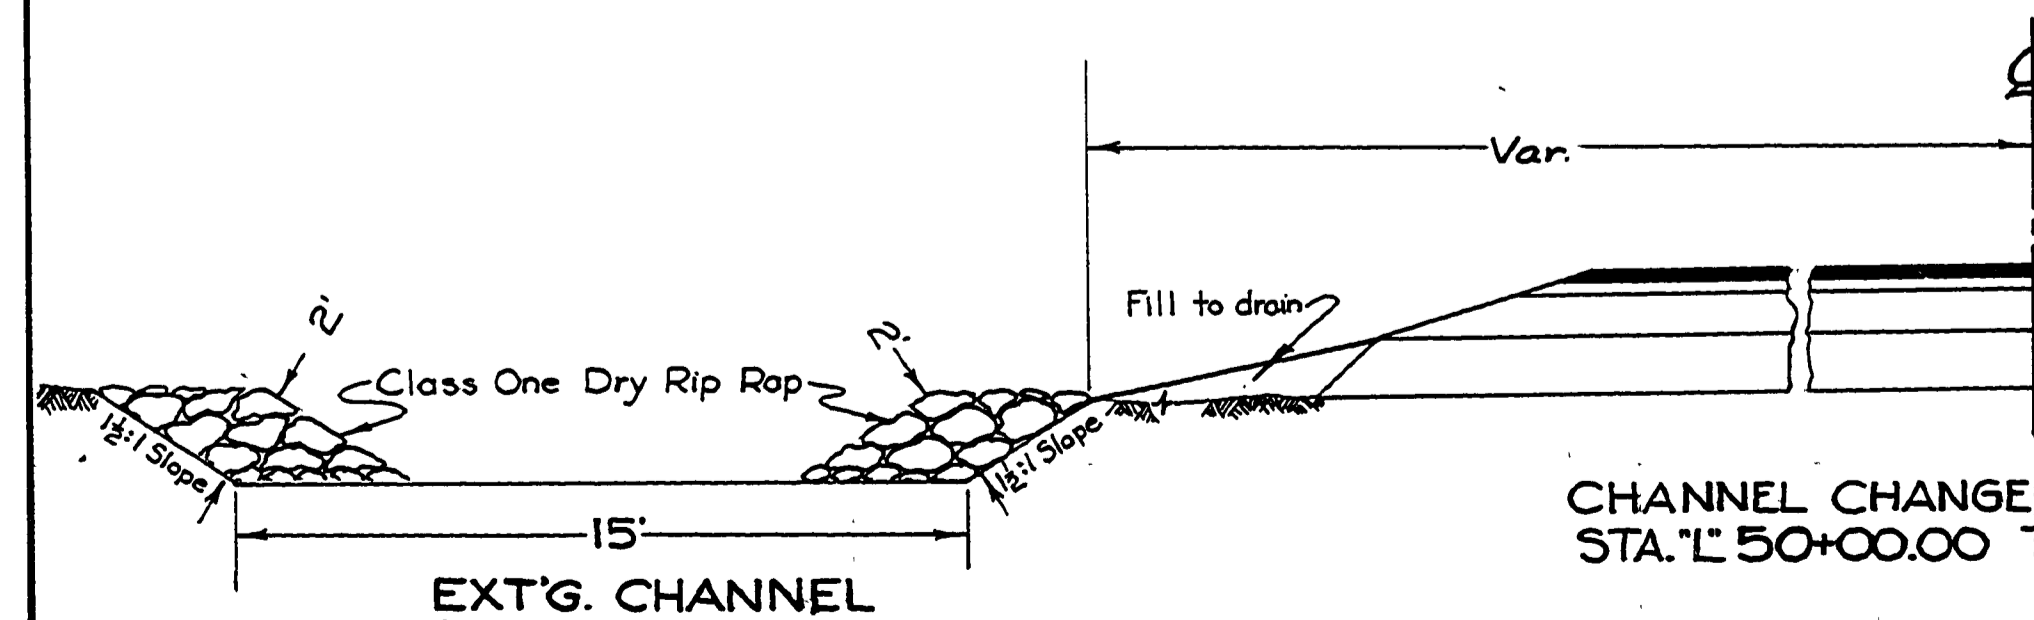

CHANNEL CHANGE TYPICAL SECTION
STA. L 50+00.00 TO STA. L 58+50.00

AS CONSTRUCTED
JW 1-11-77
DOUGLAS COUNTY
PUBLIC WORKS DEPARTMENT
STEWART PARKWAY ROAD #308
1975 SHT. 11
GEORGE E. GRUBB, DIRECTOR

RD308TPL