


FILED
RECEIVED
JUL 15 1975
COUNTY SURVEYOR
DOUGLAS COUNTY, ILL.

A	B	C	D	E	F	G	H	I	J	K	L	M
481.07	477.30	474.40	473.77	472.25	471.25	470.85	470.63	470.23	469.55	469.28	468.10	466.71

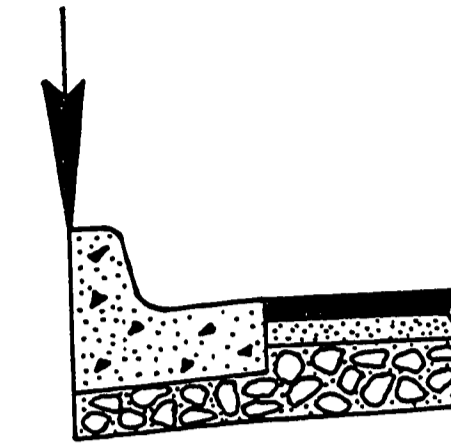

TYPE "B" CURB & GUTTER

ELEVATIONS LISTED CORRESPOND TO LOCATIONS SHOWN

- 488
- 486
- 484
- 482
- 480
- 478
- 476
- 474
- 472
- 470
- 468
- 466
- 464

A I
B I
C I
D I
E I
F I
G I
H I
I I
J I
K I
L I
M I

NOT REVISED
AS CONSTRUCTED

DOUGLAS COUNTY ROAD DEPT.
OAK KNOLLS ST'S. RD. 311
1973 SHT. 6
GEORGE E. GRUBB, COUNTY ENGR.

0000057

S 2	Δ 2	AREA
10° 19' 30"	200° 39' 00"	4400 SQ. FT.

