


W	R <sub>1</sub>	Δ <sub>1</sub>	L <sub>1</sub>	R <sub>2</sub>	Δ <sub>2</sub>	L <sub>2</sub>	Δ <sub>2</sub>	L <sub>2</sub>	X	AREA
33	30	45°13'44"	23.68	35.5	270°27'28"	18.59	15°13'44"	9.44	46.13	3,985
35	40	44°02'55"	30.75	40	268°05'50"	20.94	14°02'55"	9.81	55.62	5,220
41	35	42°16'07"	25.82	40	264°32'14"	20.94	12°16'07"	8.57	50.45	5,123
41	40	40°51'55"	28.53	40	261°43'50"	20.94	10°51'55"	7.59	52.34	5,207

AREA FIGURES ARE FOR SHADED PORTION OF CUL-DE-SAC. (Ft<sup>2</sup>)


A	B	C	D	E	F	G	H	I	J	K	L	M	G <sub>1</sub>	G <sub>2</sub>
523.60	524.70	525.35	526.10	525.85	525.10	524.35	523.60	522.90	522.15	521.40	521.05	520.35	523.54	

G<sub>2</sub> EXISTS ONLY IN THE CASE OF A VC W/G<sub>1</sub> AS THE P.I.


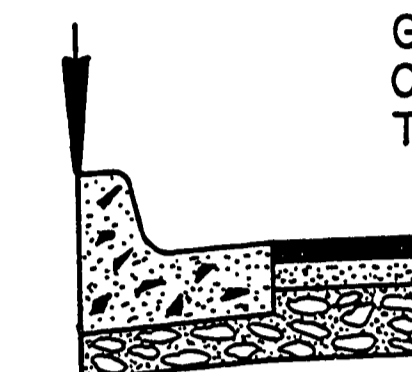


TYPE "B" CURB & GUTTER

ELEVATIONS LISTED CORRESPOND TO LOCATIONS SHOWN

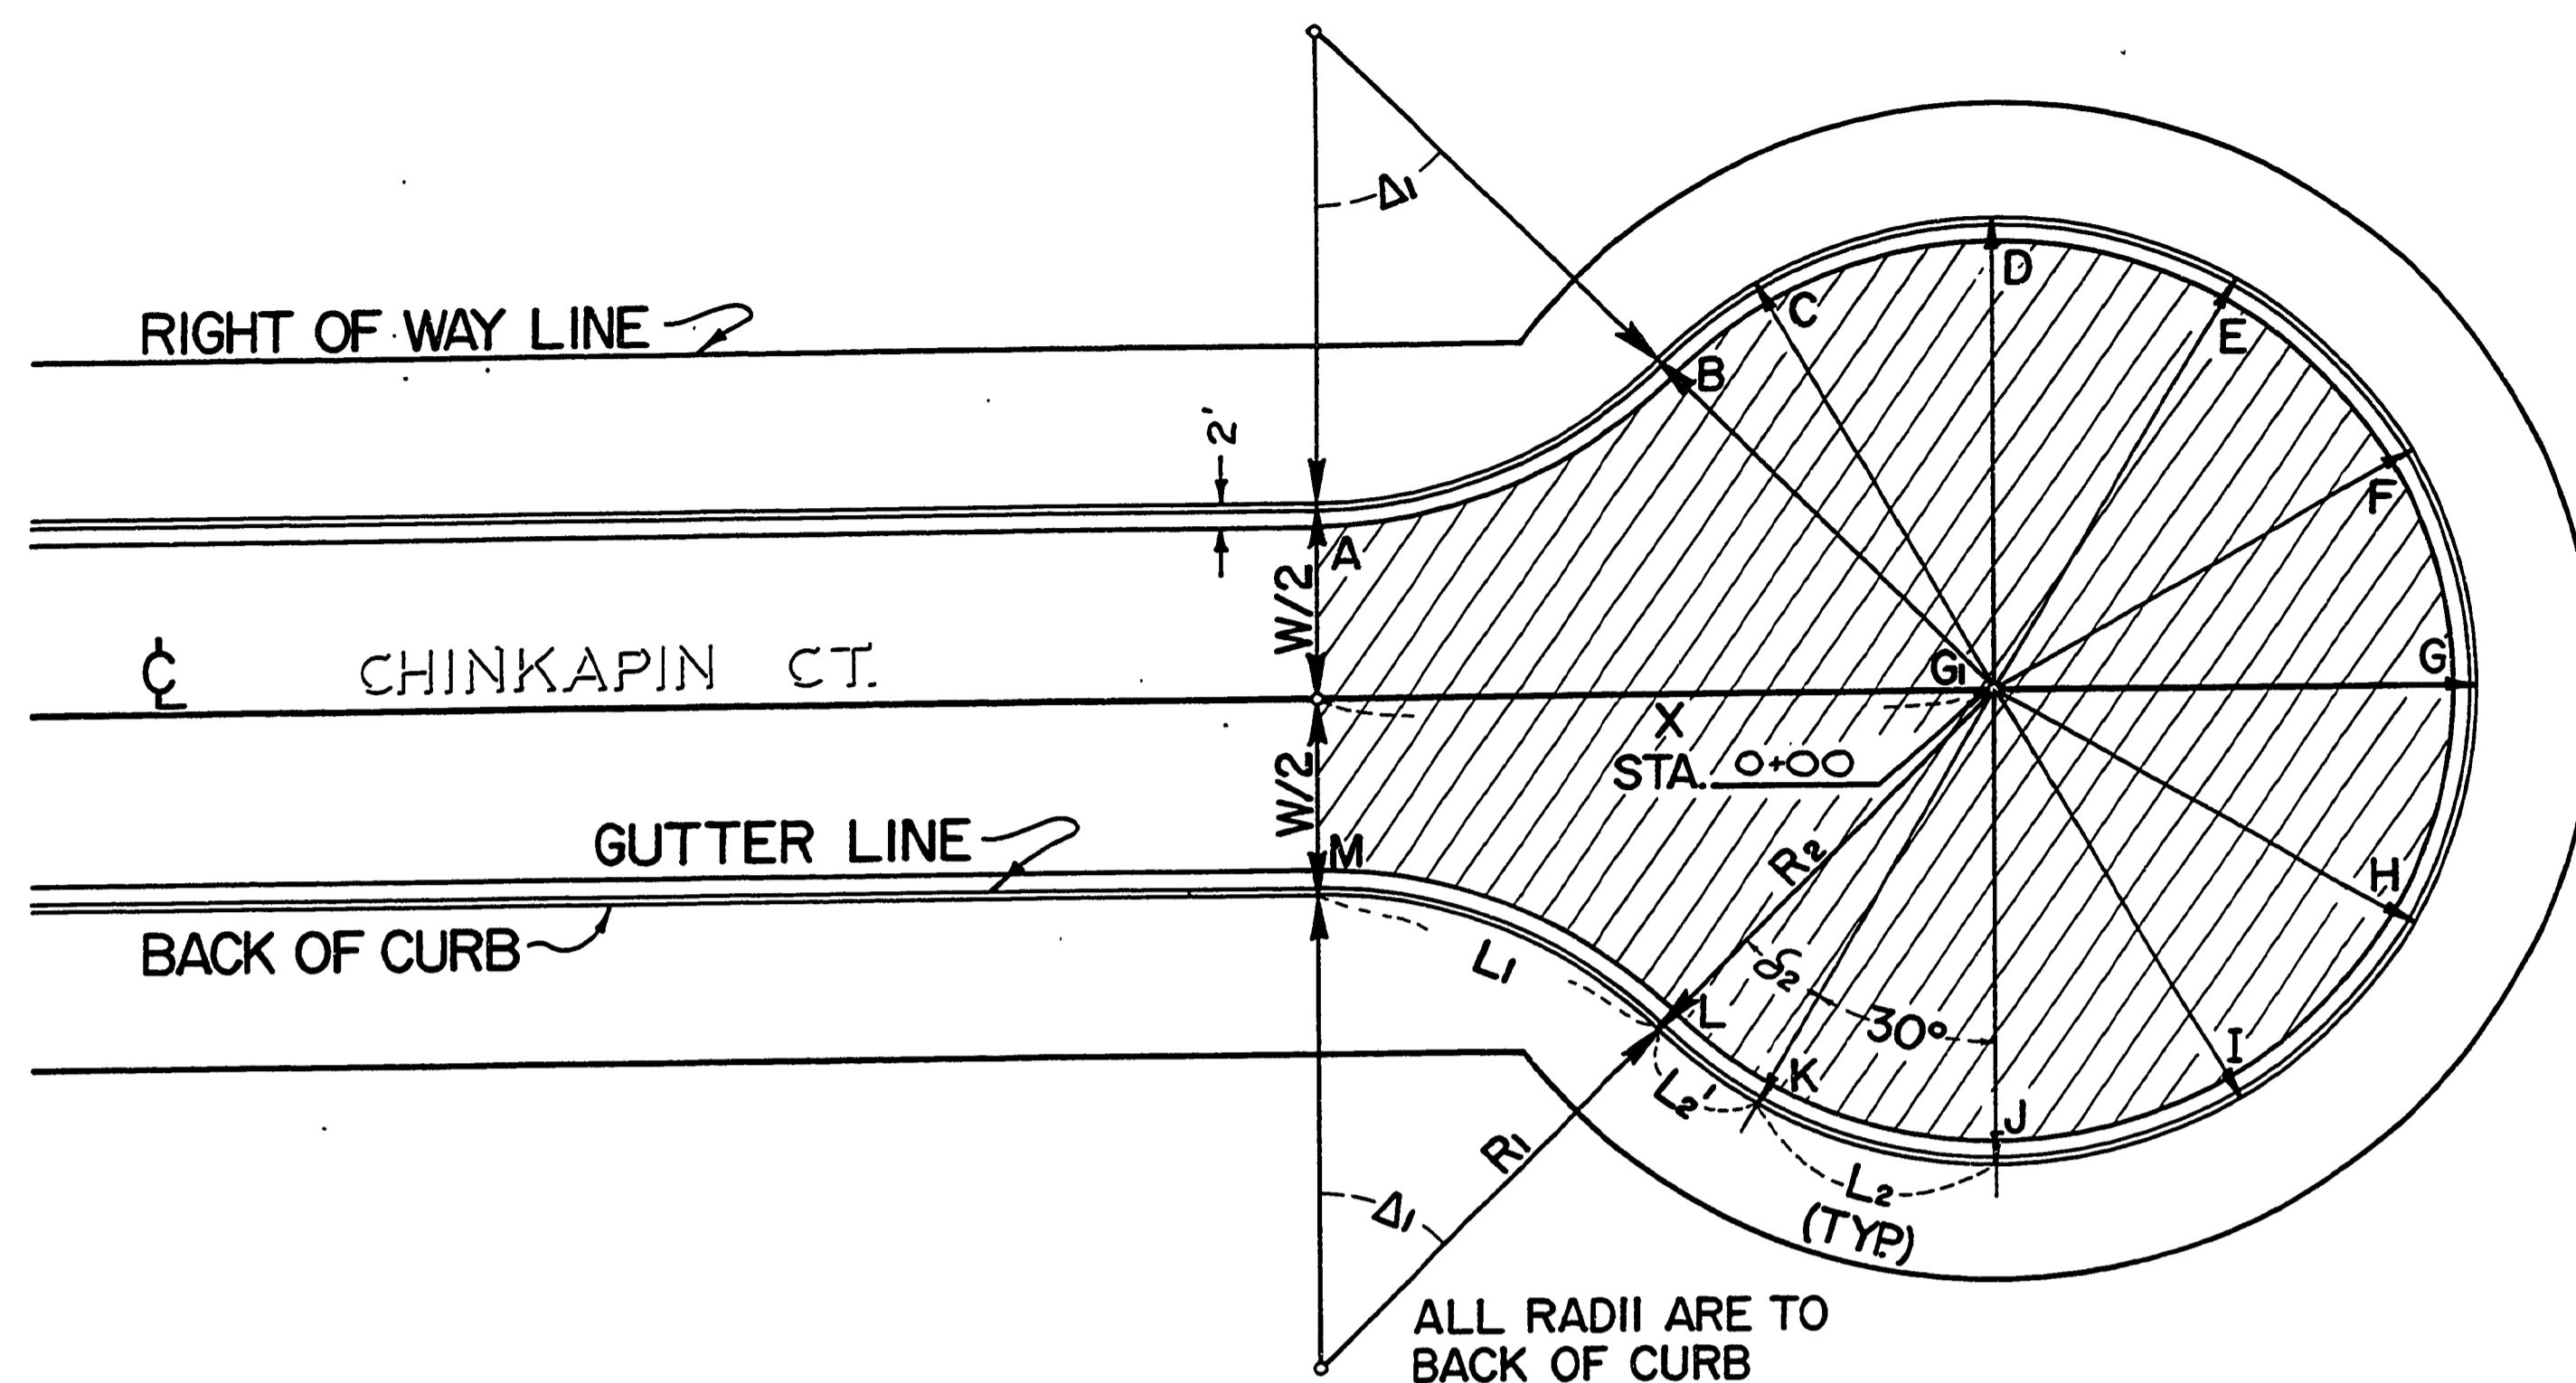


CUL-DE-SAC

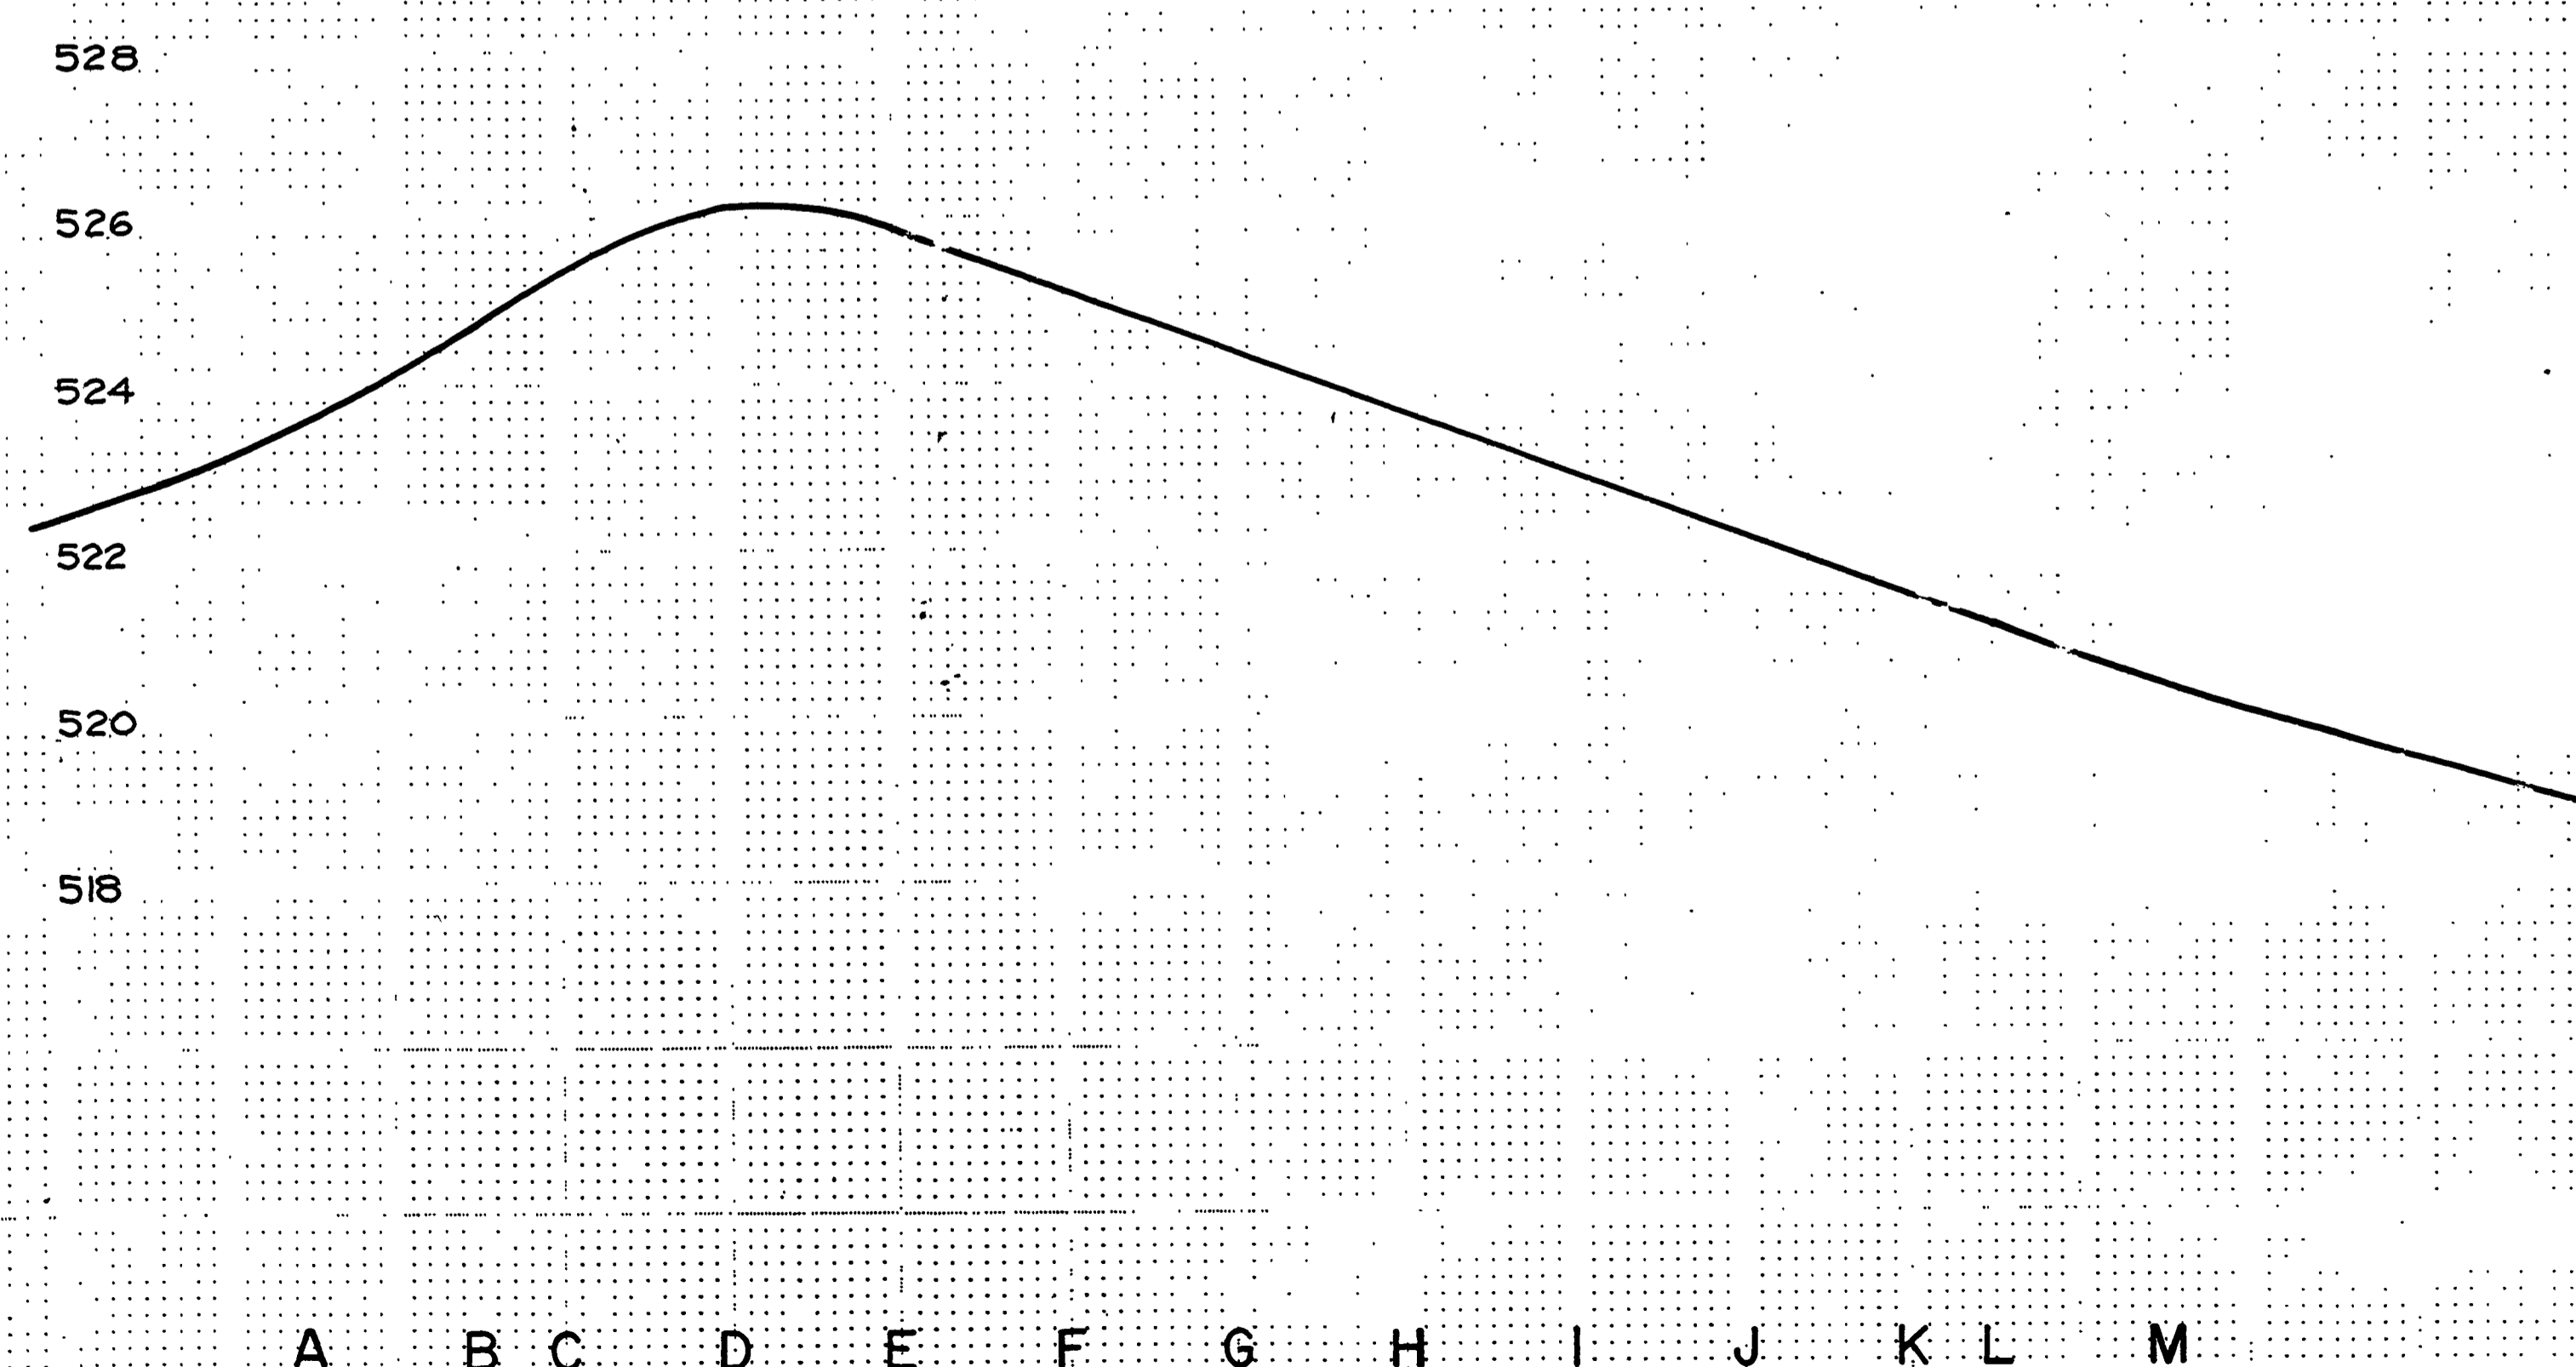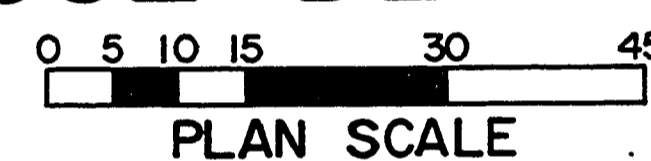

NOT REVISED  
AS CONSTRUCTED

W= 33 R<sub>1</sub>= 30 R<sub>2</sub>= 35.5  
DESCRIPTION \_\_\_\_\_  
PROJECT # 311 DATE 1973  
DOUGLAS COUNTY RD. DEPT.  
STANDARD CUL-DE-SAC LAYOUT SHT. 8

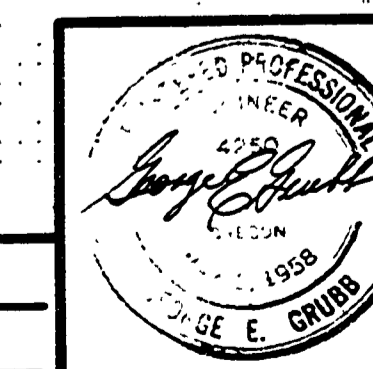

DESIGNED \_\_\_\_\_  
CHECKED \_\_\_\_\_

00000007

PLAN SURVEYED, PLOTTED, ALIGNED, CHECKED, NO. OF ANY CHECKED.

PROFILE SURVEYED, GRADES CHECKED, STRUCTURE NOTATIONS CHECKED.