



DATE: _____ BY: _____
 CHECKED: _____
 REVISIONS: _____
 NO. _____

DATE: _____ BY: _____
 CHECKED: _____
 REVISIONS: _____
 NO. _____

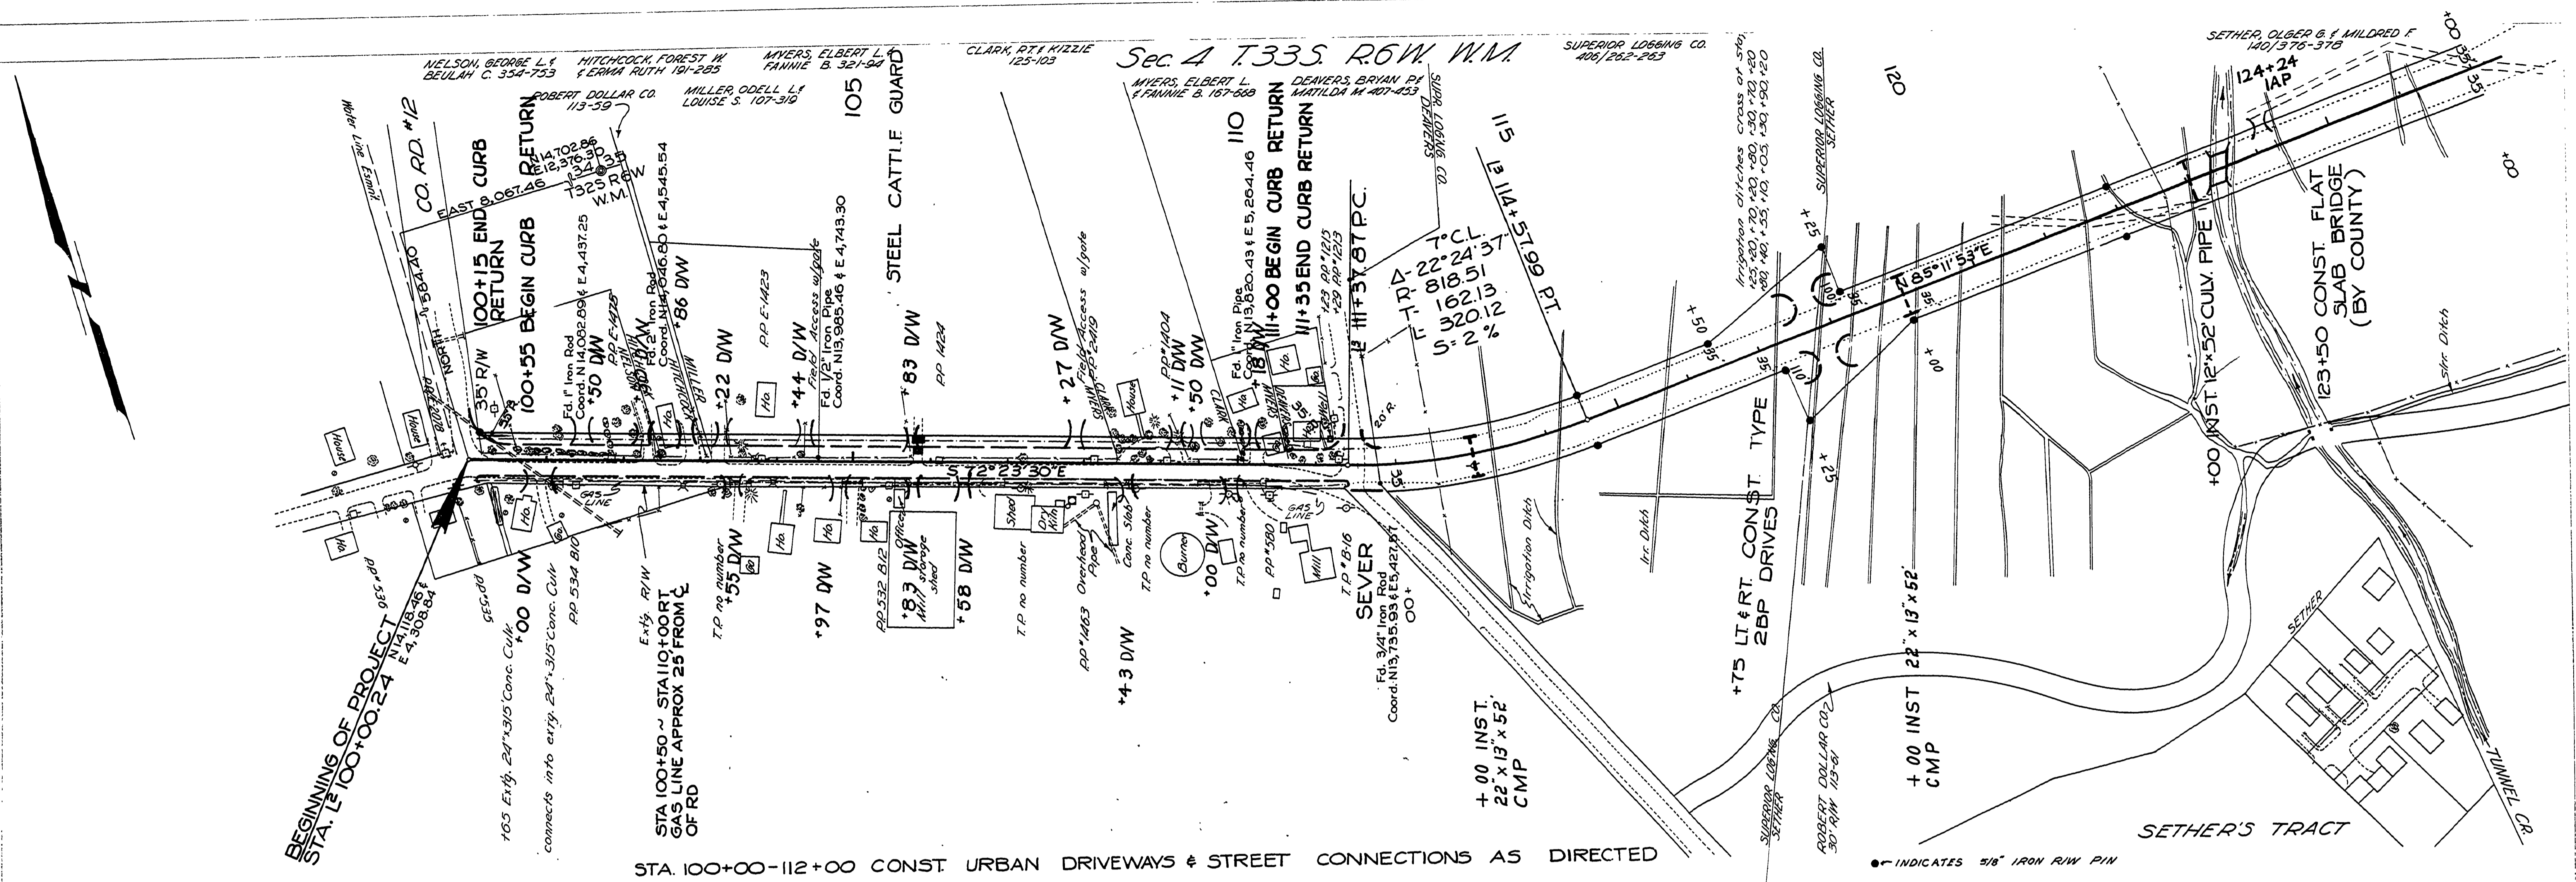

STA. 100+00-112+00 CONST. URBAN DRIVEWAYS & STREET CONNECTIONS AS DIRECTED

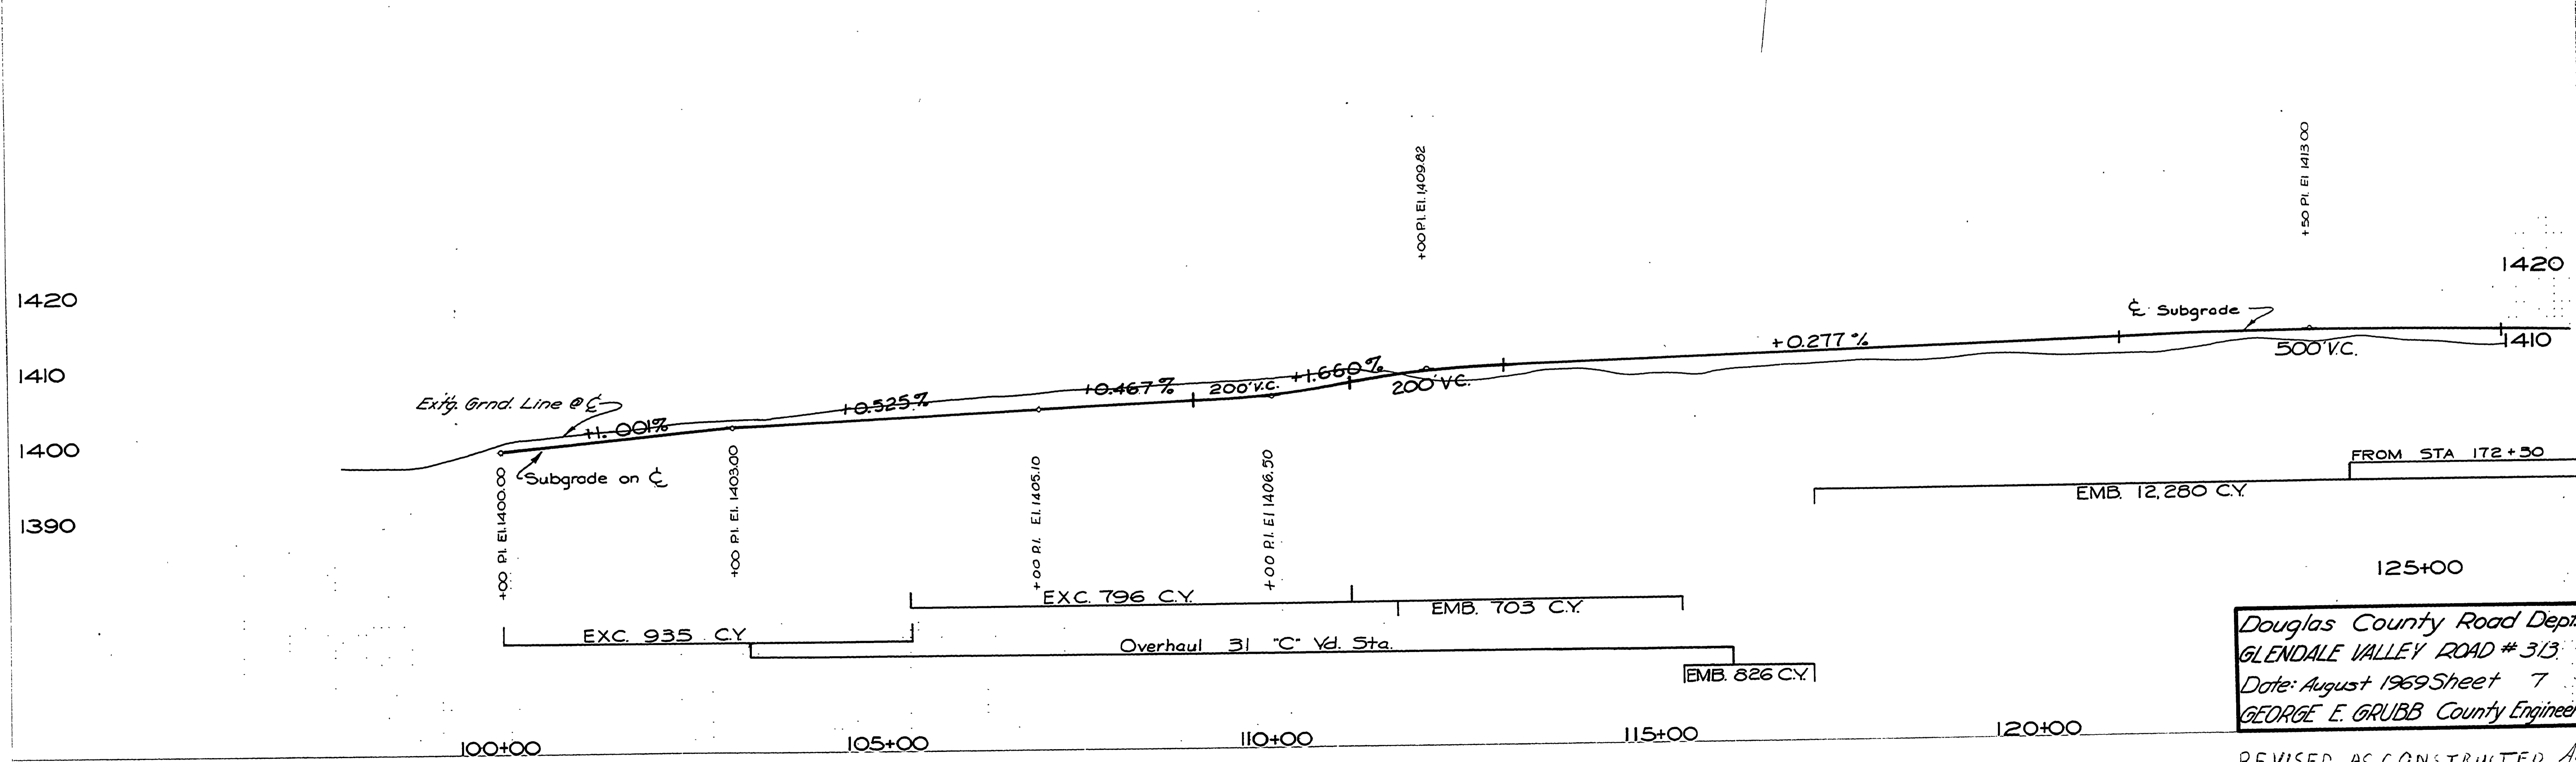

Douglas County Road Dept.
 GLENDALE VALLEY ROAD # 313
 Date: August 1969 Sheet 7
 GEORGE E. GRUBB County Engineer

M.P. 0.00-0.47

REVISIONS: AS CONSTRUCTED Aug. 67
 G.R.D. # 313 sht. 7

00000047