
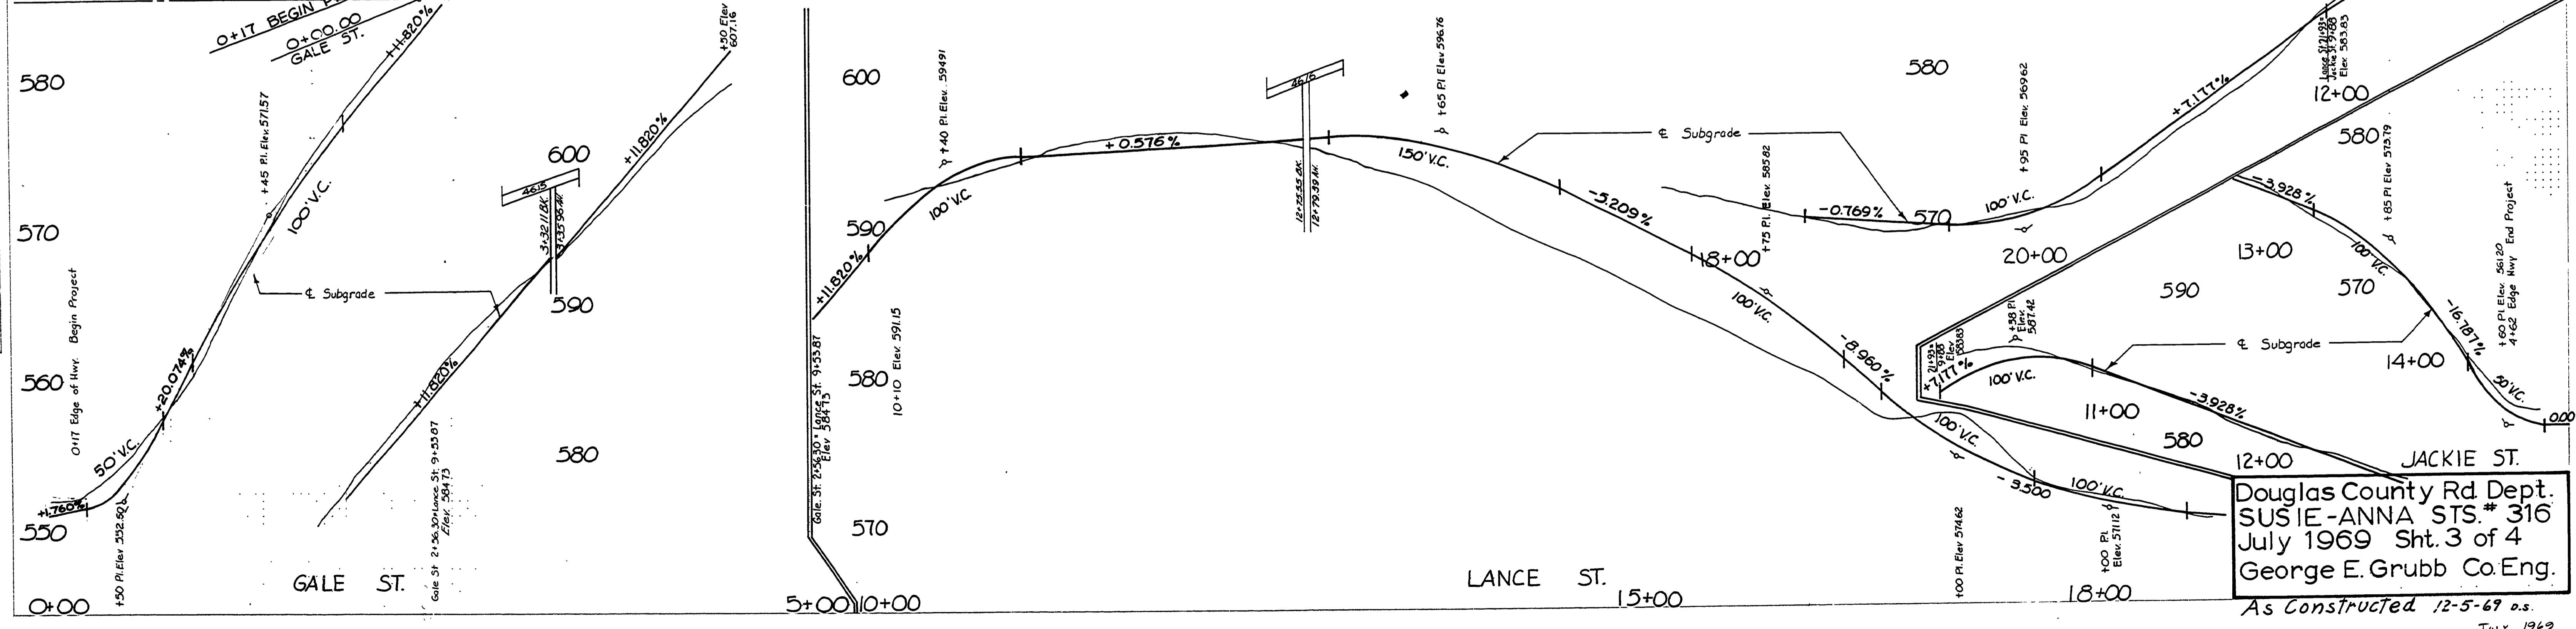


SEC. 15, T. 28 S., R. 6 W., W.M.

PLAN	DATE
NO.	
BY	
PROJECTED	
ALIGNED WITH CHECKED	
RT. OF WAY CHECKED	
NO.	

PROFILE	DATE
NO.	
BY	
SURVEYED	
GRADES CHECKED	
STRUCTURE NOTATION CHECKED	
NO.	

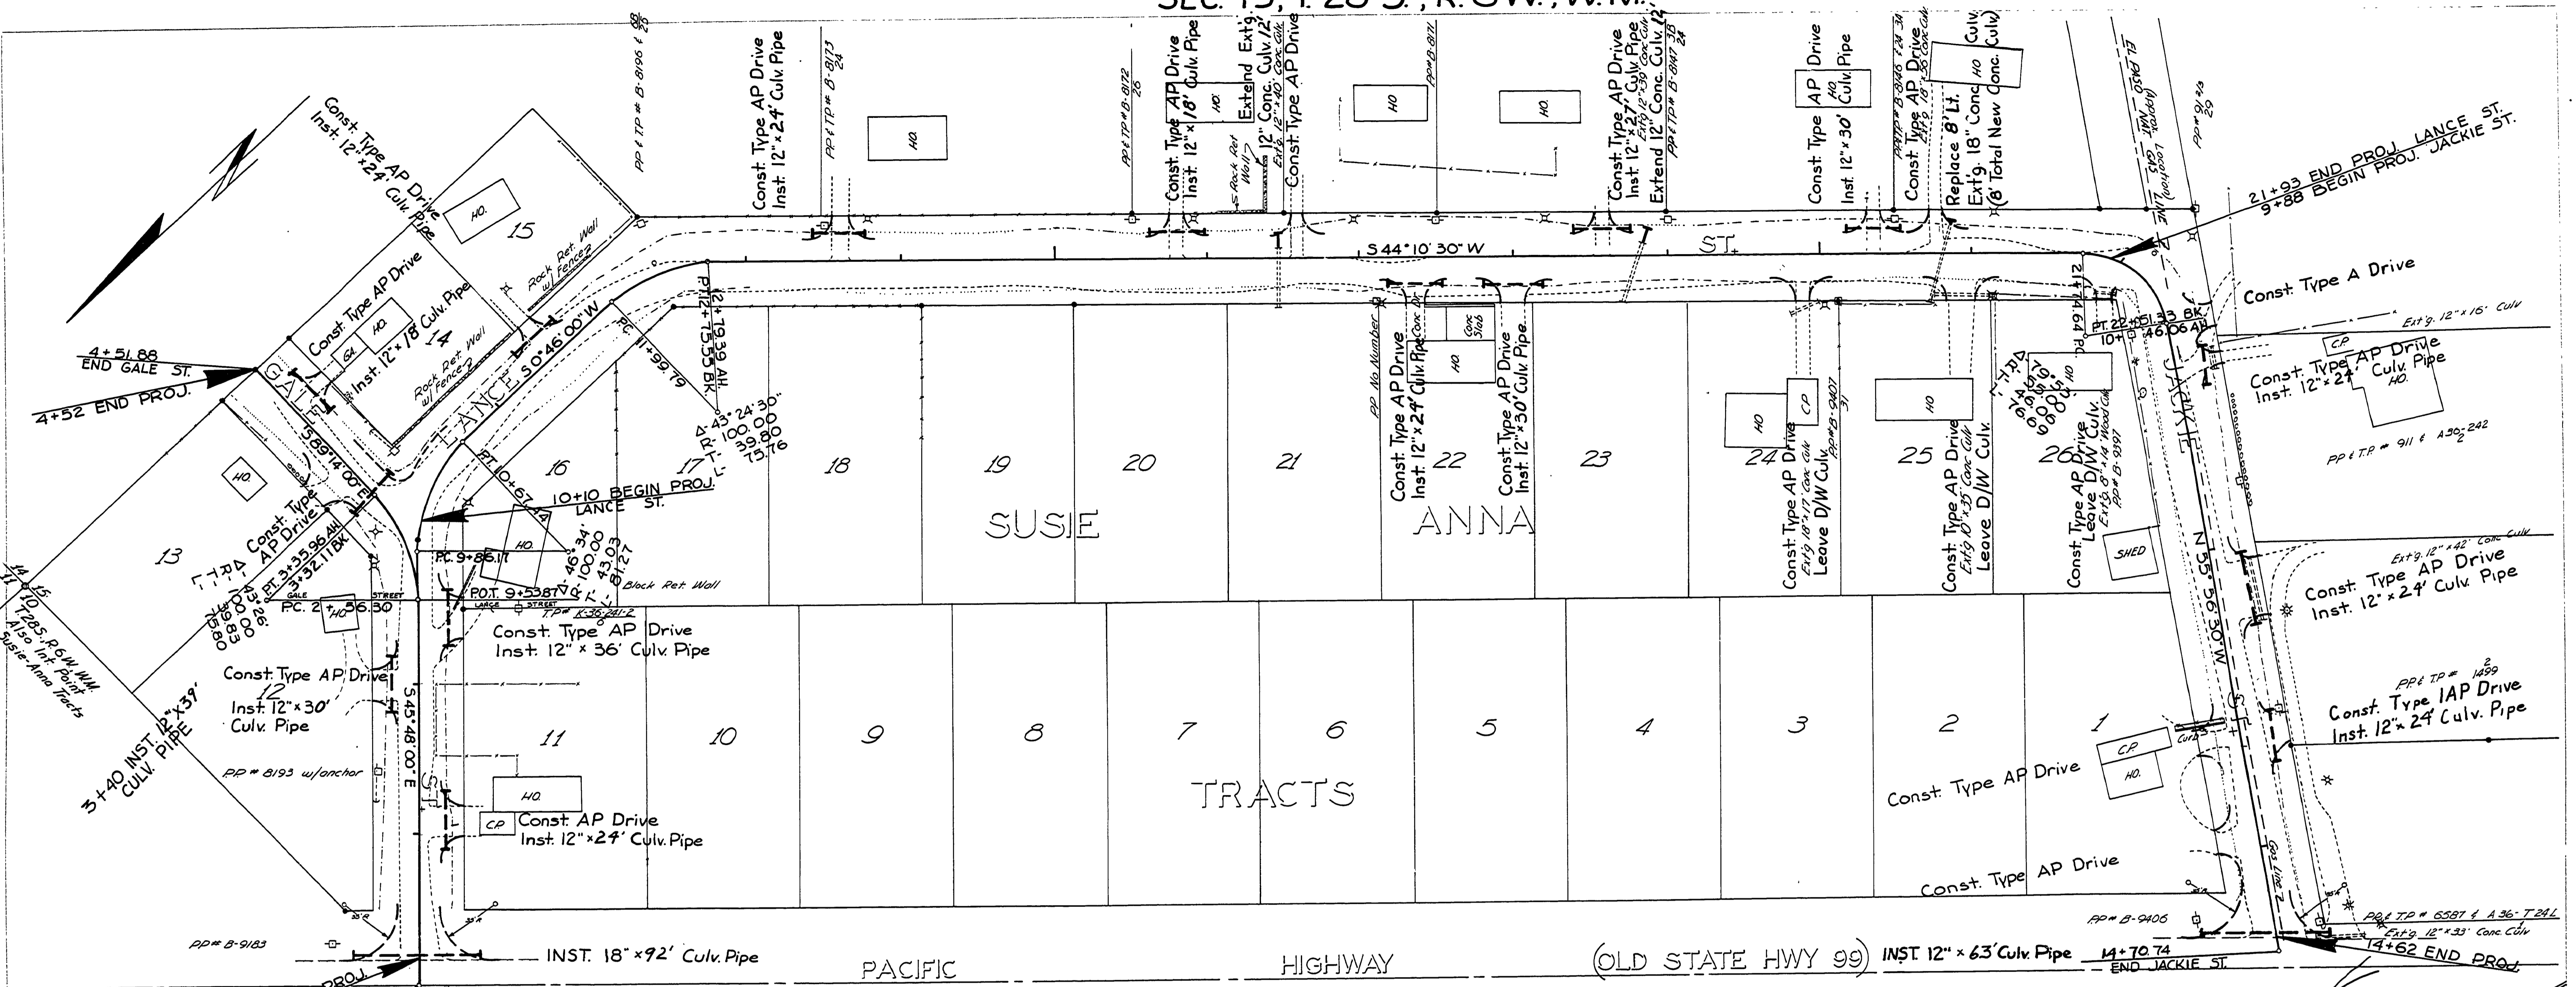

Douglas County Rd Dept.
 SUSIE-ANNA STS. # 316
 July 1969 Sht. 3 of 4
 George E. Grubb Co. Eng.

As Constructed 12-5-69 d.s.

000600029