
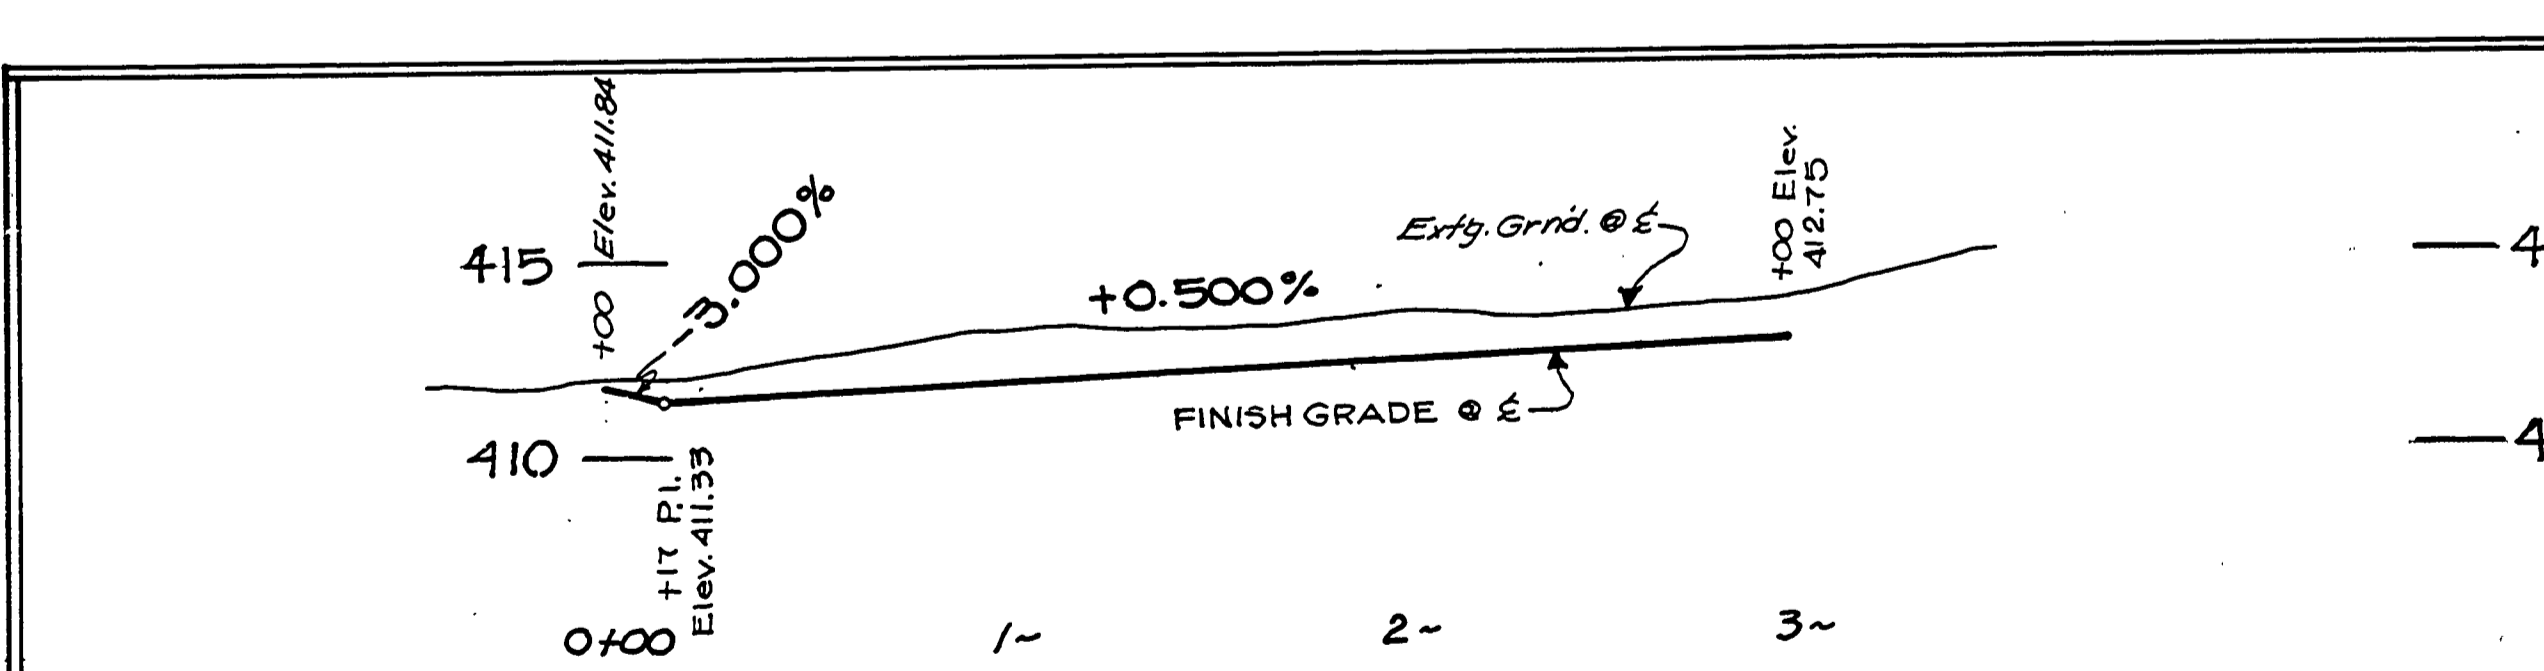
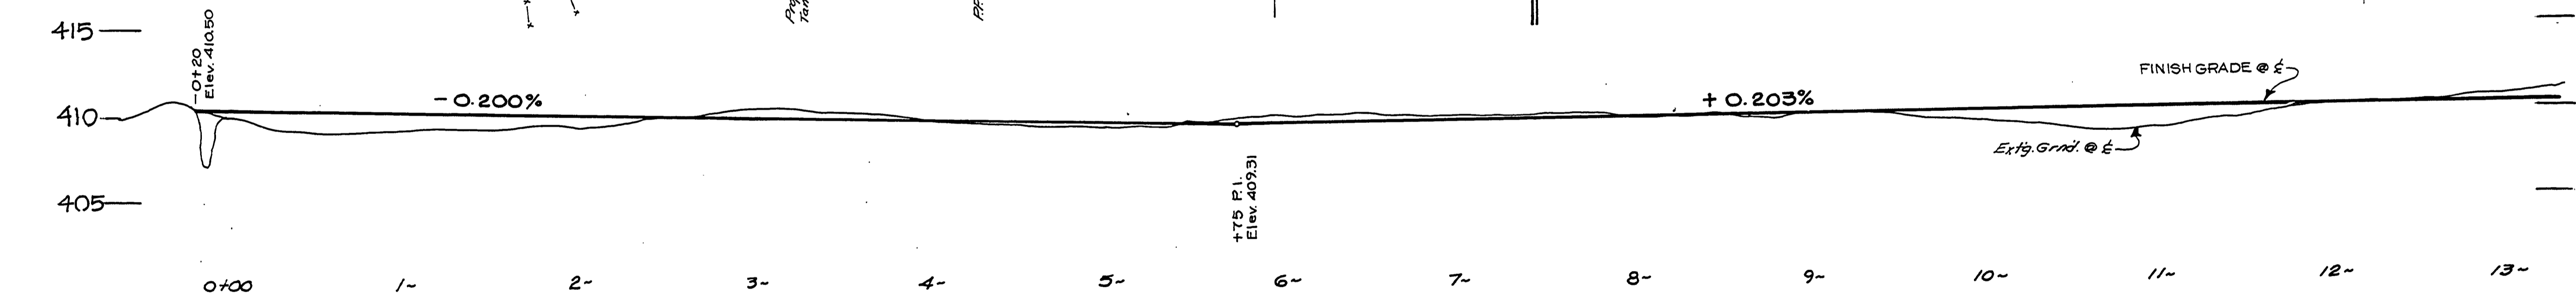
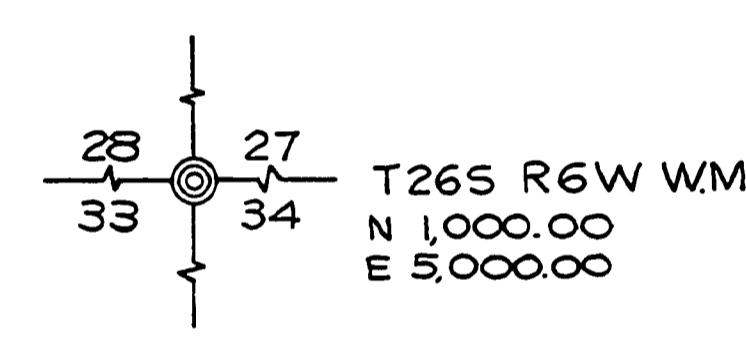
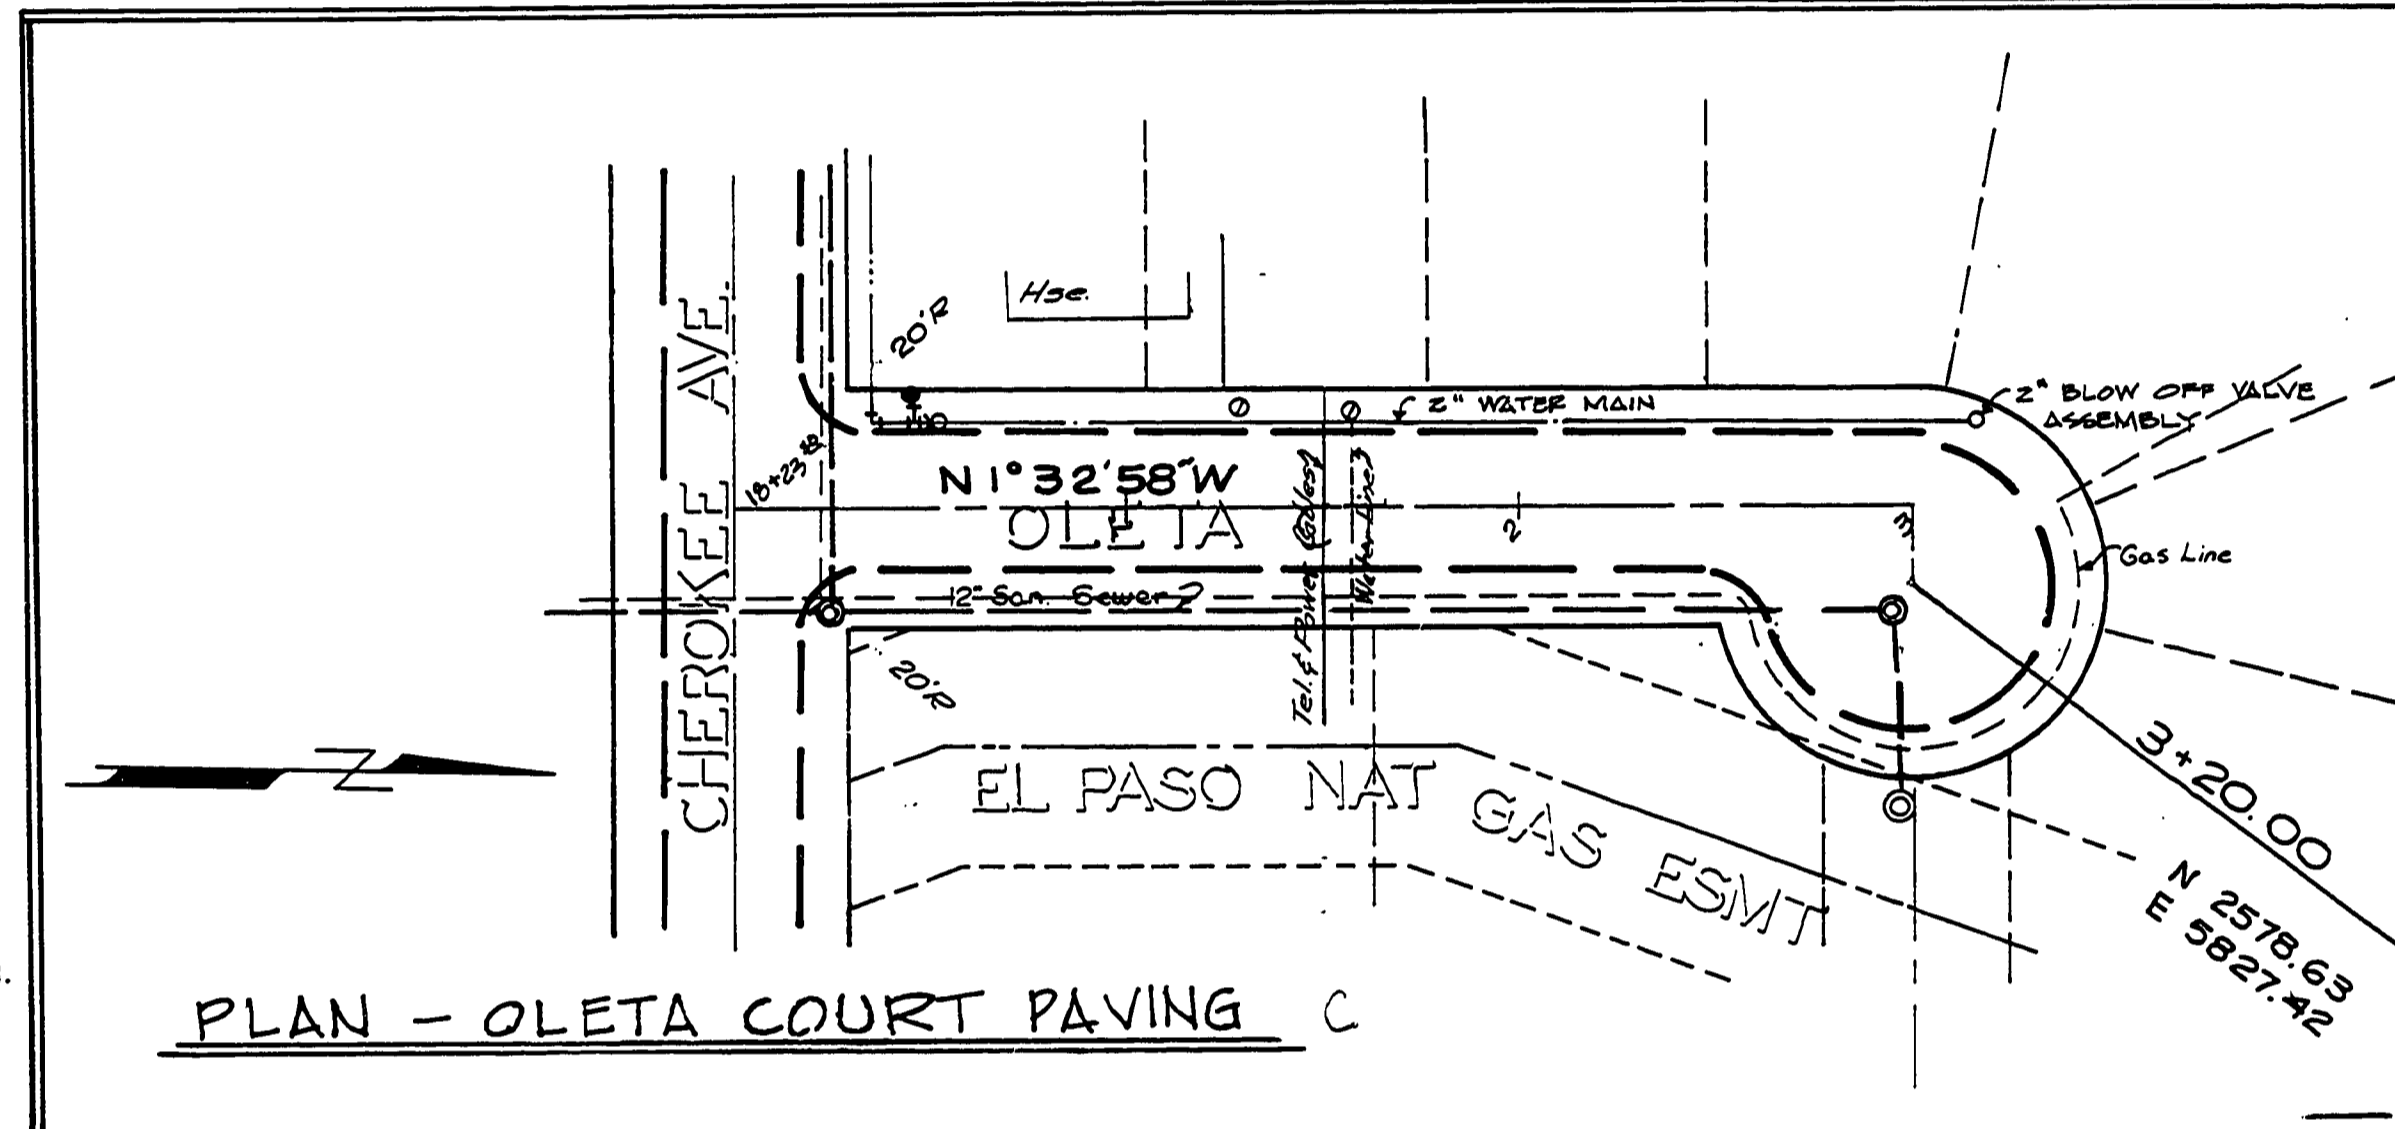
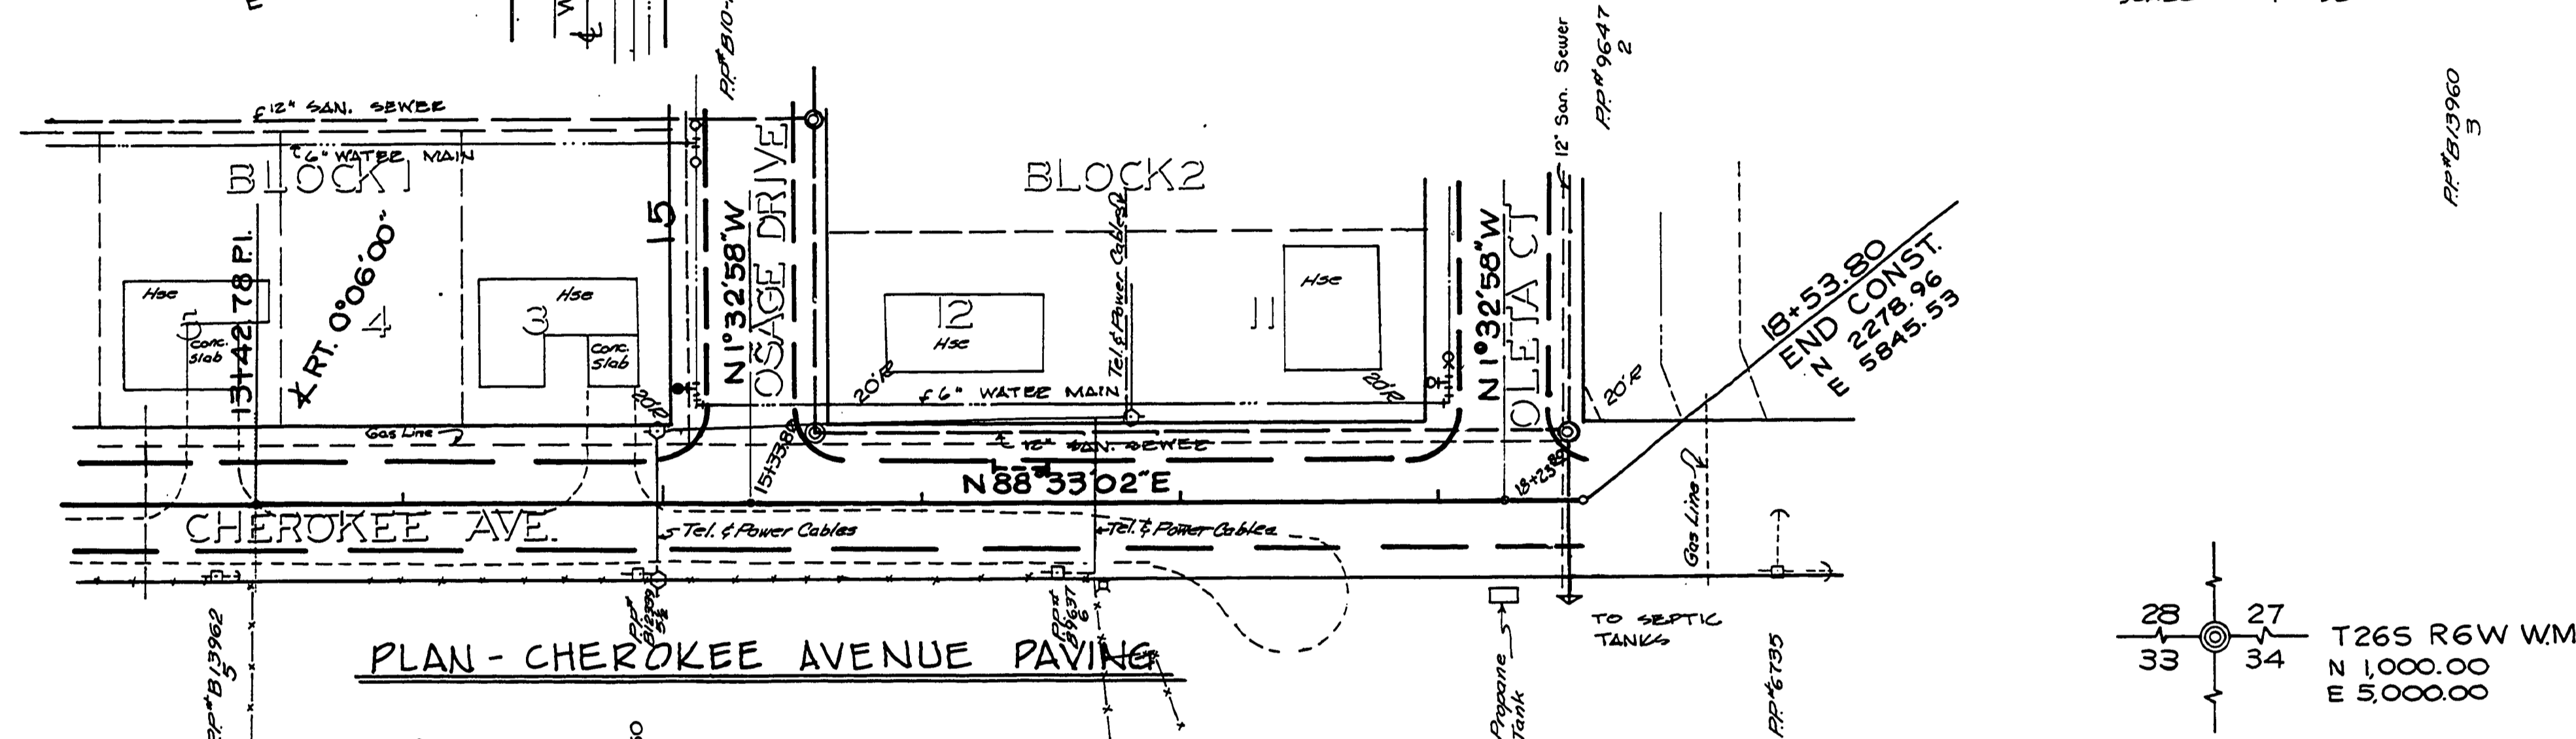


S 27 & 28 T 26S R6W WM

DATE: \_\_\_\_\_ BY: \_\_\_\_\_  
 PLAN: SURVEYED, LAYOUT, DESIGN, CONSTRUCTION, AS-BUILT, ERECTION, ELEVATION, FINISH, ETC.  
 NOTE: SEE REVISIONS FOR LATEST CHANGES.

DATE: \_\_\_\_\_ BY: \_\_\_\_\_  
 PROFILE: SURVEYED, FINISH GRADE, EXISTING GRADE, ELEVATION, FINISH, ETC.  
 NOTE: SEE REVISIONS FOR LATEST CHANGES.

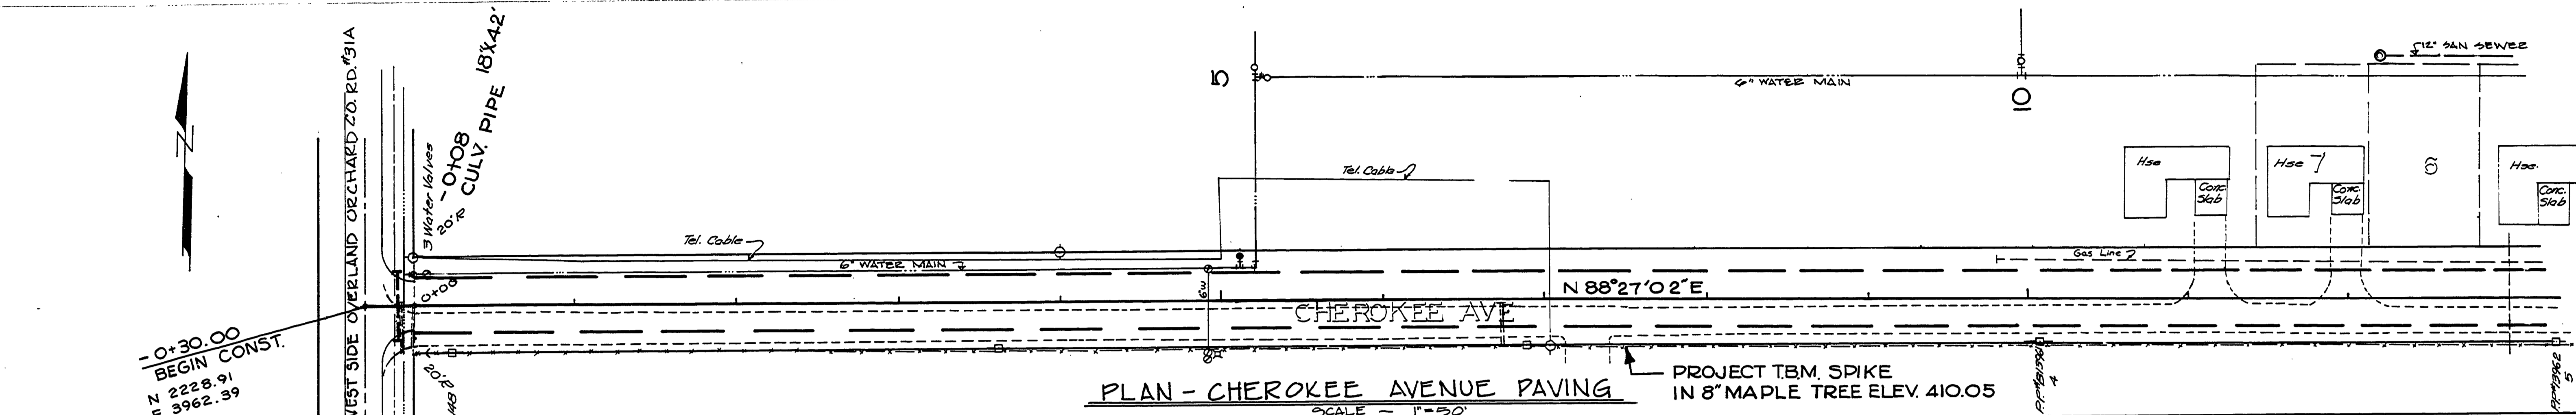

PROFILE - CHEROKEE AVE. A

PROFILE - OLETA COURT D

8-27-74  
 REVISED AS BUILT R.H.  
 DOUGLAS COUNTY ROAD DEPT  
 DEL VIEW STREETS #334  
 1973 SHT 3  
 GEORGE E. GRUBB COUNTY ENGR

00260036