


A	B	C	D	E	F	G	H	I	J	K
412.47	412.85	413.07	413.32	413.43	413.52	413.64	413.86	414.22	414.60	415.28

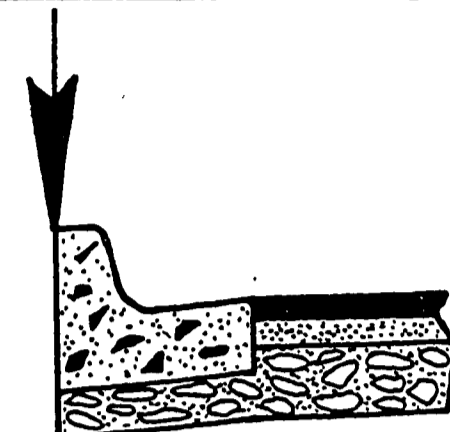


TYPE "B" CURB & GUTTER

ELEVATIONS LISTED CORRESPOND TO LOCATIONS SHOWN

AREA 3864 ft.²
 AREA IS FOR THE SHADED
 PORTION OF THE CUL-DE-SAC

SCALE 1" = 10'

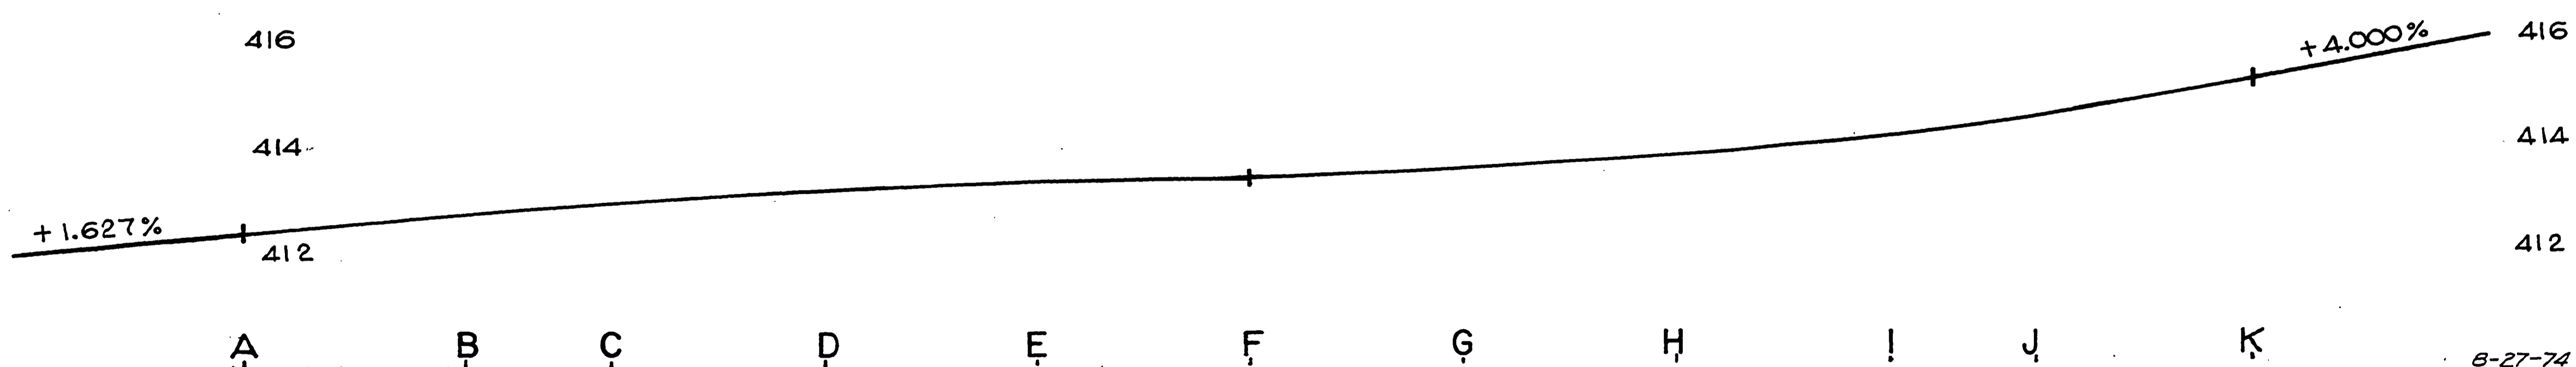

8-27-74
 REVISED AS BUILT P.H.
 DOUGLAS COUNTY ROAD DEPT.
 DEL VIEW STREETS #334B
 1973 SHT. 6
 GEORGE E. GRUBB COUNTY ENGR.

00000004