


SCALE 1" = 10'

AREA 4893 ft.²
 AREA IS FOR THE SHADED
 PORTION OF THE CUL-DE-SAC

A	B	C	D	E	F	G	H	I	J	K	L	M
412.49	412.60	412.65	412.75	412.82	412.92	412.96	412.94	412.90	412.82	412.75	412.49	413.09

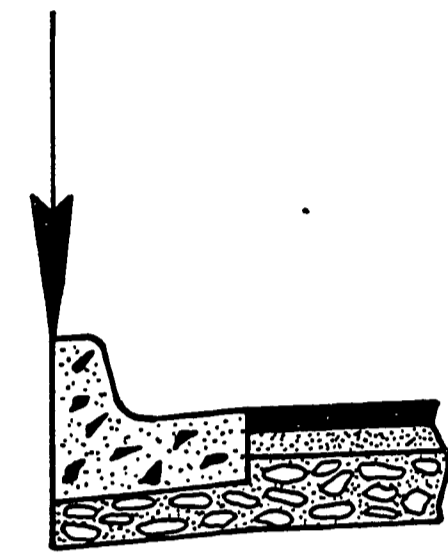

TYPE "B" CURB & GUTTER

ELEVATIONS LISTED CORRESPOND TO LOCATIONS SHOWN



8-27-74
 REVISED AS BUILT PH
 DOUGLAS COUNTY ROAD DEPT.
 DEL VIEW STREETS # 334
 1973 SHT. 7
 GEORGE E. GRUBB COUNTY ENGR.