


DOUGLAS COUNTY, OREGON  
 PLANS FOR PROPOSED CONSTRUCTION PROJECT

SADDLE BUTTE ESTATES  
 THIRD ADDITION

Section 30, T 26 S, R 6 W., W M.


FILED  
 Date: 2-11-91 By: J.P.  
 This survey consists of:  
 Map: \_\_\_\_\_  
 Narrative: \_\_\_\_\_  
 Corner Ppit: \_\_\_\_\_  
 DOUGLAS COUNTY  
 SURVEYOR

L & H Lumber Co.  
 859 W. Lookingglass St.  
 Roseburg, Oregon 97470

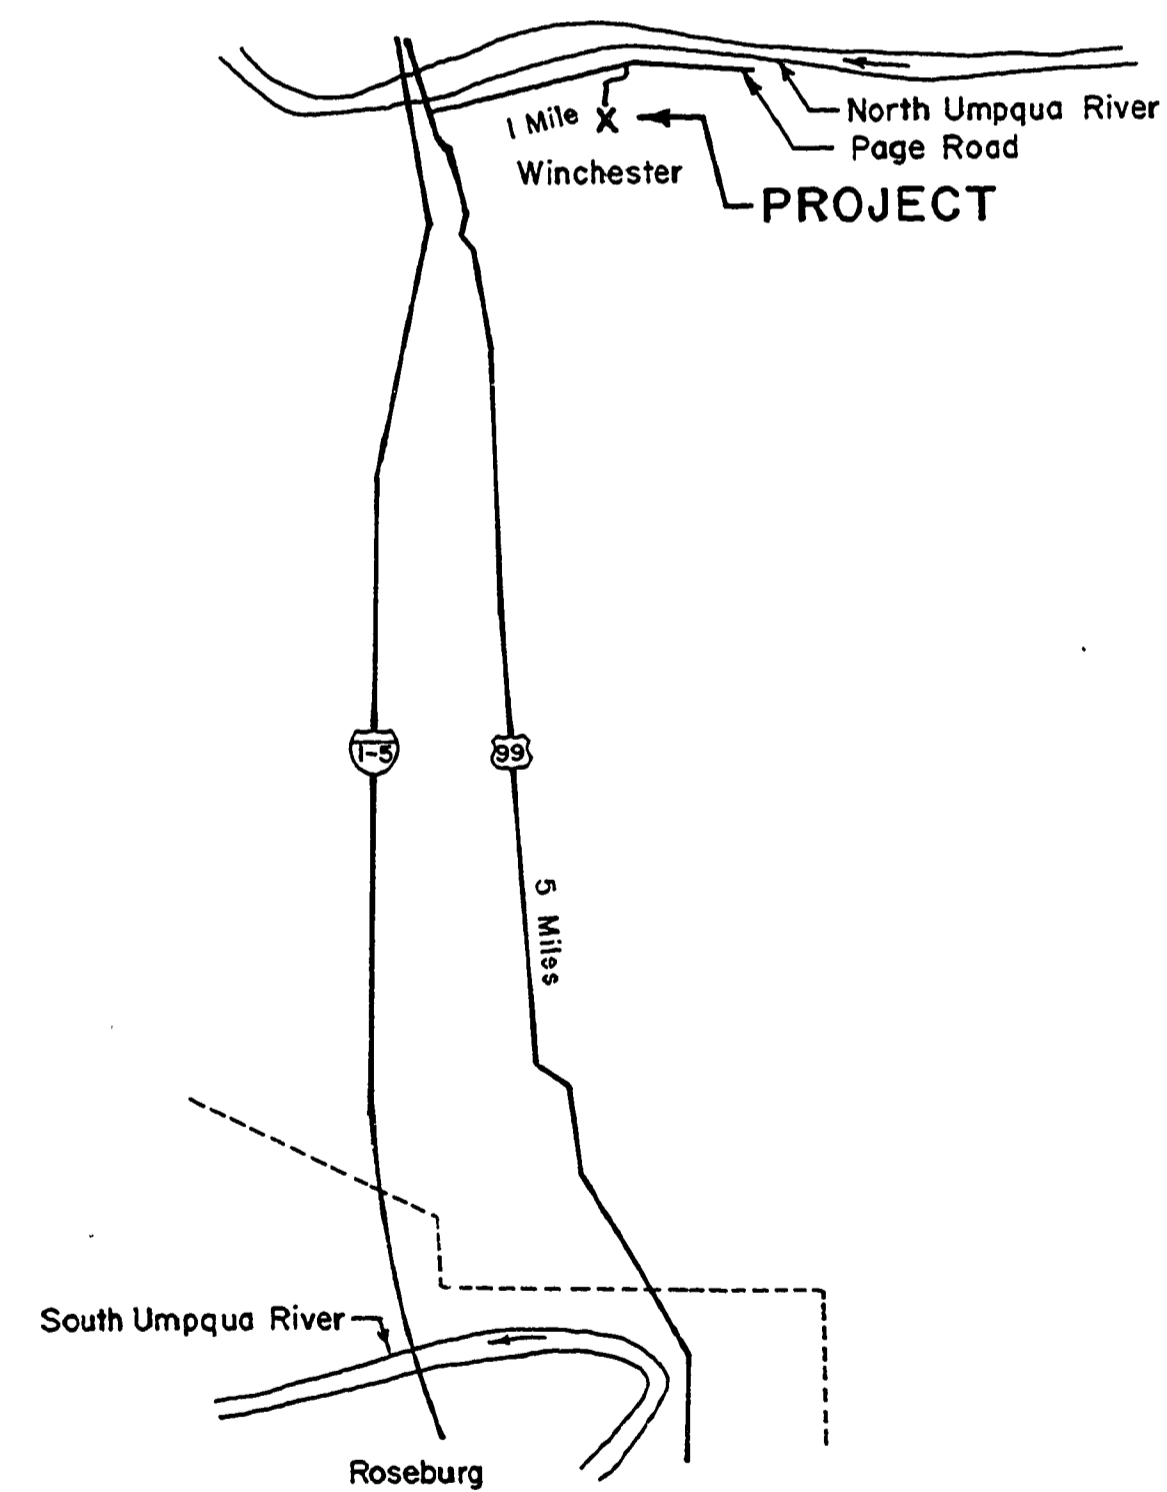

Sheet Index

- 1. Streets (Incl. Lillian St.)
- 2-3. Sanitary Sewer
- 4. Utility Mains

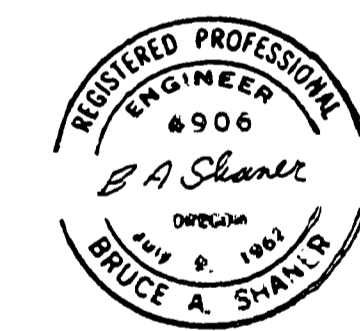

Engineering By: Shaner Engineering, Inc.  
 P. O. Box 1430  
 Roseburg, Oregon 97470  
 Inspection By: Douglas County Public Works

"As Constructed", December, 1990  
 June 19, 1990

ROAD 335E