



SEC. 5, 6, 7 & 8 T30S.R5W.W.M.

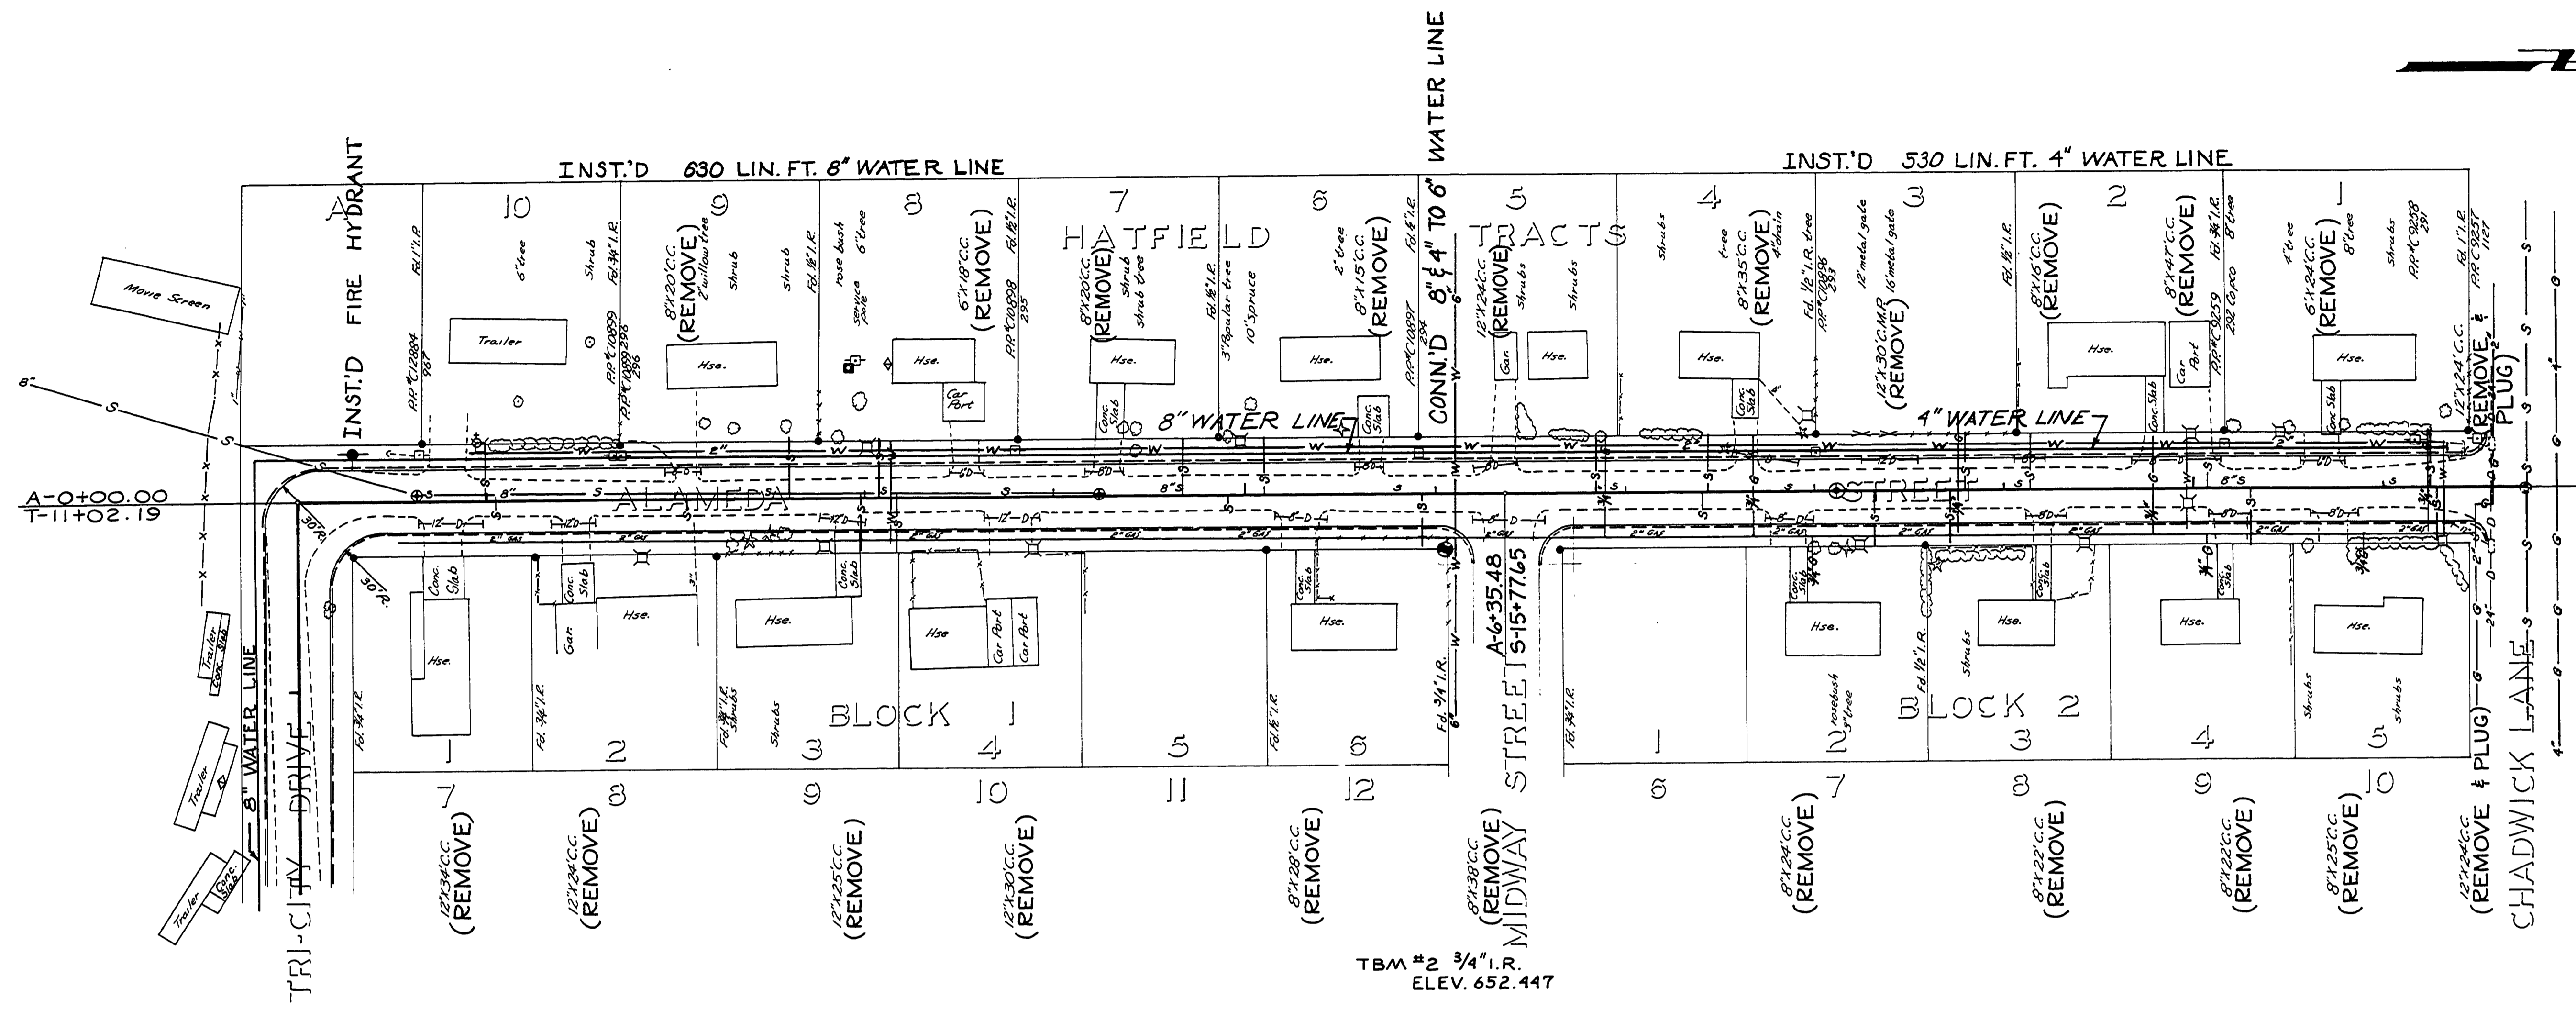

FILED
 Date: 1-30-97 By: J.P.
 This survey consists of:
 Map:
 Narrative:
 Corner Rpt:
 DOUGLAS COUNTY
 SURVEYOR

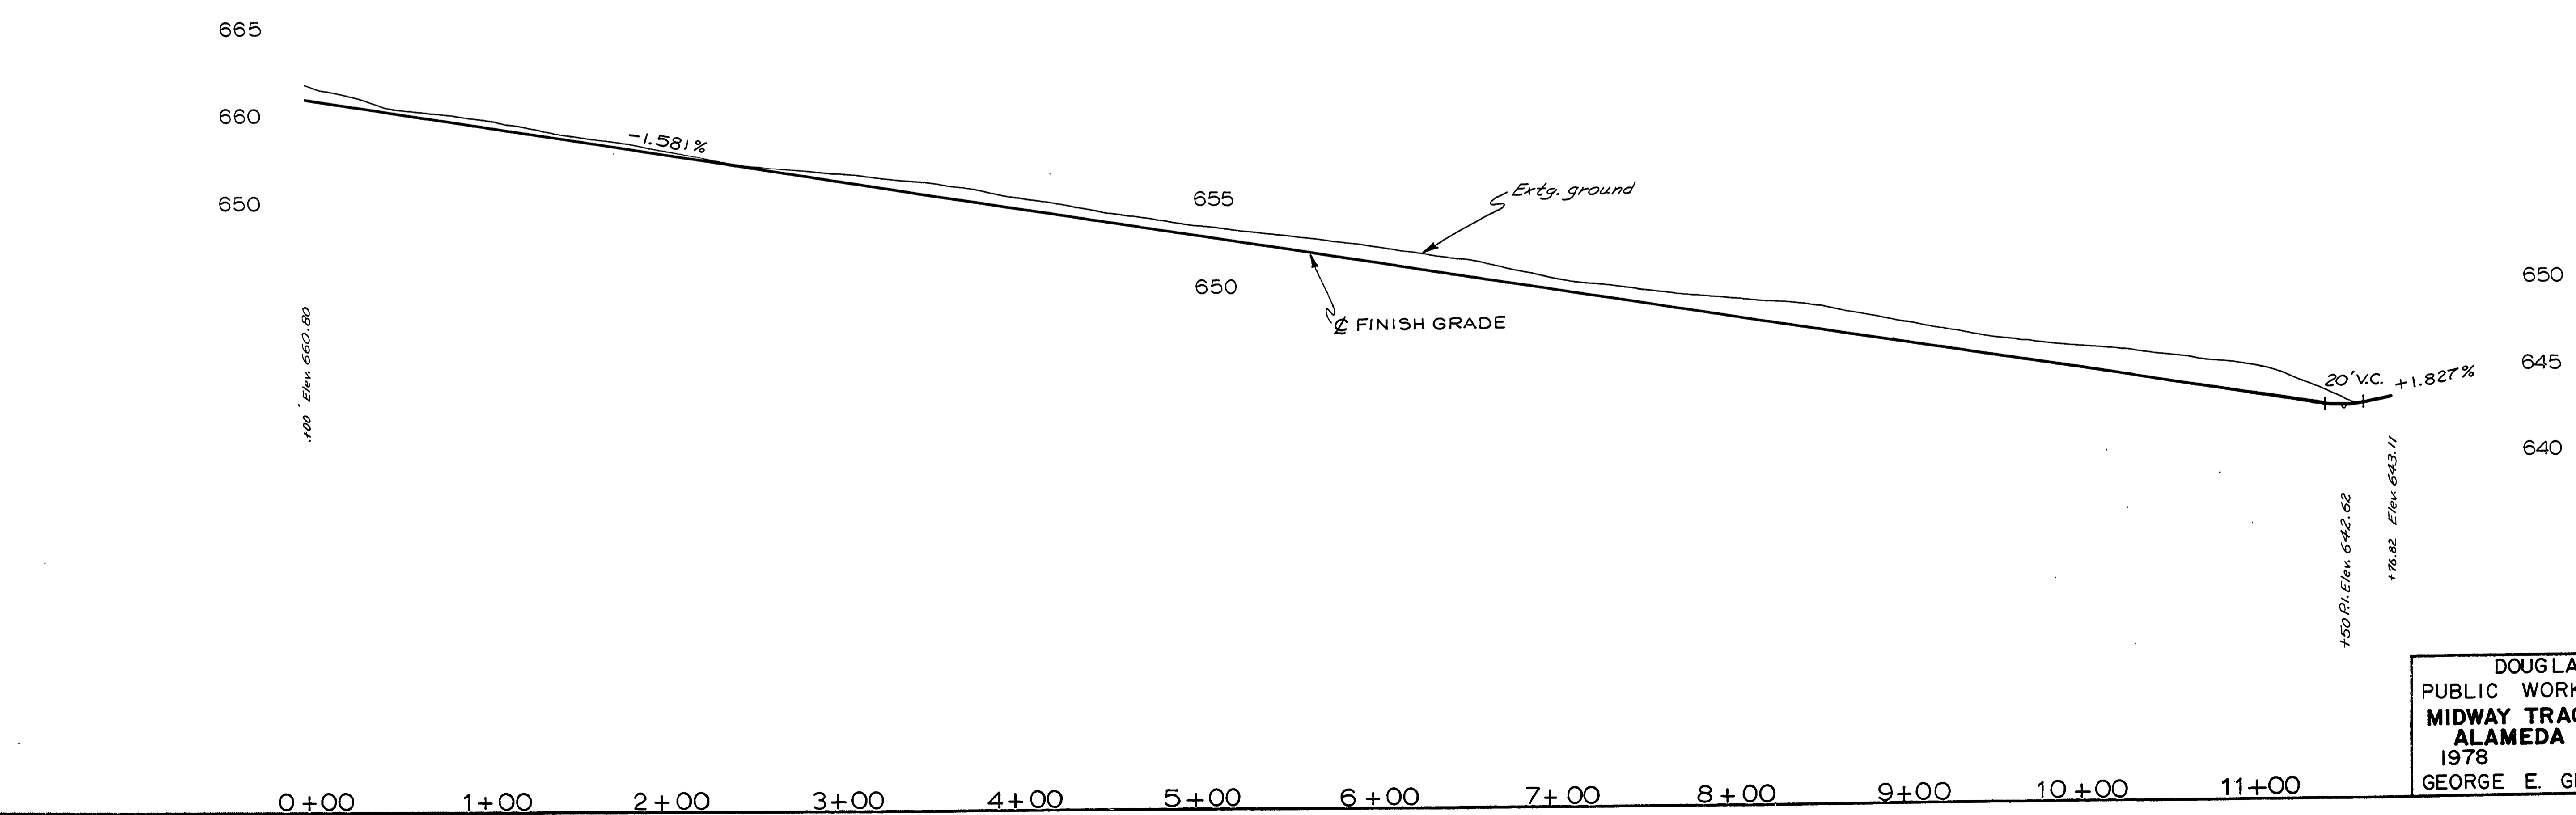

DOUGLAS COUNTY
 PUBLIC WORKS DEPARTMENT
 MIDWAY TRACTS SUBDIVISION
 ALAMEDA ST. ROAD PLAN
 1978 SHT. 3
 GEORGE E. GRUBB, DIRECTOR

RD352E02