

FILED
 Date: 1-31-97 By: J.P.
 This survey consists of:
 Map:
 Narrative:
 Corner Pp:
 DOUGLAS COUNTY SURVEYOR

SCALE: 1"=20'

REVISIONS	DATE	BY	DESCRIPTION
6/11/93			WATERMAIN SIZE & TYPE, NOTES, VALVES, ETC.
9/28/94			C.B. #2 & #6 ELEV.


FILED AS LOGAN CREST ESTATE

EASTVIEW SUBDIVISION WINSTON, OR.

UTILITY PLAN
 WATER, SAN. SEWER
 STORM SEWER

Geomax
 OF OREGON, INC.
 ENGINEERING, LAND SURVEYING, BUILDING DESIGN
 808 N. NINTH STREET COTTAGE GROVE, OREGON 97424
 TELEPHONE - (503) 942-0126 FAX - (503) 942-7935

JOB NO.: 92181 DRAWN: T.F.J. CHECKED: R.E.F.
 DATE: 3/2/93 SH. OF 3

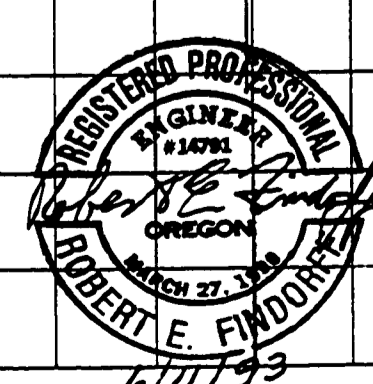

CO. RD. #354-A

RD354A02