


GREEN SANITARY DISTRICT GENERAL CONSTRUCTION SPECIFICATIONS

- ALL SANITARY SEWER WORK SHALL BE IN CONFORMANCE WITH GREEN SANITARY DISTRICT'S STANDARDS, SPECIFICATIONS AND ORDINANCES. COMPLETE CONSTRUCTION PLANS (ALL UTILITIES) TO BE PROVIDED TO DISTRICT FOR PRE-CONSTRUCTION REVIEW.
- SANITARY BUILDING SEWERS SHALL BE CONSTRUCTED IN ACCORDANCE WITH OREGON STATE DEPARTMENT OF COMMERCE, BUILDING CODE (LATEST REVISION) AND ITS AMENDMENTS. 8" AND LARGER PUBLIC SEWERS SHALL BE CONSTRUCTED IN ACCORDANCE WITH DEQ STANDARDS FOR PUBLIC SEWERS AND TO THE LINES, GRADES AND DETAILS SHOWN ON THE PLANS. 4" AND 6" SANITARY BUILDING SEWERS SHALL BE PVC ASTM 3034. ALL LINES SHALL HAVE 12 GAGE INSULATED GREEN TONING WIRE INSTALLED IN THE TRENCH FOR FUTURE LOCATING. CONTRACTOR SHALL INSTALL SEWER LATERALS TO A POINT 5 FEET BEHIND THE PROPERTY LINE OR ANY PUBLIC UTILITY EASMENTS AND LATERALS MUST BE AT LEAST 4 FEET DEEP ON PROPERTY.
- ALL SANITARY BUILDING SEWERS SHALL BE AIR TESTED IN ACCORDANCE WITH APPLICABLE CODE.
- SANITARY SEWER PIPE SHALL BE PVC ASTM 3034 SDR 35. FOR GRADES OVER 15%, USE CEMENT LINED DUCTILE IRON PIPE.
- SANITARY SEWERS SHALL BE AIR TESTED IN ACCORDANCE WITH STANDARD SPECIFICATION, UNIBELL B-0.6.85, AFTER COMPACTION OF BACKFILL.
- SANITARY SEWERS SHALL PASS THE 5% MANDREL DEFLECTION TEST IN ACCORDANCE WITH APPLICABLE APWA SPECIFICATIONS.
- SANITARY SEWERS SHALL BE INSPECTED AFTER CONSTRUCTION WITH A TV CAMERA PER D.E.Q. REQUIREMENTS.
- CONCRETE SHALL BE CLASS 5 (1 1/2" MAXIMUM AGGREGATE SIZE) WITH 6 SACKS OF CEMENT PER CUBIC YARD OF CONCRETE, WITH A MINIMUM COMPRESSIVE STRENGTH OF NOT LESS THAN 3,000 P.S.I. AT 28 DAYS WHEN TESTED IN ACCORDANCE WITH ASTM C-39.86.
- WHEREVER SANITARY SEWERS CROSS WATER LINES WITH LESS THAN 18" VERTICAL CLEARANCE, THE SANITARY SEWER SHALL BE C900 PVC OR DUCTILE IRON PIPE 10" MINIMUM EACH SIDE OF WATER LINE.
- MANHOLES SHALL BE TESTED ACCORDING TO 1990 APWA STANDARD SPECIFICATION 306.6.03. WATER TO BE FILLED TO THE RIM OR VACUUM TESTED IN ACCORDANCE WITH ASTM C-924.86.
- NEW SANITARY SEWER LINES SHALL BE CLEANED WITH A JETTER TRUCK CAPABLE OF PRODUCING 65 GPM AT A PRESSURE OF 1200 PSI MINIMUM. CLEANING SHALL BEGIN AT THE UPSTREAM END OF THE LINE AND PROCEED DOWNSTREAM TO THE BEGINNING OF THE PROJECT. ANY SOIL, ROCKS OR RUBBISH WILL BE REMOVED FROM THE PROJECT SITE.
- ALL MANHOLE CONNECTIONS SHALL BE INSERTA TEE CONNECTORS, OR DISTRICT APPROVED CONNECTION DEVICE.
- CONTRACTOR SHALL PROVIDE PRE-FORMED U SHAPED GASKETS, CONFORMING TO ASTM F-477.
- CONTRACTOR SHALL REPLACE ANY AND ALL SURVEY MONUMENTS WHICH ARE AFFECTED BY THE CONSTRUCTION. ALL MONUMENTS WILL BE RESET BY A LICENSED LAND SURVEYOR. ++GREEN SANITARY DISTRICT FURNISHES THE LICENSED SURVEYOR, CONTRACTOR WILL BE BILLED FOR THE ACTUAL COST OF RESETTING THE MONUMENT OR MONUMENTS.
- CONTRACTOR SHALL PROVIDE GREEN SANITARY DISTRICT WITH A BOND FOR ONE YEAR EQUIVALENT TO THE COST OF THE SEWER PORTION OF THE CONSTRUCTION BID. ++GREEN SANITARY DISTRICT IS TO BE LISTED AS CO-INSURED ON CONTRACTOR'S INSURANCE POLICY.
- ALL TONING WIRE SHALL BE TESTED FOR CONTINUITY BEFORE FINAL SURFACING BY A LICENSED ELECTRICAL CONTRACTOR.
- CONTRACTOR SHALL CONTACT ONE-CALL AT 1-800-332-2344 AT LEAST 48 HOURS PRIOR TO COMMENCING ANY EXCAVATION.
- CONSTRUCTION DOCUMENTS MUST BE APPROVED BY BOTH DEQ AND THE DISTRICT BEFORE THE DISTRICT WILL ISSUE A PERMIT TO CONSTRUCT THE SEWER EXTENSION.
- A PRE-CONSTRUCTION MEETING WILL OCCUR 7 DAYS BEFORE CONSTRUCTION OF SANITARY SEWER.


TYPICAL TRENCH BACK FILL ZONES

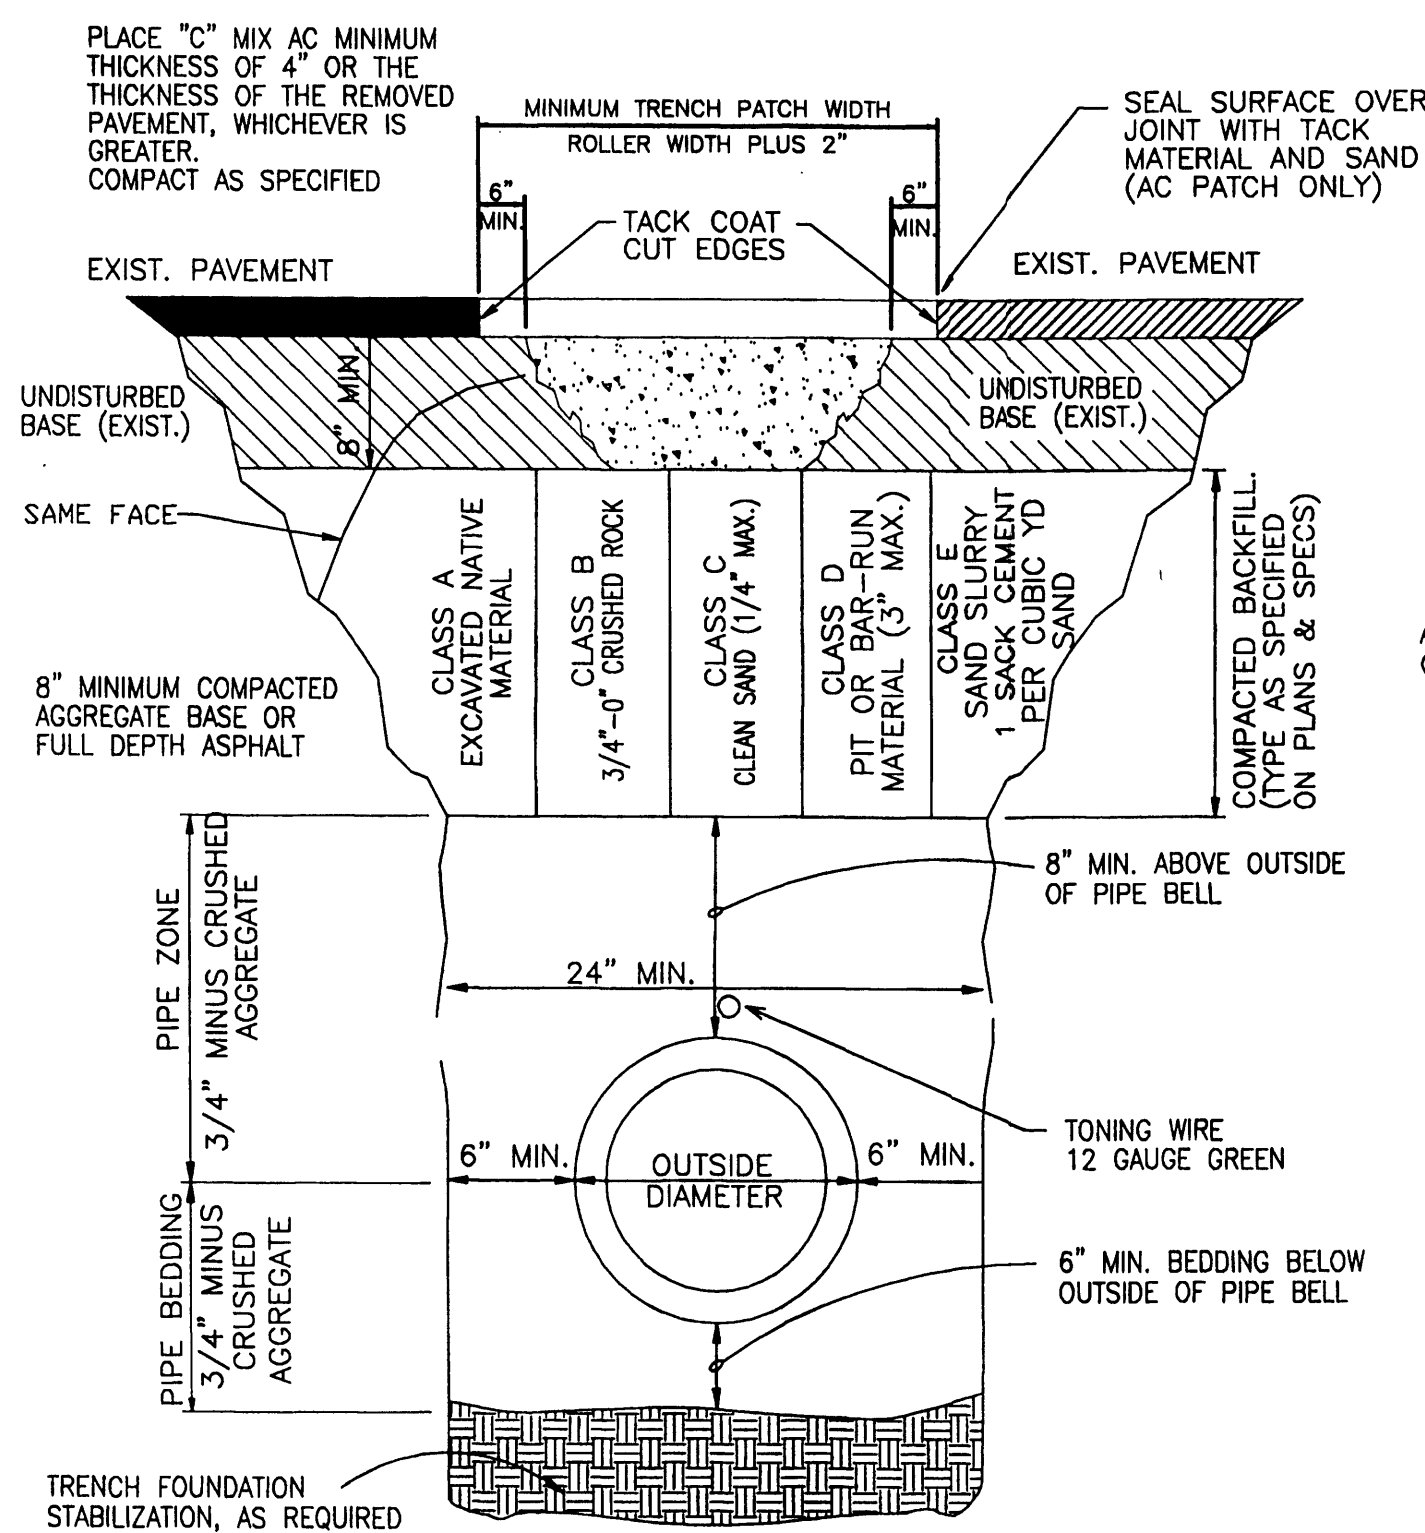


- NOTES:**
- ALL EXISTING AC OR PCC PAVEMENT SHALL BE SAW CUT PRIOR TO REPAVING.
 - CONCRETE PAVEMENT SHALL BE REPLACED WITH CONCRETE TO A MINIMUM THICKNESS OF 6" OR TO THE THICKNESS OF REMOVED PAVEMENT, WHICHEVER IS GREATER.

REVISION DATE APRIL 2002


TYPICAL 4" SEWER SERVICE CONNECTION DETAIL

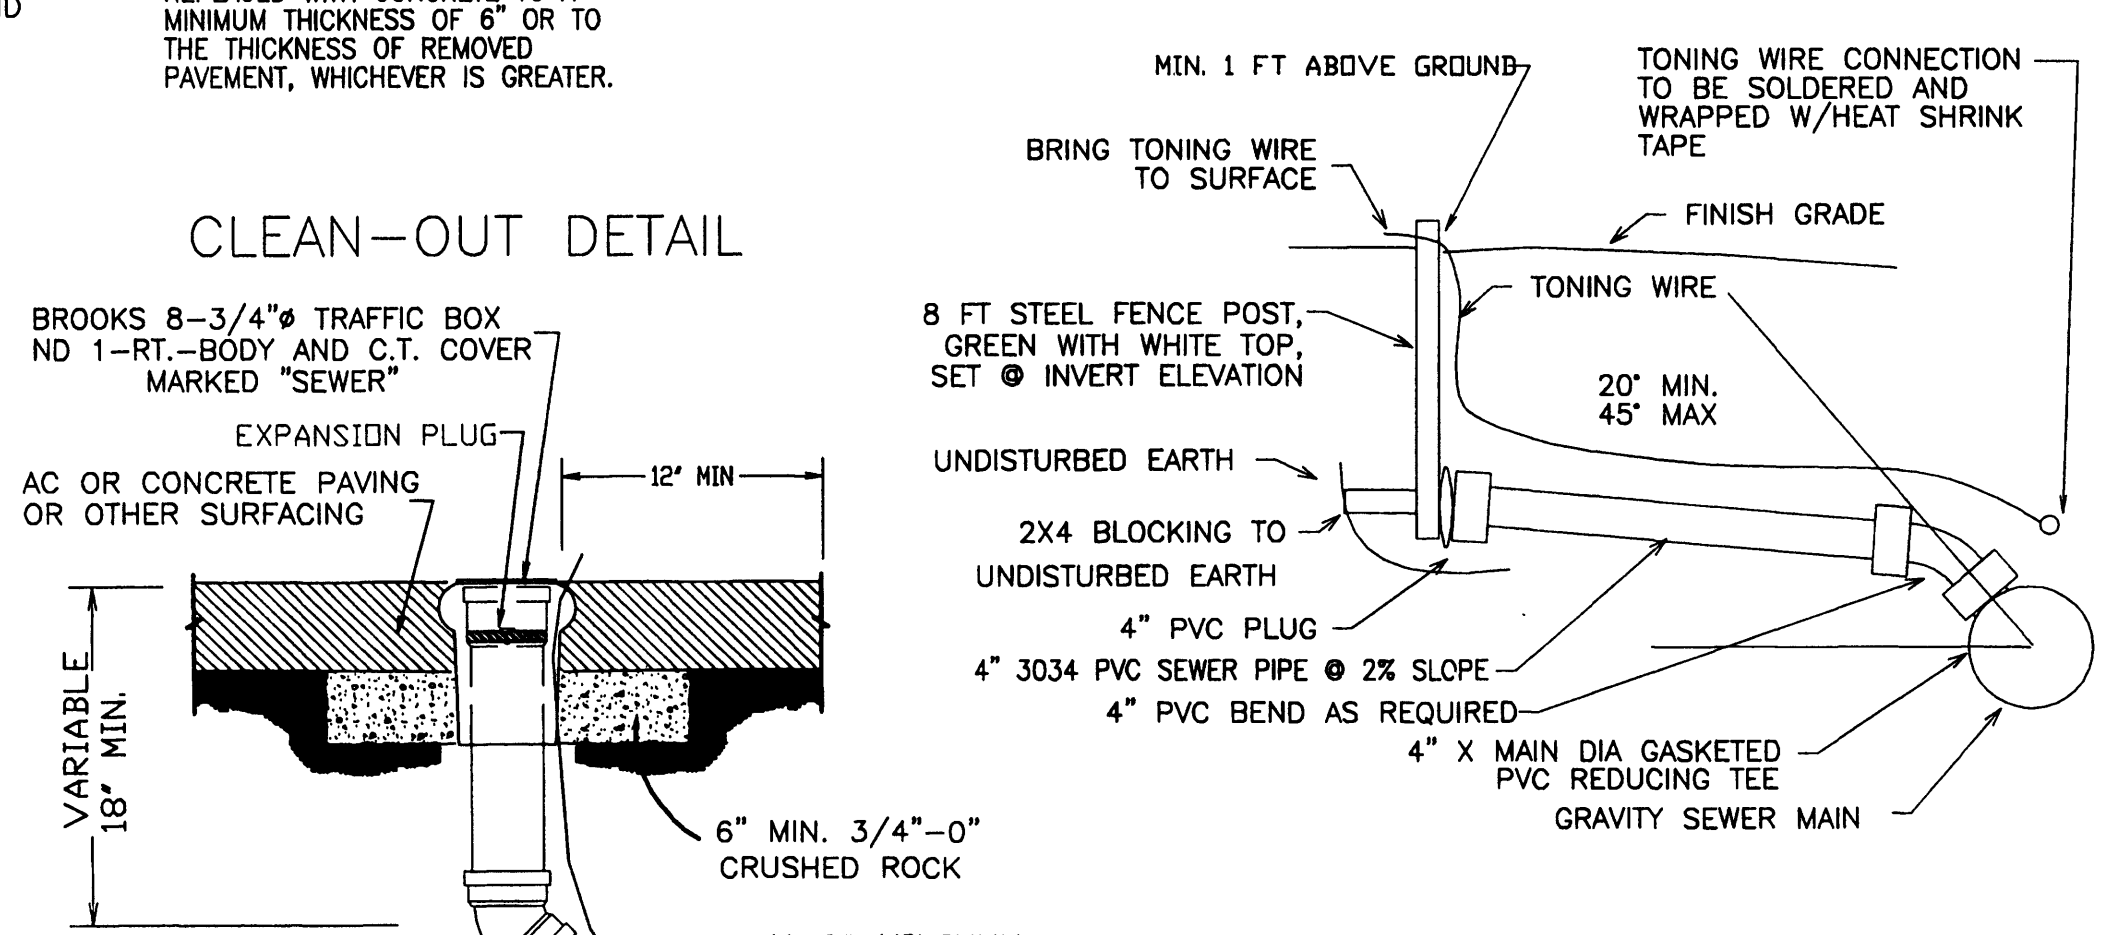


CLEAN-OUT DETAIL

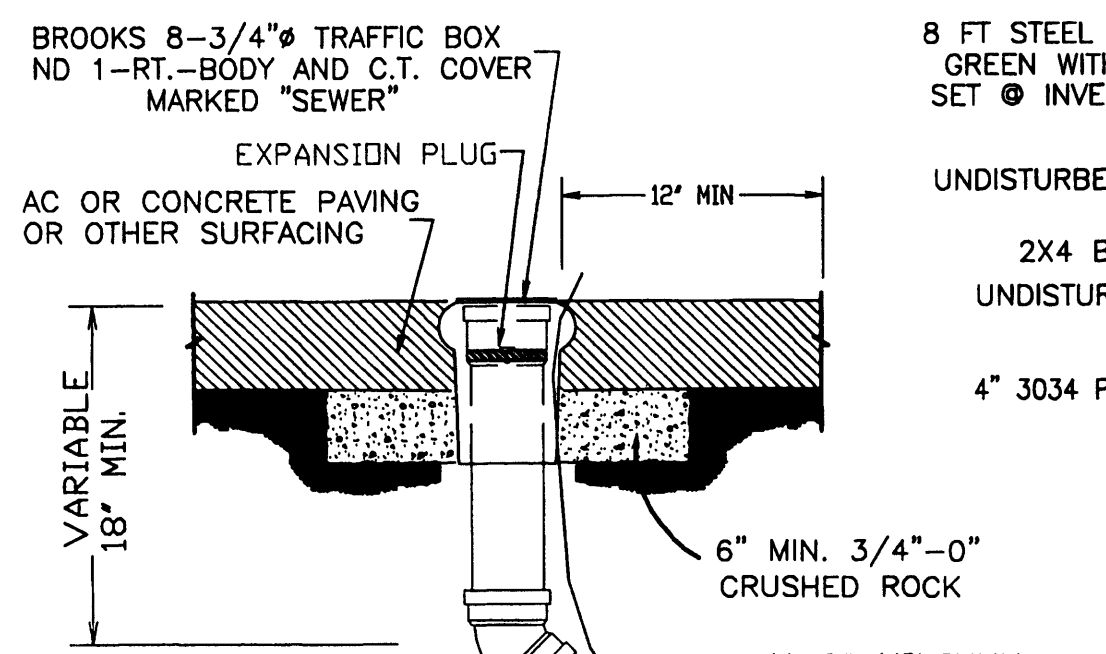


BUILDING LATERAL LINE

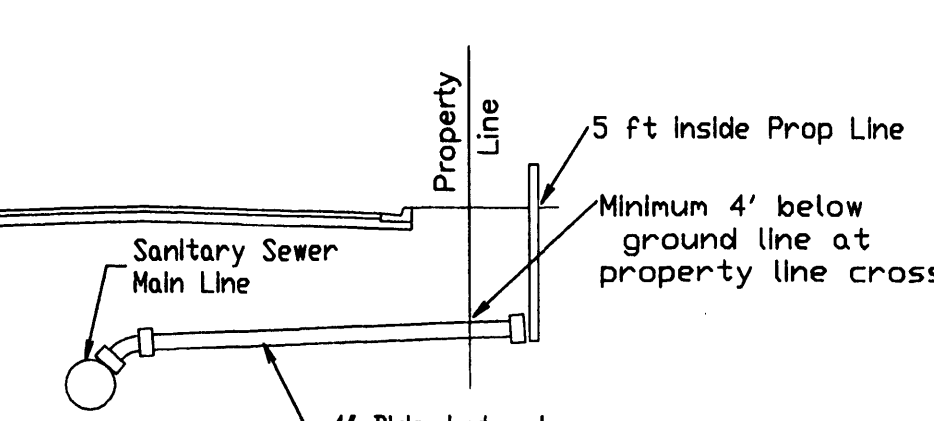

OUTSIDE DROP INLET MANHOLE

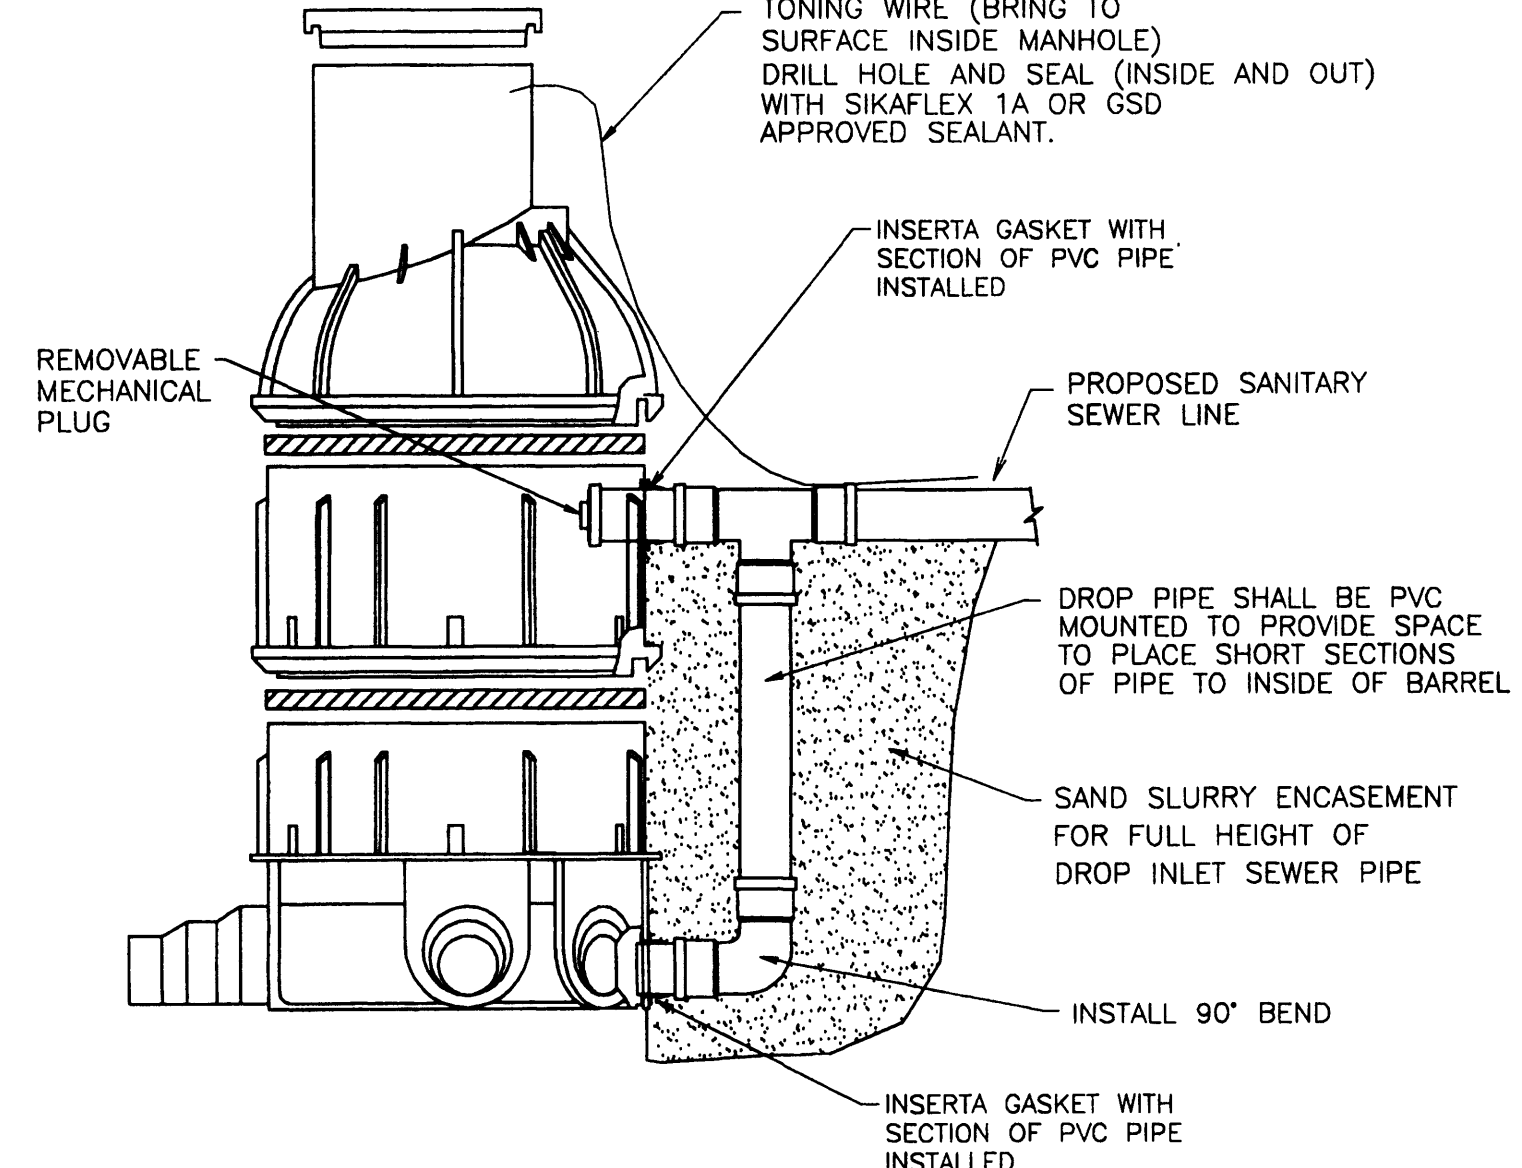


SANITARY ROUND BASE

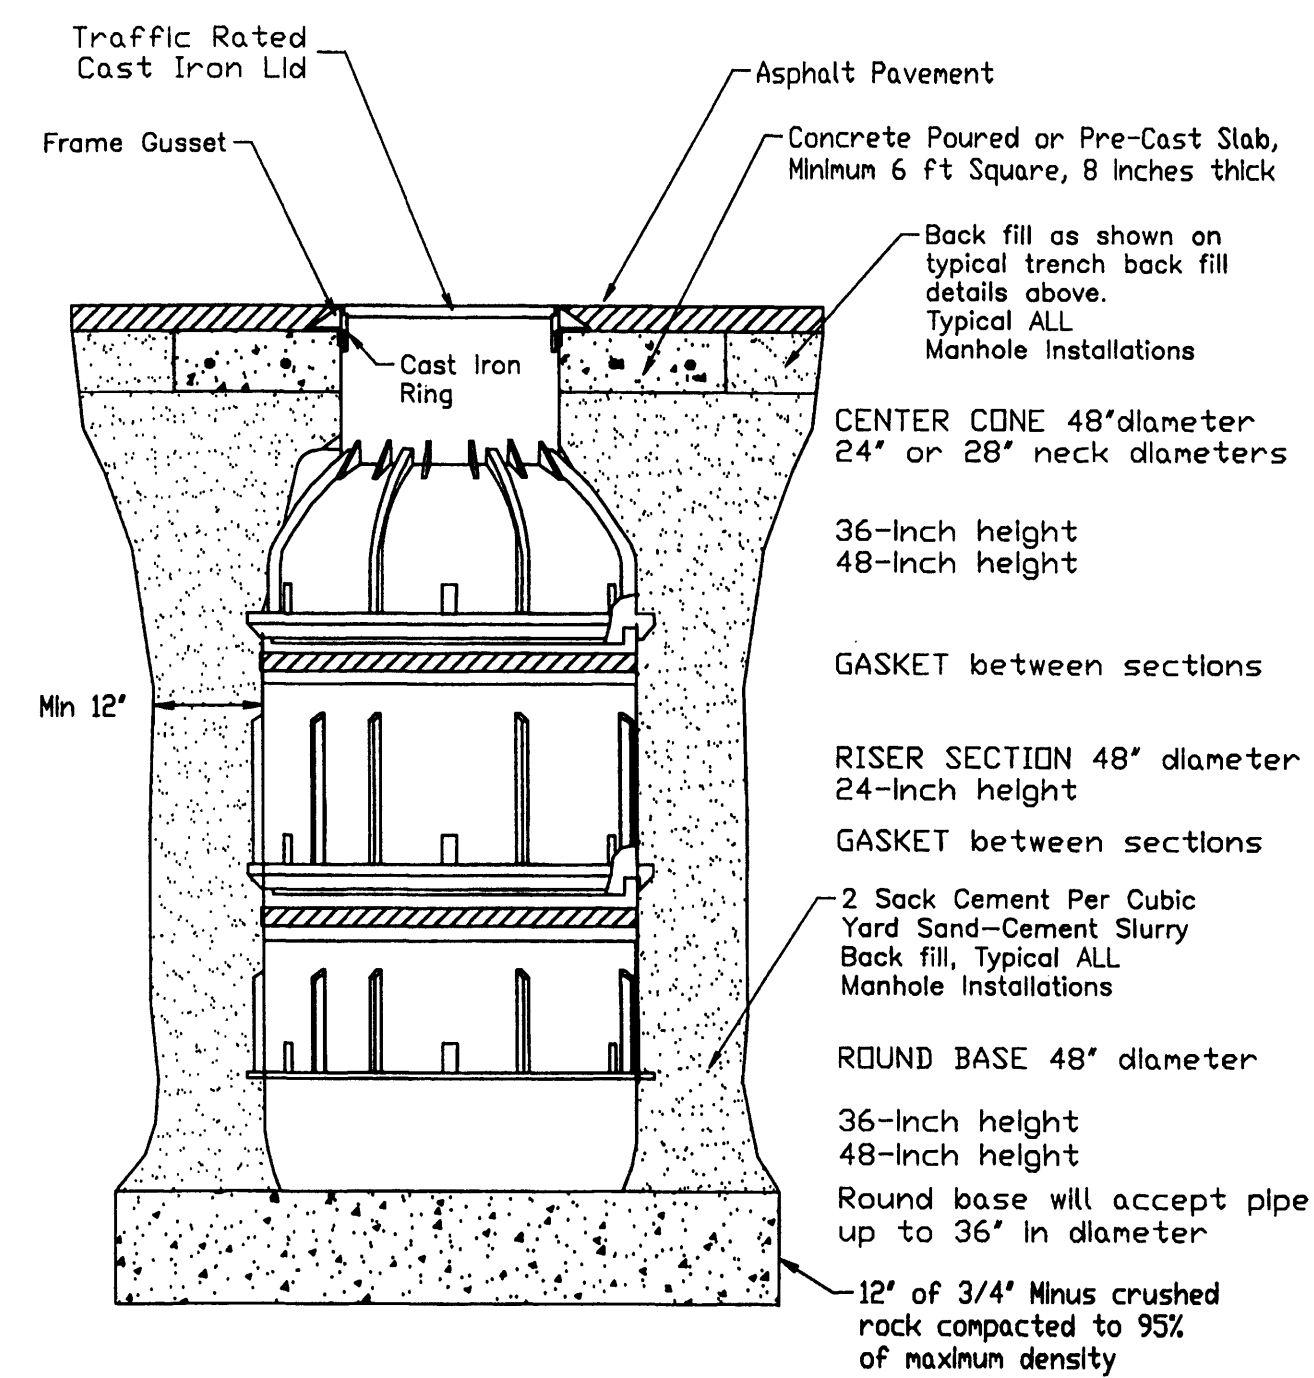


SAVOY COURT AS-BUILTS (10/13/04)

HDPE SANITARY MANHOLE

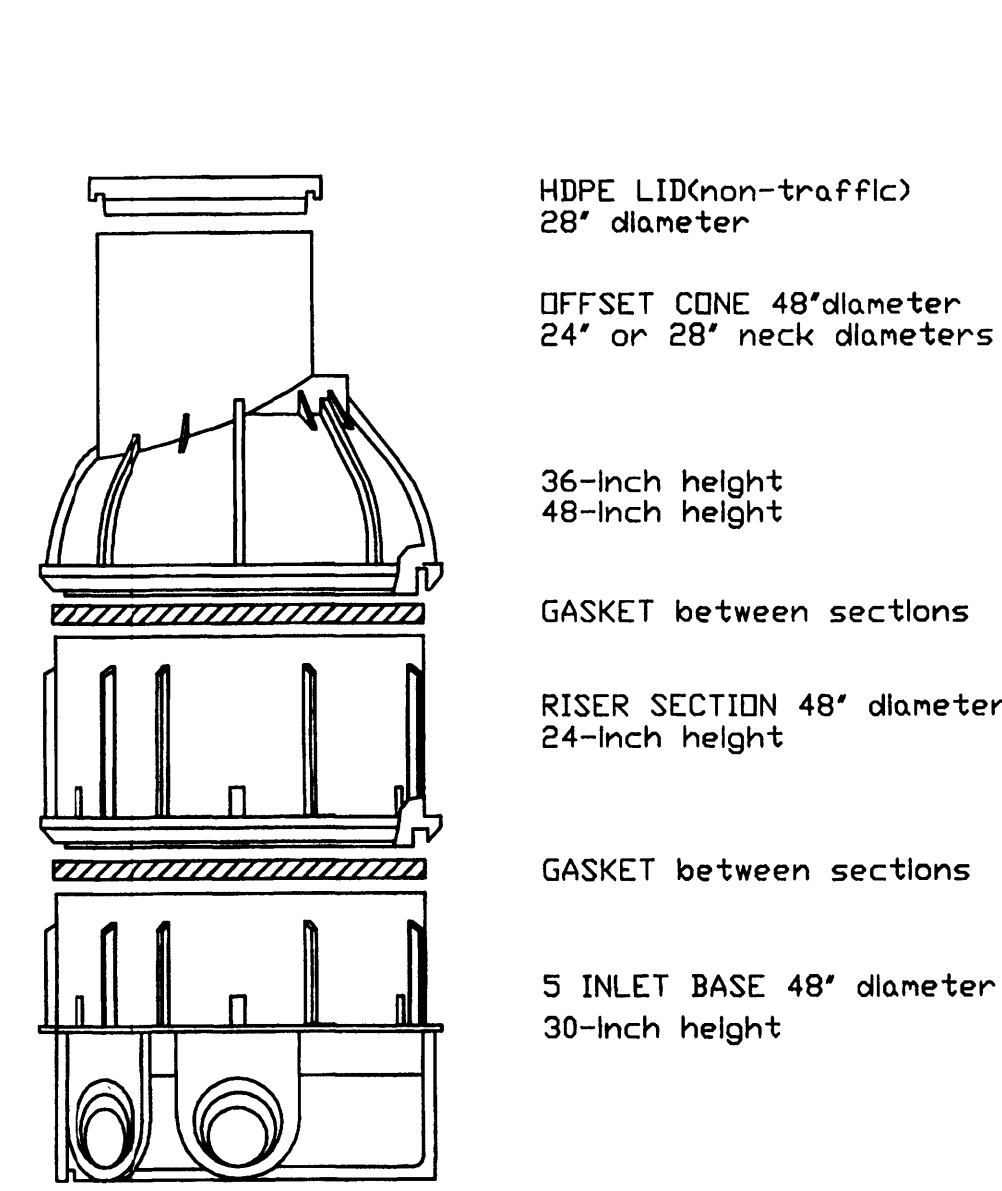

INSERTA TEE CONNECTION DETAILS

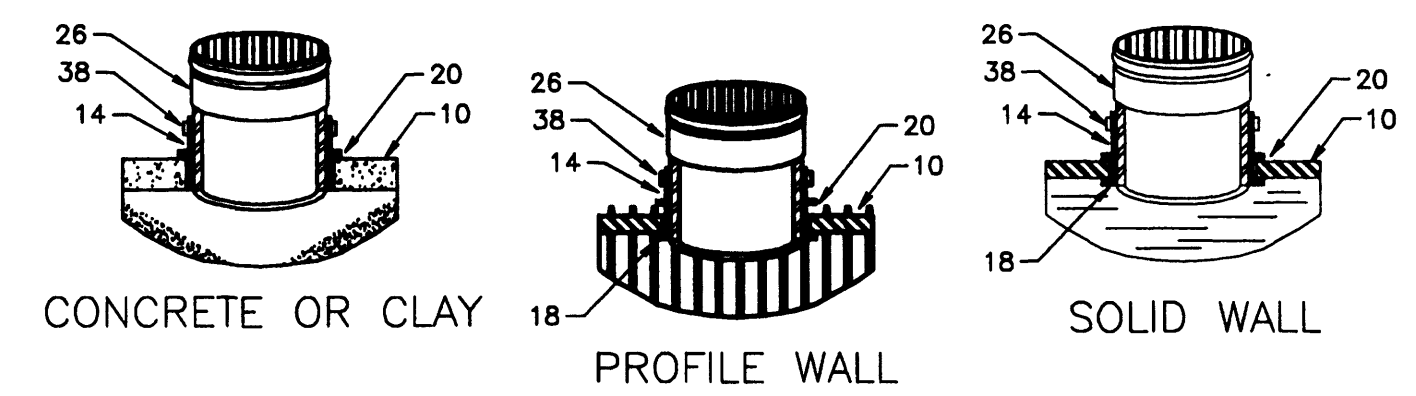

- 10 MAINLINE PIPE WALL WHERE BRANCH LINE IS CONNECTED
- 14 COMPLETE RUBBER SLEEVE CONSISTING OF C-443 SPECIFICATIONS
- 18 RUBBER SEGMENT WHICH IS MOLDED INTO THE RUBBER SLEEVE
- 20 RUBBER SEGMENT WHICH IS MOLDED INTO THE RUBBER SLEEVE
- 26 SDR-26 PVC HUB (ASTM D-3034) WHICH IS DRIVEN INTO THE CENTER OF THE RUBBER SLEEVE AFTER THE RUBBER SLEEVE IS IN THE HOLE
- 38 STAINLESS STEEL BAND, PUT ON ABOVE 20 AS AN ADDED PRECAUTION

INSERTA TEE INSTALLATION INSTRUCTIONS

BITS	INSERTA TEE SIZE	BIT (HOLE) DIAMETER
	4" (100 MM)	4 1/2" (112.5 MM)
	6" (150 MM)	6 1/2" (162.5 MM)
	8" (200 MM)	8 3/4" (218.8 MM)
	10" (250 MM)	10 7/8" (271.9 MM)
	12" (300 MM)	12 7/8" (321.9 MM)
	15" (375 MM)	15 13/16" (395.3 MM)



INSERTA TEE INSTALLATION PROCEDURE

- CORE THE PROPER SIZE HOLE AS SHOWN ABOVE
- INSERT THE RUBBER SLEEVE INTO THE CORED HOLE WITH THE GOLD VERTICAL LINE ON THE RUBBER SLEEVE FACING TO THE SIDE OF THE MAINLINE. THE UPPER SEGMENT SHOULD BE ON THE TOP OF THE WALL OR RIB AND THE LOWER SEGMENT (PVC, RIBBED & POLYETHYLENE PIPE ONLY) SHOULD BE ON THE INSIDE OF THE PIPE.
- APPLY THE INSERTA TEE SOLUTION SUPPLIED TO THE INSIDE OF THE RUBBER SLEEVE AND TO THE OUTSIDE OF THE PVC HUB ADAPTER. CAUTION! USING PIPE LUBE MAY RESULT IN HUB ADAPTER POPPING OUT
- PLACE THE PVC HUB ADAPTER INTO THE RUBBER SLEEVE. MAKE SURE THAT THE RED VERTICAL LINE ON THE PVC HUB ADAPTER IS IN LINE WITH THE GOLD VERTICAL LINE ON THE RUBBER SLEEVE.
- PLACE THE 2X4 BOARD ON TOP OF THE PVC HUB ADAPTER.
- THE RED HORIZONTAL LINE AT THE TOP OF THE HUB ADAPTER IS A DEPTH MARK. THIS TELLS THE INSTALLER JUST HOW FAR TO DRIVE THE ADAPTER INTO THE RUBBER SLEEVE. USING THE BOARD AND HAMMER, DRIVE THE PVC HUB ADAPTER INTO THE RUBBER SLEEVE TO WHERE THE HORIZONTAL RED LINE ON THE PVC HUB ADAPTER MEETS THE TOP OF THE RUBBER SLEEVE.
- PLACE THE STAINLESS BAND AROUND THE TOP OF THE RUBBER SLEEVE AND TIGHTEN DOWN
- INSTALL SIDE SERVICE PIPE IN NORMAL MANNER


SPECIFICATIONS FOR POLYETHYLENE MANHOLES

- THIS SPECIFICATION COVERS MATERIALS, MANUFACTURE, DIMENSIONS, AND REQUIREMENTS FOR POLYETHYLENE MANHOLES USED WITH SEWERAGE OR DRAINAGE PIPE AND OR UNDERGROUND CONDUITS WITH OUTSIDE DIAMETERS OF LESS THAN 46 INCHES. MANHOLES SHALL BE MANUFACTURED OF HDPE OR APPROVED EQUAL MEETING THE FOLLOWING SPECIFICATIONS: ASTM D-833; ASTM D-3350; ASTM D-2122; ASTM F-412; ASTM F-2412; ASTM F-477
- MANHOLES SHALL BE PRODUCED BY THE ROTATIONAL MOLDING PROCESS AND CONSIST OF THE REQUIRED COMBINATIONS OF BASE, RISER, STIFFENING/ANCHOR RING, AND CONE SECTION AS REQUIRED BY ASTM F-477.
- INTERIOR ACCESS SHALL BE PROVIDED WITH NONMETALLIC FACTORY-MOLDED STEPS.
- SEGMENTED JOINTS SHALL BE BELL AND SPIGOT WITH A U SHAPED GASKET, CONFORMING TO ASTM F-477.
- ANCHOR RINGS SHALL BE AT EACH JOINT AND EXTEND 2.5 INCHES FROM MANHOLE O.D.
- STIFFENER RINGS SHALL BE EQUAL TO OR LESS THAN 24 INCHES APART LONGITUDINALLY AND CIRCUMFERENTIALLY AROUND THE BARREL.
- CONCRETE MANHOLES MAY BE SUBSTITUTED IN EXTRAORDINARY CIRCUMSTANCES AT THE DISTRICTS DESCRETION.

OUTSIDE DROP INLET MANHOLE

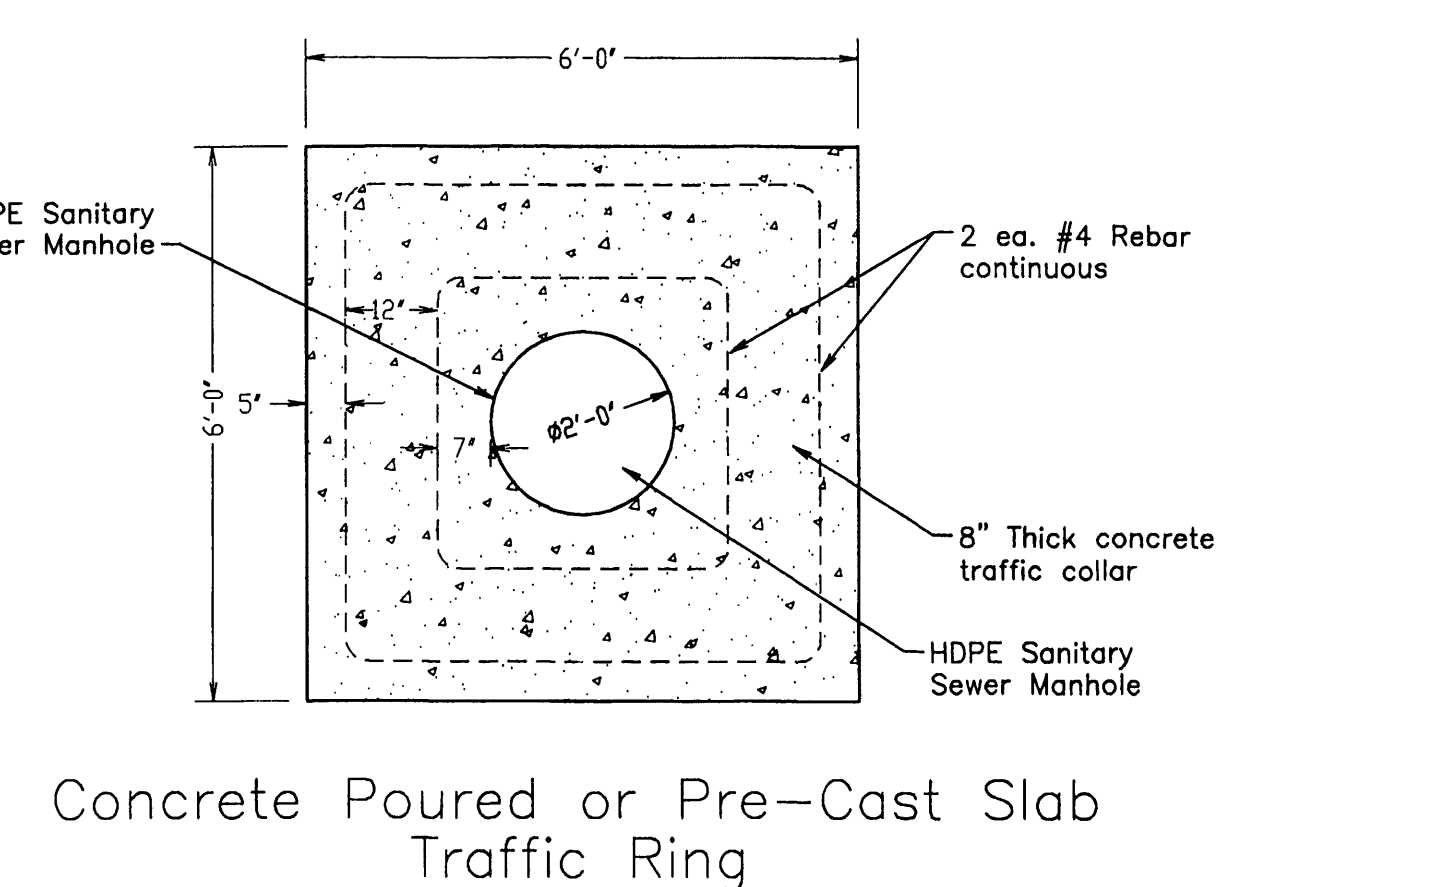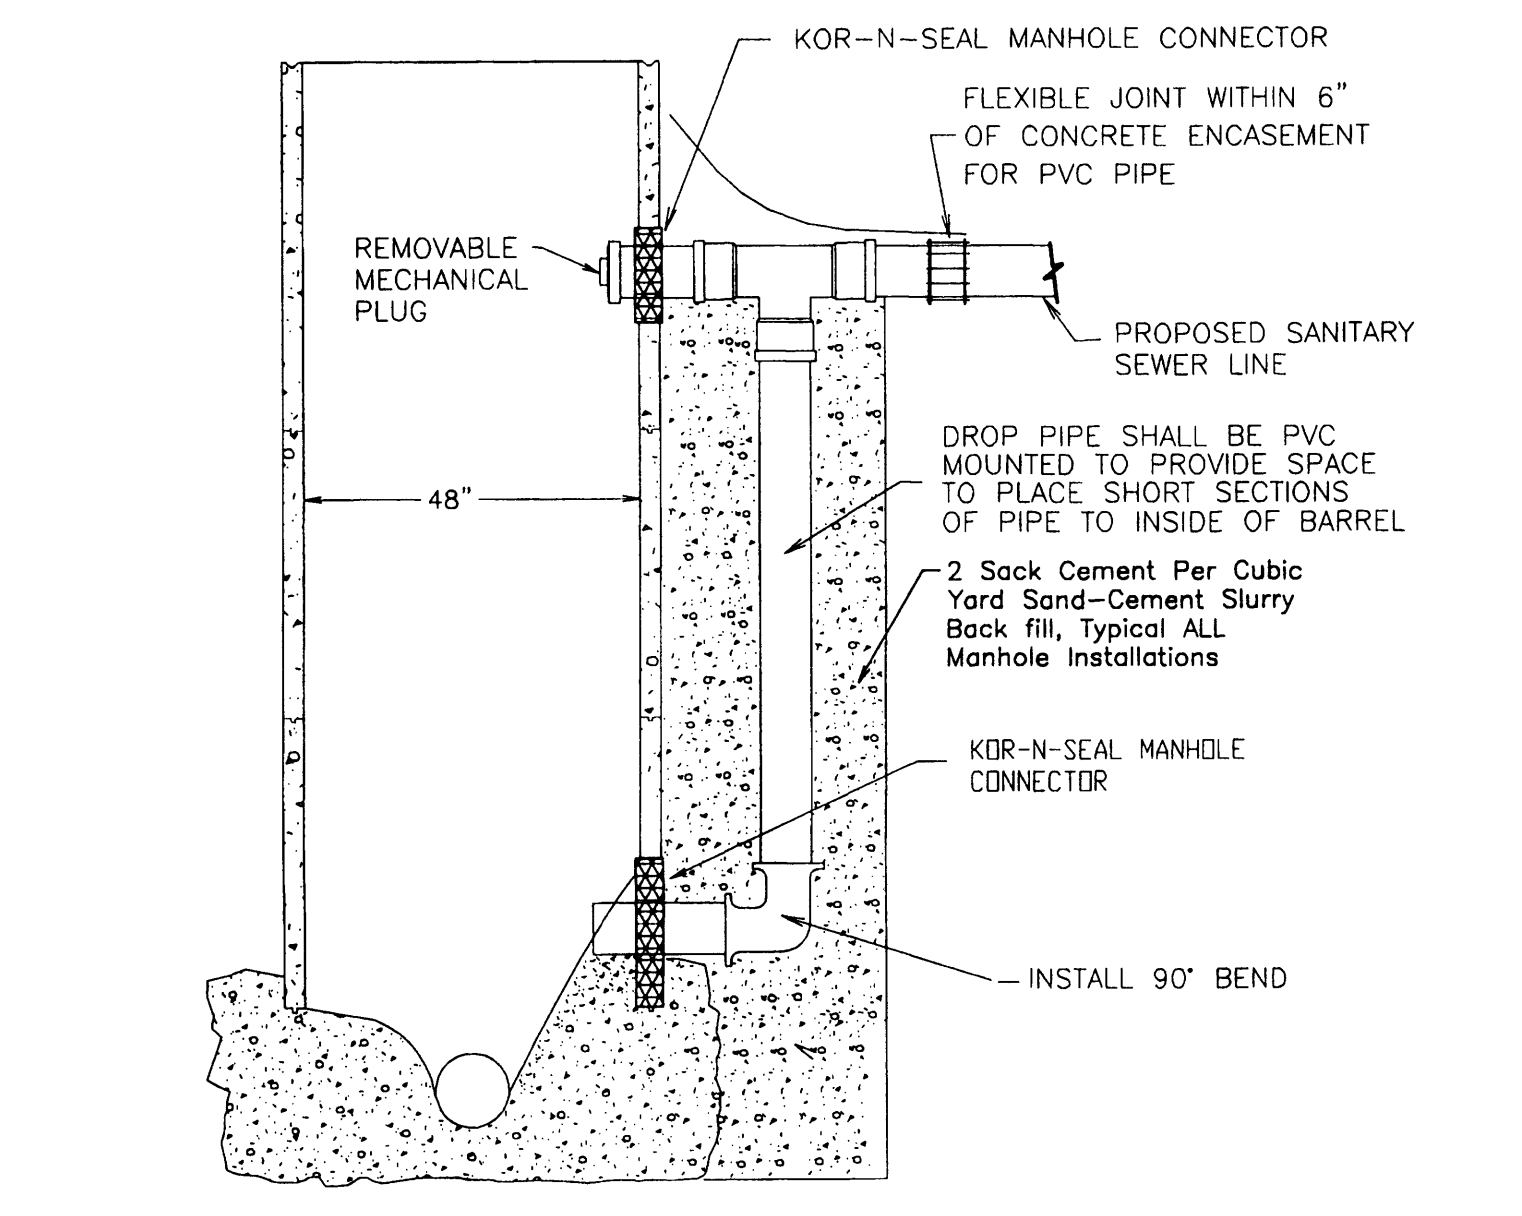

5 INLET SANITARY BASE

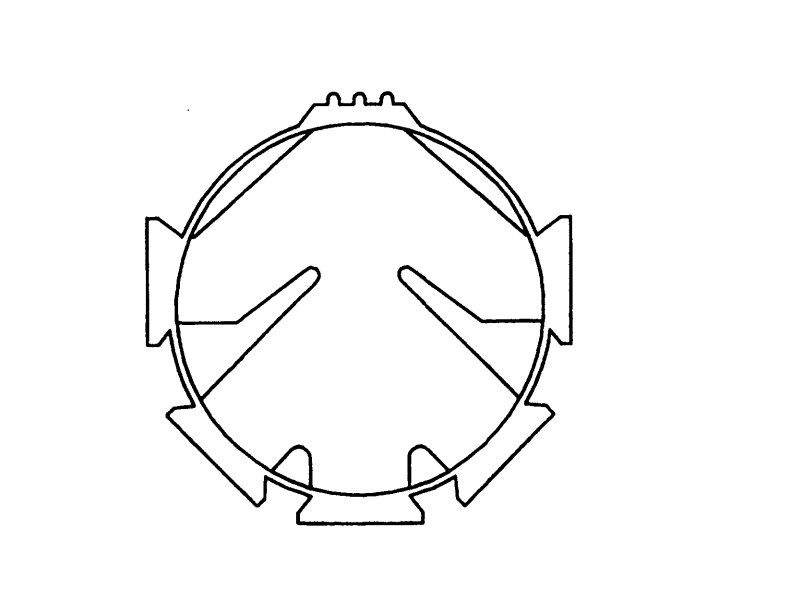

GREEN SANITARY DISTRICT

FILED
Date: 6-21-2005 By: JLD
This survey consists of:
Map:
Narrative:
Corner Pkt:
DOUGLAS COUNTY SURVEYOR

GREEN SANITARY DISTRICT CONSTRUCTION SPECIFICATIONS

GREEN SANITARY DISTRICT
3879 OLD HIGHWAY 99 S
ROSEBURG, OR 97470
PH (541) 679-7191

SANITARY SEWER LINE CONSTRUCTION DETAILS AND SPECIFICATIONS

SHEET 8 of 9

354GSD1