


1
6 SEWERLINE PLAN
1" = 40'

FILED
Date: 6-22-2005 By: J.P.
This survey consists of:
Map:
Name:
Corner Pkt:
DOUGLAS COUNTY
SURVEYOR

OWNER: STULL ENTERPRISES
PROJECT: SAVOY COURT SUBDIVISION
SHEET TITLE: SAVOY COURT SANITARY SEWER PLAN & PROFILE
BTS ENGINEERING & SURVEYING, INC.
411 S.E. MAIN ST., ROSSBURG, OR 97470
PHONE (503) 673-9866 FAX (503) 673-0105

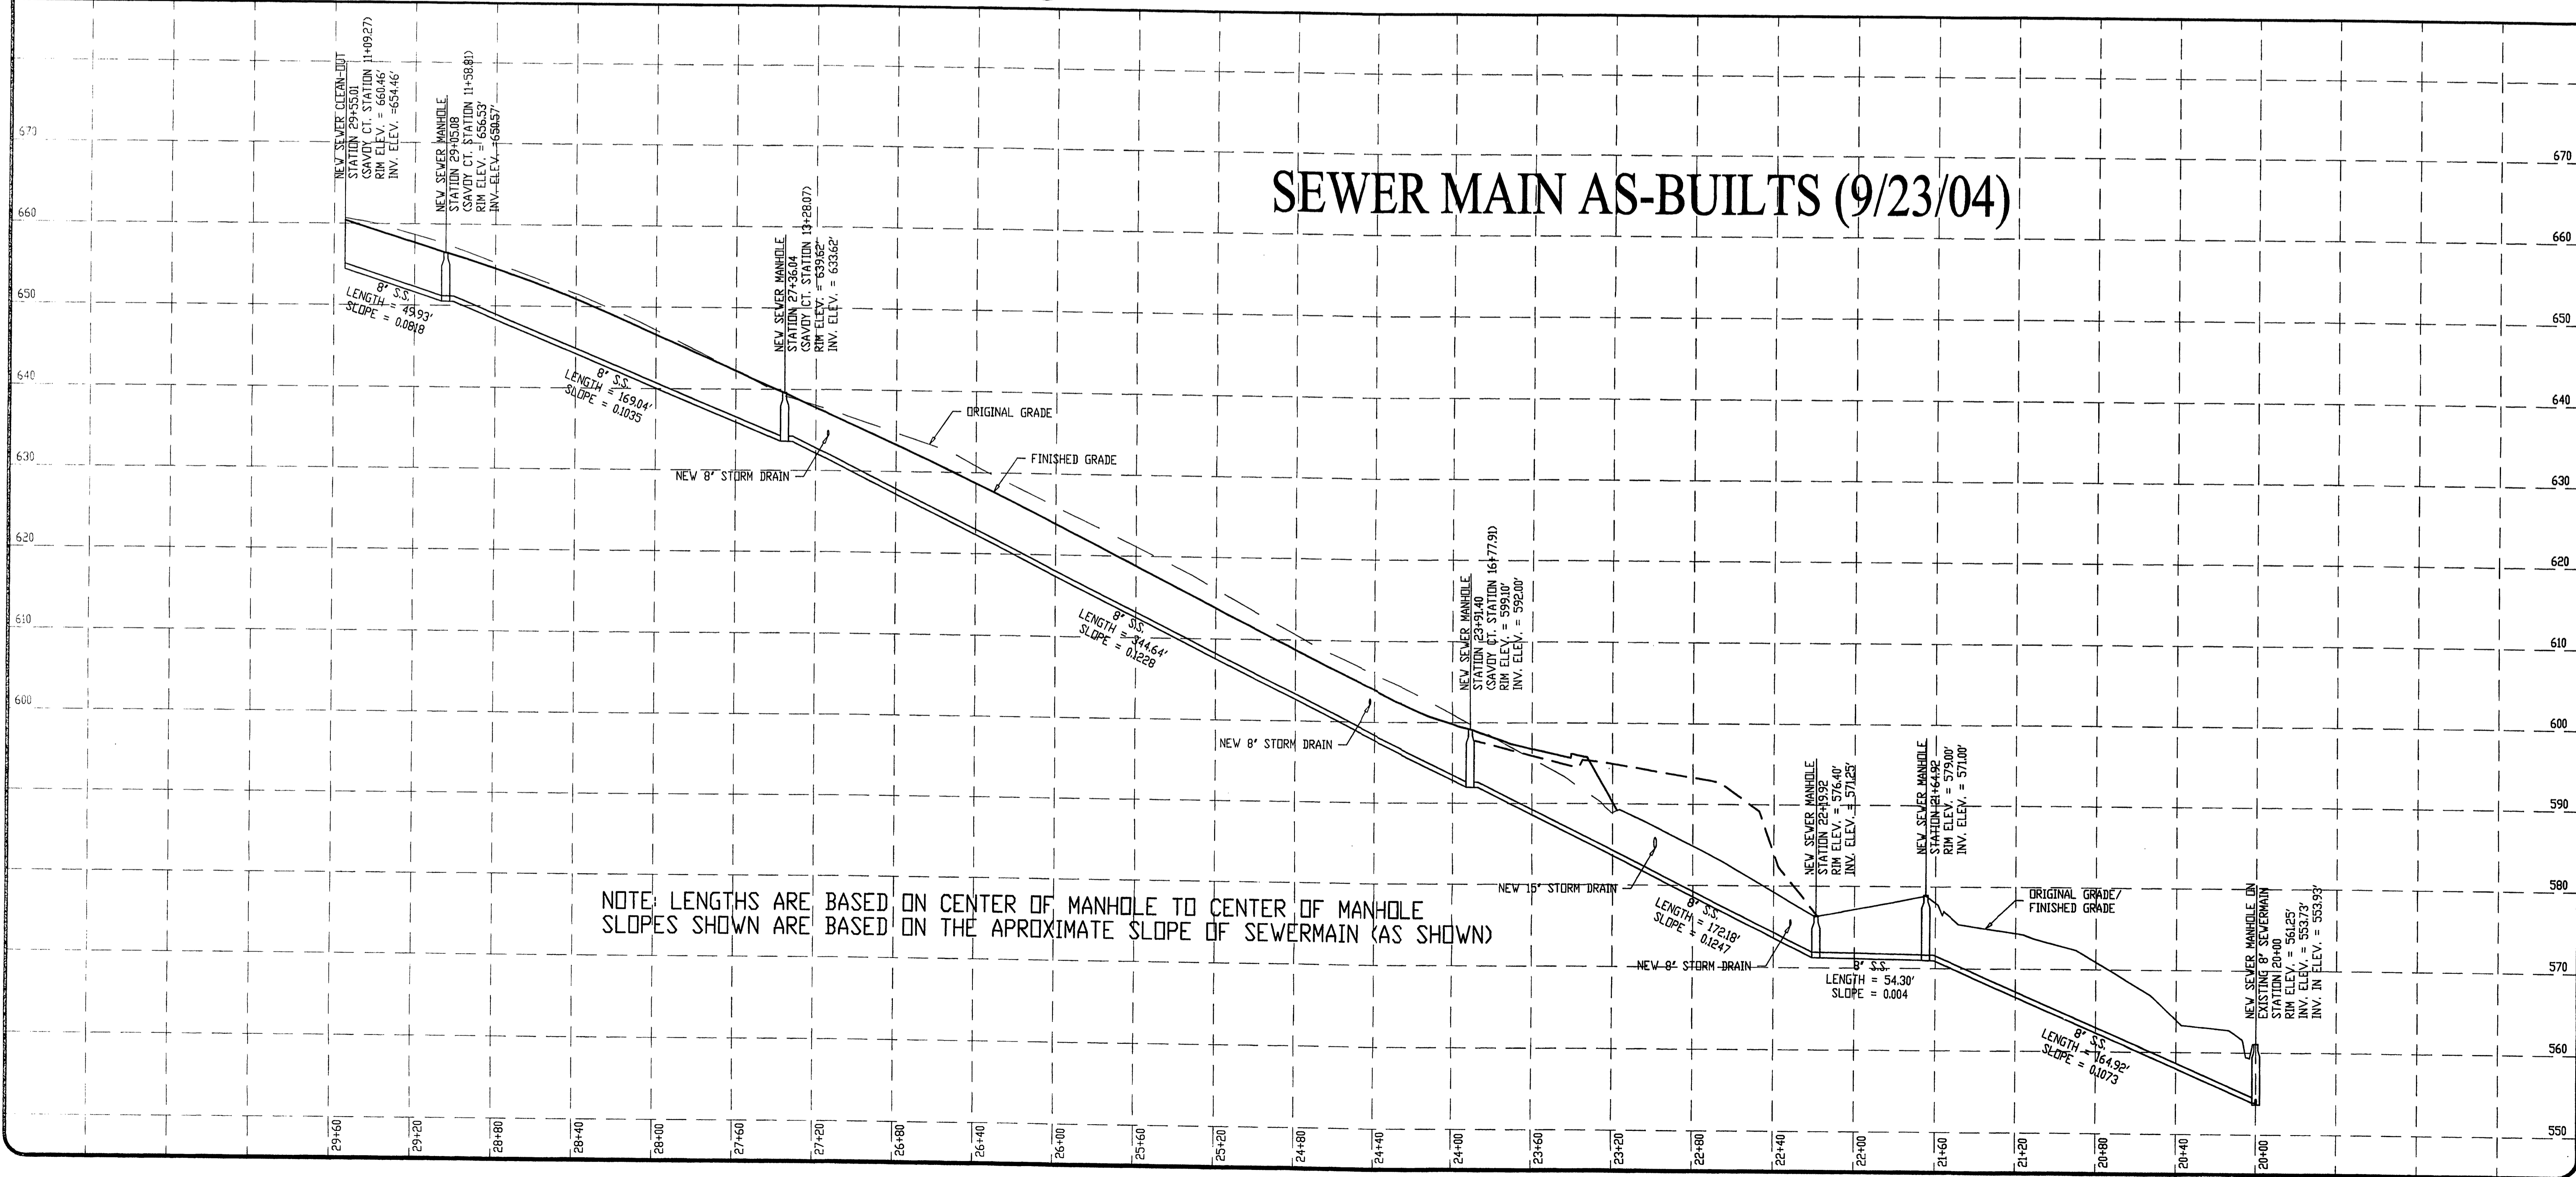


NOTE: LENGTHS ARE BASED ON CENTER OF MANHOLE TO CENTER OF MANHOLE
SLOPES SHOWN ARE BASED ON THE APPROXIMATE SLOPE OF SEWERMAIN (AS SHOWN)

SEWER MAIN AS-BUILTS (9/23/04)

PROJECT: SAVOY COURT SUBDIVISION
SHEET TITLE: SAVOY COURT SANITARY SEWER PLAN & PROFILE

DATE:	MAY 20, 2004
REV. #1:	
REV. #2:	
REV. #3:	
REV. #4:	
REV. #5:	

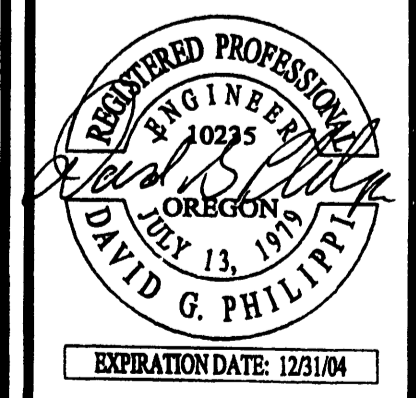

PROJ. # 04-011
SHEET NO. 6 of 9