


FILED
 Date: 3/19/2006, Rv: JP
 This survey consists of:
 Map: _____
 Narrative: _____
 Corner Rot: _____
 DOUGLAS COUNTY
 SURVEYOR

HATCH KEY
 PHASE 1A

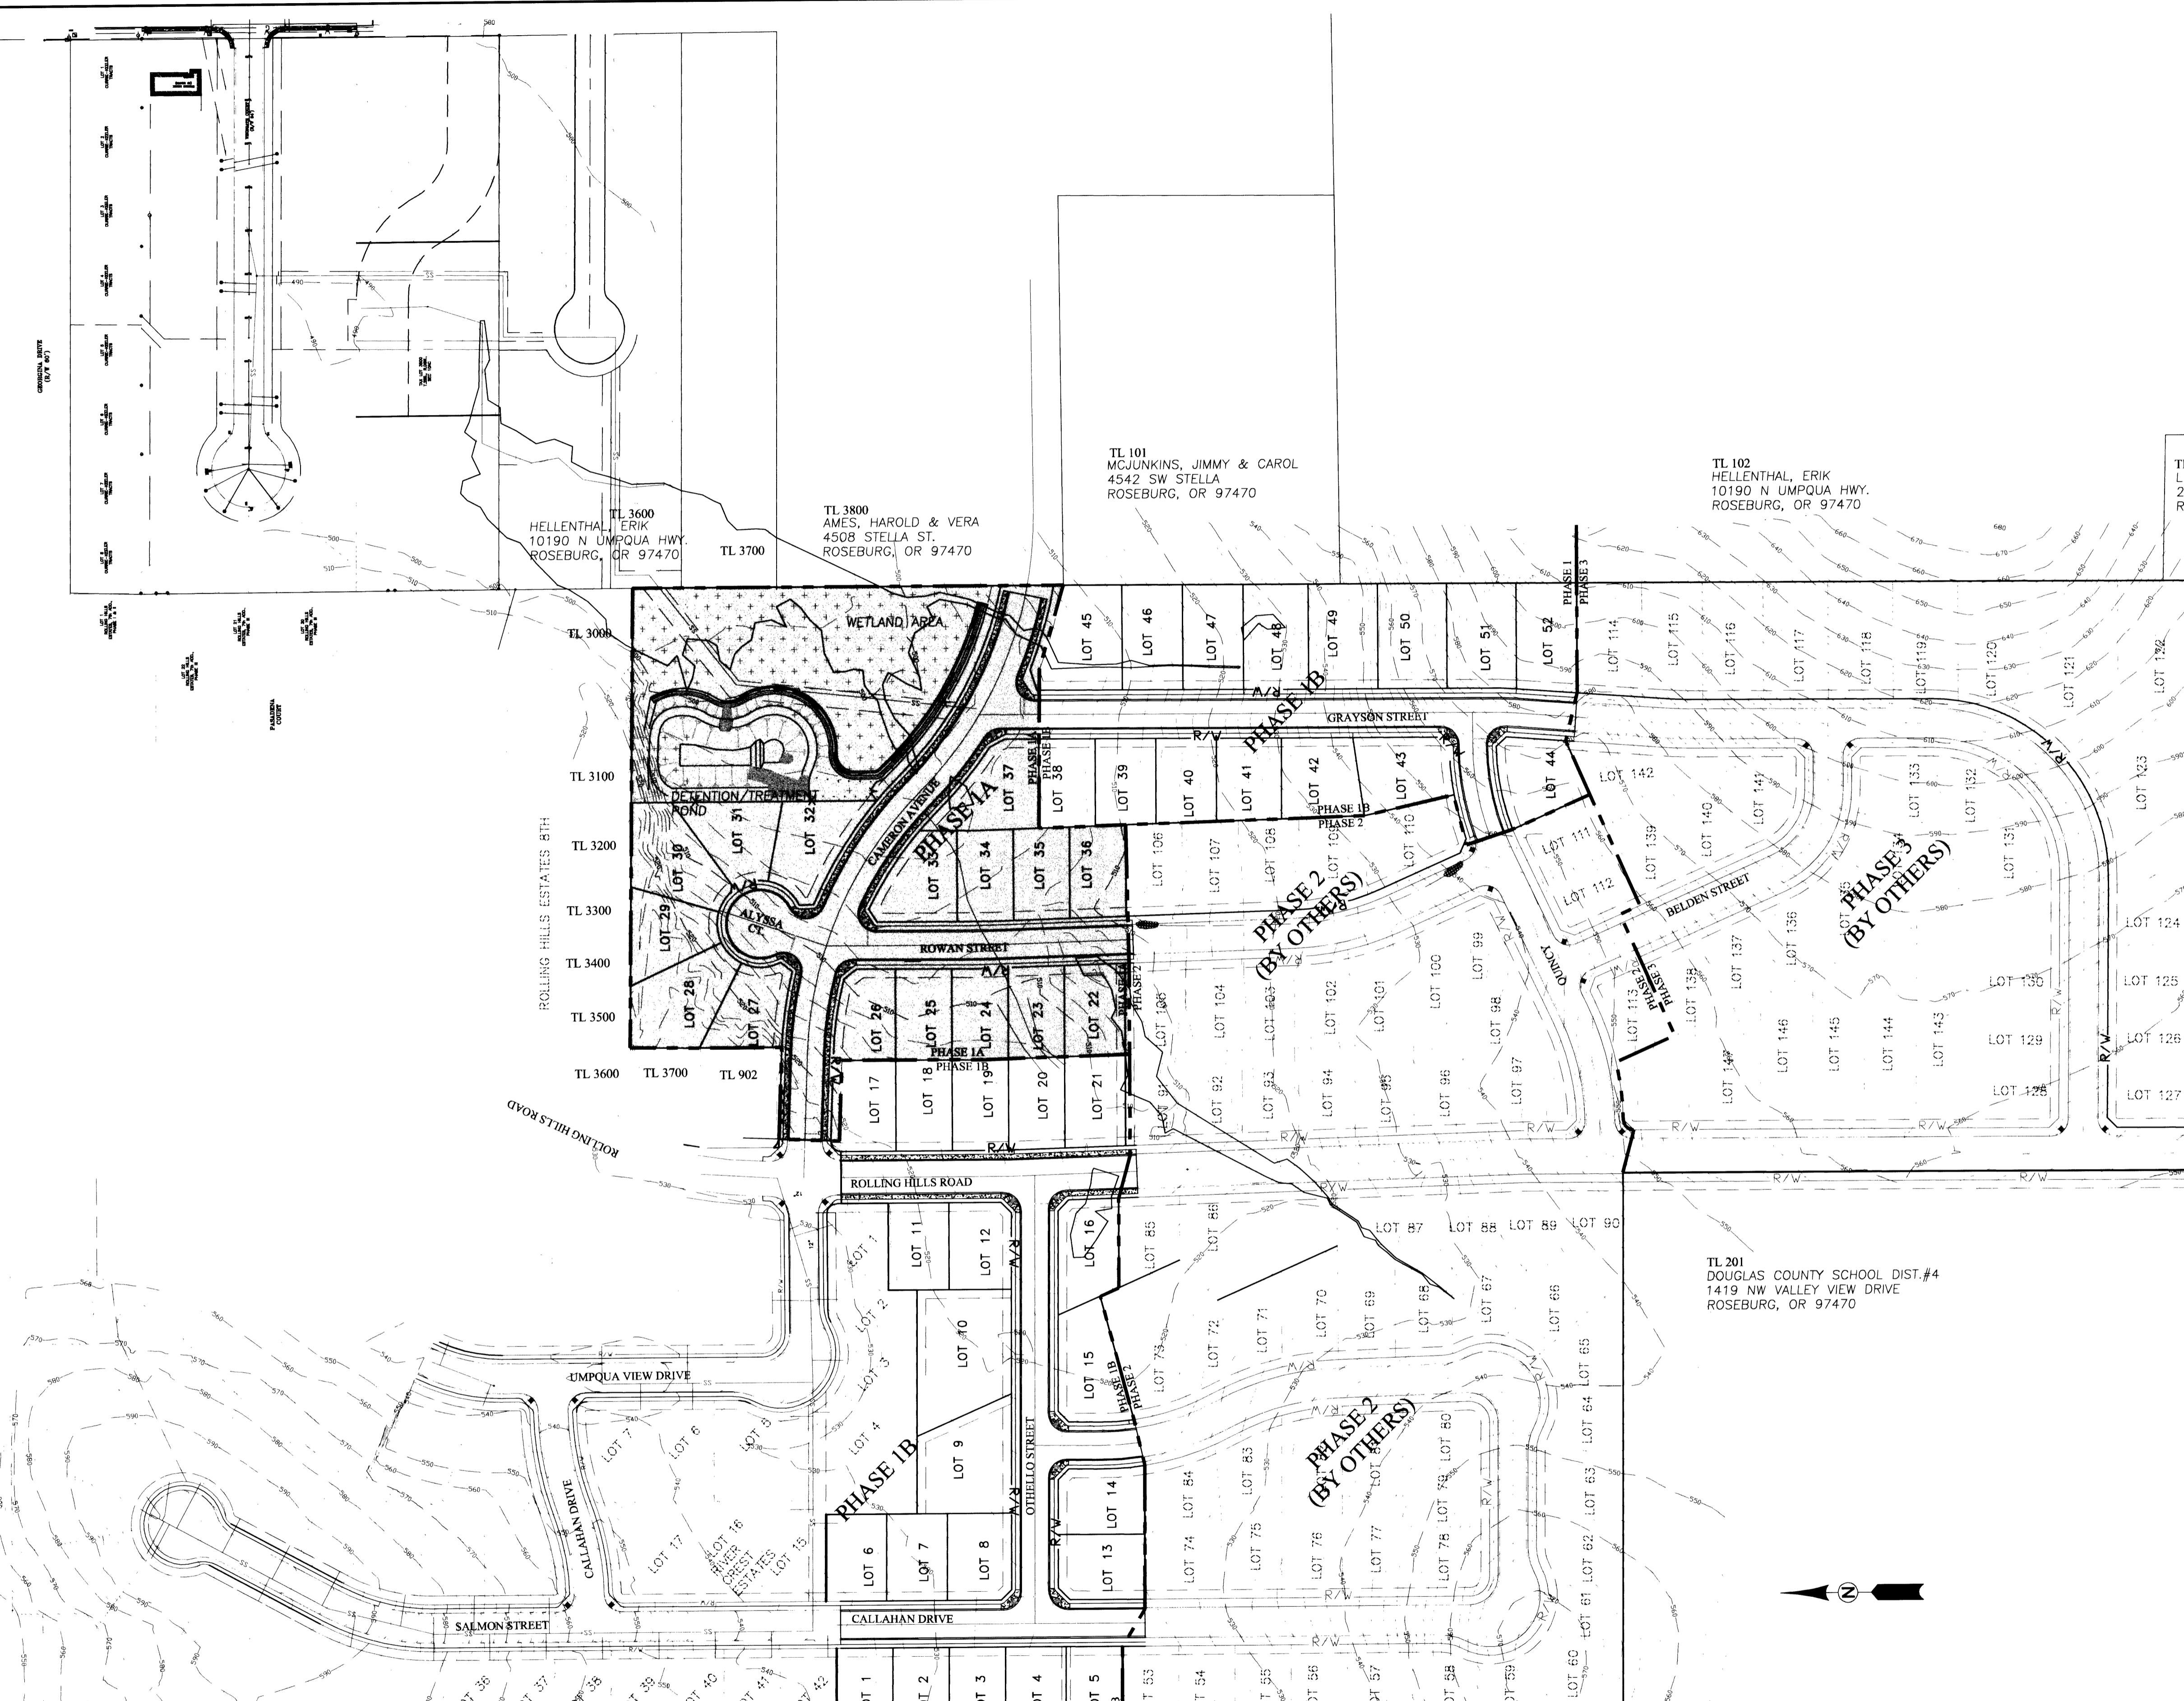

TL 900
 LUTHER, TODD & JENNIFER
 224 FISK LANE
 ROSEBURG, OR 97470

TL 100
 BODFIELD, ARLENE
 2548 SW LANDERS LN.
 ROSEBURG, OR 97470

TL 4800
 CALKINS, GARY & KATHRYN
 14229 SPANAWAY LOOP RD.
 TACOMA, WA 98444

TL 102
 HELLENTHAL, ERIK
 10190 N UMPQUA HWY.
 ROSEBURG, OR 97470

TL 3800
 AMES, HAROLD & VERA
 4508 STELLA ST.
 ROSEBURG, OR 97470

TL 101
 MCGUNKINS, JIMMY & CAROL
 4542 SW STELLA
 ROSEBURG, OR 97470

TL 3600
 HELLENTHAL, ERIK
 10190 N UMPQUA HWY.
 ROSEBURG, OR 97470

TL 201
 DOUGLAS COUNTY SCHOOL DIST.#4
 1419 NW VALLEY VIEW DRIVE
 ROSEBURG, OR 97470

TL 301
 DOUGLAS COUNTY SCHOOL DIST.#4
 1419 NW VALLEY VIEW DRIVE
 ROSEBURG, OR 97470

TL 401
 DOUGLAS COUNTY SCHOOL DIST.#4
 1419 NW VALLEY VIEW DRIVE
 ROSEBURG, OR 97470

TL 700
 WPI #4 LLC
 4610 HOLEGATE
 ROSEBURG, OR 97470


TL 402
 WPI #4 LLC
 4610 HOLEGATE ST.
 ROSEBURG, OR 97470

TL 300
 SCEVERS, RONNIE
 4620 SE HOLEGATE
 ROSEBURG, OR 97470

0' 50' 100' 200'
 SCALE: 1"=100'

CALL BEFORE YOU DIG!
 ONE CALL: (800) 332-2344
 OAR 952-001-0010 THROUGH
 OAR 952-001-0090

i.e.
 ENGINEERING
 505 SE Main Street
 Roseburg, Oregon 97470
 PHONE (541) 673-0166
 FAX (541) 440-9392
 Email: iemail@ieengineering.com

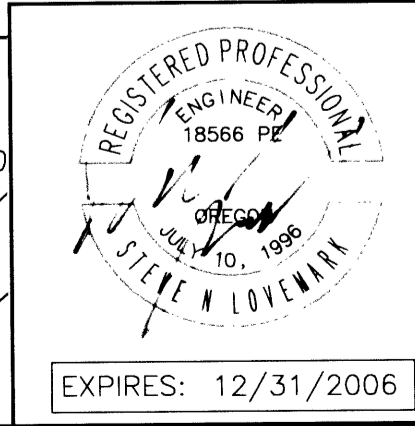

Rev.	Date	Dwg	Description
1	7/1/06	JDL	AGENCY REVIEW
2	4/13/06	JDL	AS-BUILT PHASE 1A
3	8/9/06	NRJ	AS-BUILT PHASE 1B

Project Name:	RIVER CREST ESTATES 2 PHASE 1
Title:	PHASE 1, 2, & 3 EXISTING TOPOGRAPHY
DES DMA	PROJECT NO. 1944-0312
DWG JDL	DATE: MAY 20, 2005
CHK SNL	SCALE: AS SHOWN
APP SNL	SHEET: 2 OF 18

C. R. 4 # 366, 375 J, 375 N, 375 O, 388 B, 288 C, 288 D

EXIST. TOPOGRAPHY CO. RDS. 366 375J 375N
 3750 288B 288C 288D

375288TP

DO NOT DUPLICATE