


ROLLING HILLS DR.
 SCALE: 1 : 20 HORZ. STA: 17+41.53 - 23+15.79
 1 : 5 VERT.

- STORM DRAINAGE NOTES:**
- INSTALL 40LF OF 12" PVC PIPE @ SL=1.0%
 - INSTALL 40LF OF 12" PVC PIPE @ SL=1.0% FOR FUTURE CURB INLET CONNECTION IE @ STUB: 542.44
 - CONNECT INTO EXISTING STORM SYSTEM

- STORM DRAIN WEEPHOLE LOCATIONS:**
- PROVIDE 3" WEEPHOLES FOR PERFORATED PIPE WITHIN STORM EASEMENT AT:
- | | |
|-------------------------|-------------------------|
| STA: 17+94.00 20.00' LT | STA: 20+53.00 20.00' LT |
| STA: 17+94.00 20.00' RT | STA: 20+53.00 20.00' RT |
| STA: 18+58.00 20.00' LT | STA: 21+41.00 20.00' LT |
| STA: 18+58.00 20.00' RT | STA: 21+41.00 20.00' RT |
| STA: 19+24.00 20.00' LT | STA: 21+81.00 20.00' LT |
| STA: 19+24.00 20.00' RT | STA: 21+81.00 20.00' RT |
| STA: 19+85.00 20.00' LT | STA: 22+25.00 20.00' RT |
| STA: 19+85.00 20.00' RT | |
- PROVIDE 3" WEEPHOLES FOR ROOF DRAIN LATERAL DRAINAGE AT:
- | | |
|-------------------------|-------------------------|
| STA: 17+44.00 RT 20.00' | STA: 20+00.00 LT 20.00' |
| STA: 17+44.00 LT 20.00' | STA: 20+32.00 RT 20.00' |
| STA: 18+25.00 RT 20.00' | STA: 21+07.00 RT 20.00' |
| STA: 18+40.00 LT 20.00' | STA: 20+78.00 LT 20.00' |
| STA: 18+04.00 LT 20.00' | STA: 21+77.00 RT 20.00' |
| STA: 19+34.00 LT 20.00' | STA: 22+44.00 RT 20.00' |

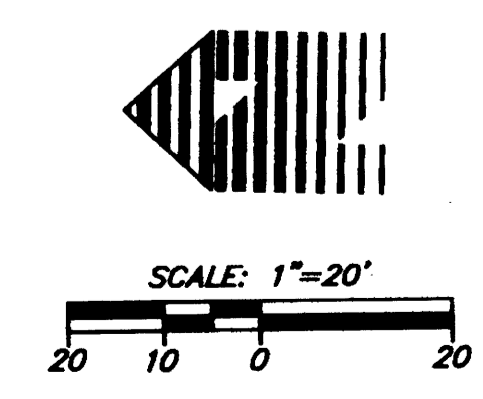

LEGEND:

SITE BOUNDARY	---
EXISTING RIGHT-OF-WAY	---
EXISTING CENTER LINE	---
EXISTING LOT LINE	---
EXISTING EASEMENT LINE	---
EXISTING CURB LINE	---
EXISTING SIDEWALK LINE	---
PHASE LINE	---
EXISTING GAS LINE	---
EXISTING STORM LINE	---
EXISTING CURB INLET	□
EXISTING SANITARY LINE	---
EXISTING SANITARY MANHOLE	○
PROPOSED RIGHT-OF-WAY	---
PROPOSED CENTER LINE	---
PROPOSED LOT LINE	---
PROPOSED EASEMENT LINE	---
PROPOSED CURB LINE	---
PROPOSED SIDEWALK	---
PROPOSED STORM LINE	---
PROPOSED CURB INLET	□
PROPOSED SANITARY LINE	---
PROPOSED SANITARY MANHOLE	○
PROPOSED WATER LINE	---
PROPOSED WATER VALVE	•
PROPOSED WATER METER	•
PROPOSED FIRE HYDRANT	•

FILED
 Date: 10/9/2008 By: JC
 This survey consists of:
 Map:
 Narrative:
 Corner Rpt:
 DOUGLAS COUNTY SURVEYOR

W R G
 DESIGN INC.
 5415 SW Westgate Dr, Ste 100 Portland, OR 97221
 Tel: 503.492.2500 Fax: 503.492.2500
 PLANNERS • ENGINEERS • LANDSCAPE ARCHITECTS • SURVEYORS

ROLLING HILLS DR. STORM PLAN STA 17+41.53 - 23+15.79
RIVER CREST ESTATES 2 - PHASE 2
HAYDEN HOMES
 Green District, Oregon

AS-BUILT
 BASED ON CHANGES IDENTIFIED DURING CONSTRUCTION AS OF 3/7/08

REGISTERED PROFESSIONAL ENGINEER
 KEVIN S. RUSSELL
 JULY 09 2005
 EXPIRES: 12-31-08

DATE: 1/3/2008
 DRAWN: LMB
 DESIGNED: LMB
 CHECKED: KBR
 PROJECT #: HAY88600
 SHEET TITLE: ROLLING HILLS STORM PLAN
 SHEET NUMBER: **C223**
 OF 6 SHEETS

Co. Rd. # 366 MP 0.90 - 0.79
CO. RD. 366