

# ROLLING HILLS ESTATES 8th EDITION IMPROVEMENT PLANS

## GENERAL NOTES

FILED  
Date: 11-22-96  
This survey consists of:  
Map:  
Narrative:  
Corner Rpt:  
DOUGLAS COUNTY  
SURVEYOR

### GENERAL NOTES

- The 1990 edition of the Standard Specifications for Public Works Construction prepared by the American Public Works Association Chapter will be considered the Standard Specifications with the exception of Division 1 and all measurement and payment sections.
- Trench backfill shall be Class "B" (3/4"-0 crushed rock) under all streets shoulder to shoulder, and Class "A" (Suitable excavated material) elsewhere unless shown different on trench detail or in specs. All trenches will be compacted with hand operated pneumatic compactor.
- The contractor shall replace any and all survey monuments which are affected by the construction. All monuments will be reset by a licensed land surveyor.
- Locations shown on engineering drawings are approximate. The exact location will be staked in the field by the engineer. Contractor to give 7 days notice to engineer for stakes.
- Contractor shall maintain a minimum horizontal separation of 10 feet between water main and sewer main measured edge to edge.
- 14 gage copper toning wire approved for direct bury shall be placed in all trenches where pipe has been laid. Except for water lines which shall have 12 gage wire.
- The contractor shall notify all affected utility companies for locations of mainline and service line locations prior to digging. Utilities which are damaged and were marked properly will be repaired by the contractor at his cost. Utilities which are damaged by the contractor that were unmarked or improperly marked will be paid for by the owner of the affected utility. Contractor to contact "ONE CALL" at least 48 hours prior to construction at 673-6676.

### GENERAL SANITARY SEWER NOTES




- All sanitary sewer work shall be in conformance with Green Sanitary District Specifications and Ordinance. In cases of conflict Green Sanitary District Specifications shall take precedence over the Standard Specifications.
- Sanitary sewer laterals shall be constructed in accordance with Oregon State Department of Community, Building Codes Division, 1988 Uniform Plumbing Code and its amendments, except for 8" and larger public sewers which shall be constructed in accordance with DEQ standards for public sewers and to the lines, grades and details shown on the plans. 4" and 6" laterals shall be PVC ASTM 3034. All lines shall have toning wire installed in the trench for future locating.
- All sewer laterals shall be air tested in accordance with applicable code.

### GENERAL STREET IMPROVEMENT NOTES

- All street improvement work shall be in conformance with the latest version of Douglas County Public Works Department Design Standards and Standard Drawings. In cases of conflict the Douglas County Standards shall take precedence over the Standard Specifications.
- All asphalt pavement shall be "C" mix meeting Oregon State Highway Department standards.

### GENERAL WATER SYSTEM NOTES

- All water system work shall be in conformance with the rules and regulations of Roberts Creek Water District. In cases of conflict the Roberts Creek Water District specifications shall take precedence over the Standard Specifications.
- All pipe for water mainlines shall be PVC C-900 pipe.
- The contractor shall flush, hydrostatically test and chlorinate all new water mainlines installed. The Engineer shall witness all test made by the contractor to insure they are performed properly. Test shall be determined by the Engineer prior to testing.
- All construction is subject to inspection by the Roberts Creek Water District. Contractor shall give the City 48 hours notice prior to beginning construction.
- No other major utilities shall run parallel within 3 feet of the new watermain.
- Thrust blocks shall be installed at all bends and fittings as per Typical Thrust Block Detail.
- Water service shall be 3/4" copper per Roberts Creek std Detail.

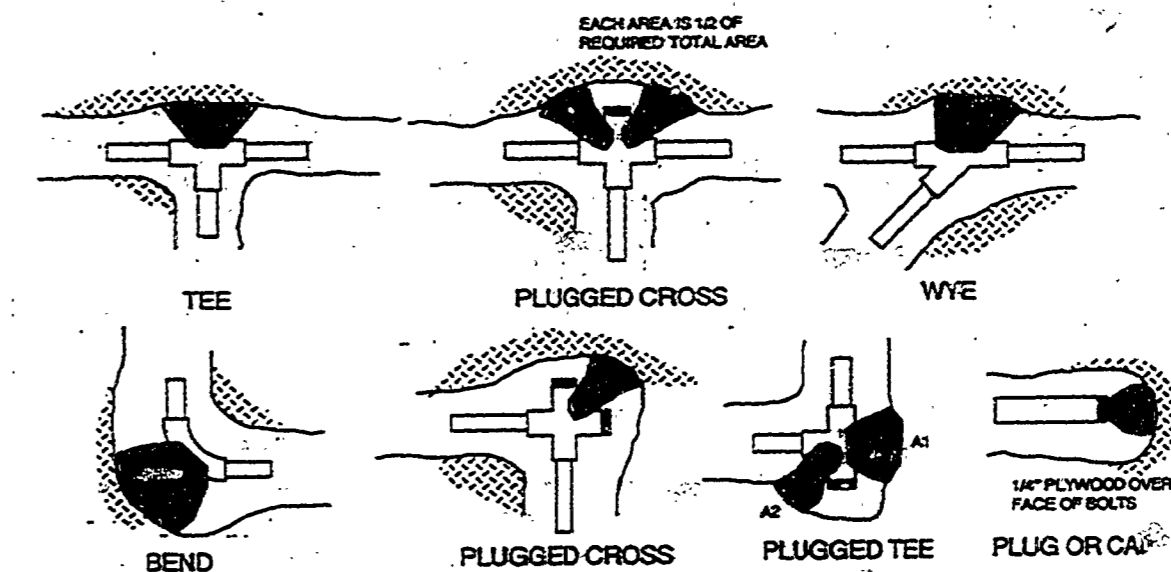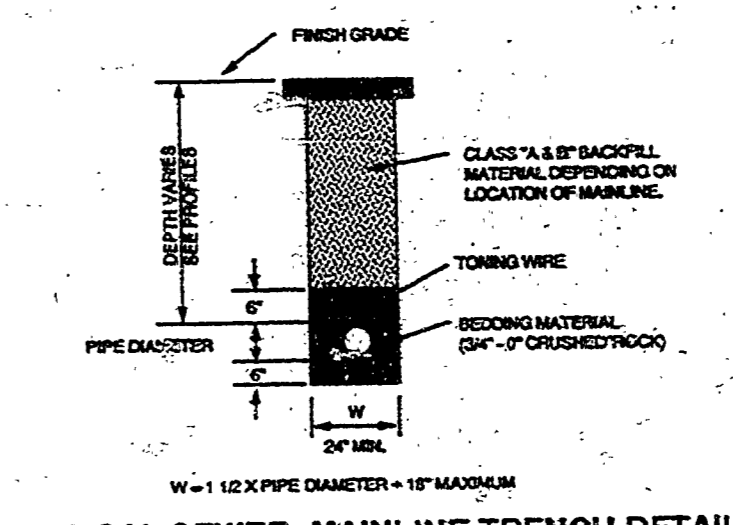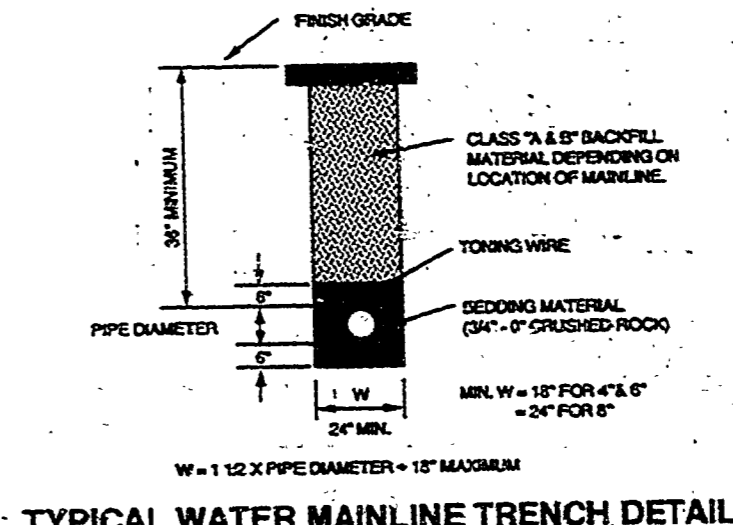

FITTING SIZE	TEE, WYE, PLUG, OR CAP		90 DEG. BEND PLUGGED CROSS		TEE PLUGGED ON RUN AT A1 A2		45 DEG. BEND		22 1/2 DEG. BEND		11 1/2 DEG. BEND	
	02	04	04	06	04	06	02	04	02	04	02	04
2	0.2	0.4	0.5	0.4	0.2	0.2	0.2	0.2	0.2	0.2	0.2	0.2
3	0.5	0.8	1.2	0.8	0.5	0.5	0.5	0.5	0.5	0.5	0.5	0.5
4	1.0	1.4	1.9	1.4	1.0	1.0	1.0	1.0	1.0	1.0	1.0	1.0
6	2.1	3.0	4.3	3.0	2.1	2.1	2.1	2.1	2.1	2.1	2.1	2.1
8	3.8	5.4	7.8	5.4	3.8	3.8	3.8	3.8	3.8	3.8	3.8	3.8
10	5.9	8.4	11.8	8.4	5.9	5.9	5.9	5.9	5.9	5.9	5.9	5.9
12	8.5	12.0	17.0	12.0	8.5	8.5	8.5	8.5	8.5	8.5	8.5	8.5
14	11.5	16.3	23.0	16.3	11.5	11.5	11.5	11.5	11.5	11.5	11.5	11.5
16	15.0	21.3	30.0	21.3	15.0	15.0	15.0	15.0	15.0	15.0	15.0	15.0
18	19.0	27.0	38.0	27.0	19.0	19.0	19.0	19.0	19.0	19.0	19.0	19.0
20	23.5	32.3	47.0	32.3	23.5	23.5	23.5	23.5	23.5	23.5	23.5	23.5
24	34.0	48.0	68.0	48.0	34.0	34.0	34.0	34.0	34.0	34.0	34.0	34.0



NOTE: ABOVE BEARING AREAS BASED ON TEST PRESSURE OF 150 PSI AND AN ALLOWABLE SOIL BEARING STRESS OF 2000 LB. PER SQUARE FOOT. TO COMPUTE BEARING AREAS FOR DIFFERENT TEST PRESSURES AND SOIL BEARING STRESSES, USE THE FOLLOWING EQUATION: BEARING AREA = (TEST PRESSURE/150) x (2000/SOIL BEARING STRESS) x (TABLE VALUE)

- NOTES:
- CONCRETE THRUST BLOCKING TO BE POURED AGAINST UNDISTURBED EARTH.
  - KEEP CONCRETE CLEAR OF JOINT AND ACCESSORIES.
  - THE REQUIRED THRUST BEARING AREAS FOR SPECIAL CONNECTIONS ARE SHOWN ENCLOSED ON THE PLANS. (C) INDICATES IS SQUARE FEET BEARING AREA REQUIRED.
  - IF NOT SHOWN ON PLANS REQUIRED BEARING AREAS AT FITTING SHALL BE AS INDICATED BELOW, ADJUSTED IF NECESSARY, TO CONFORM TO THE TEST PRESSURES AND ALLOWABLE SOIL BEARING STRESSES STATED IN THE SPECIAL SPECIFICATIONS.
  - BEARING AREAS AND SPECIAL BLOCKING DETAILS SHOWN ON PLANS TAKE PRECEDENCE OVER BEARING AREAS AND BLOCKING DETAILS SHOWN ON THIS STANDARD DETAIL.

- LEGEND:**
- W--- EXISTING WATERLINE
  - SS--- EXISTING SANITARY SEWER LINE 8"
  - SD--- PROPOSED STORM DRAIN LINE & MANHOLE
  - W--- PROPOSED 8" WATERLINE
  - SS--- PROPOSED SANITARY SEWER LINE & MANHOLE
  - FH--- PROPOSED FIRE HYDRANT
  - O--- PROPOSED SEWER CLEAN OUT
  - CB--- PROPOSED CATCH BASINS


## SHEET INDEX

- SHEET 1 COVER SHEET
- SHEET 2 ROLLING HILL ROAD PLAN & PROFILE
- SHEET 3 SILVERADO COURT PLAN & PROFILE
- SHEET 4 CURB RETURN PROFILES SUPER ELEVATION DIAGRAM

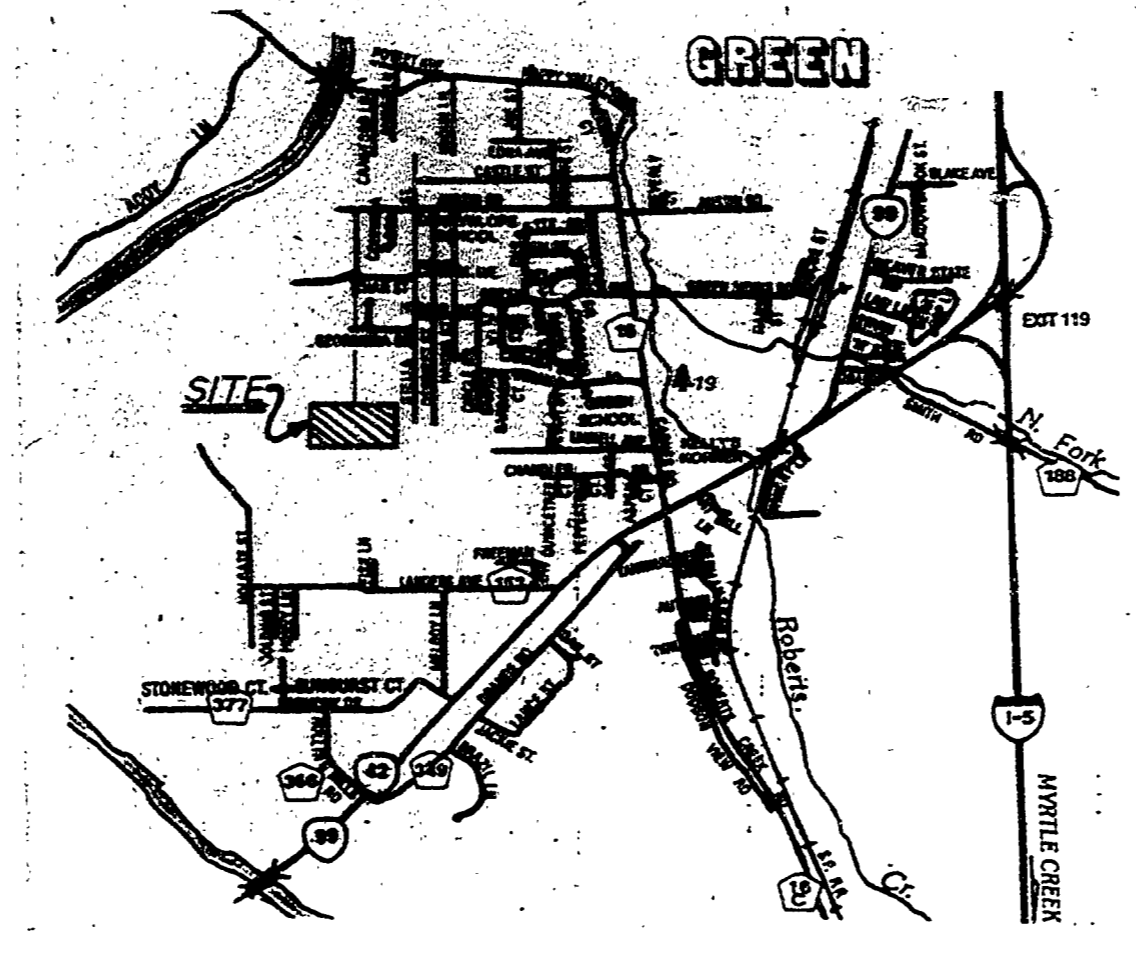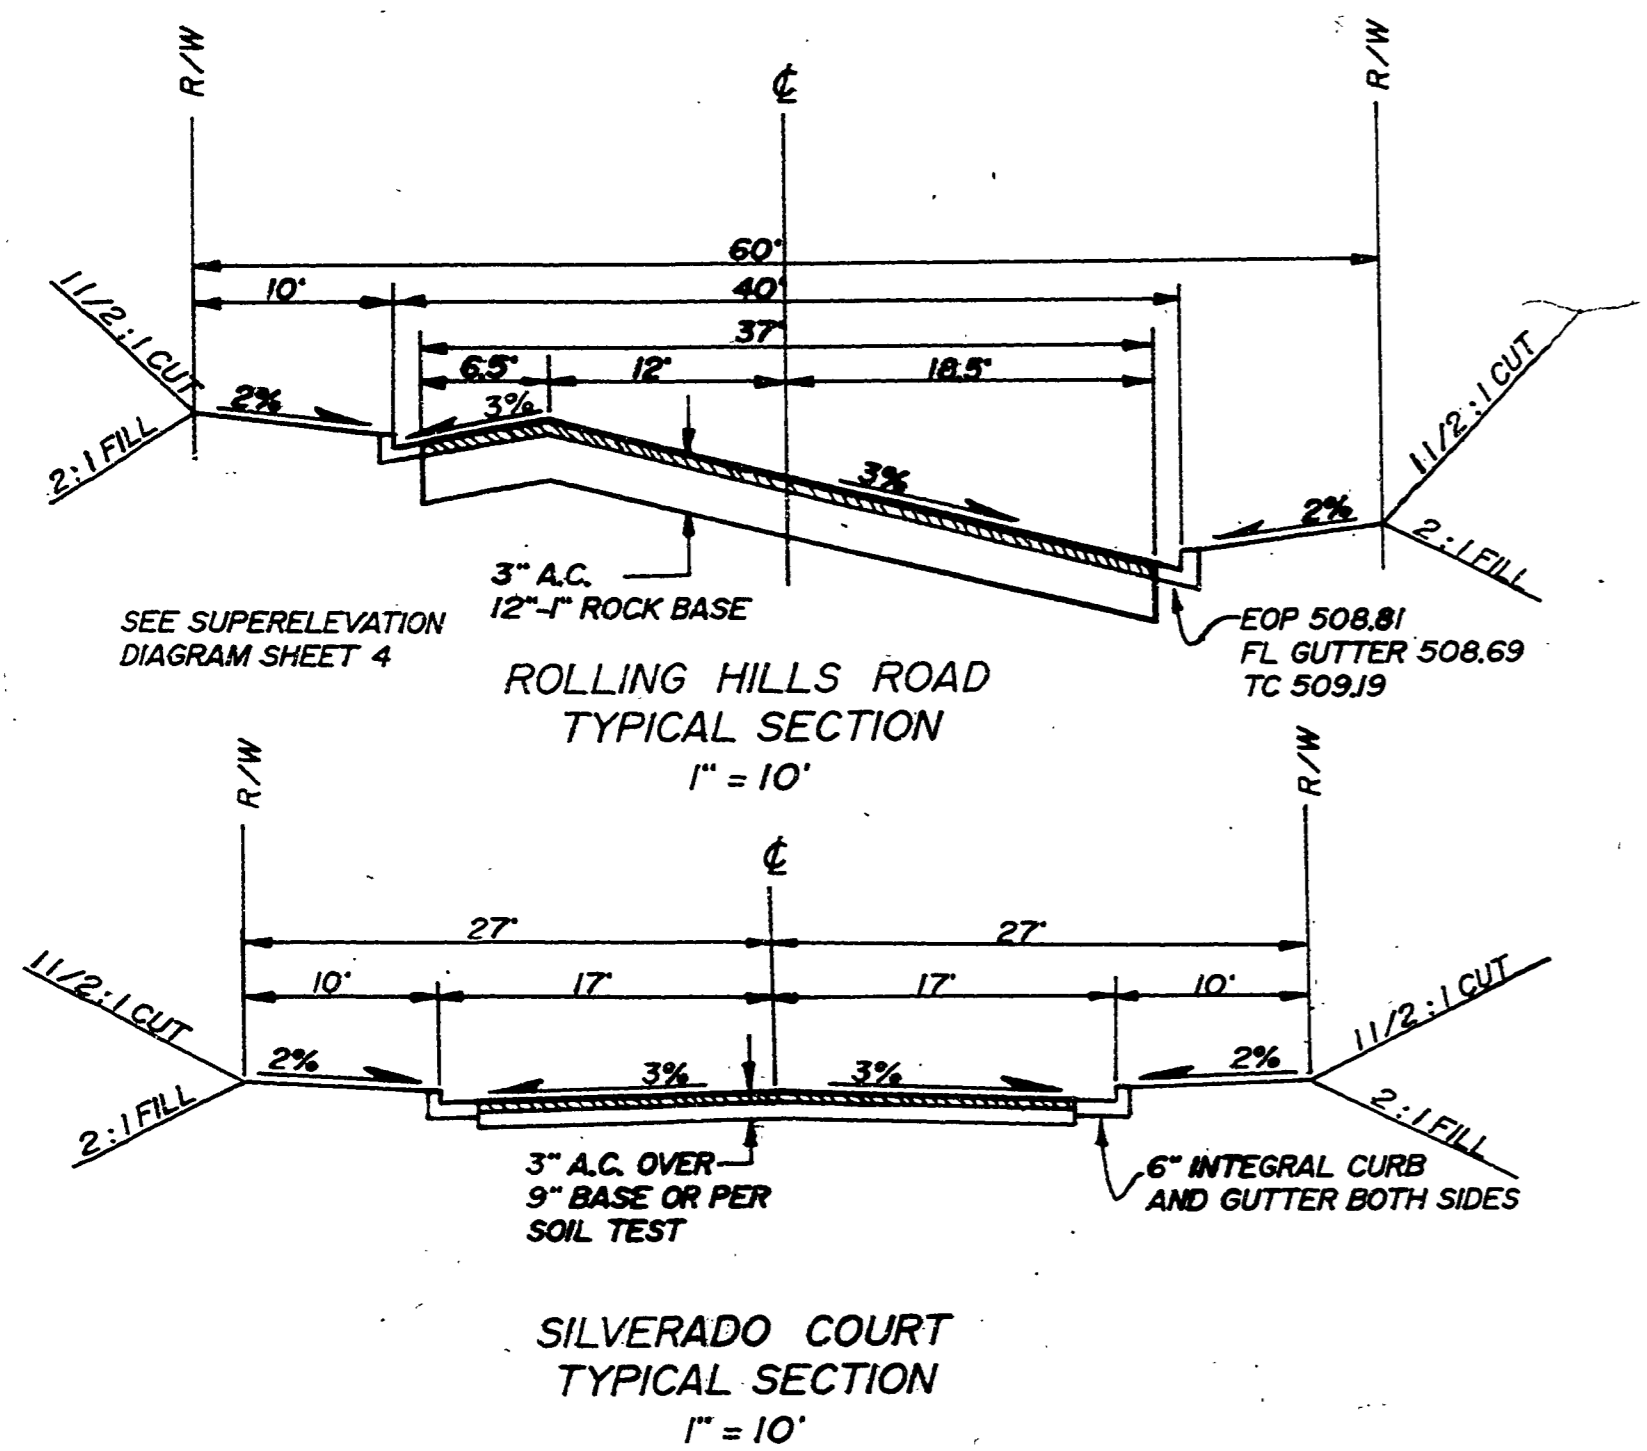

Bench Mark: A disk stamped "BM CHAR RLS 1507 ELEV. 485.00 1980" set in a 10-inch diameter concrete filled tile flush with the ground.

Location: Go to the intersection of Stella Street (Co. Rd. No. 246) and Char Avenue (Co. Rd. No. 375) in Green (T28S, R6W, Sec. 10). Monument is in Northwest Corner formed by intersection. Char Avenue is approximately 0.2 miles South of the intersection of Austin Road (Co. Rd. No. 207) and Stella Street (Co. Rd. No. 246).

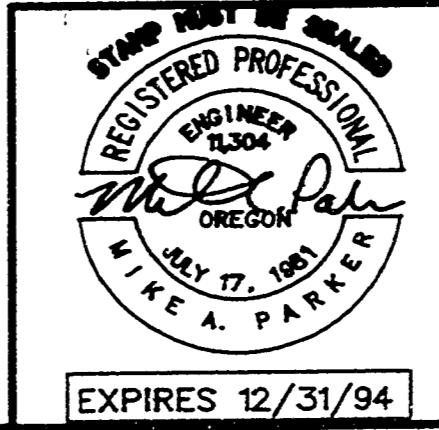

Rev.	Date	Description
1	8-2-93	SEWER, WATER, & S.D.
2	8-4-93	DELETE CB-2 & 70' - 12" S.D.
3	8-6-93	REVISE S.E. RETURN PROFILE
4		CO. ENG. PLAN CHECK
5	12-7-93	AS-BUILTS

**i.e.** 1205 S.E. Court Street  
Roseburg, Oregon 97470  
PHONE (503) 673-0188  
FAX (503) 440-9392

Project Name: ROLLING HILLS 8TH ADDITION IMPROVEMENT PLANS

Title: TITLE SHEET

DES R.C.I. PROJECT NO. 108-08  
DWG S.M. DATE: JULY 1993  
CHK R.C.I. SCALE: AS NOTED  
APP M.A.P. SHEET 1 OF 4