



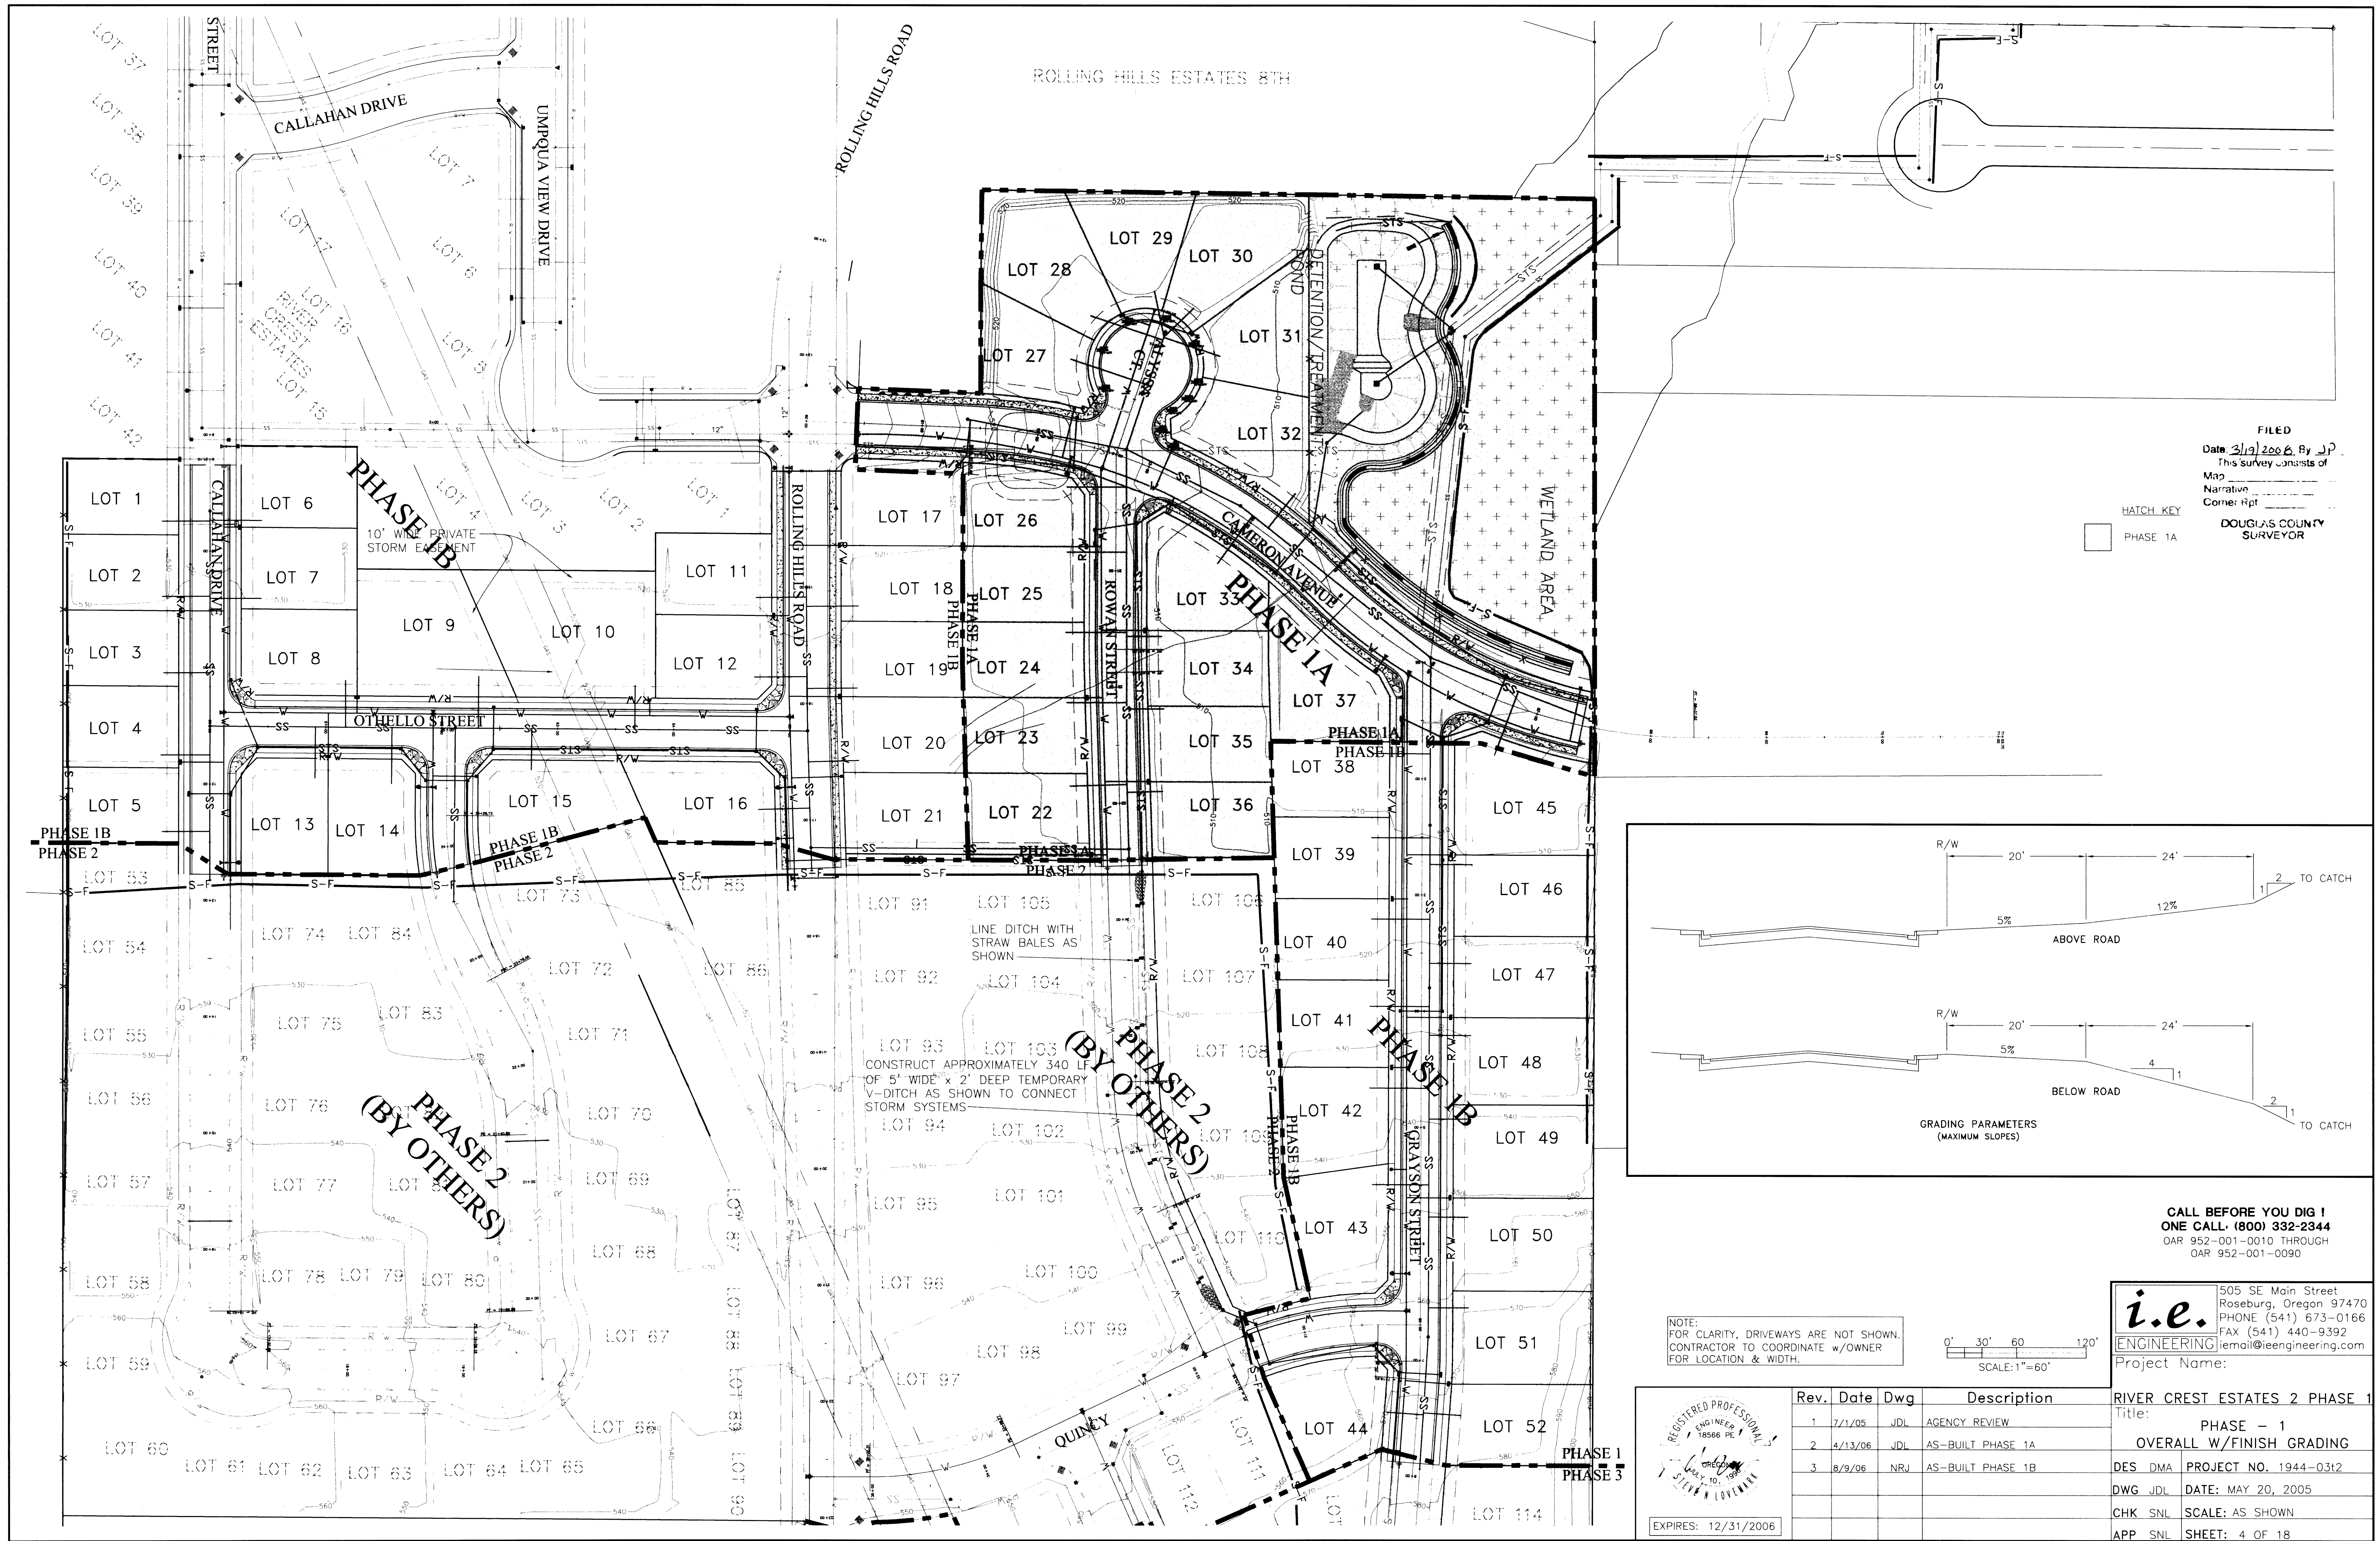


FILED
Date: 3/19/2006 By: JPD
This survey consists of:
Map _____
Narrative _____
Corner Rpt _____
DOUGLAS COUNTY
SURVEYOR

HATCH KEY
PHASE 1A

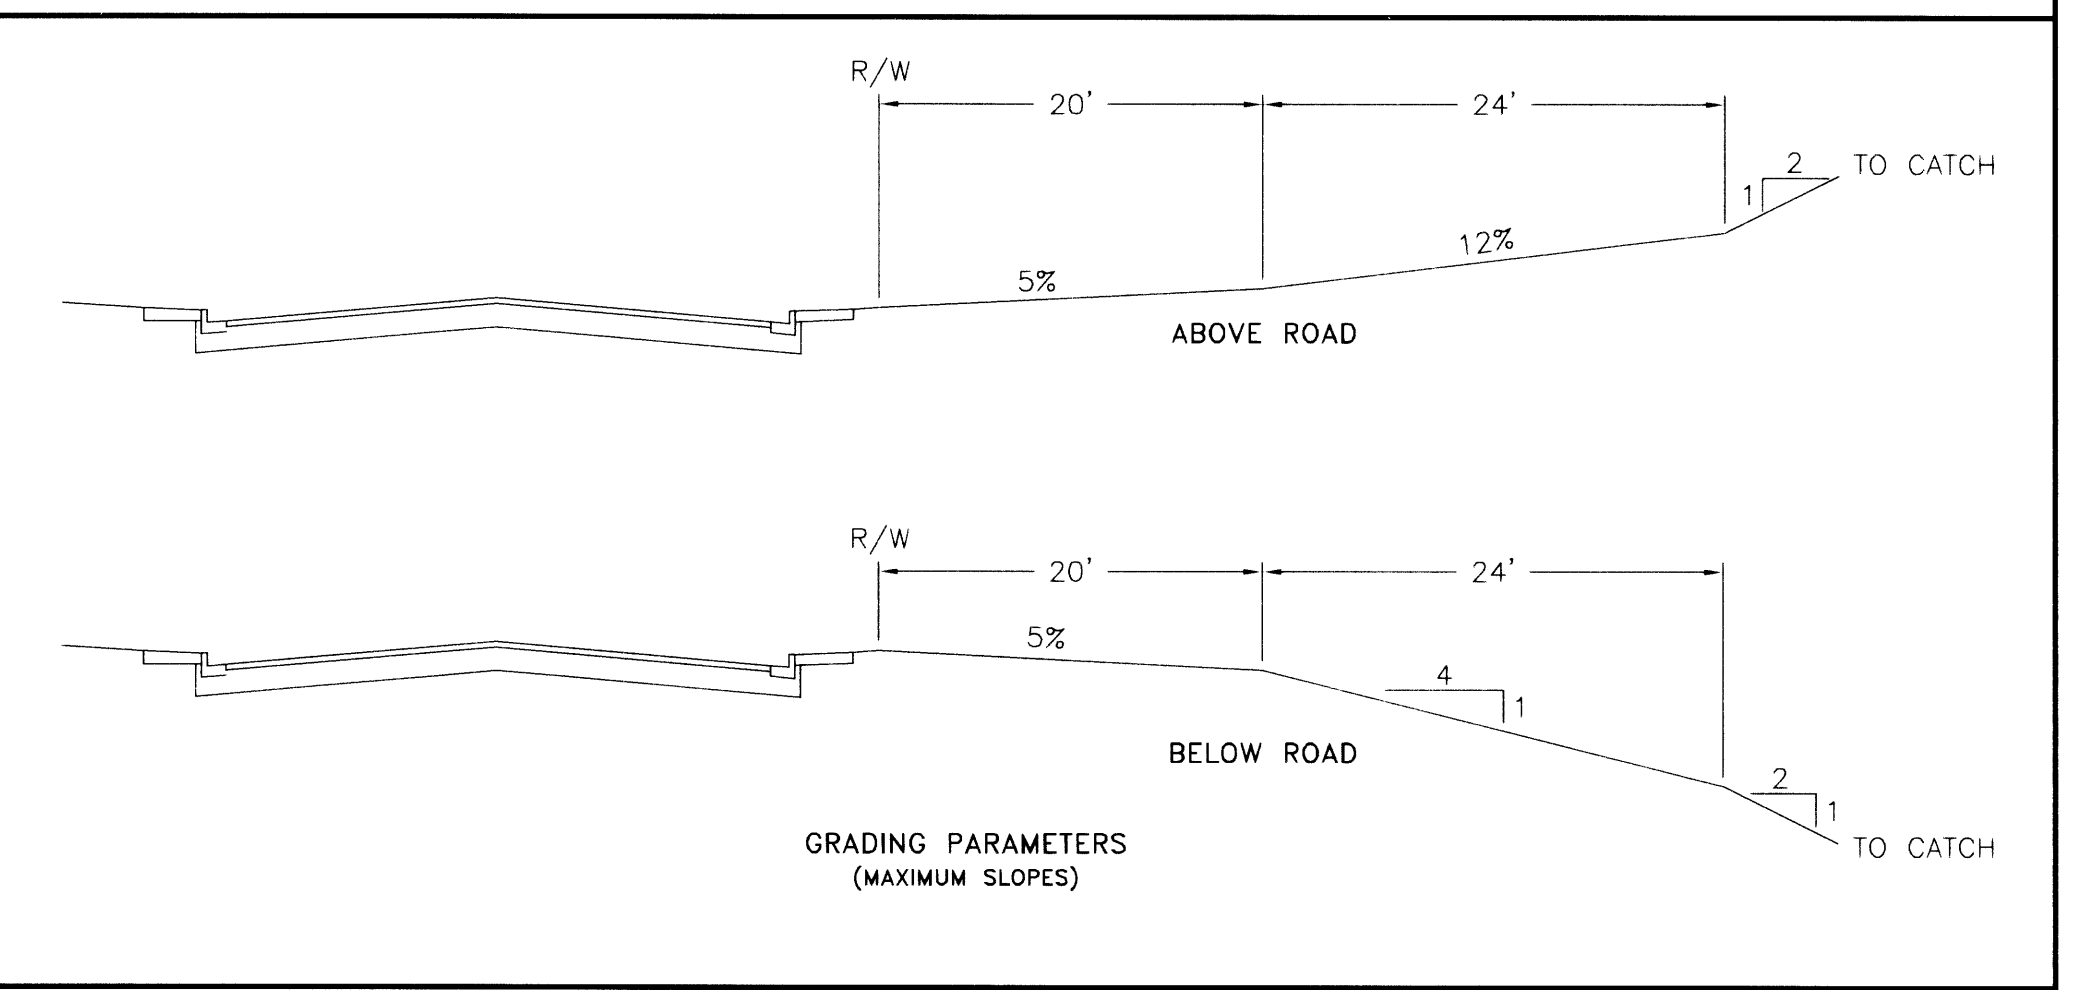


CALL BEFORE YOU DIG 1
ONE CALL (800) 332-2344
OAR 952-001-0010 THROUGH
OAR 952-001-0090

NOTE:
FOR CLARITY, DRIVEWAYS ARE NOT SHOWN.
CONTRACTOR TO COORDINATE w/OWNER
FOR LOCATION & WIDTH.

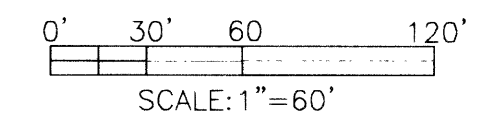

i.e.
ENGINEERING
505 SE Main Street
Roseburg, Oregon 97470
PHONE (541) 673-0166
FAX (541) 440-9392
Email: iemail@ieengineering.com
Project Name:

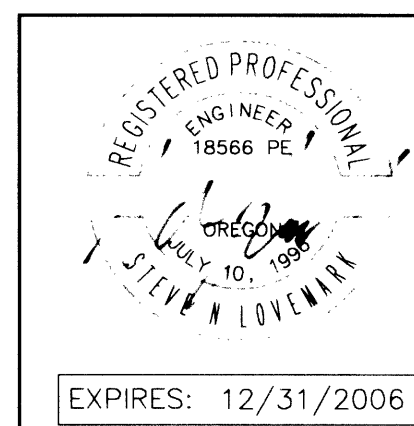

Rev.	Date	Dwg	Description
1	7/1/05	JDL	AGENCY REVIEW
2	4/13/06	JDL	AS-BUILT PHASE 1A
3	8/9/06	NRJ	AS-BUILT PHASE 1B

RIVER CREST ESTATES 2 PHASE 1	
Title: PHASE - 1	
OVERALL W/FINISH GRADING	
DES DMA	PROJECT NO. 1944-0312
DWG JDL	DATE: MAY 20, 2005
CHK SNL	SCALE: AS SHOWN
APP SNL	SHEET: 4 OF 18

3752886G