
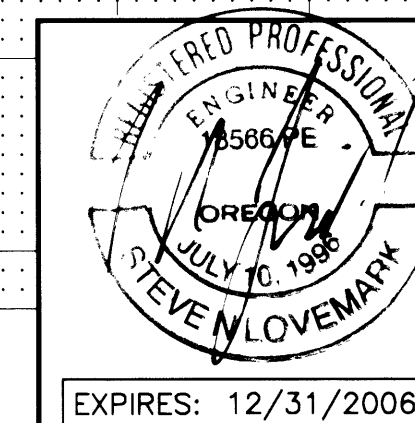
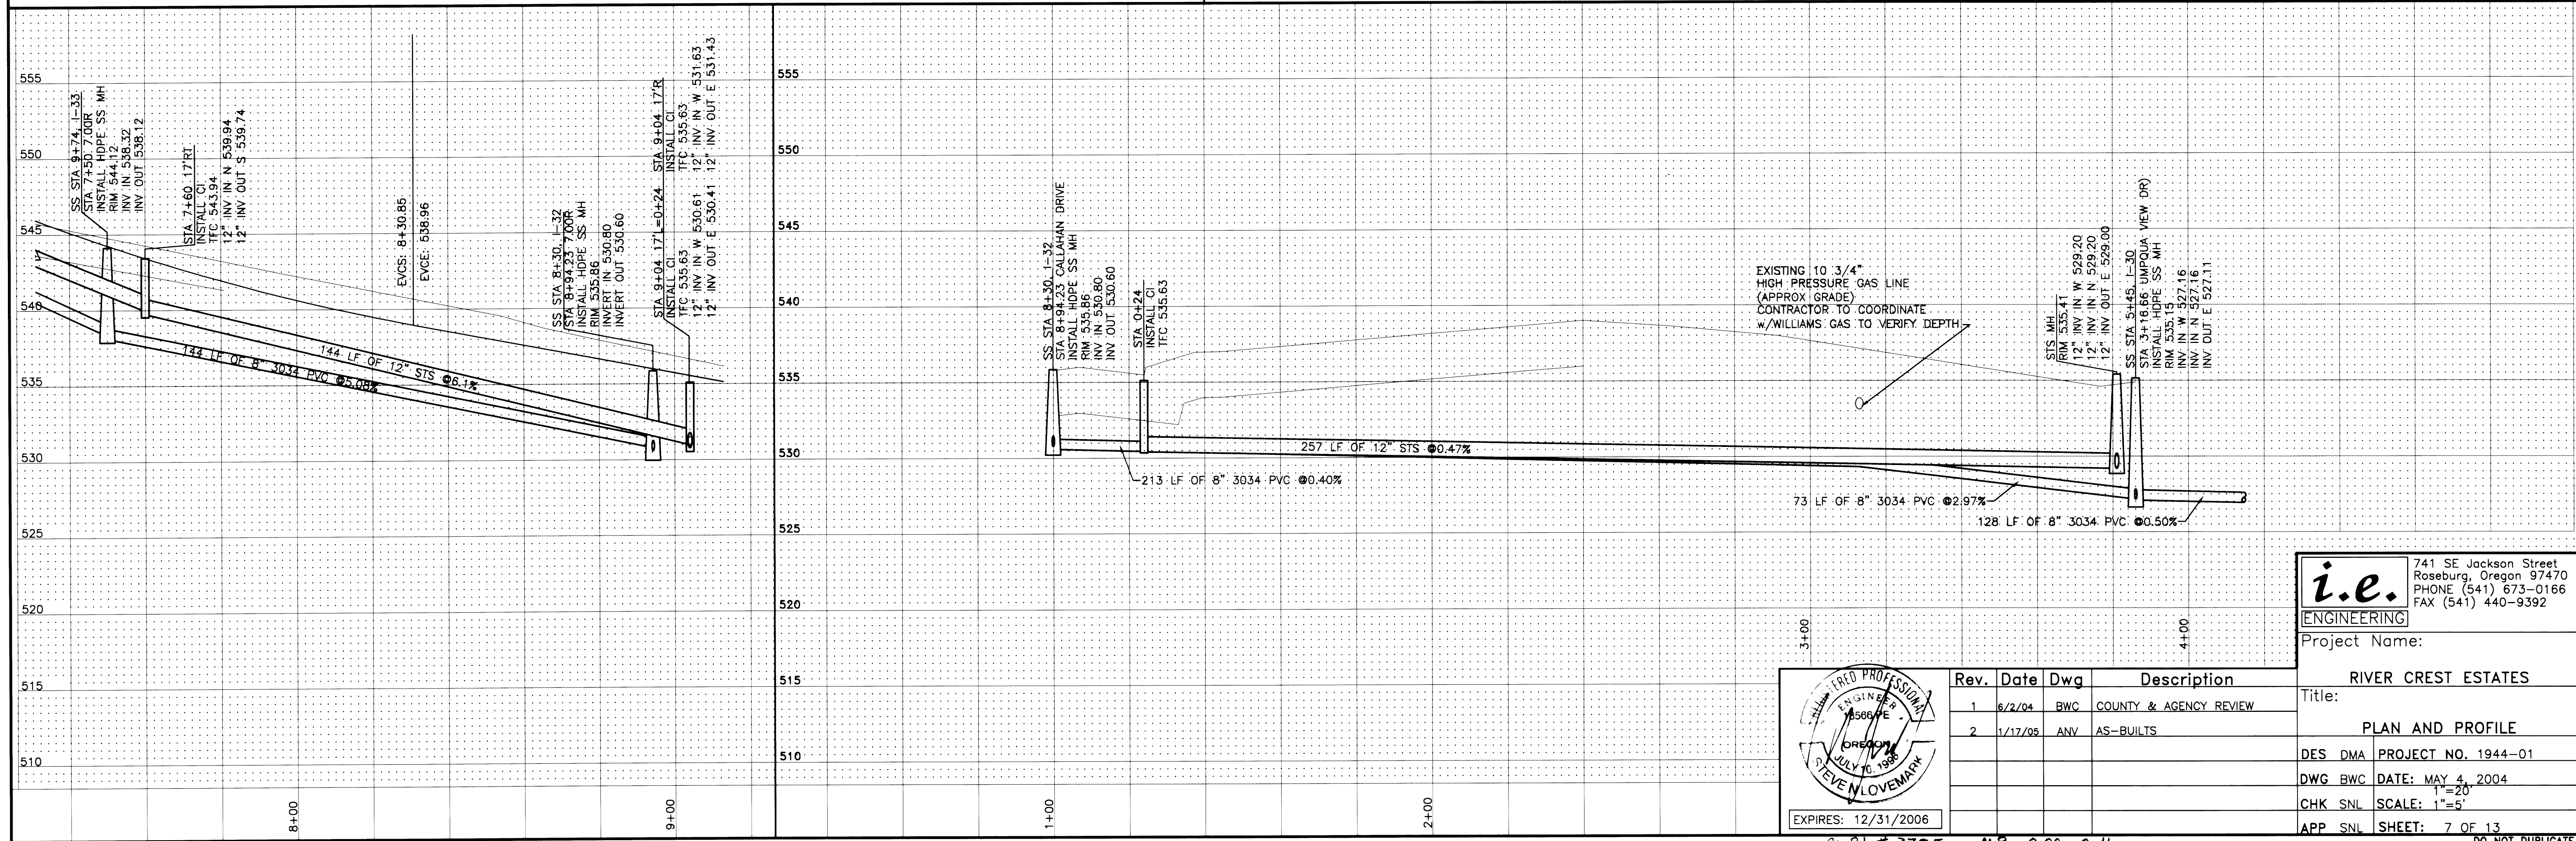
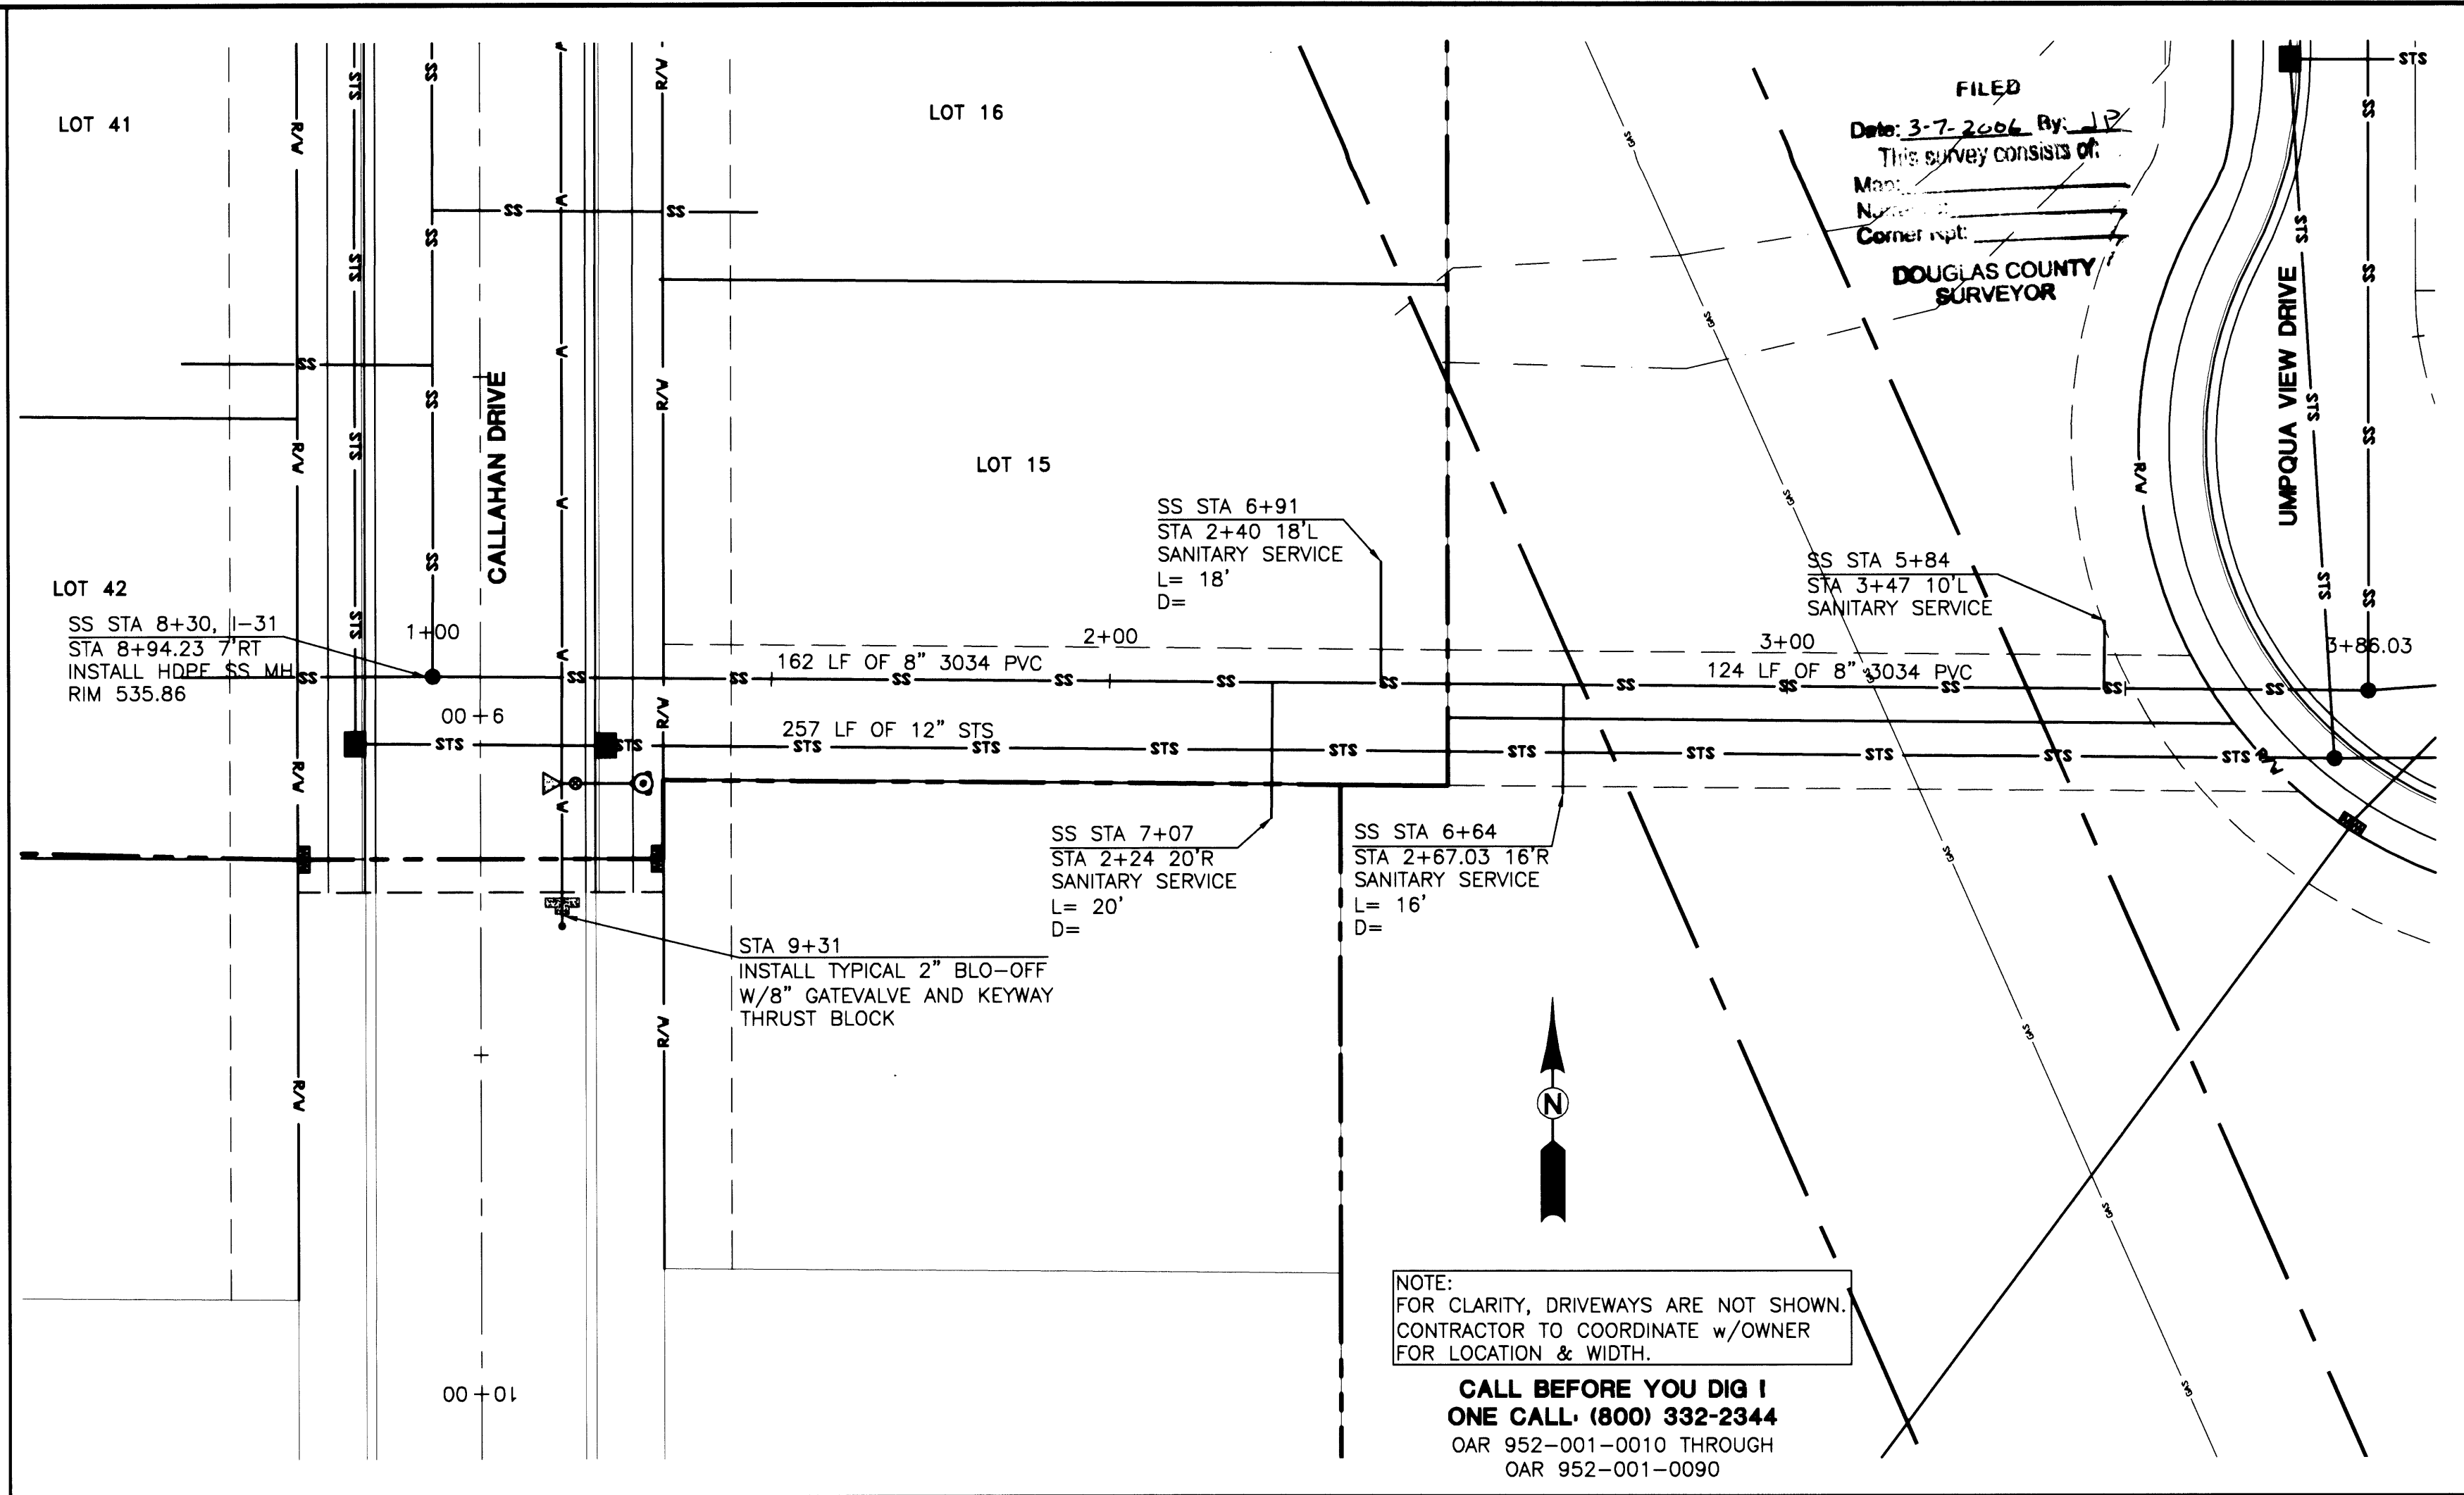


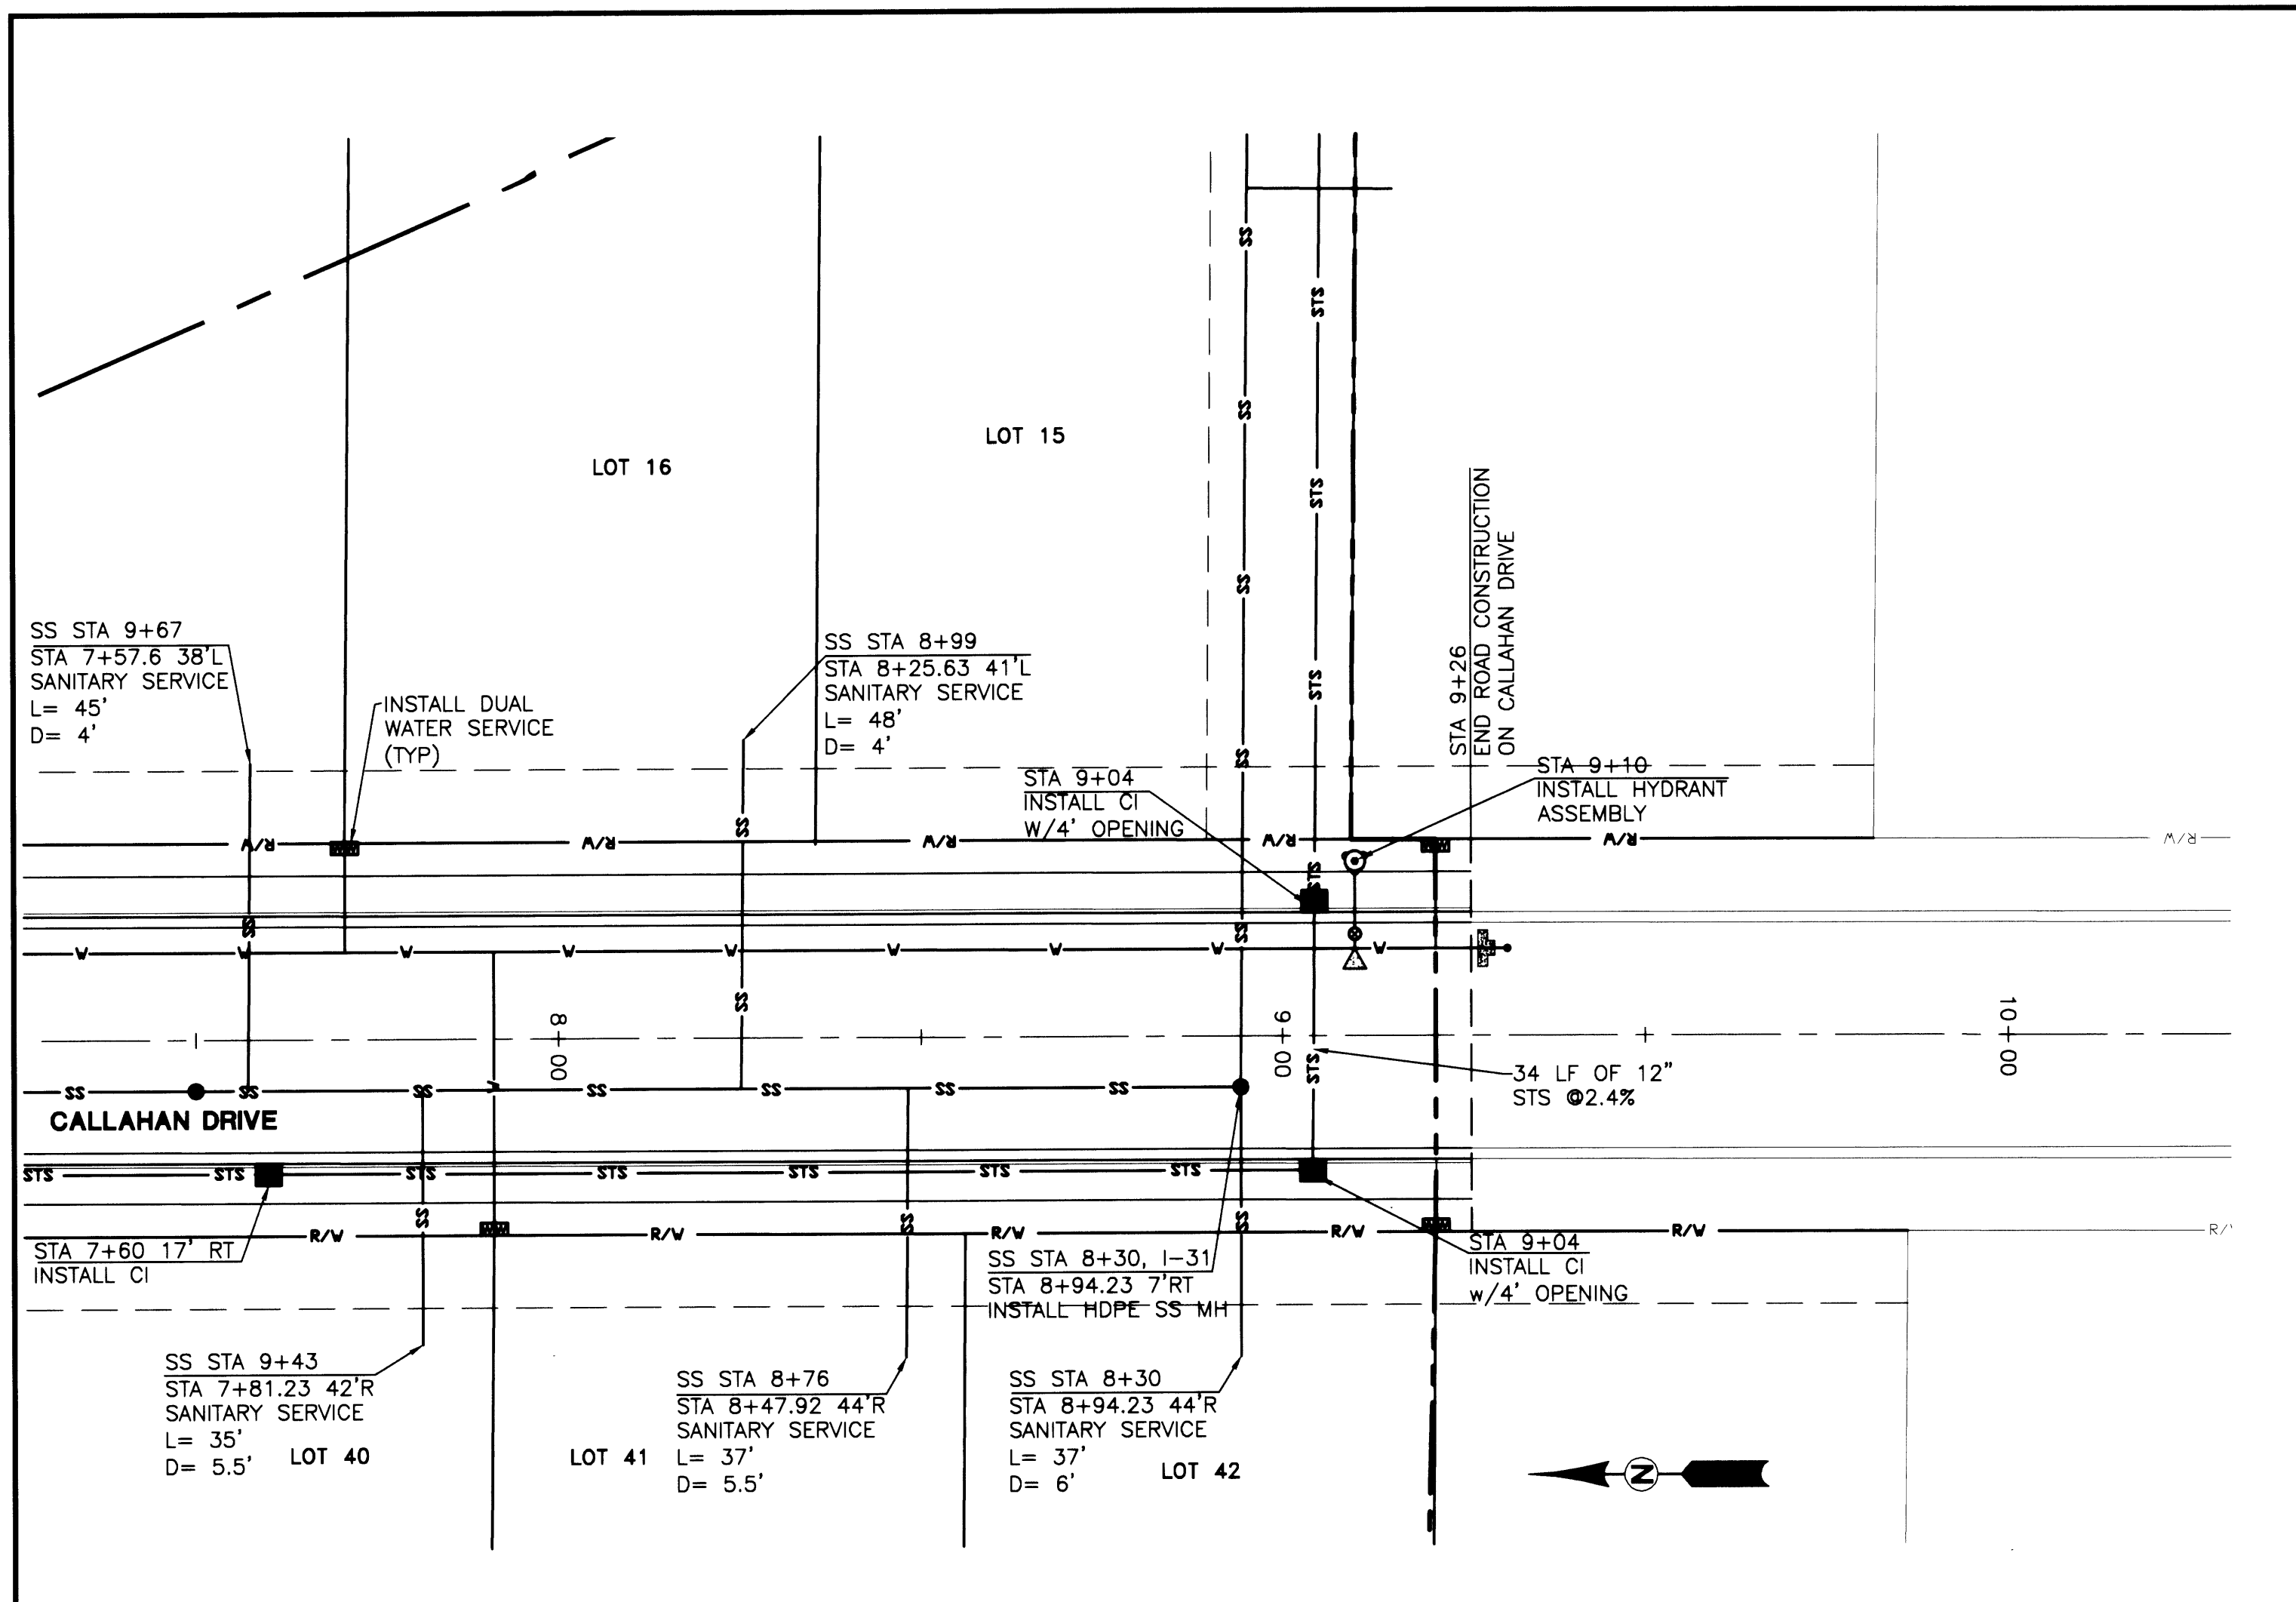

Rev.	Date	Dwg	Description
1	6/2/04	BWC	COUNTY & AGENCY REVIEW
2	1/17/05	ANV	AS-BUILTS

i.e. ENGINEERING
 741 SE Jackson Street
 Roseburg, Oregon 97470
 PHONE (541) 673-0166
 FAX (541) 440-9392

Project Name: RIVER CREST ESTATES

Title: PLAN AND PROFILE

DES DMA PROJECT NO. 1944-01

DWG BWC DATE: MAY 4, 2004

CHK SNL SCALE: 1"=5'

APP SNL SHEET: 7 OF 13

Co. Rd. # 375 J M.P. 0.00 - 0.11

DO NOT DUPLICATE

R375J001