



FILED
 Date: 10/18/2008 By: JC
 This survey consists of:
 Map:
 Name:
 Center Ppt:
 D:\Projects\100808\100808.dwg

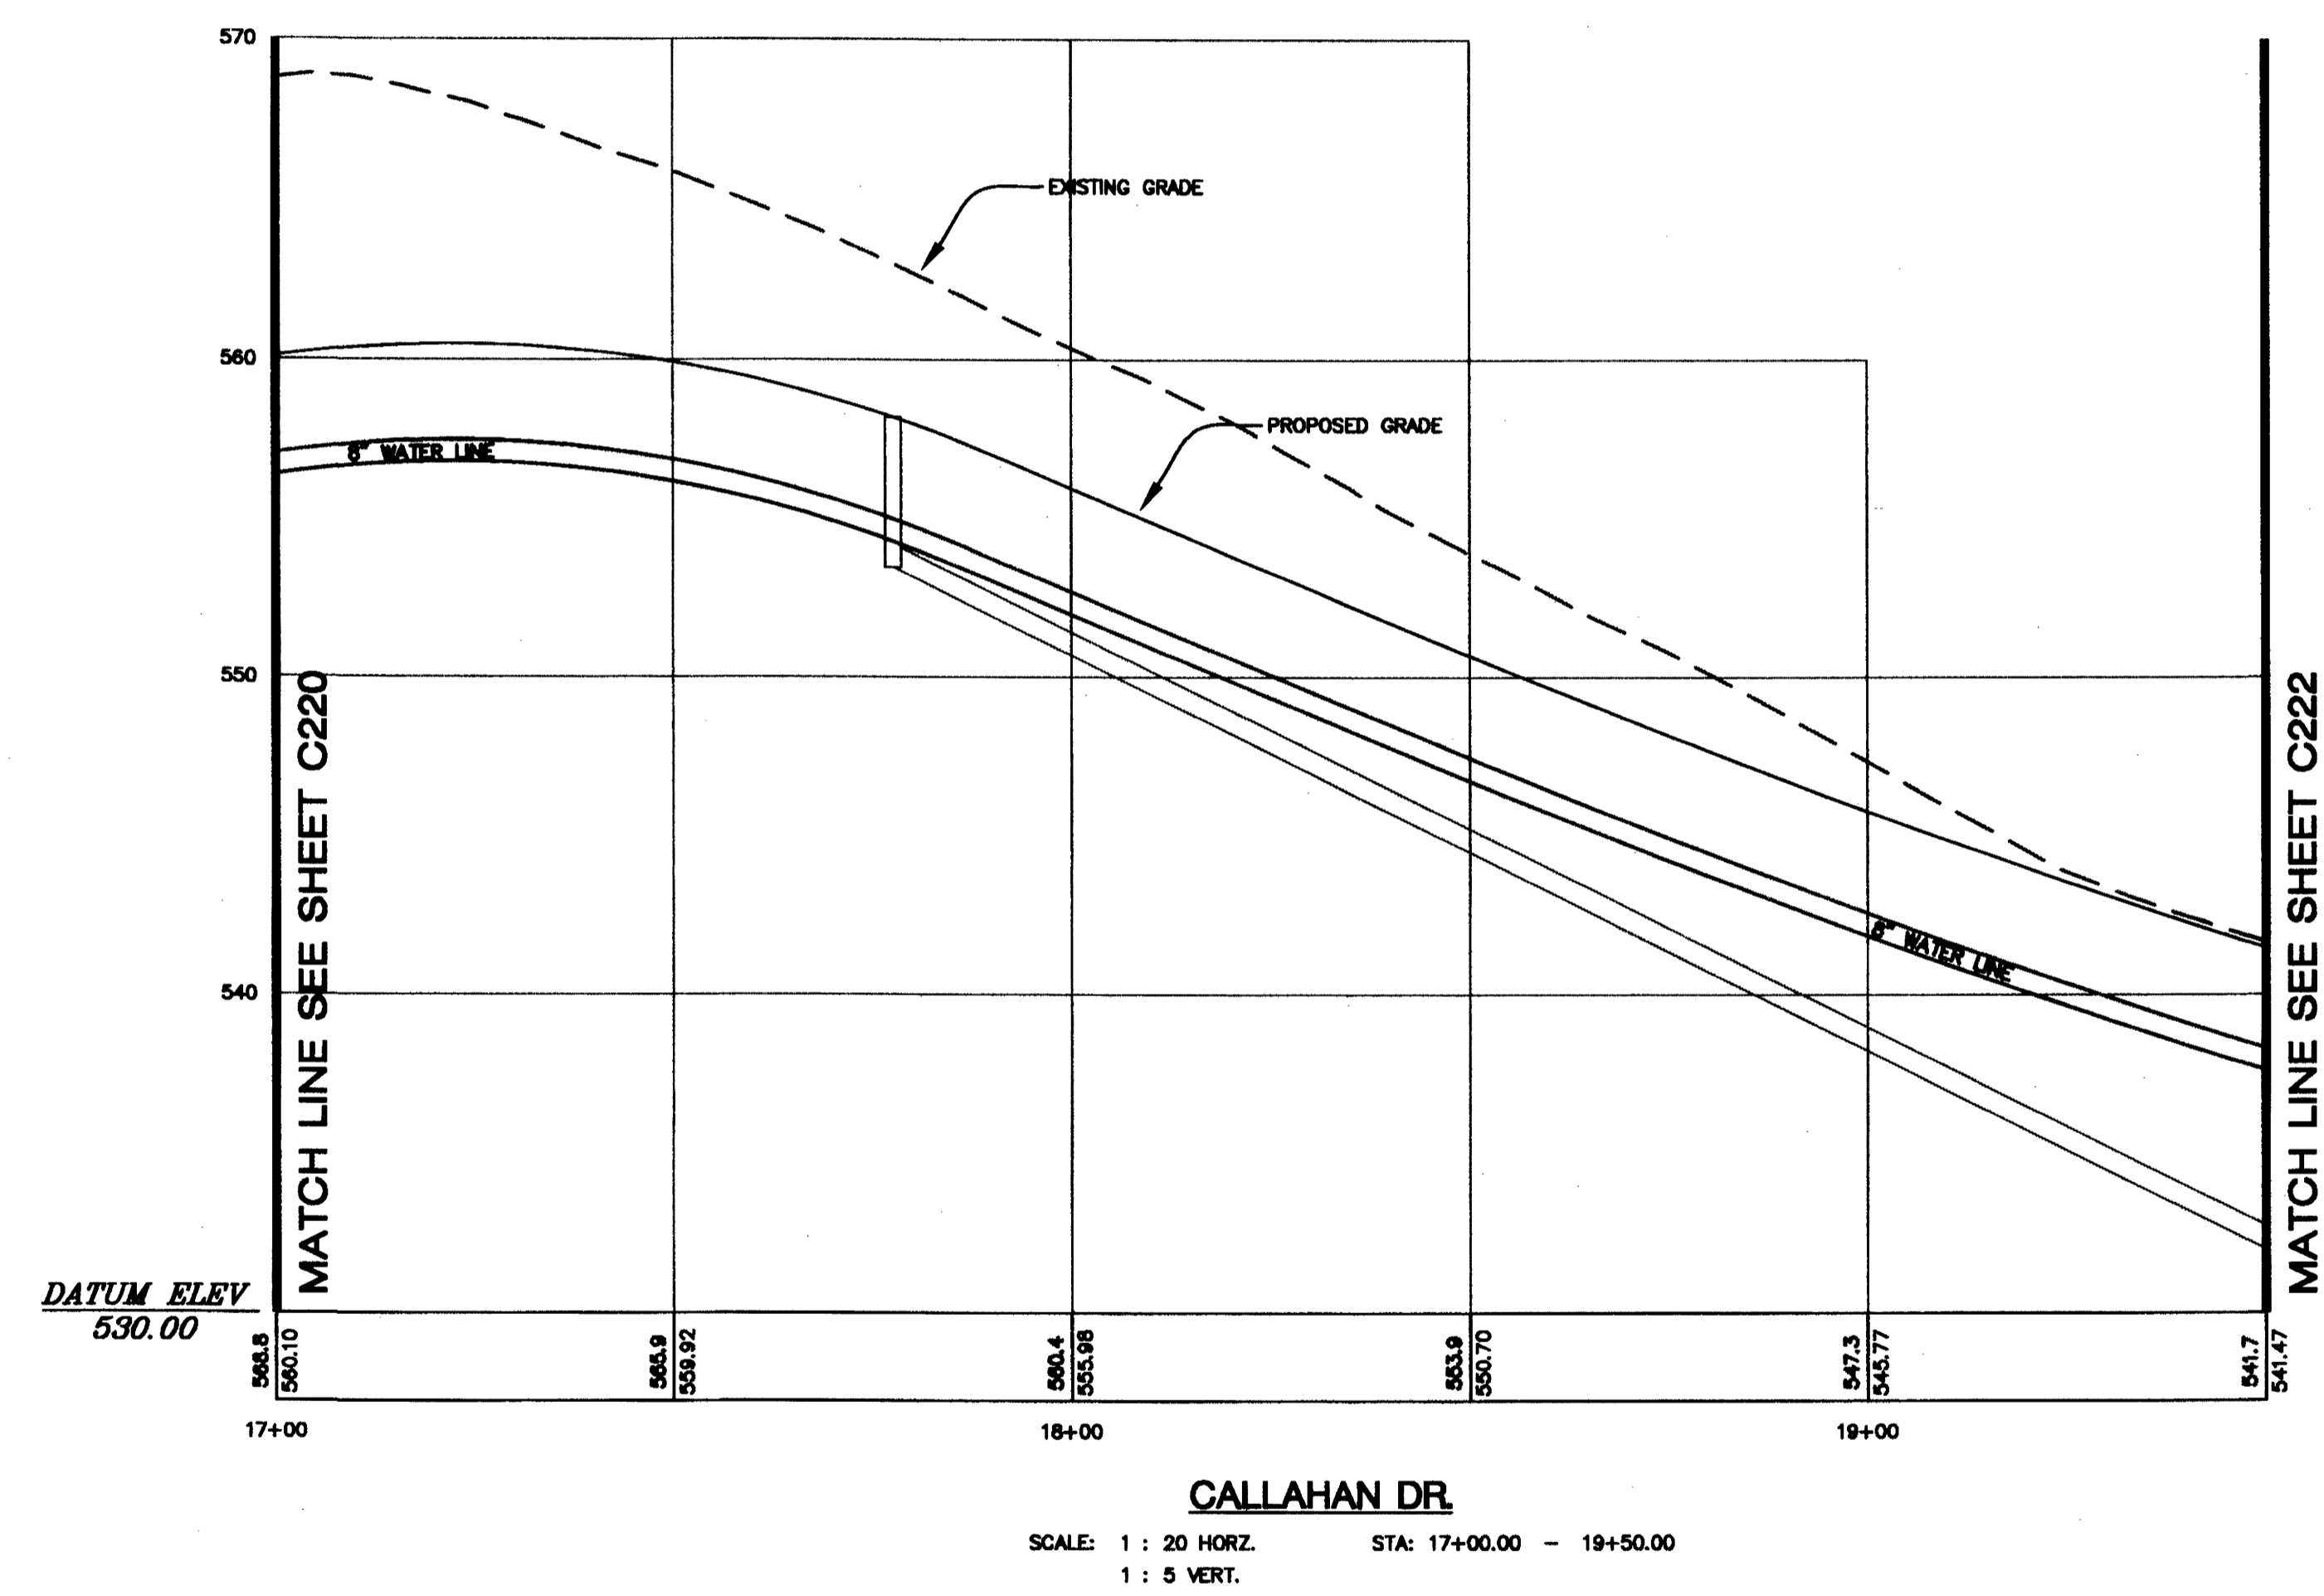

STORM DRAIN WEEPHOLE LOCATIONS:
 PROVIDE 3" WEEPHOLES FOR PERFORATED PIPE WITHIN STORM EASEMENT AT:
 STA: 18+11.89 RT 17.00' STA: 18+75.81 RT 18.00' RT
 PROVIDE 3" WEEPHOLES FOR ROOF DRAIN LATERAL DRAINAGE AT:
 STA: 18+20.54 LT 17.00 STA: 19+30.51 RT 39.90'
 STA: 17+86.36 RT 17.00 STA: 19+12.48 RT 34.34'
 STA: 18+86.88 LT 17.00 STA: 19+56.72 RT 39.32'
 STA: 18+46.54 RT 17.00

LEGEND:

SITE BOUNDARY	---
EXISTING RIGHT-OF-WAY	---
EXISTING CENTER LINE	---
EXISTING LOT LINE	---
EXISTING EASEMENT LINE	---
EXISTING CURB LINE	---
EXISTING SIDEWALK LINE	---
PHASE LINE	---
EXISTING GAS LINE	---
EXISTING STORM LINE	---
EXISTING CURB INLET	□
EXISTING SANITARY LINE	---
EXISTING SANITARY MANHOLE	○
PROPOSED RIGHT-OF-WAY	---
PROPOSED CENTER LINE	---
PROPOSED LOT LINE	---
PROPOSED EASEMENT LINE	---
PROPOSED CURB LINE	---
PROPOSED SIDEWALK	---
PROPOSED STORM LINE	---
PROPOSED CURB INLET	□
PROPOSED SANITARY LINE	---
PROPOSED SANITARY MANHOLE	○
PROPOSED WATER LINE	---
PROPOSED WATER VALVE	●
PROPOSED WATER METER	⊗
PROPOSED FIRE HYDRANT	⊗

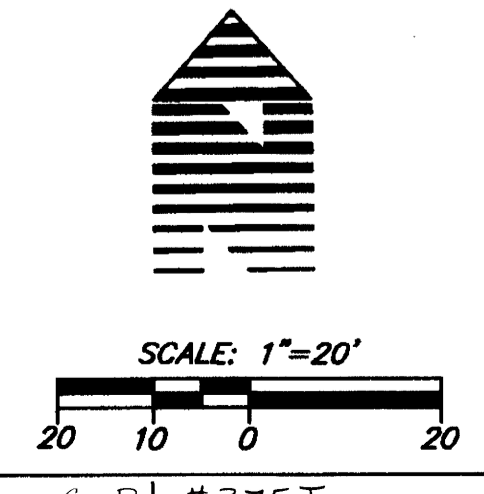

W R G
 DESIGN
 5415 SW Weagata Dr, Ste 100 Portland, OR 97221
 Tel: 503.498.2500 Fax: 503.498.2600
 PLANNERS • ENGINEERS • LANDSCAPE ARCHITECTS • SURVEYORS

CALLAHAN DR. STORM PLAN STA 17+00.00 - 19+50.00
RIVER CREST ESTATES 2 - PHASE 2
HAYDEN HOMES
 Green District, Oregon

AS-BUILT
 BASED ON CHANGES IDENTIFIED DURING CONSTRUCTION AS OF 3/7/08



DATE: 3/2/08
 DRAWN: MDB
 DESIGNED: MDB
 CHECKED: KBR
 PROJECT #: HAY89800
 SHEET TITLE: CALLAHAN STORM PLAN
 SHEET NUMBER: C221
 OF 4 SHEETS

CO. RD. 375J

SS375J02