

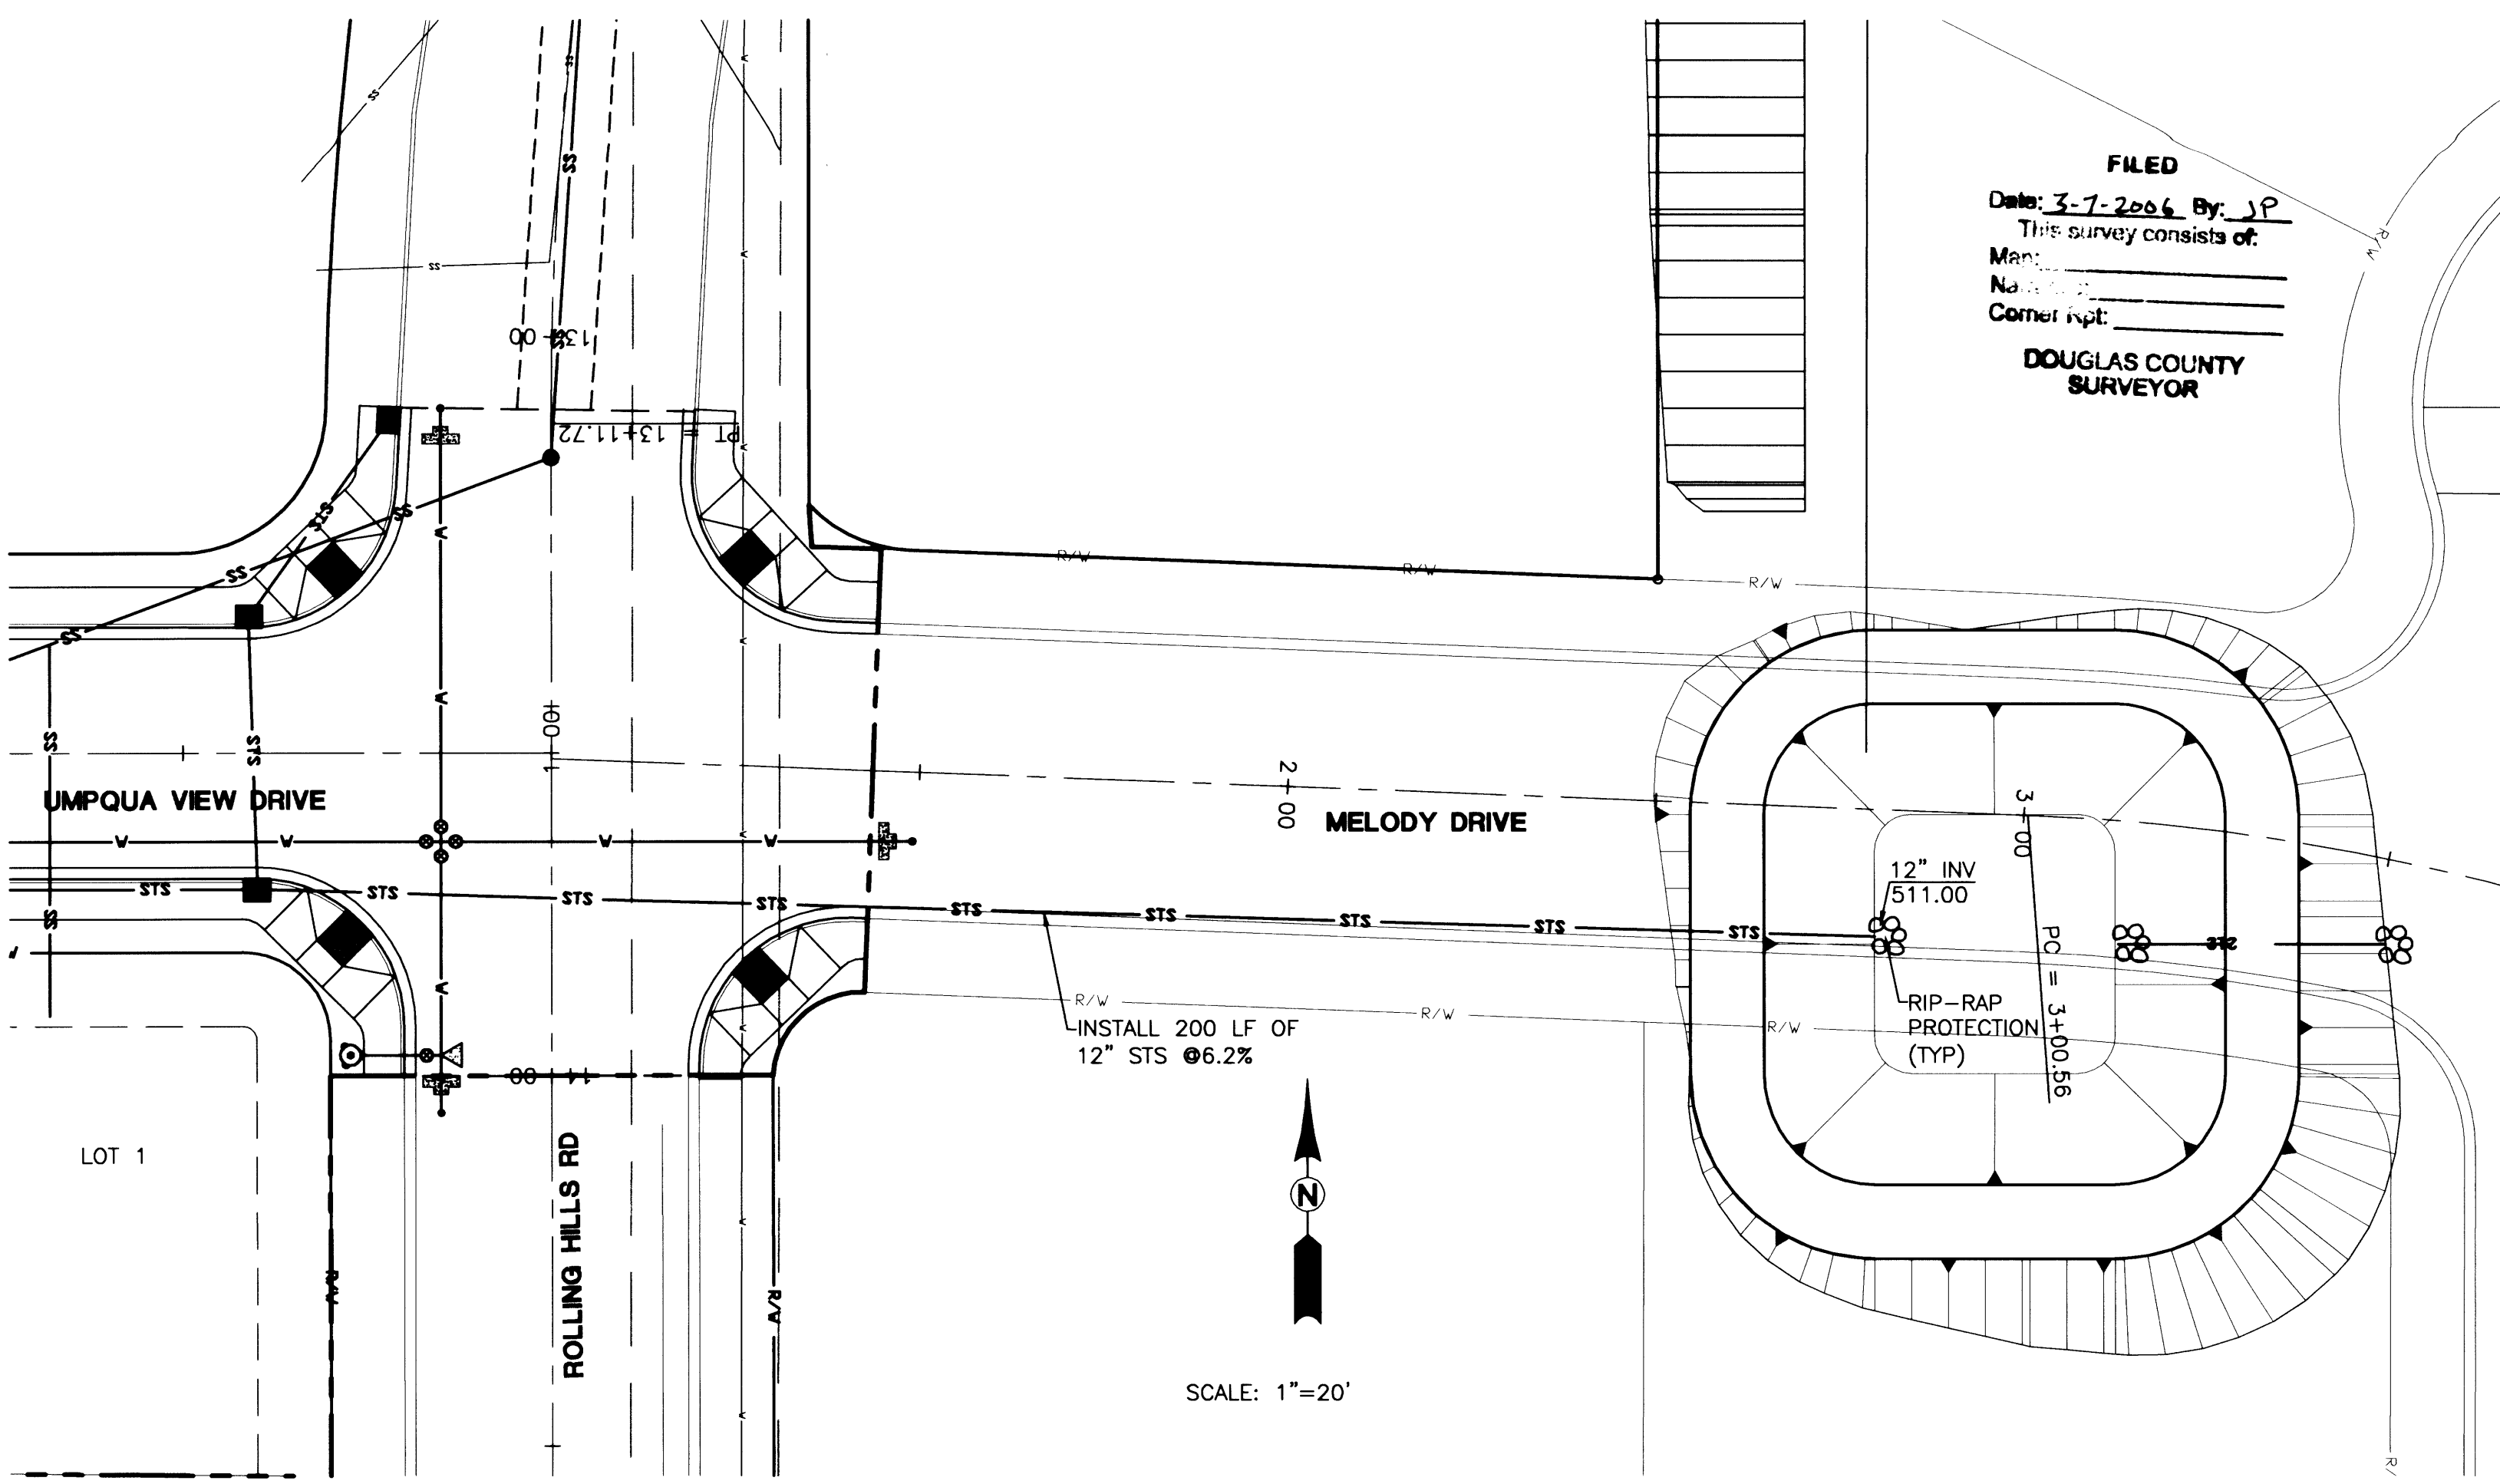
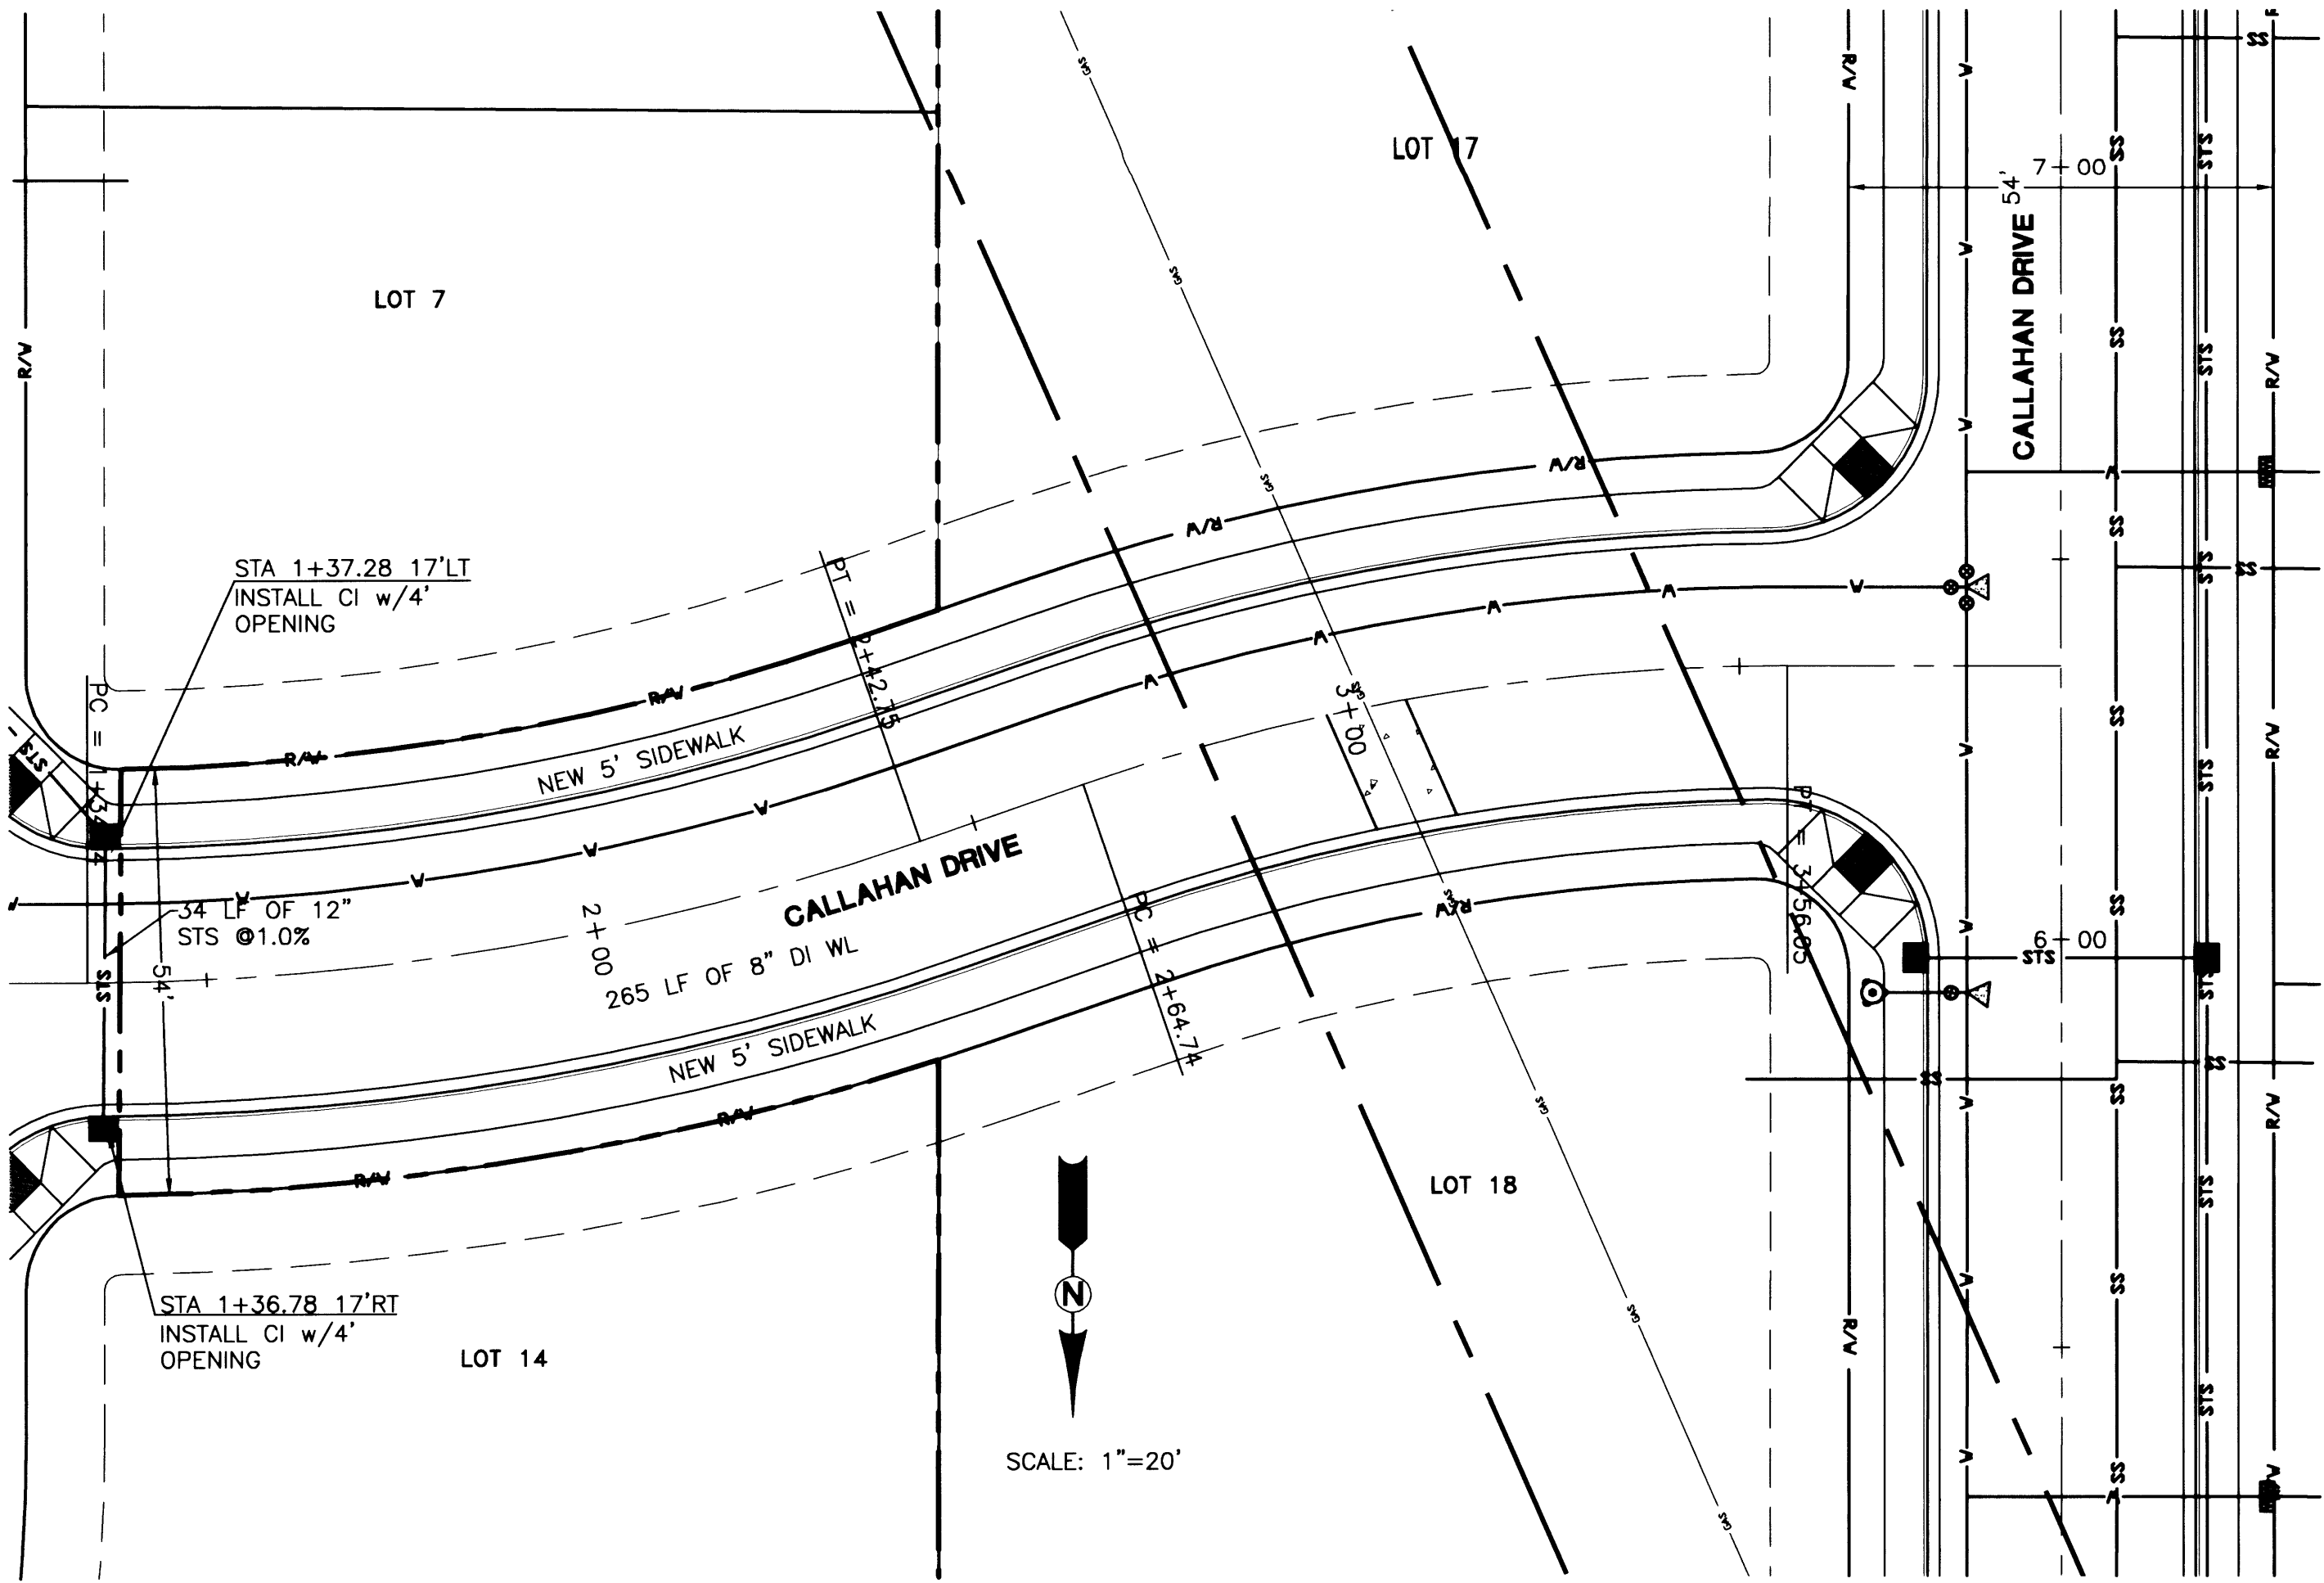


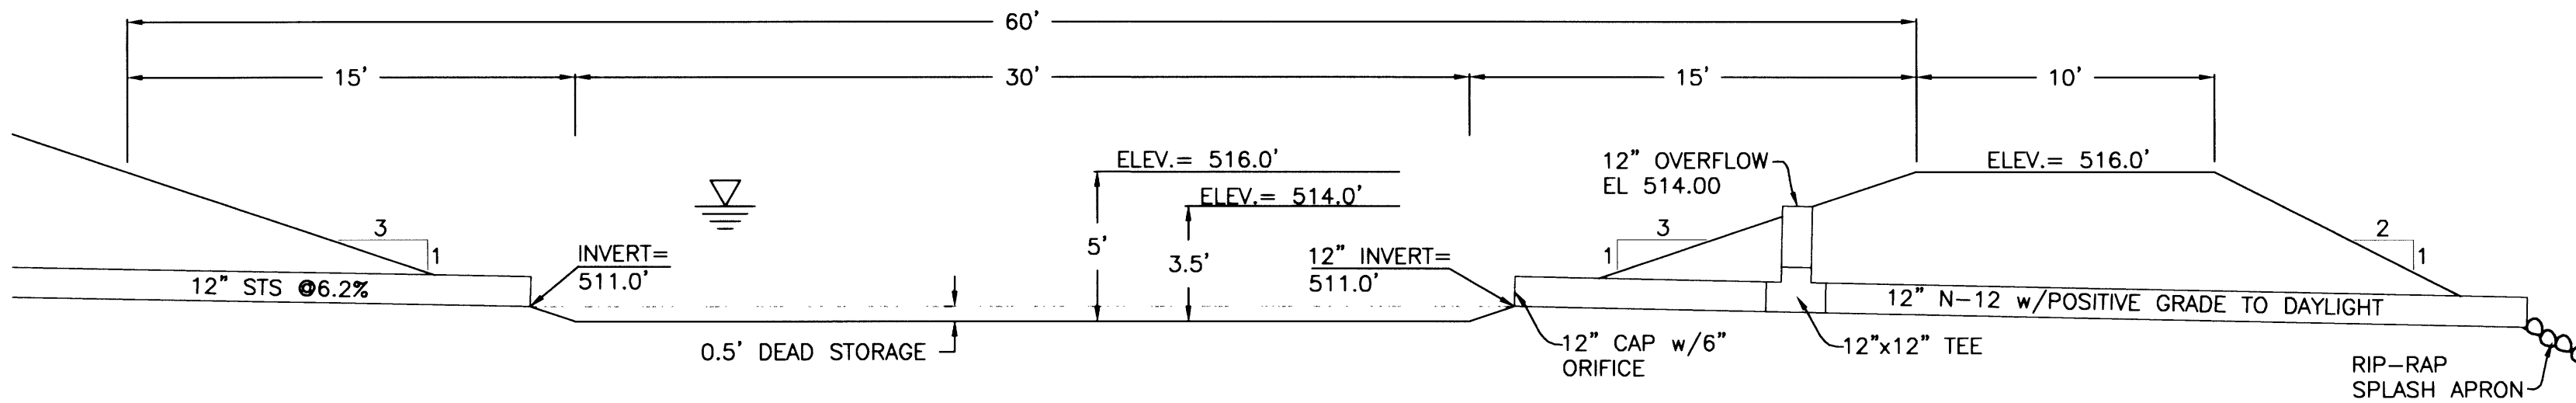


FILED
Date: 3-7-2006 By: J.P.
This survey consists of:
Map:
Name:
Corner rpt:
DOUGLAS COUNTY
SURVEYOR

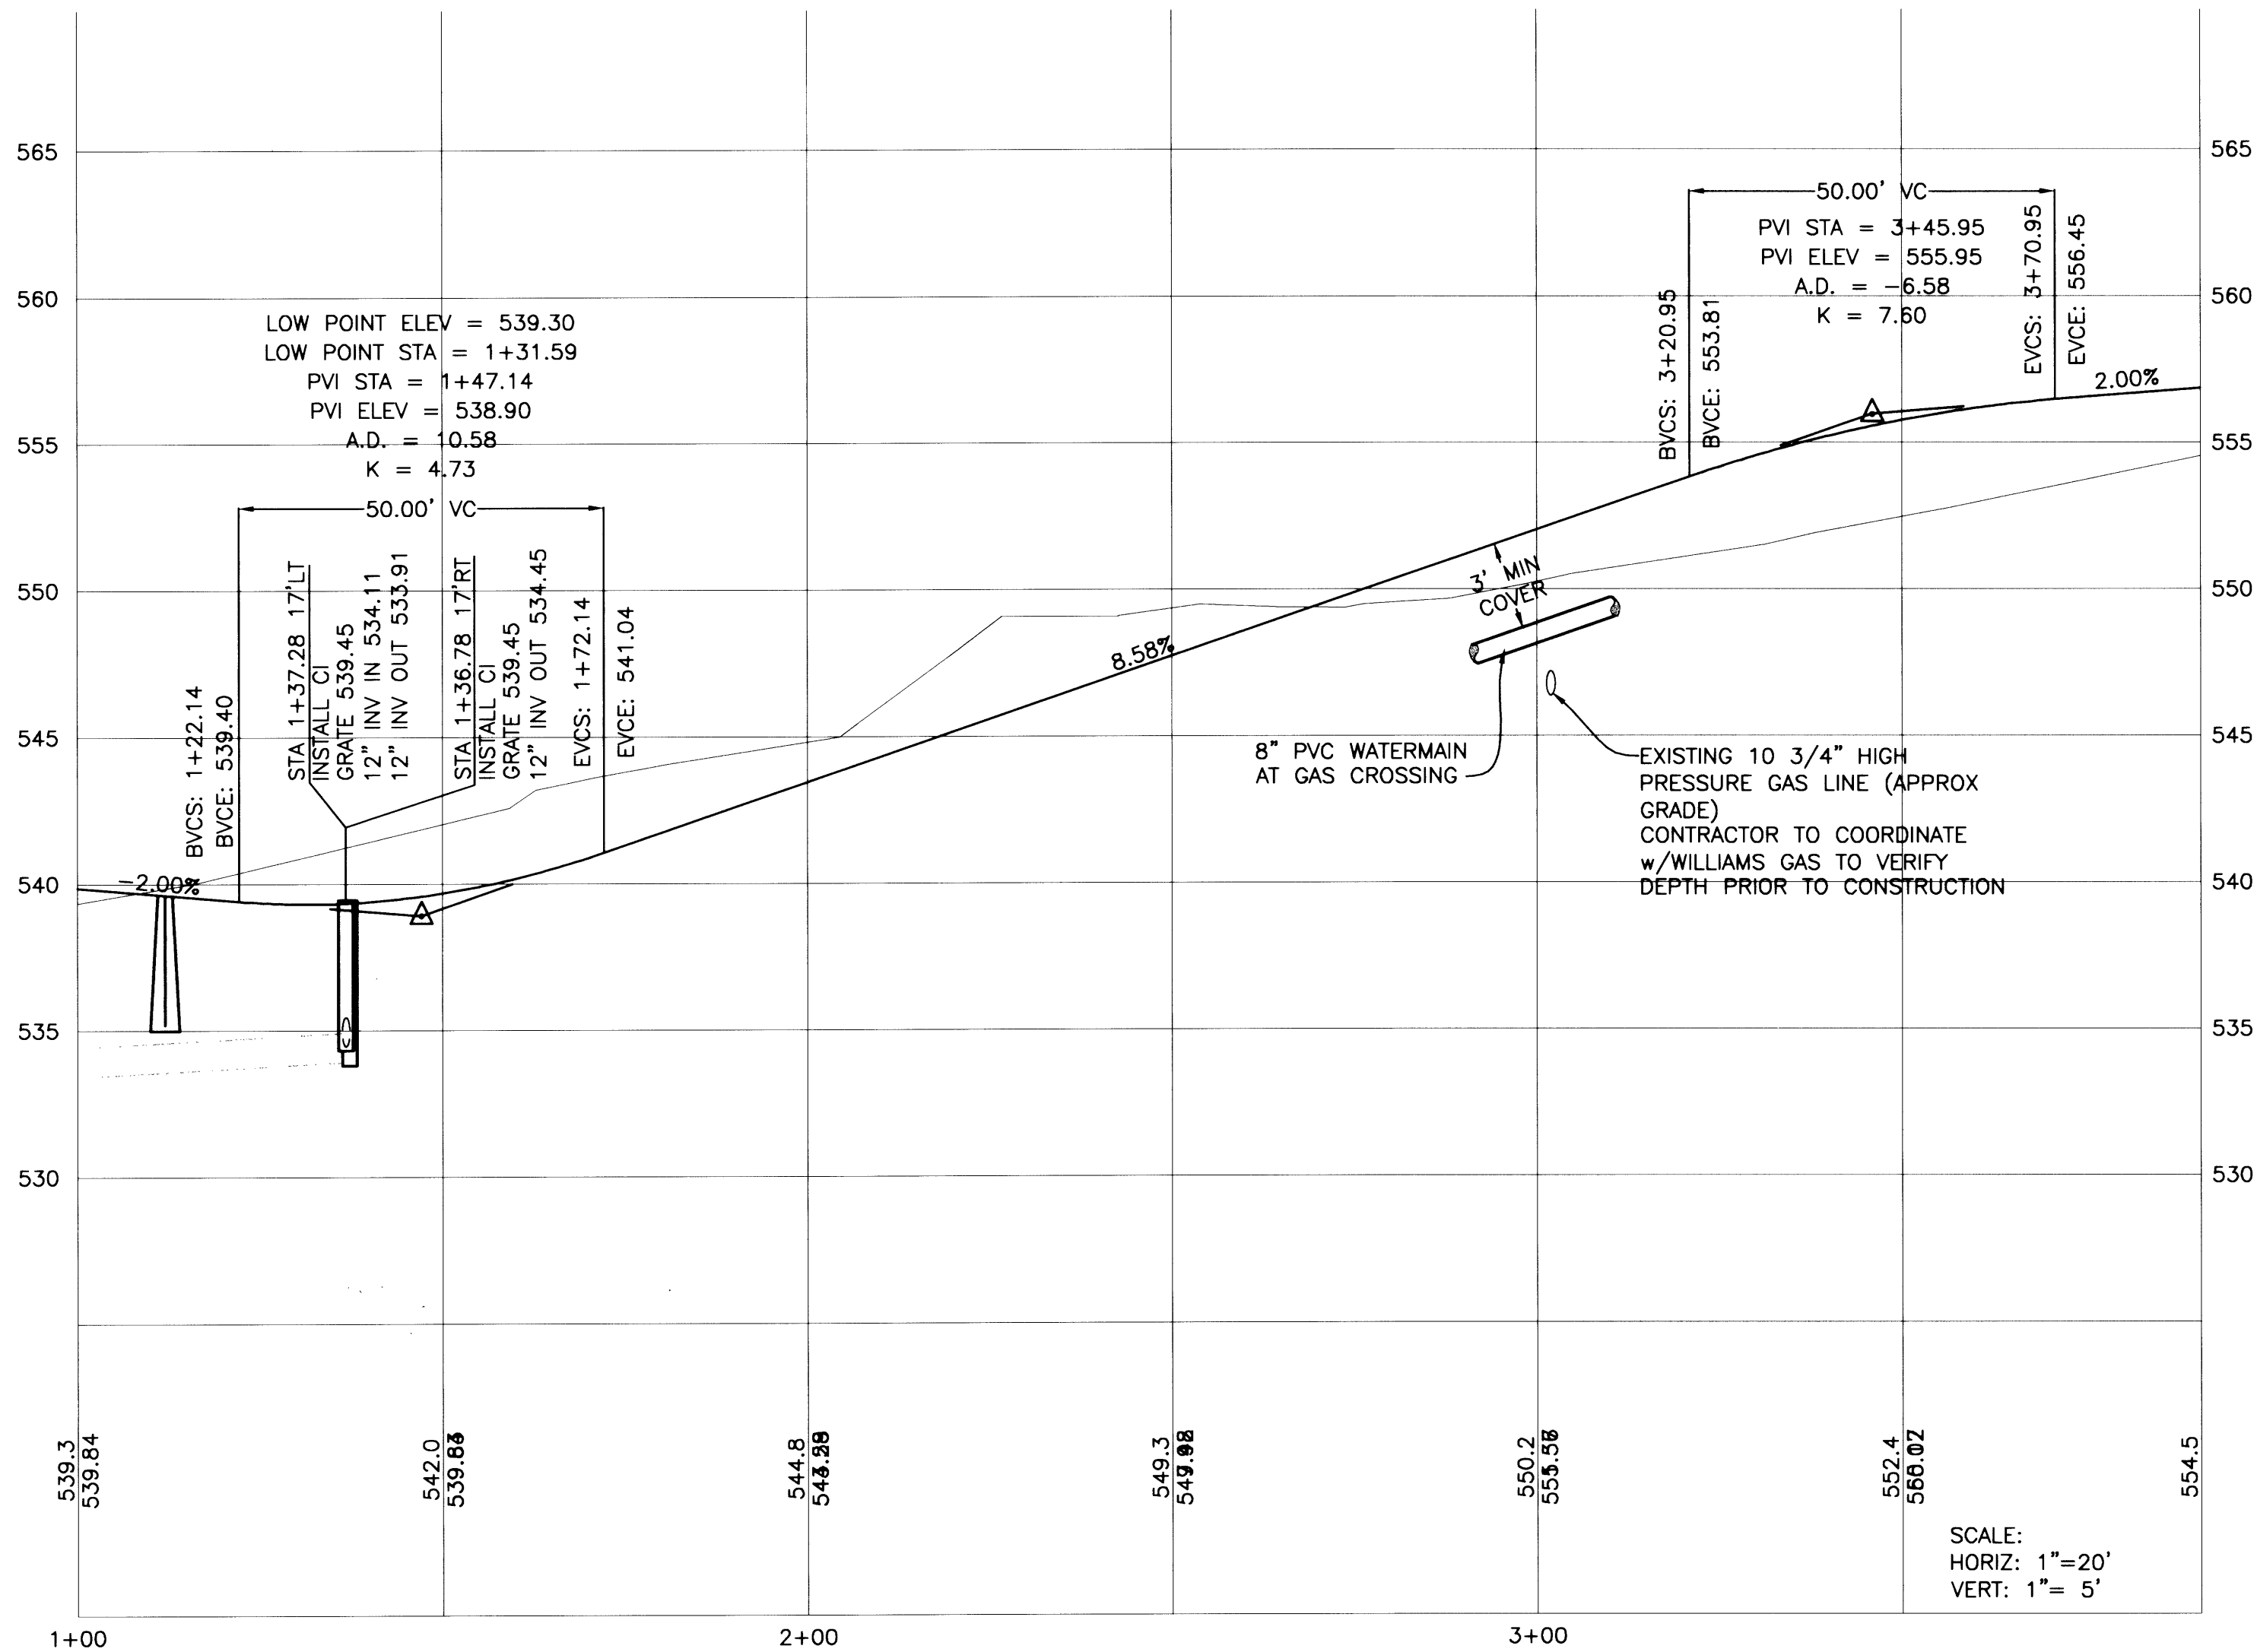

TEMPORARY DETENTION POND
FOR PHASES 1 AND 2
SCALE: 1"=5'

POND CRITERIA
DESIGN EVENT= 10 YR
DRAINAGE AREA= 6 ACRES
PRE-DEVELOPMENT FLOW= 1.5 CFS
POST-DEVELOPMENT FLOW= 3.9 CFS
REQUIRED STORAGE= 3,600 CU FT
REQUIRED BOTTOM AREA= 610 SQ FT
ACTUAL STORAGE= 4,500 CU FT
ACTUAL BOTTOM AREA= 850 SQ FT

NOTE:
FOR CLARITY, DRIVEWAYS ARE NOT SHOWN.
CONTRACTOR TO COORDINATE w/OWNER FOR LOCATION & WIDTH.
CALL BEFORE YOU DIG 1
ONE CALL (800) 332-2344
OAR 952-001-0010 THROUGH
OAR 952-001-0090

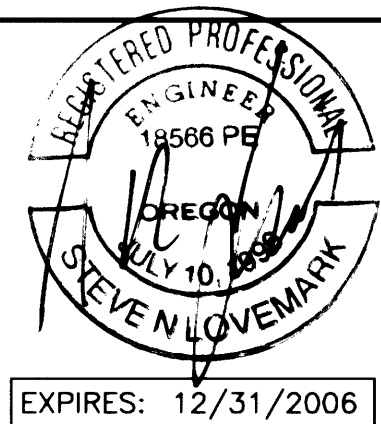

Rev.	Date	Dwg	Description
1	6/2/04	BWC	COUNTY & AGENCY REVIEW
2	1/17/05	ANV	AS-BUILTS

i.e. ENGINEERING
741 SE Jackson Street
Roseburg, Oregon 97470
PHONE (541) 673-0166
FAX (541) 440-9392
Email: ieengineering.com

Project Name:	
RIVER CREST ESTATES	
Title:	DETENTION POND
DES DMA	PROJECT NO. 1944-01T5
DWG BWC	DATE: MAY 4, 2004
CHK SNL	SCALE: AS SHOWN
APP SNL	SHEET: 8 OF 13

Co.Rd. # 375 H, 375 J, 375 K

DO NOT DUPLICATE

R375DPON