


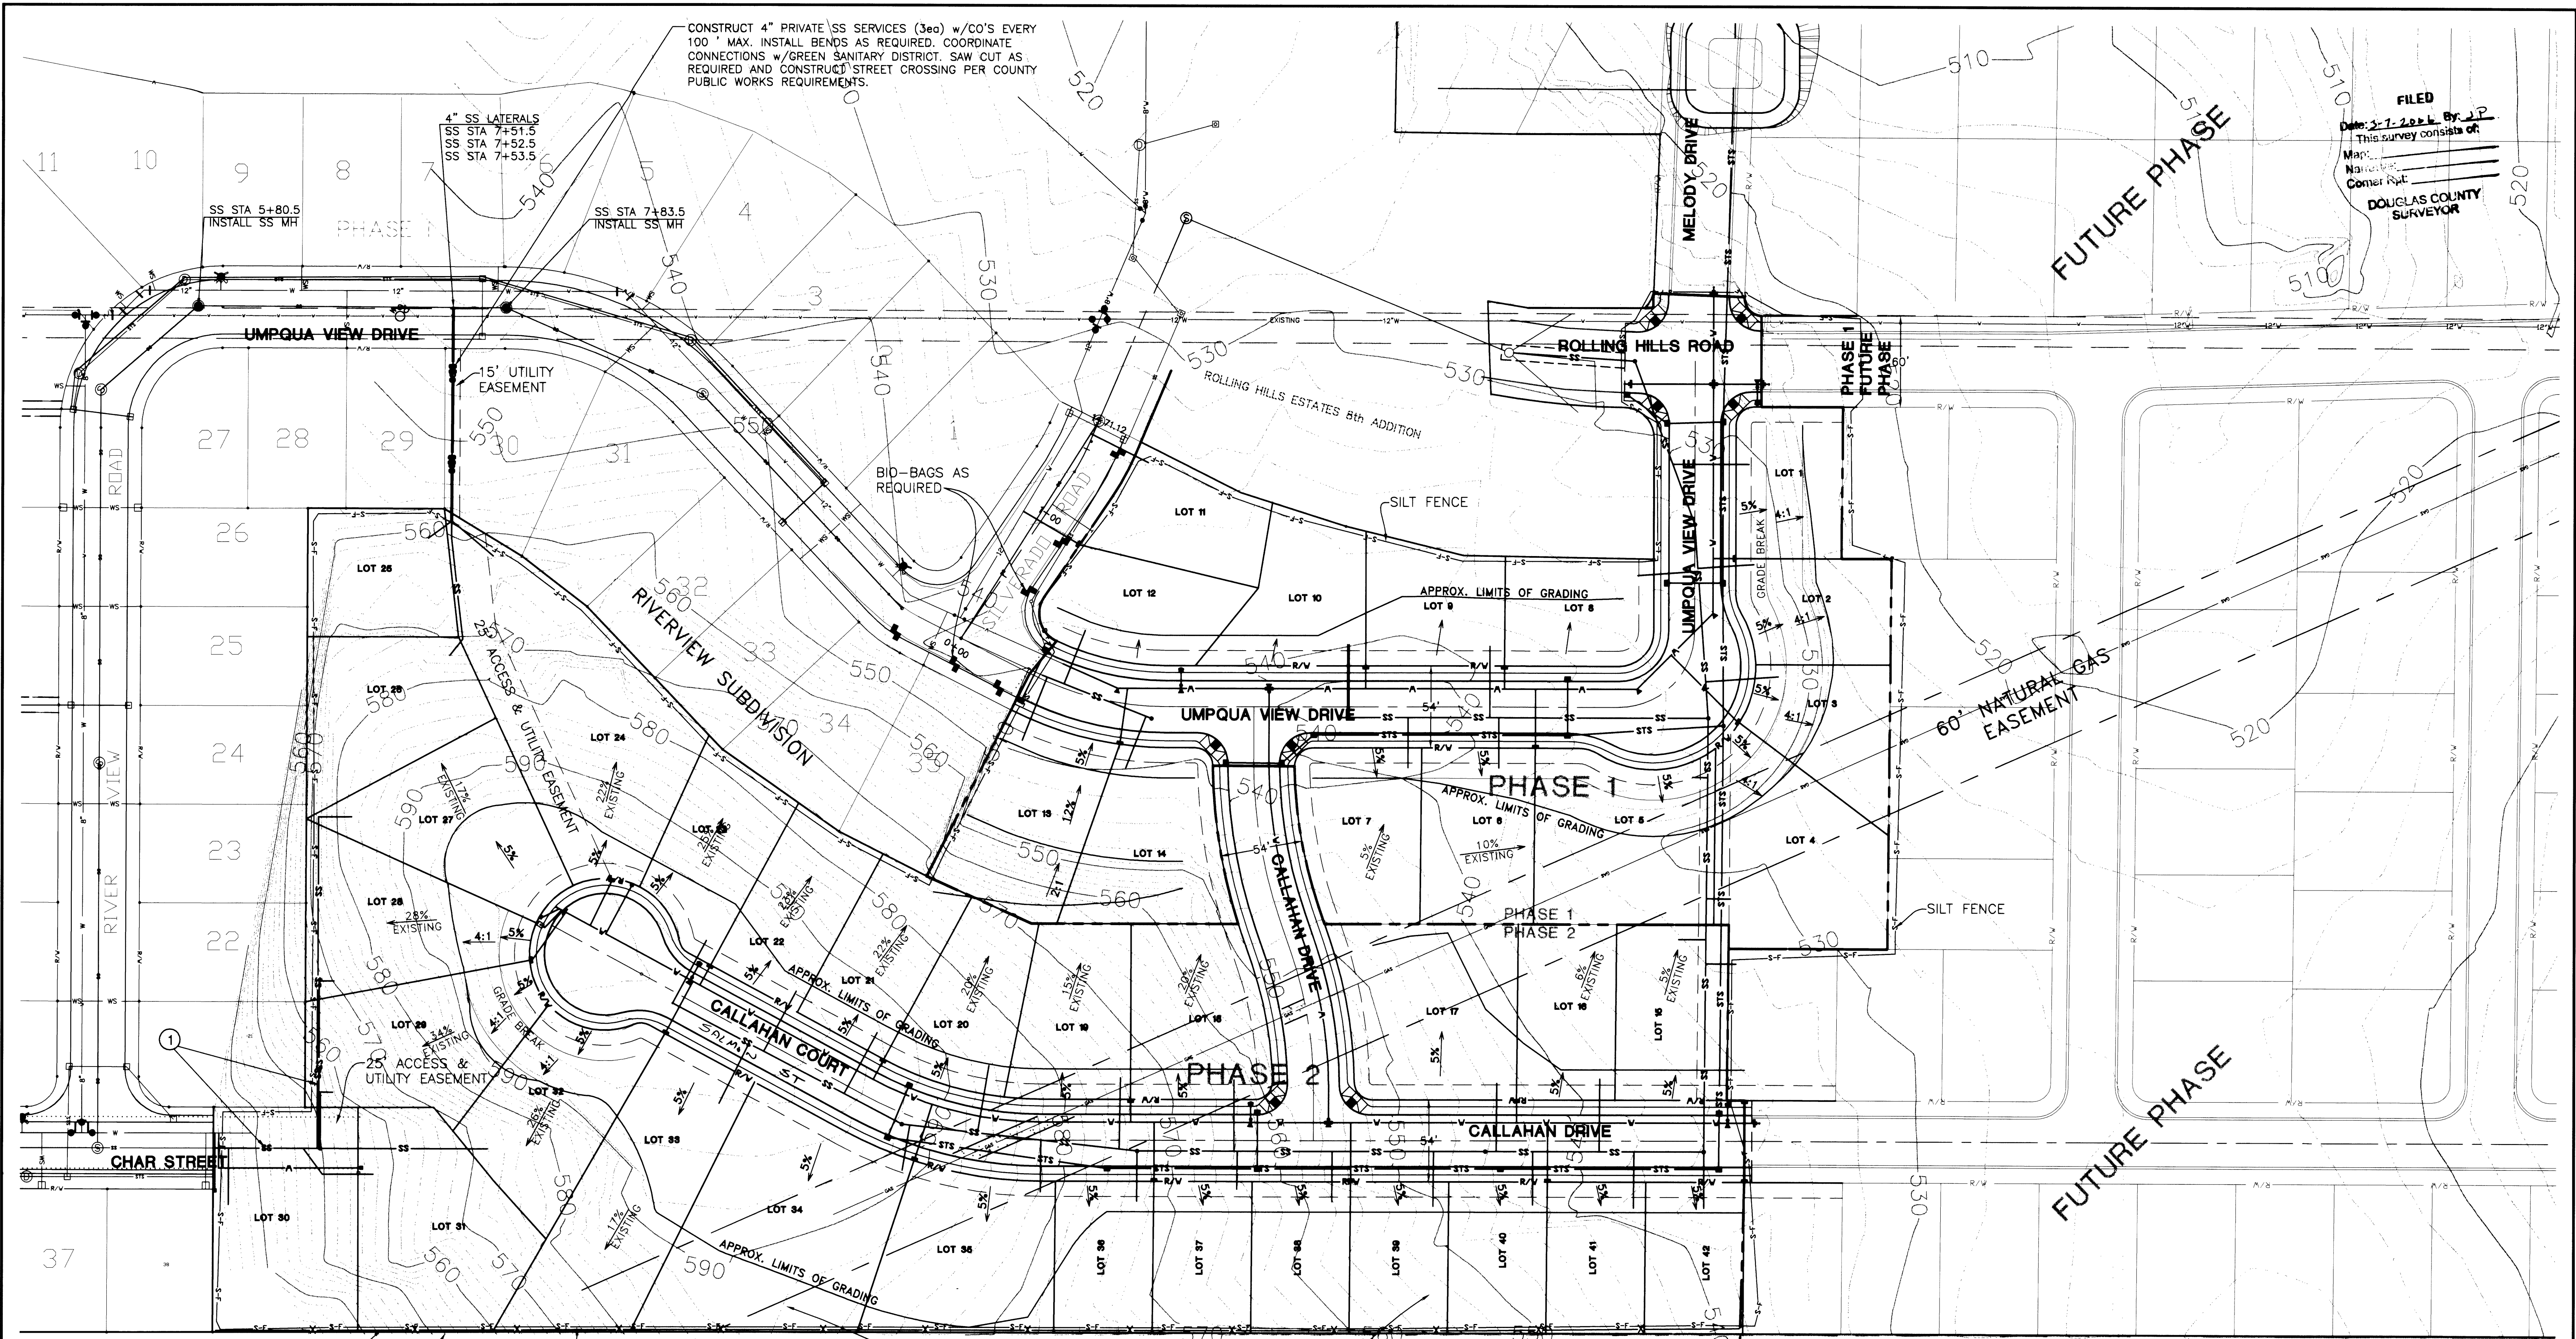

FILED
Date: 3-1-2004 By: J.P.
This survey consists of:
Map:
Name:
Corner Ref:
DOUGLAS COUNTY
SURVEYOR

INSTALL 1007± LF OF 6' HIGH CL-6R CHAIN LINK FENCE ON PROPERTY LINE PER COUNTY CONDITIONS.

① CONSTRUCT 4" PRIVATE SS SERVICES (3ea) w/CO'S EVERY 100' MAX. INSTALL BENDS AS REQUIRED. COORDINATE INSTALLATION w/GREEN SANITARY DISTRICT.

EROSION SHEET LEGEND:


ORIGINAL _____ ELEV. _____

DESIGN _____ ELEV. _____

SILT FENCE _____



SEDIMENT BARRIER _____

INLET PROTECTION _____

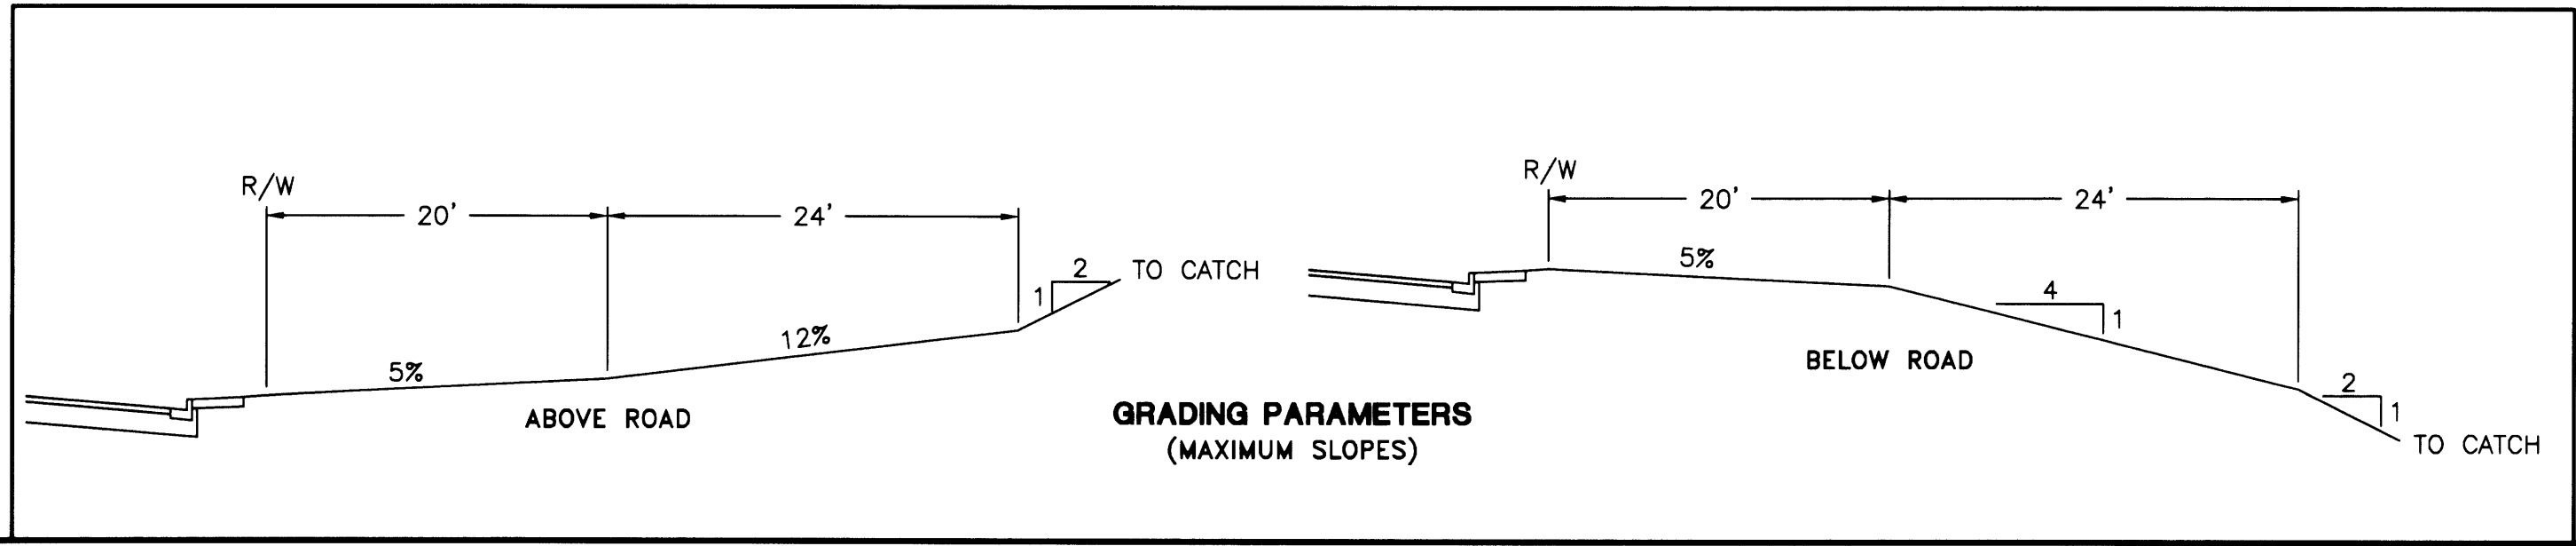

NOTE:
FOR CLARITY, DRIVEWAYS ARE NOT SHOWN.
CONTRACTOR TO COORDINATE w/OWNER
FOR LOCATION & WIDTH.

CALL BEFORE YOU DIG 1
ONE CALL: (800) 332-2344
OAR 952-001-0010 THROUGH
OAR 952-001-0090

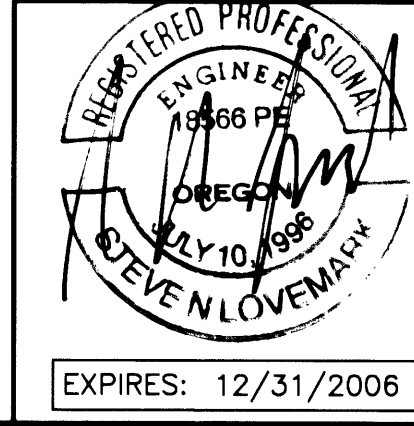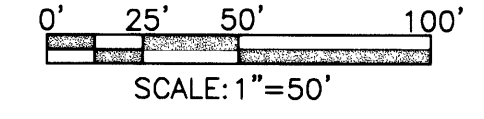

Rev.	Date	Dwg	Description
1	6/2/04	BWC	COUNTY & AGENCY REVIEW
2	1/17/05	ANV	AS-BUILTS

i.e. ENGINEERING 741 SE Jackson Street Roseburg, Oregon 97470 PHONE (541) 673-0166 FAX (541) 440-9392 Email: iemail@ieengineering.com	
Project Name:	
RIVER CREST ESTATES	
Title:	LOT GRADING & EROSION CONTROL
DES DMA	PROJECT NO. 1944-01
DWG BWC	DATE: MAY 4, 2004
CHK SNL	SCALE: AS SHOWN
APP SNL	SHEET: 3 OF 13

R375EROS