

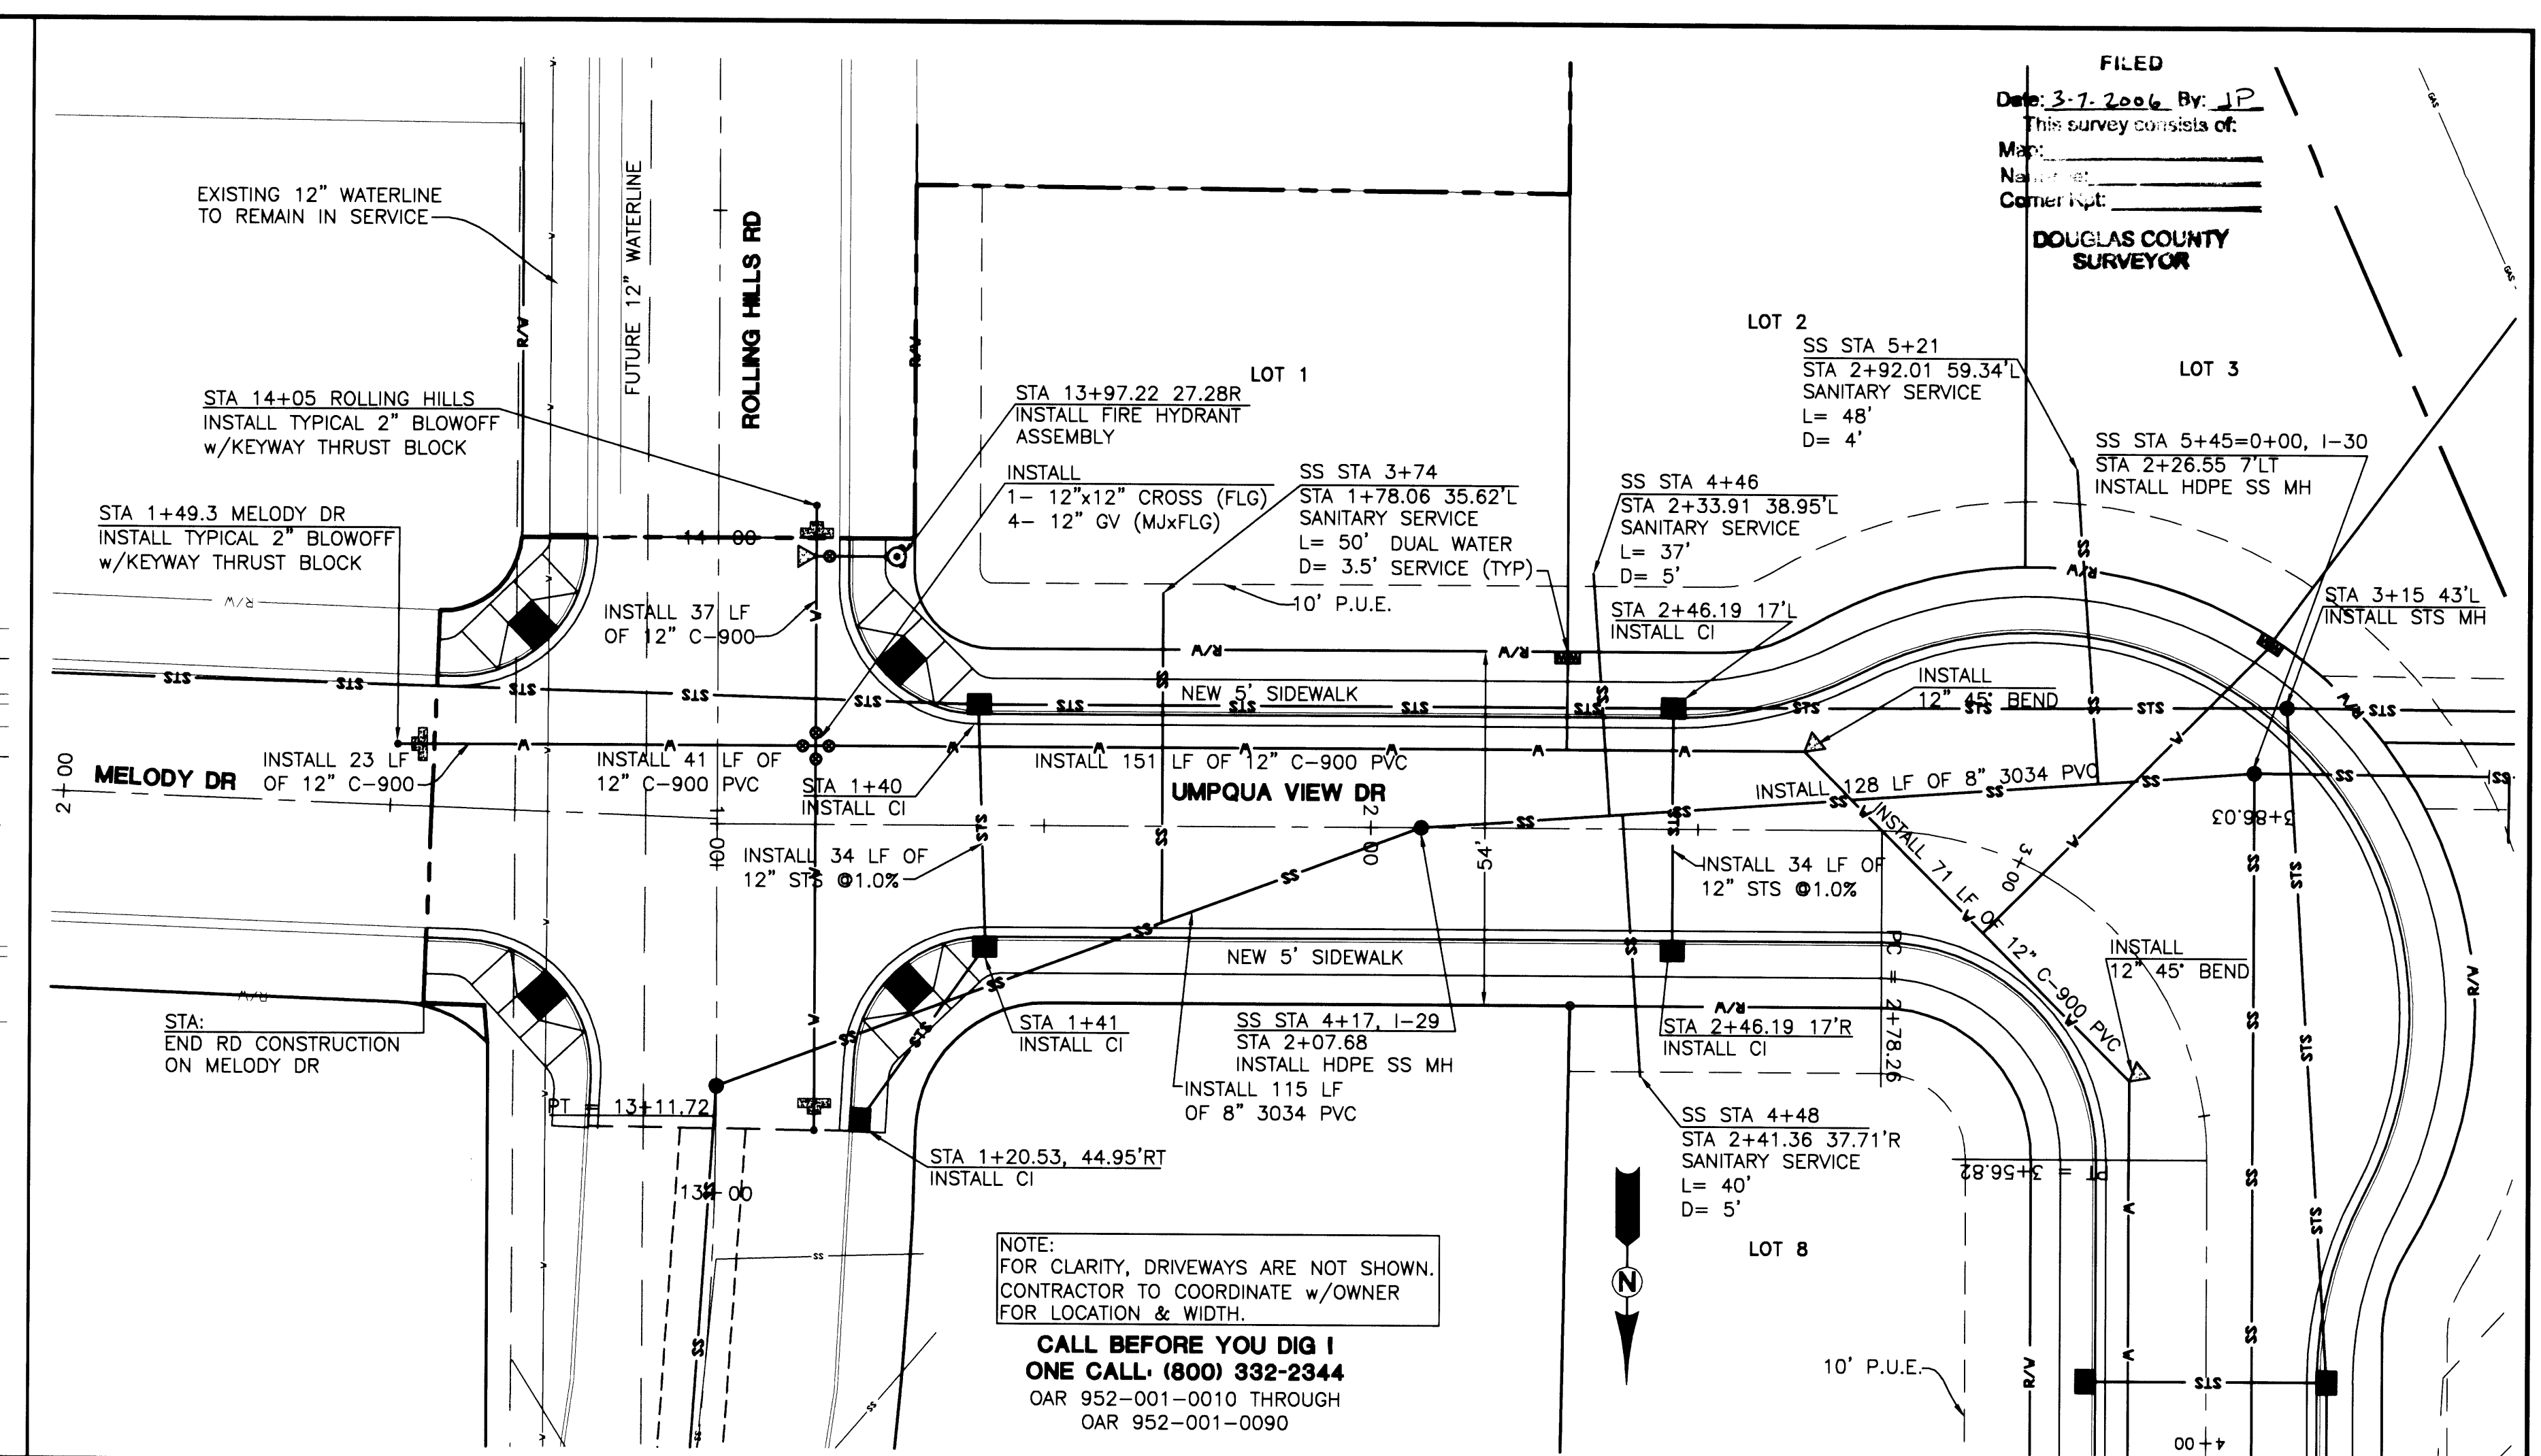


FILED  
 Date: 3-7-2006 By: JP  
 This survey consists of:  
 Map:  
 Name:  
 Corner 1/4:  
**DOUGLAS COUNTY SURVEYOR**

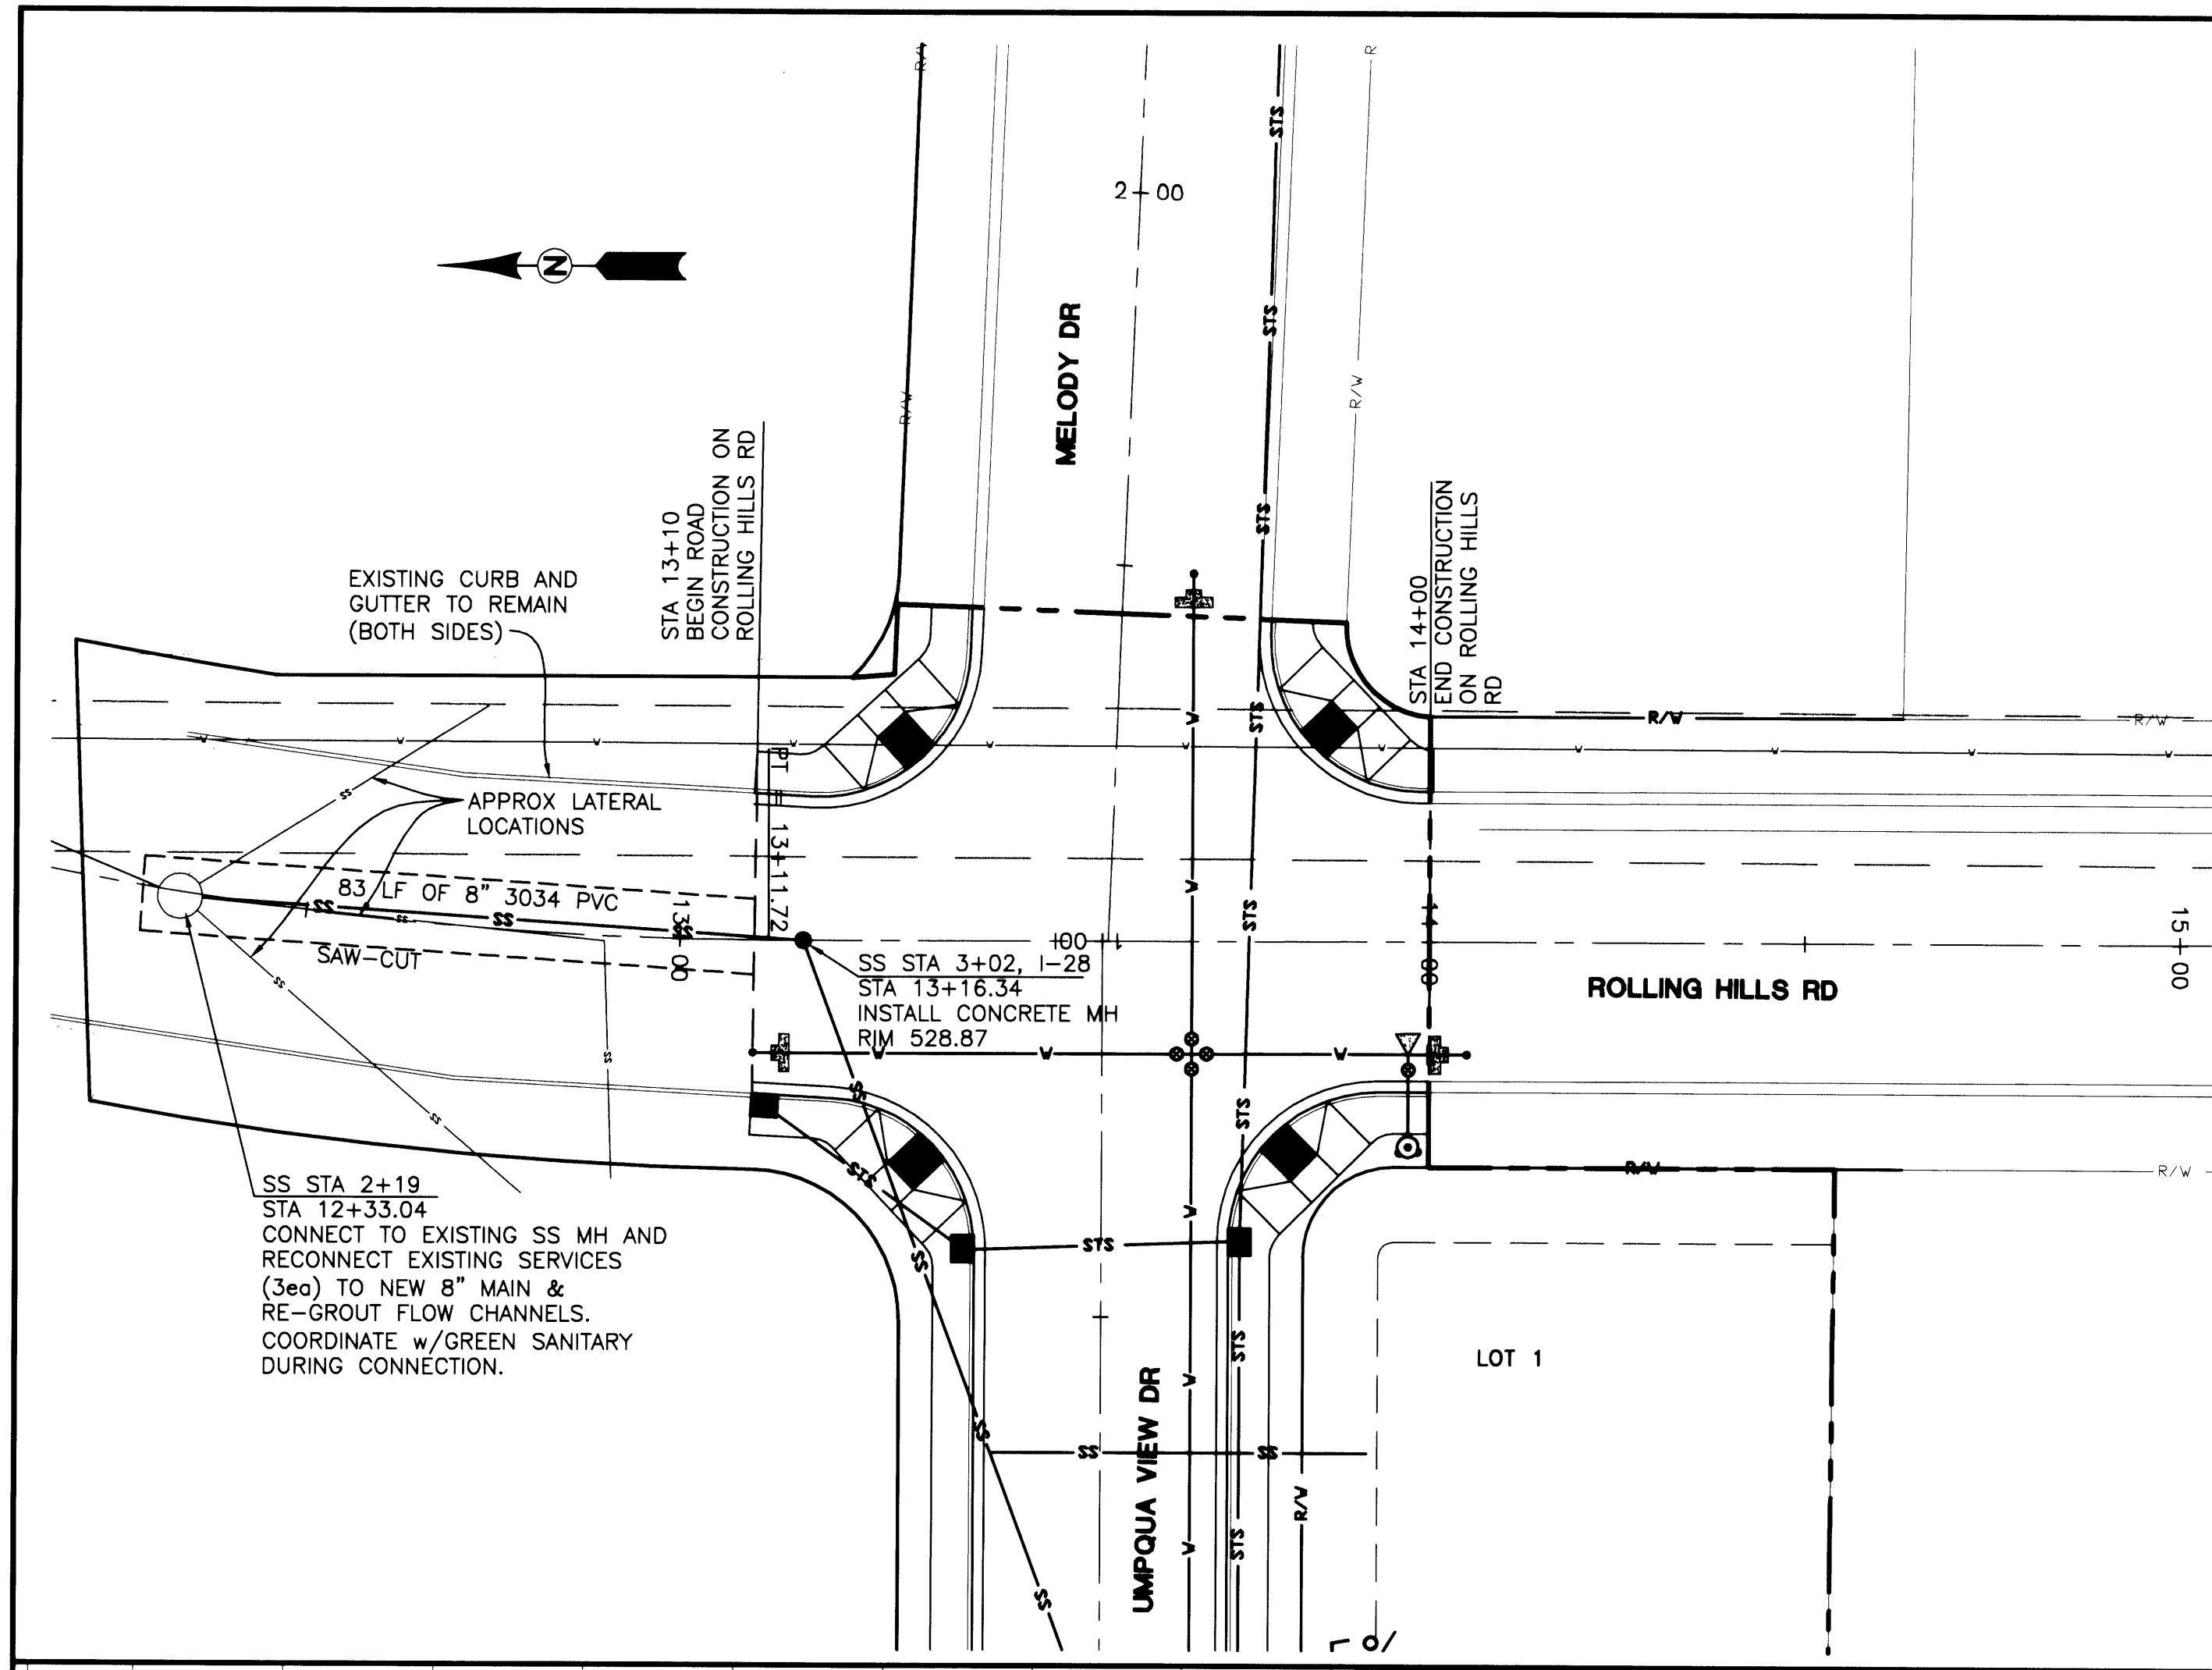

NOTE:  
 FOR CLARITY, DRIVEWAYS ARE NOT SHOWN.  
 CONTRACTOR TO COORDINATE W/OWNER  
 FOR LOCATION & WIDTH.  
**CALL BEFORE YOU DIG 1**  
**ONE CALL: (800) 332-2344**  
 OAR 952-001-0010 THROUGH  
 OAR 952-001-0090

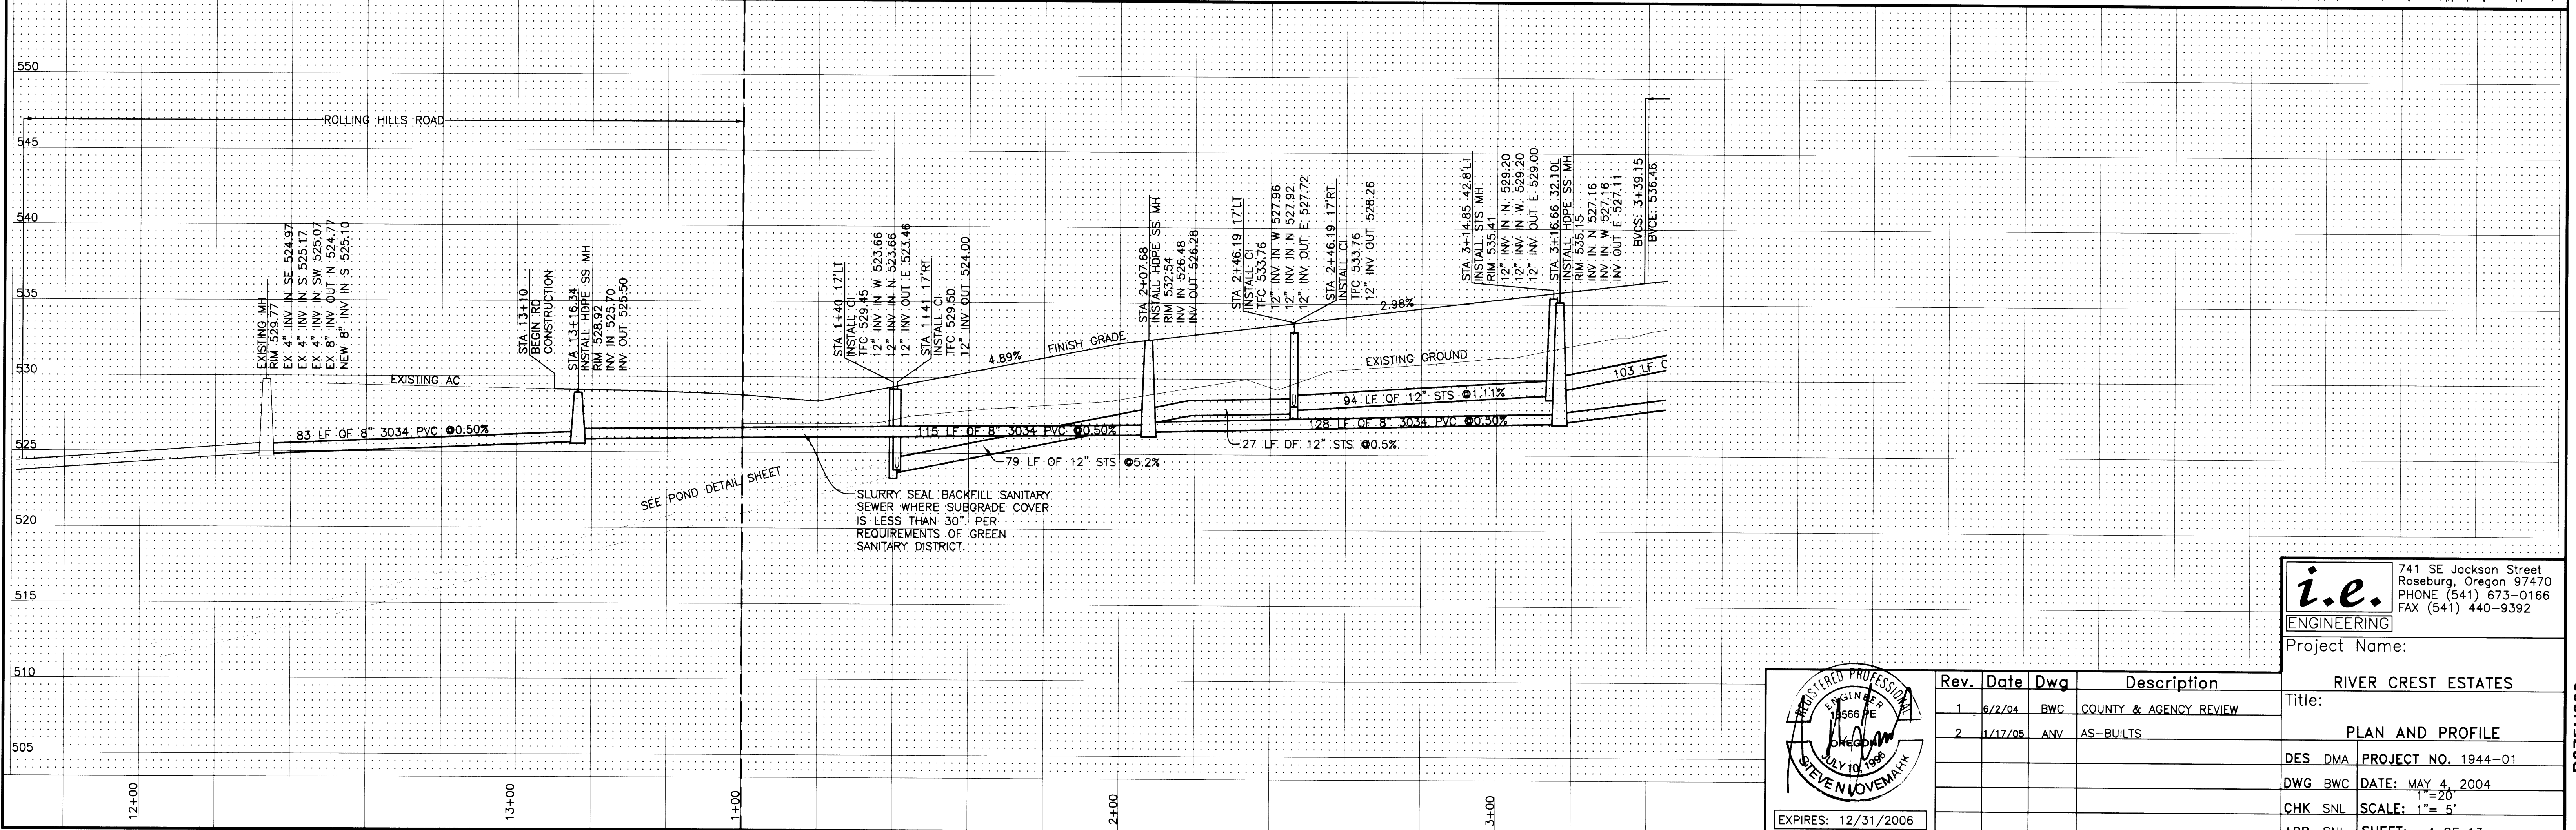

**i.e.** ENGINEERING  
 741 SE Jackson Street  
 Roseburg, Oregon 97470  
 PHONE (541) 673-0166  
 FAX (541) 440-9392

Project Name: RIVER CREST ESTATES


Title: PLAN AND PROFILE

DES DMA PROJECT NO. 1944-01

DWG BWC DATE: MAY 4, 2004

CHK SNL SCALE: 1"= 5'

APP SNL SHEET: 4 OF 13

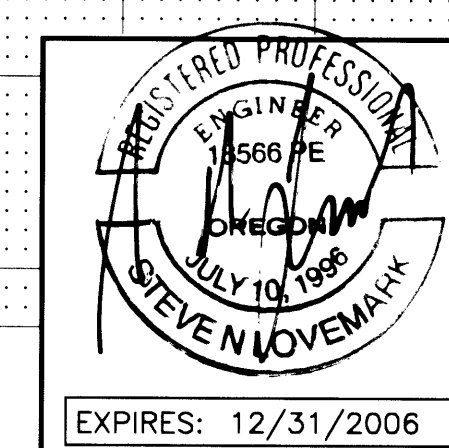

Rev.	Date	Dwg	Description
1	6/2/04	BWC	COUNTY & AGENCY REVIEW
2	1/17/05	ANV	AS-BUILTS

R375H000