


i.e.
 ENGINEERING
 741 SE Jackson Street
 Roseburg, Oregon 97470
 PHONE (541) 673-0166
 FAX (541) 440-9392

Project Name: RIVER CREST ESTATES

Rev.	Date	Dwg	Description
1	6/2/04	BWC	COUNTY & AGENCY REVIEW
2	1/17/05	ANV	AS-BUILTS

Title: PLAN AND PROFILE
 DES DMA PROJECT NO. 1944-01
 DWG BWC DATE: MAY 4, 2004
 CHK SNL SCALE: 1"=5'
 APP SNL SHEET: 5 OF 13

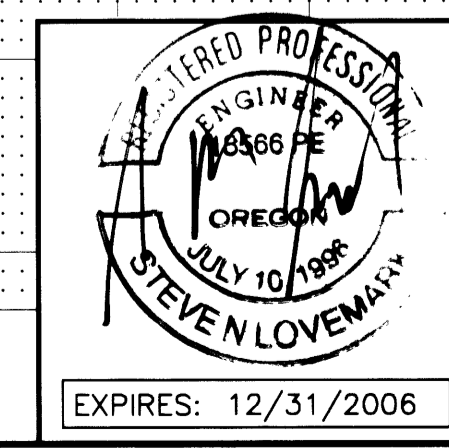

R375H001