



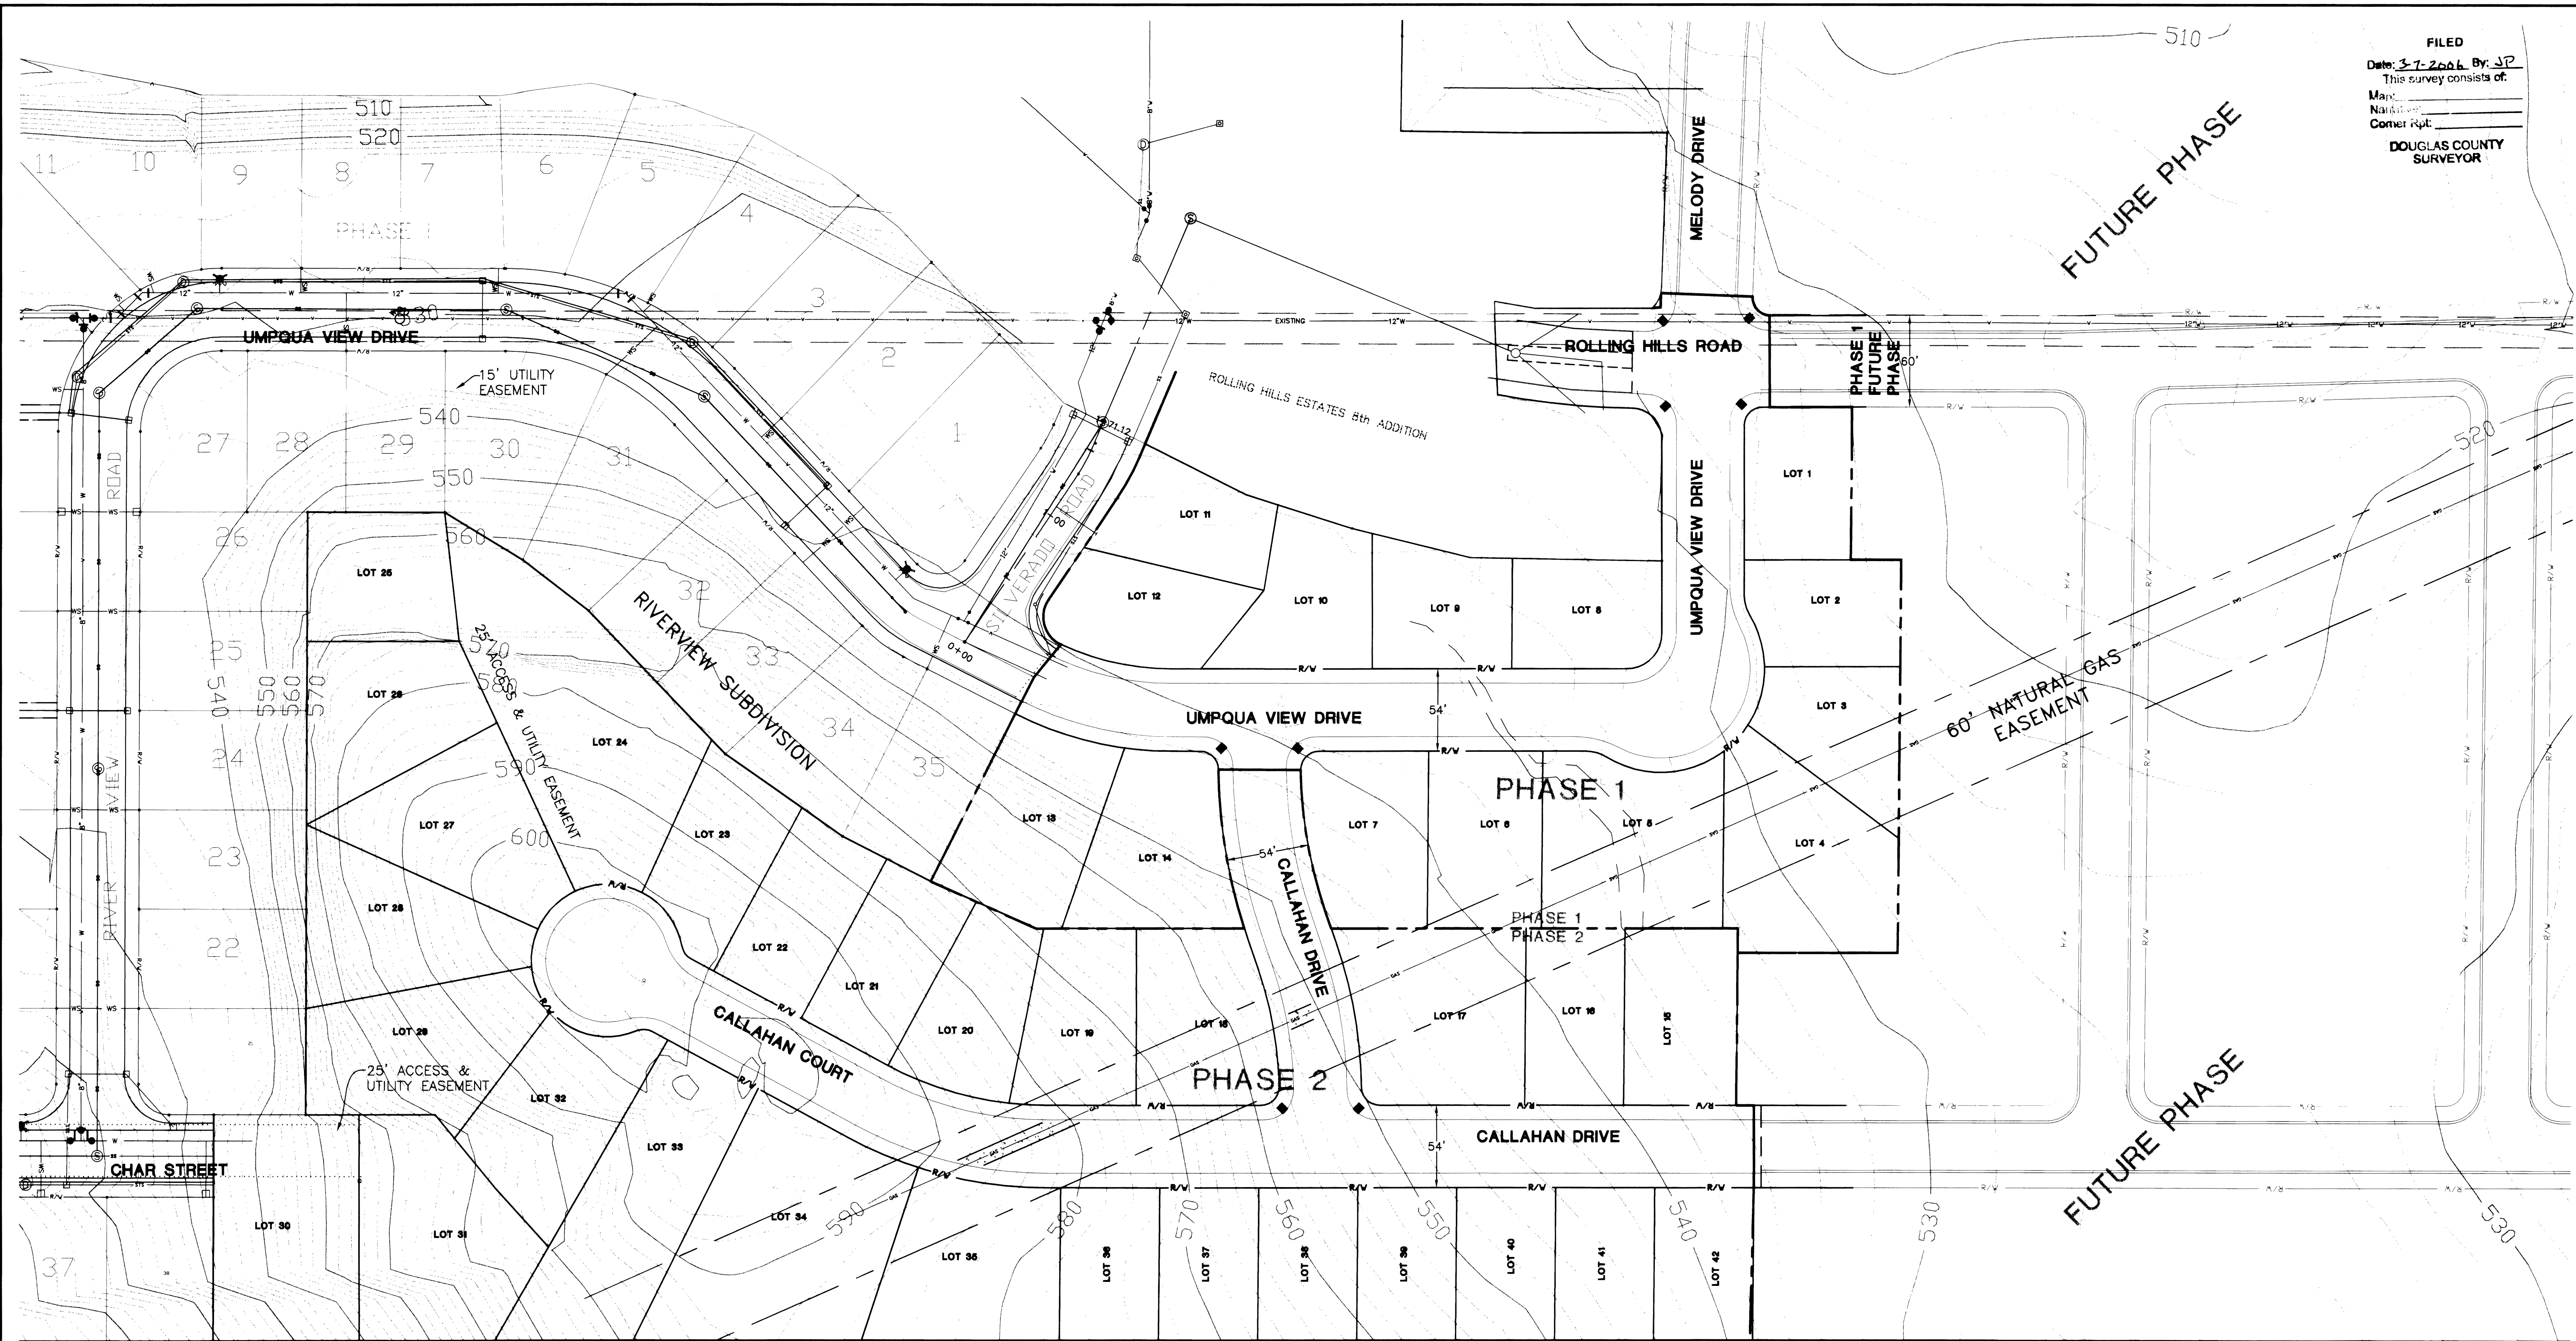

FILED
Date: 3-7-2006 By: SP
This survey consists of:
Map:
Narrative:
Cover rpt:
DOUGLAS COUNTY
SURVEYOR

NOTE:
FOR CLARITY, DRIVEWAYS ARE NOT SHOWN.
CONTRACTOR TO COORDINATE w/OWNER
FOR LOCATION & WIDTH.

CALL BEFORE YOU DIG !
ONE CALL: (800) 332-2344
JAR 952-001-0010 THROUGH
OAR 952-001-0090

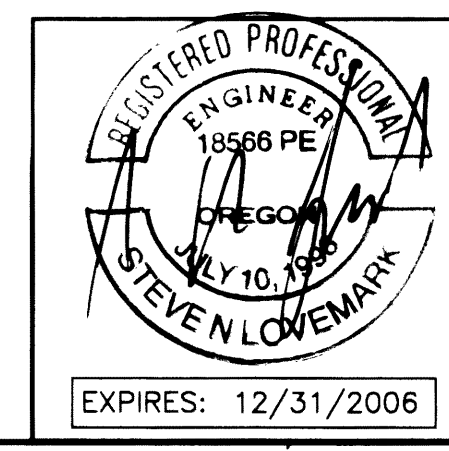

Rev.	Date	Dwg	Description
1	6/2/04	BWC	COUNTY & AGENCY REVIEW
2	1/17/05	ANV	AS-BUILTS

i.e. ENGINEERING		741 SE Jackson Street Roseburg, Oregon 97470 PHONE (541) 673-0166 FAX (541) 440-9392 email@ieengineering.com
Project Name:		
RIVER CREST ESTATES		
Title:		
EXISTING TOPOGRAPHY		
DES DMA	PROJECT NO.	1944-01
DWG BWC	DATE:	MAY 4, 2004
CHK SNL	SCALE:	AS SHOWN
APP SNL	SHEET:	2 OF 13

Co. Rd. # 375 H, 375 J, 375 K M.P. 0.00-0.24, 0.00-0.11, 0.00-0.10 DO NOT DUPLICATE 0.10

R37510PO