

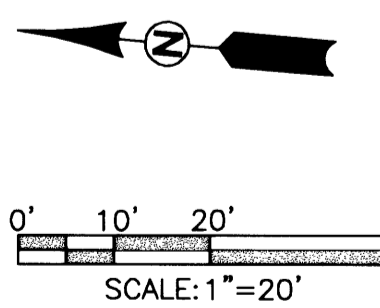


FILED  
 Date: 1-17-2007 By: JP  
 This survey consists of:  
 Map:  
 Narrative:  
 Corner Rpt:  
 DOUGLAS COUNTY  
 SURVEYOR

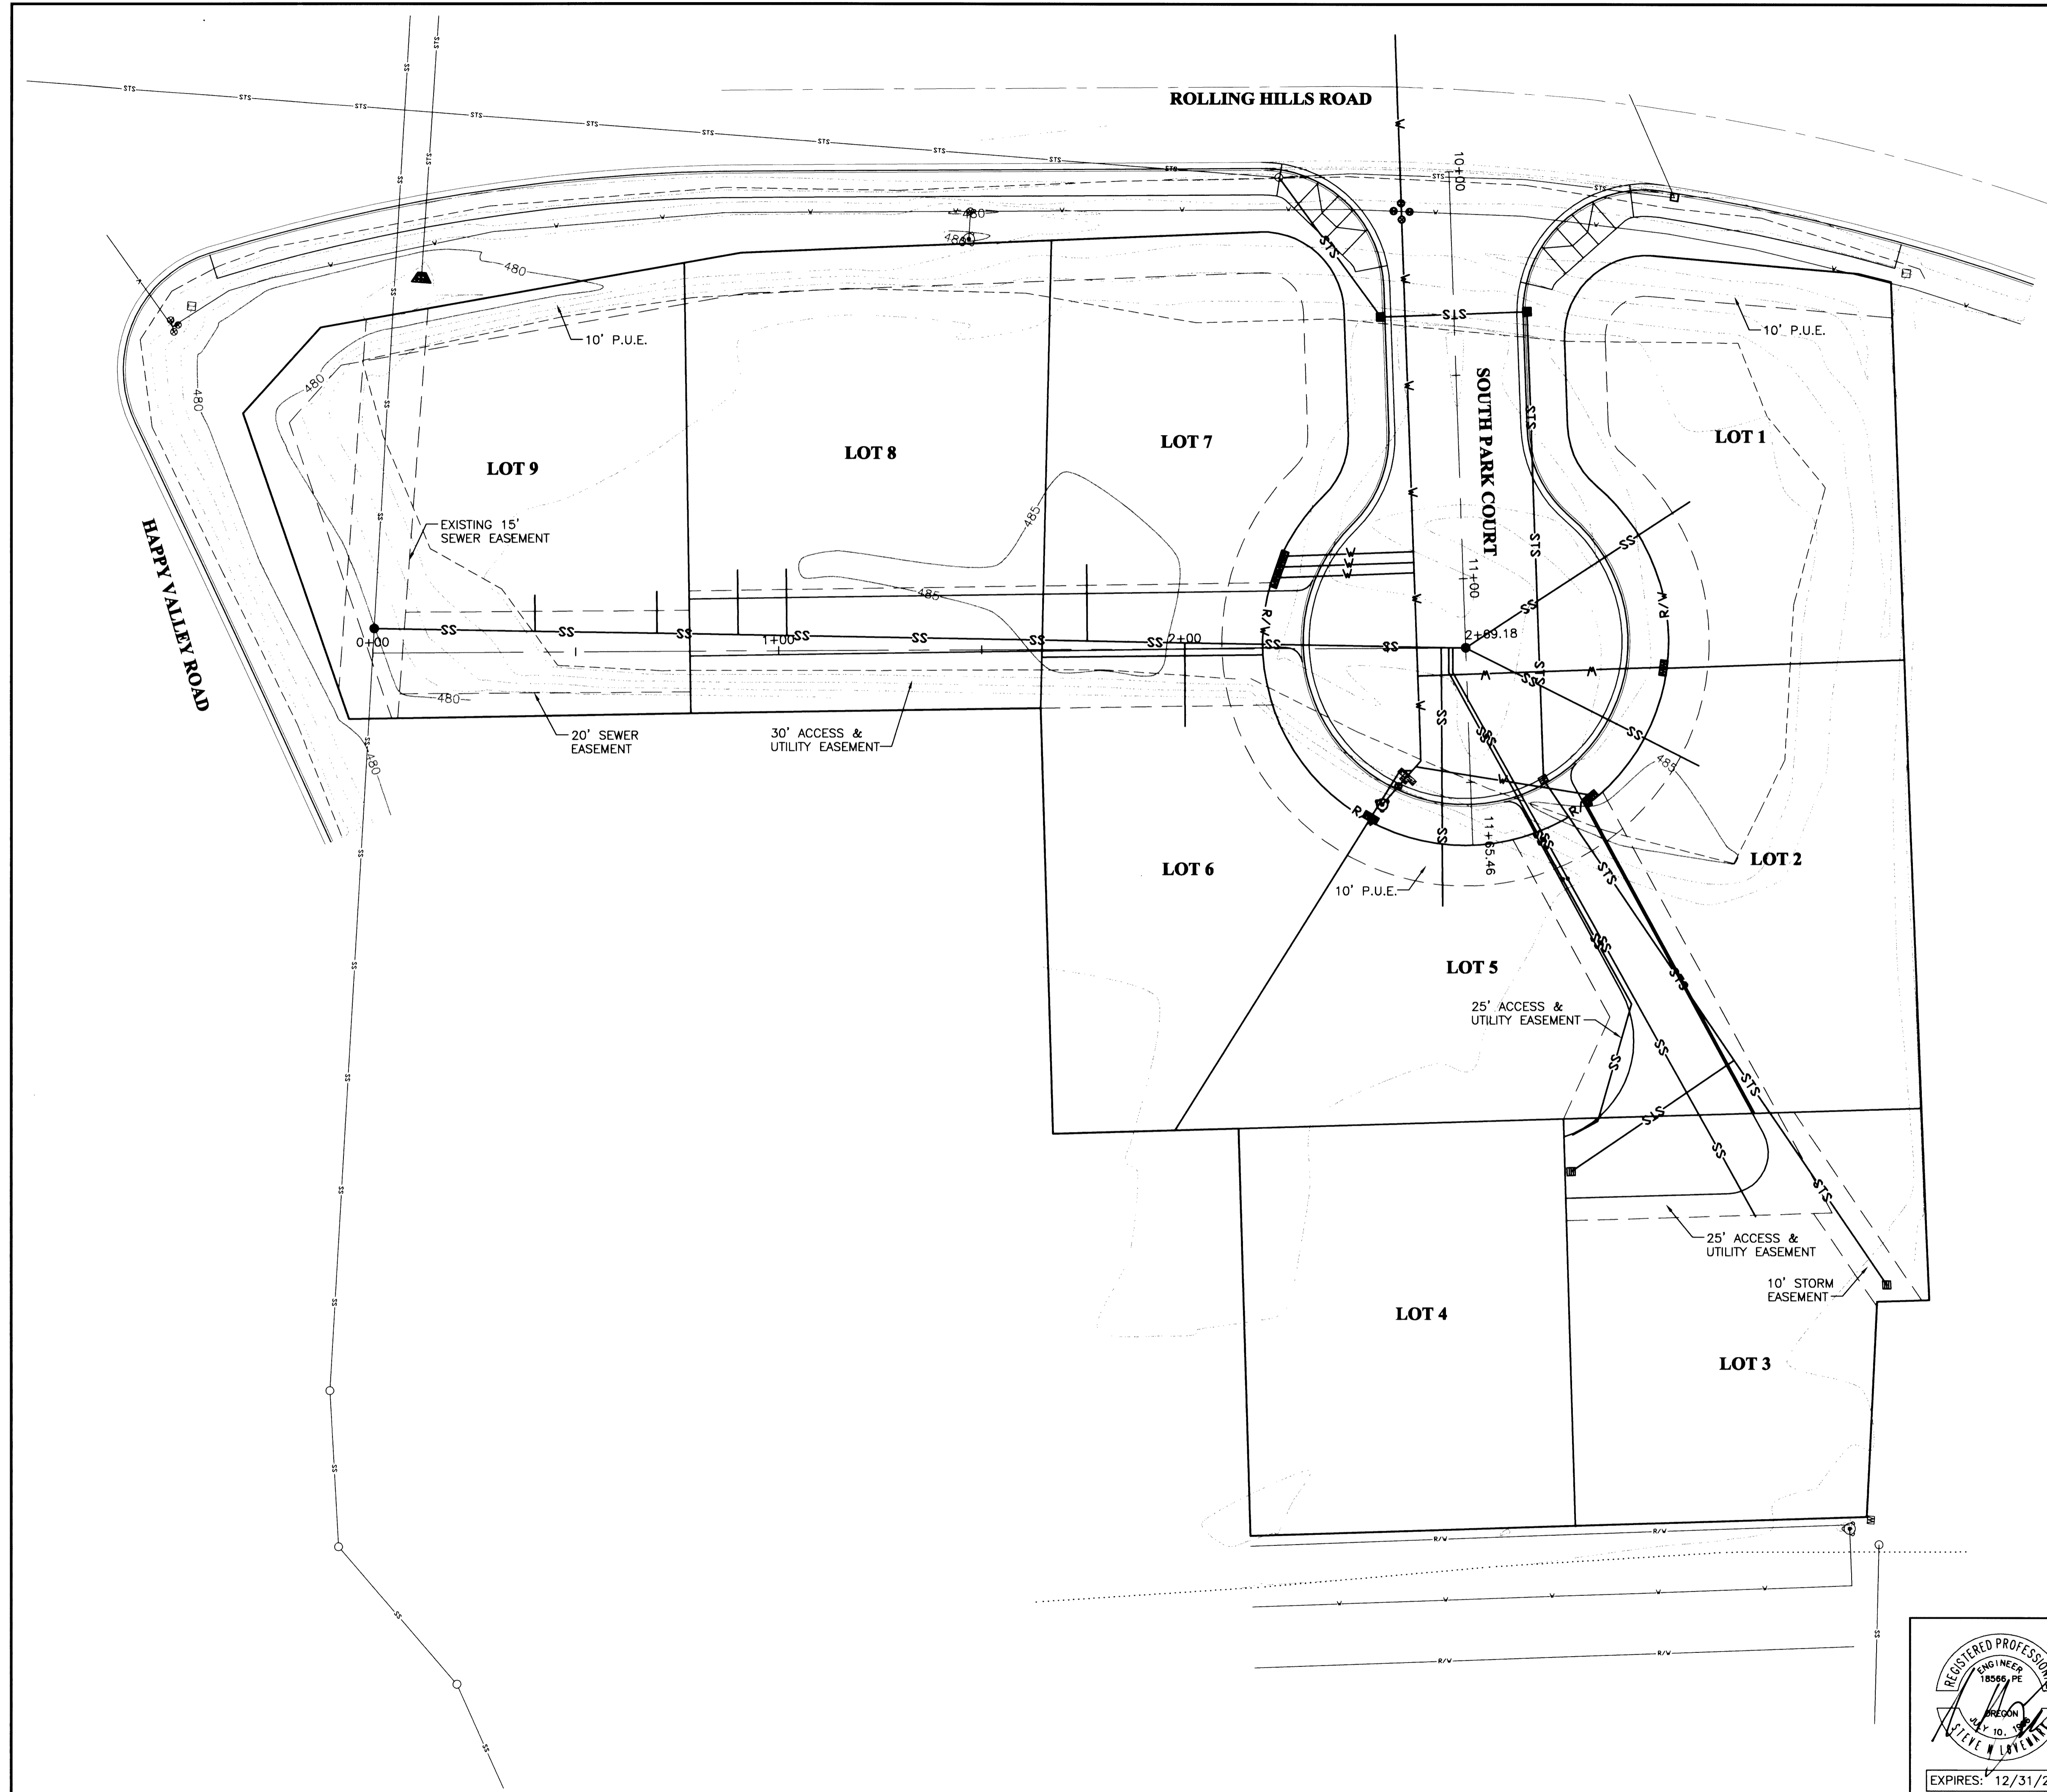

CALL BEFORE YOU DIG !  
 ONE CALL (800) 332-2344  
 OAR 952-001-0010 THROUGH  
 OAR 952-001-0090

**i.e.** ENGINEERING  
 741 SE Jackson Street  
 Roseburg, Oregon 97470  
 PHONE (541) 673-0166  
 FAX (541) 440-9392  
 jemail@ieengineering.com  
 Project Name:

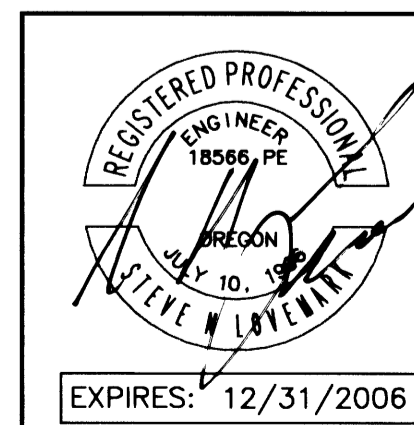

Rev.	Date	Dwg	Description
1	6/23/06	JDL	AS-BUILT

**SOUTH PARK SUBDIVISION**  
 Title:  
**OVERALL LAYOUT AND EXISTING TOPOGRAPHY**  
 DES JPM PROJECT NO. 106-04  
 DWG ANV DATE: MARCH 21, 2005  
 CHK SNL SCALE: AS SHOWN  
 APP SNL SHEET: 2 OF 8

Co. Rd. # 375L M.P. 0.00 - 0.02 DO NOT DUPLICATE

**CO. RD. #375L LAYOUT AND TOPOGRAPHY.**

00000002