

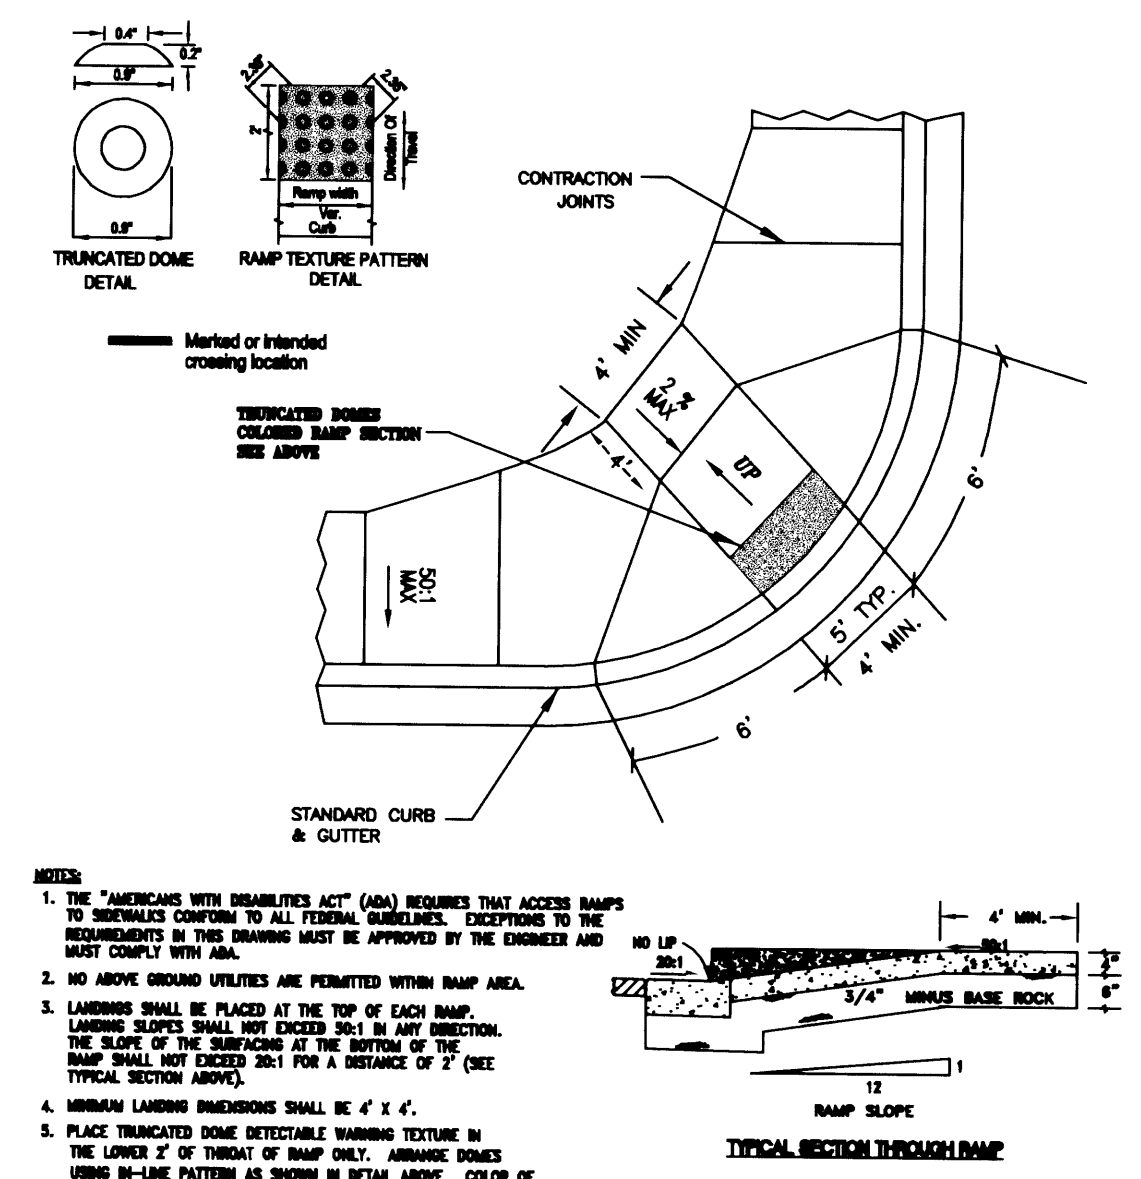
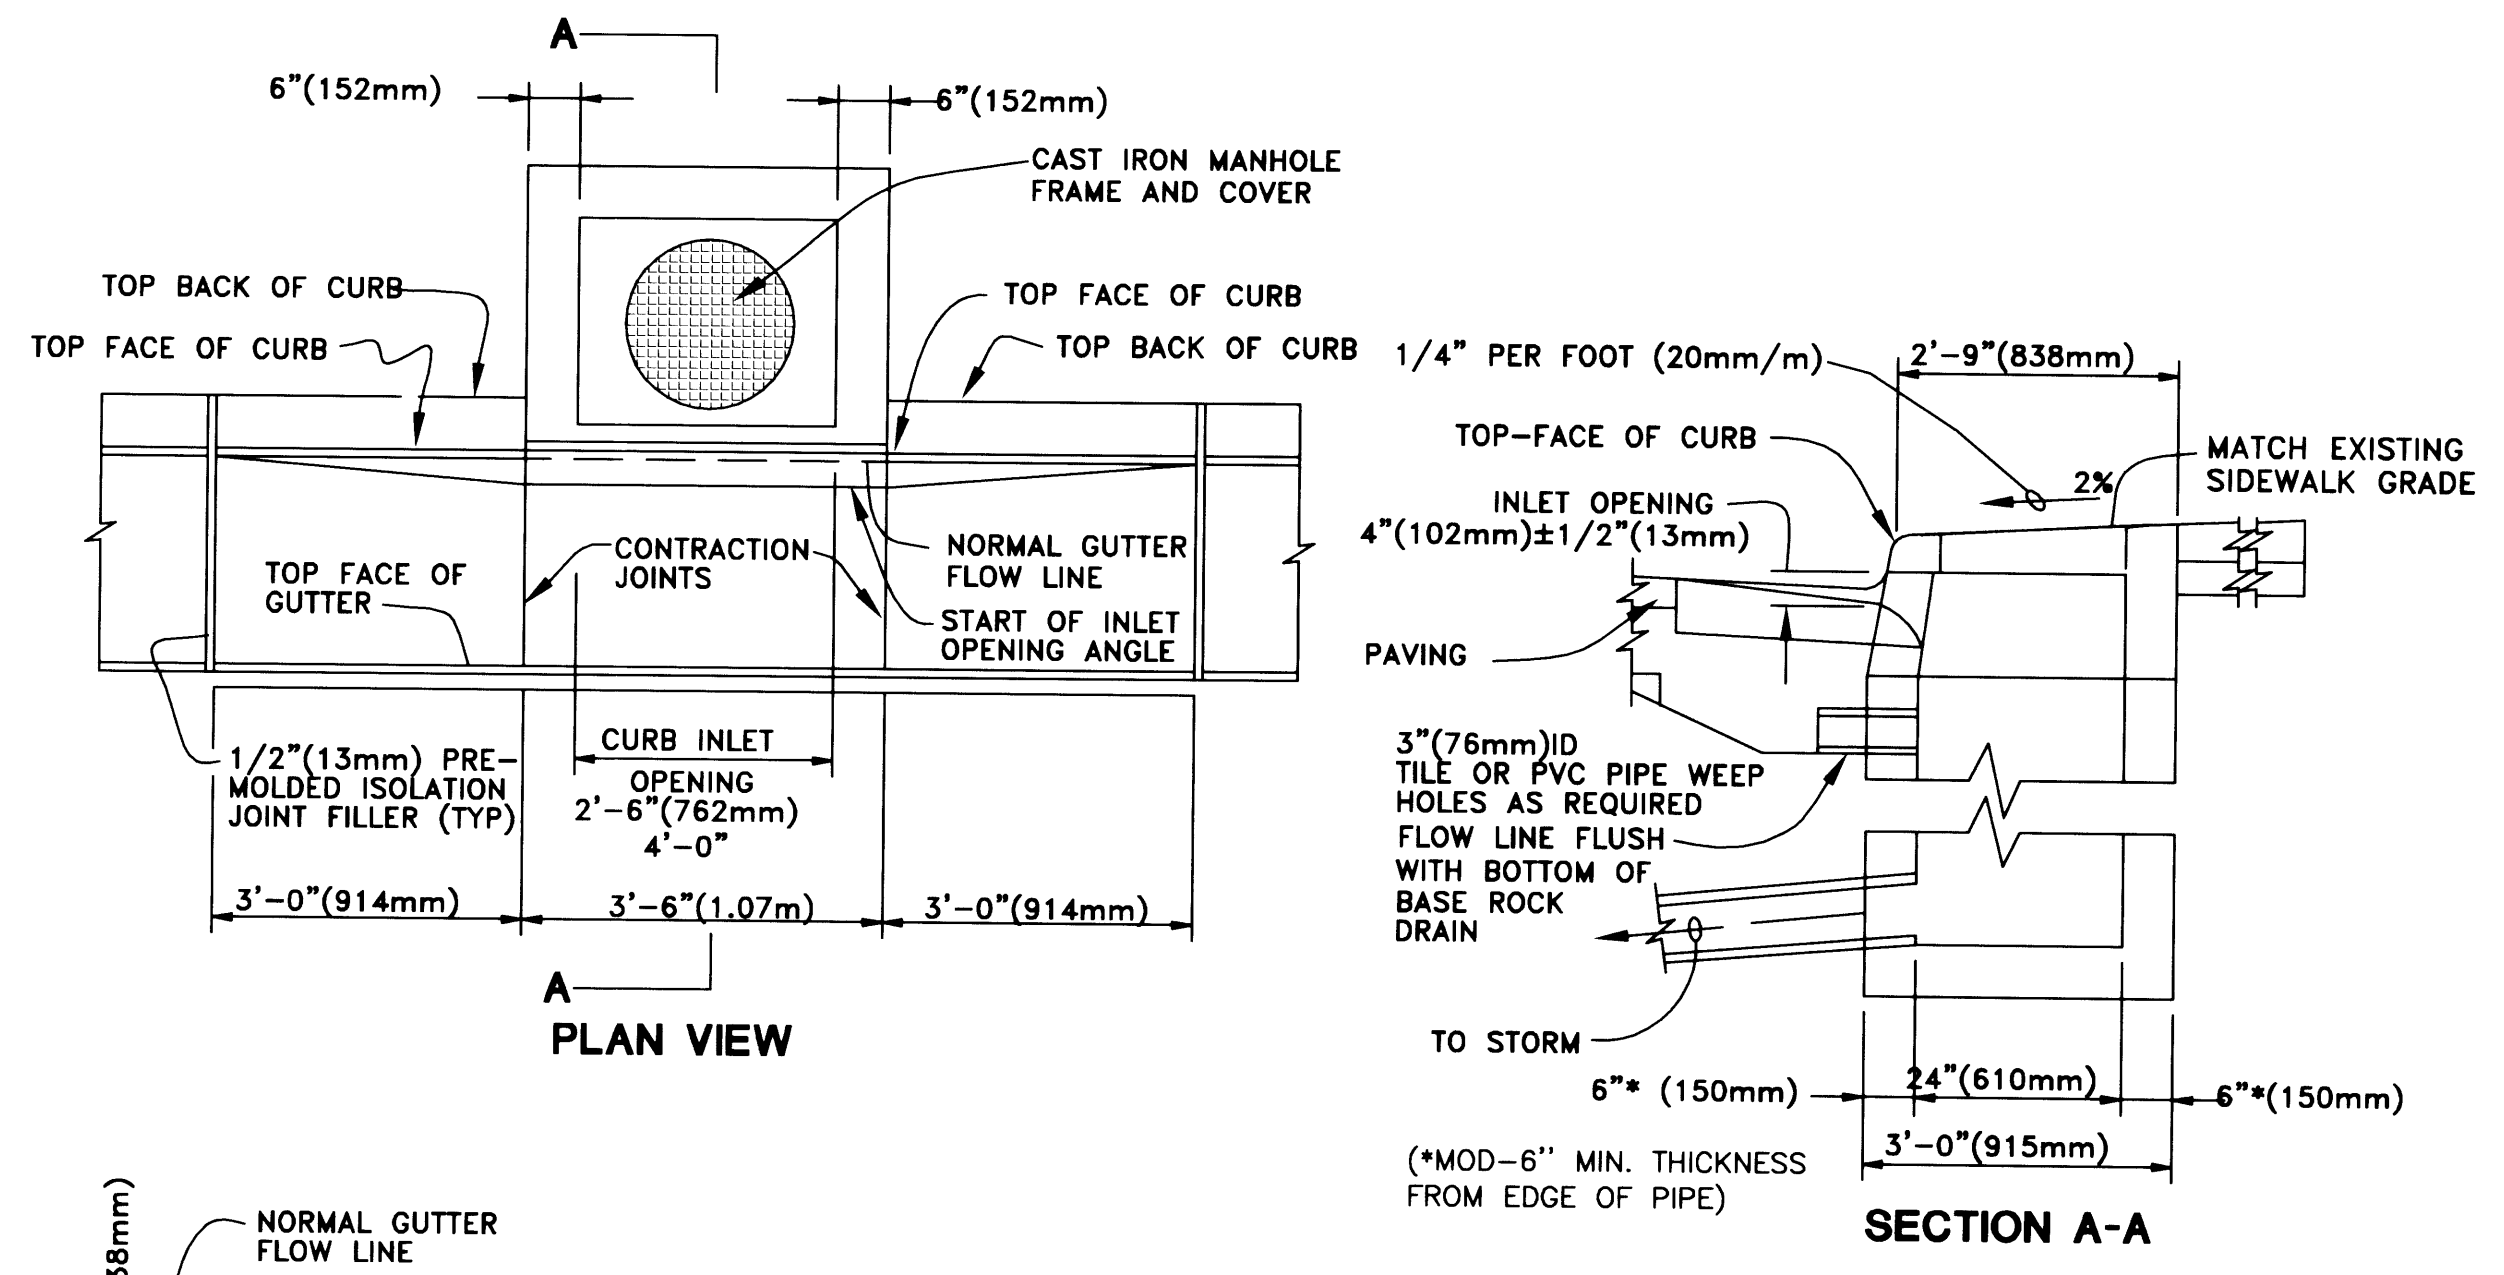
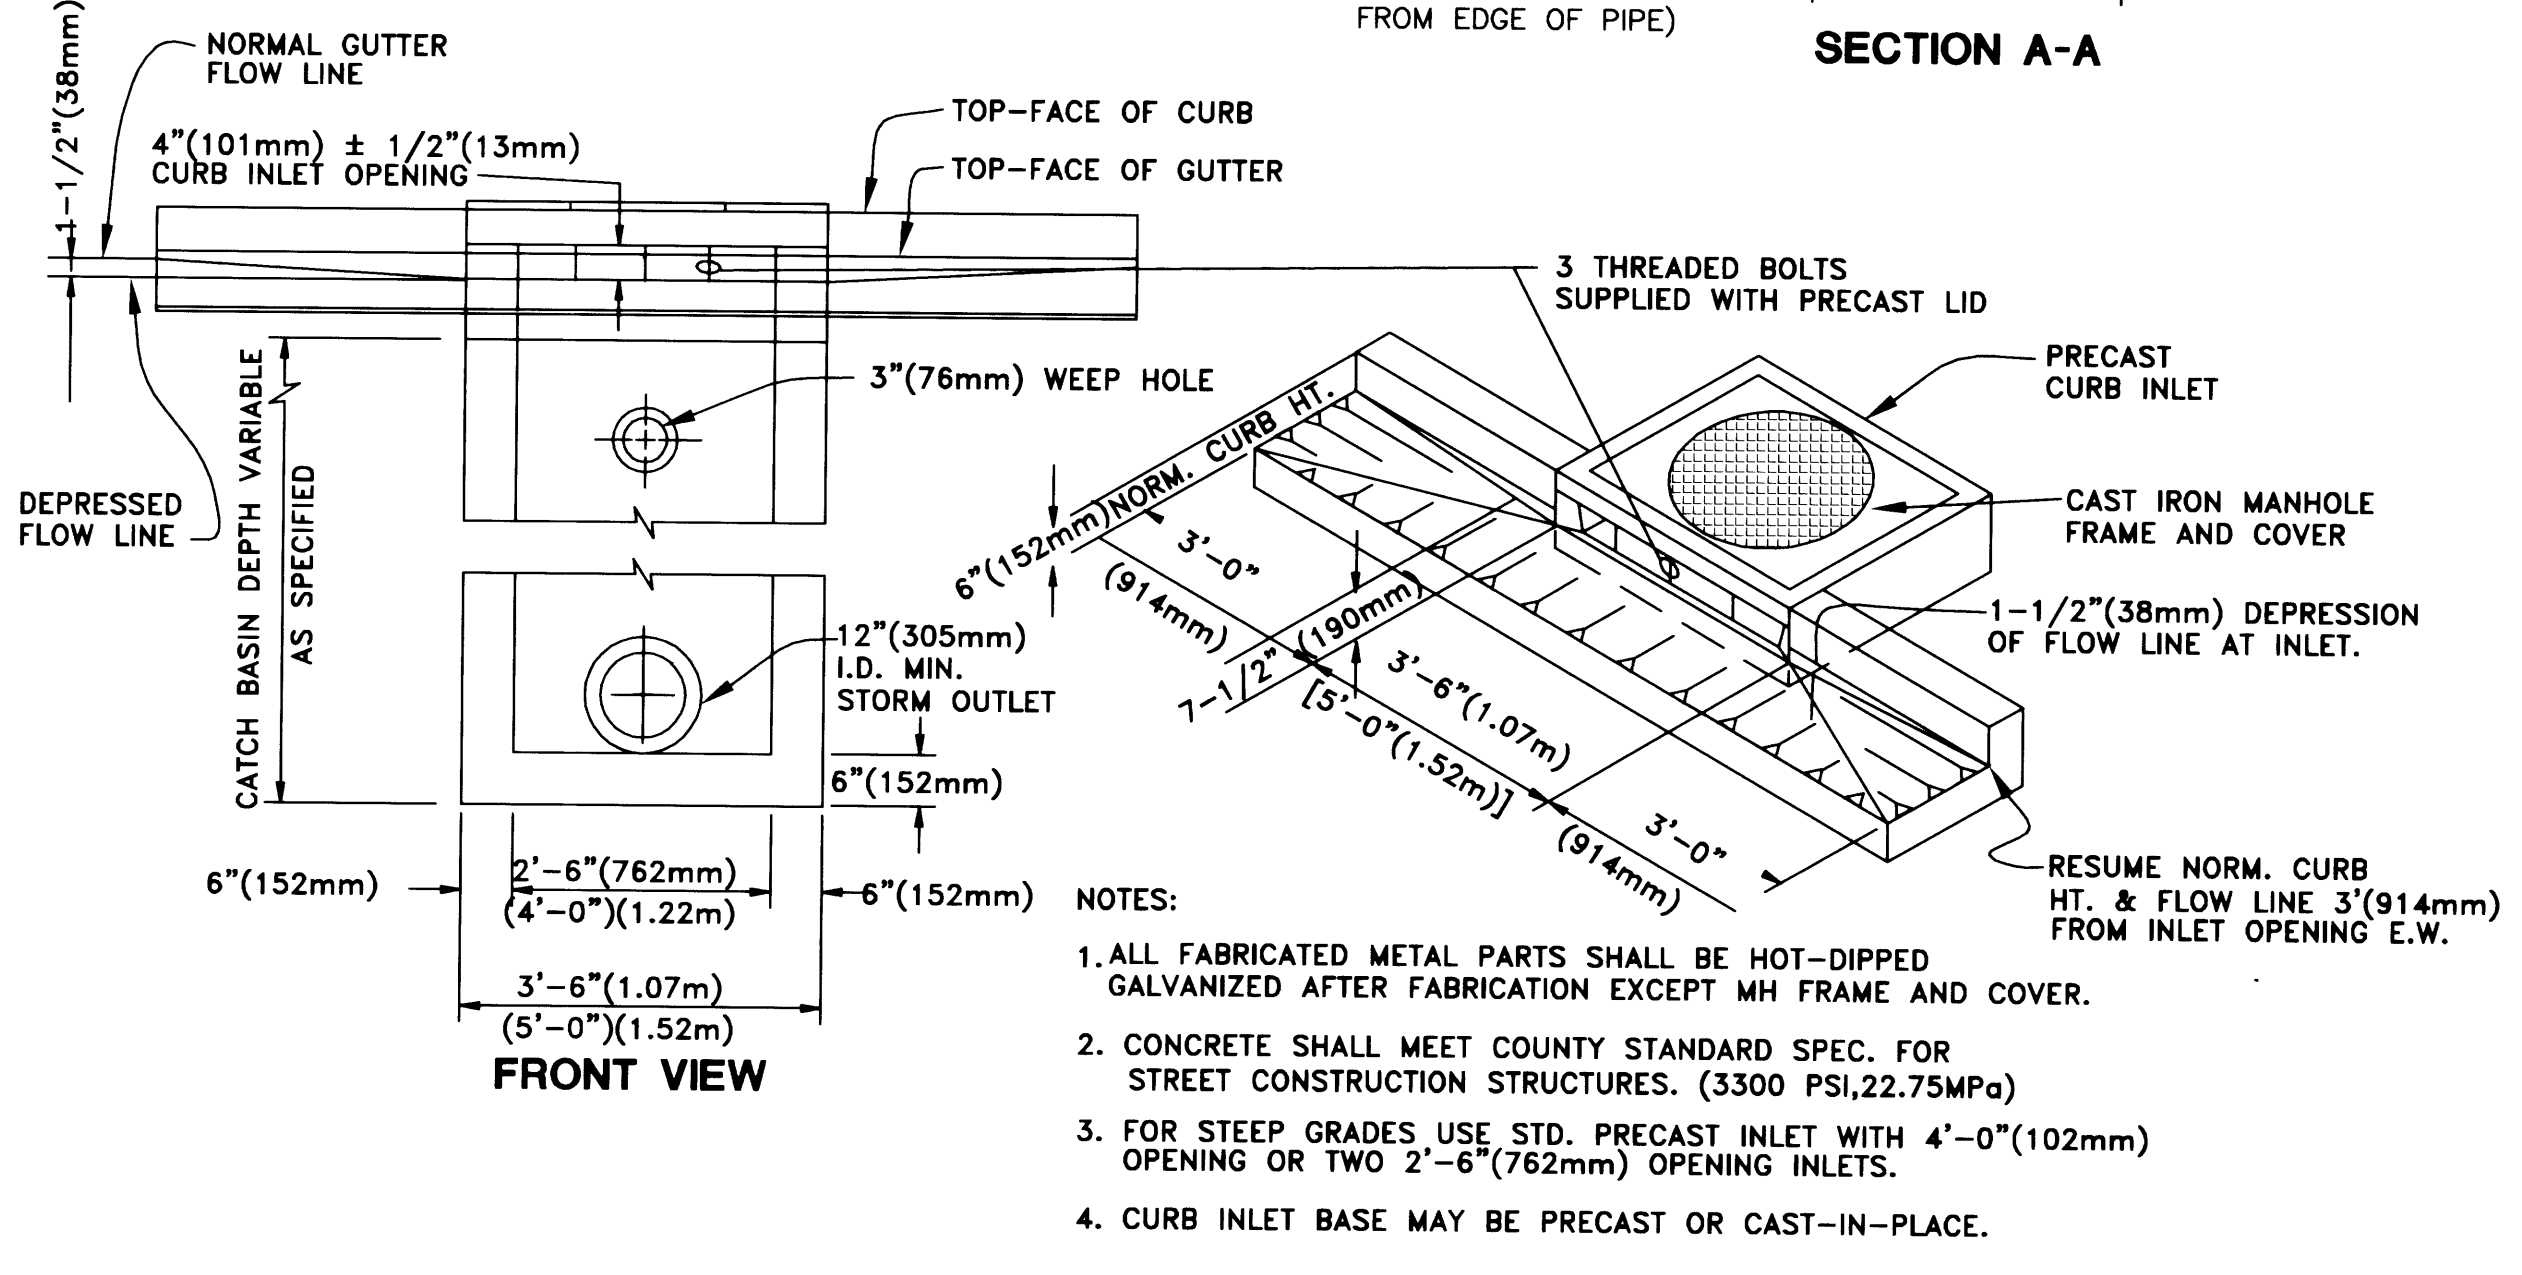



FILED
 Date: 1-17-2007 By: J.P.
 This survey consists of:
 Map:
 Narrative:
 Corner Rpt:
 DOUGLAS COUNTY
 SURVEYOR

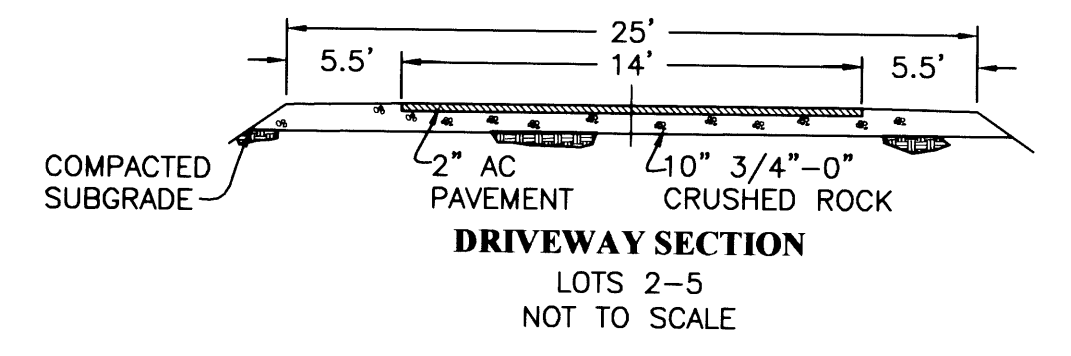


ADA RAMP

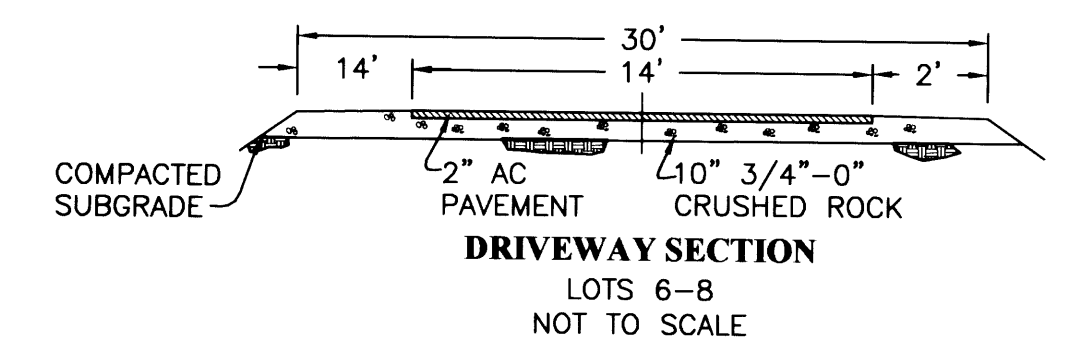


TYPICAL CG-3 INLET DETAIL

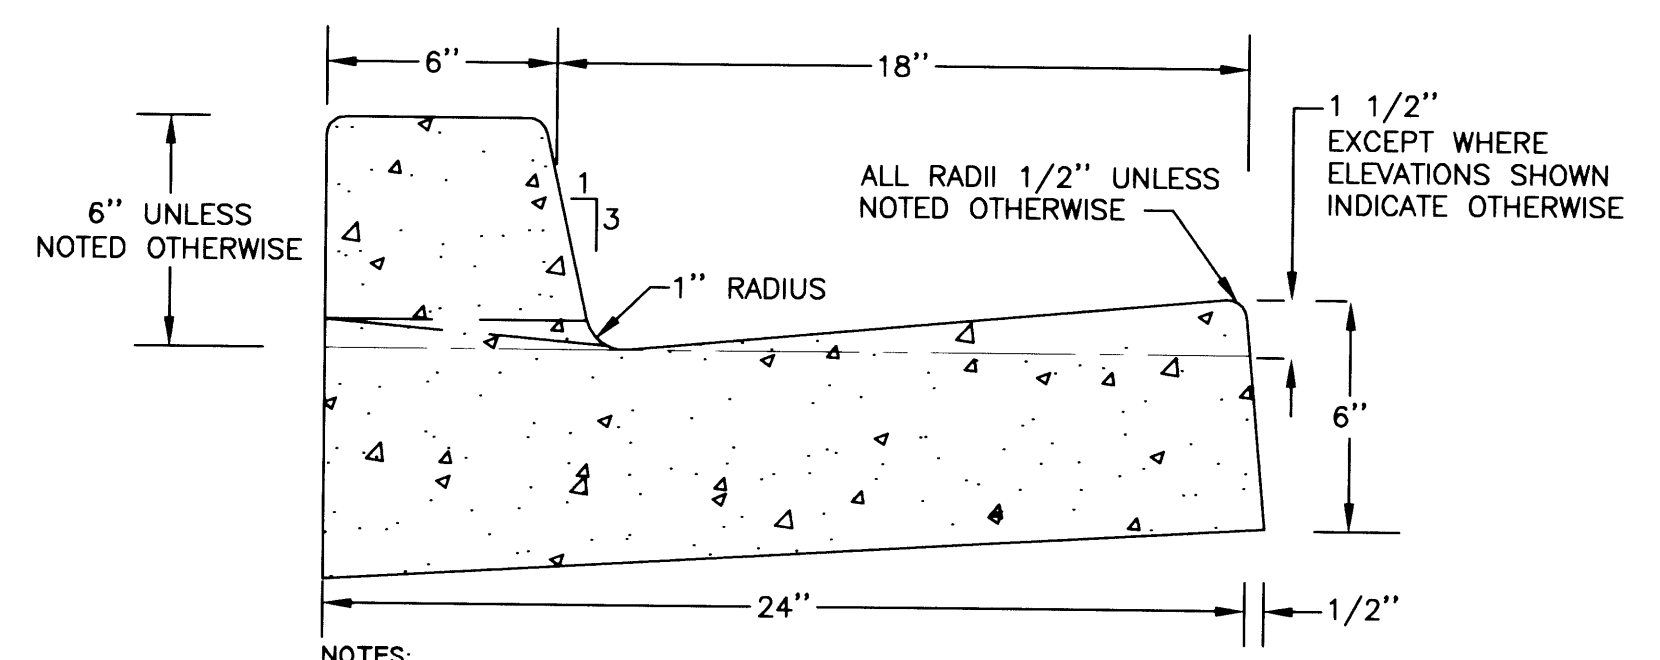


TYPICAL CURB AND GUTTER

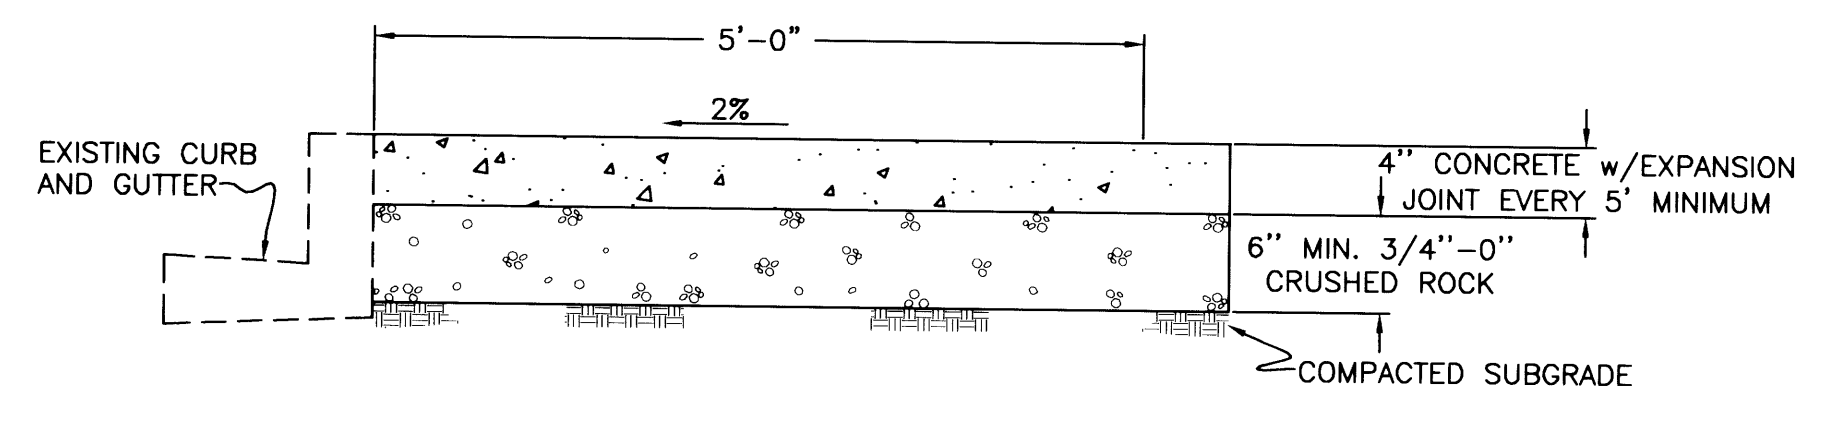


SIDEWALK STRUCTURAL SECTION

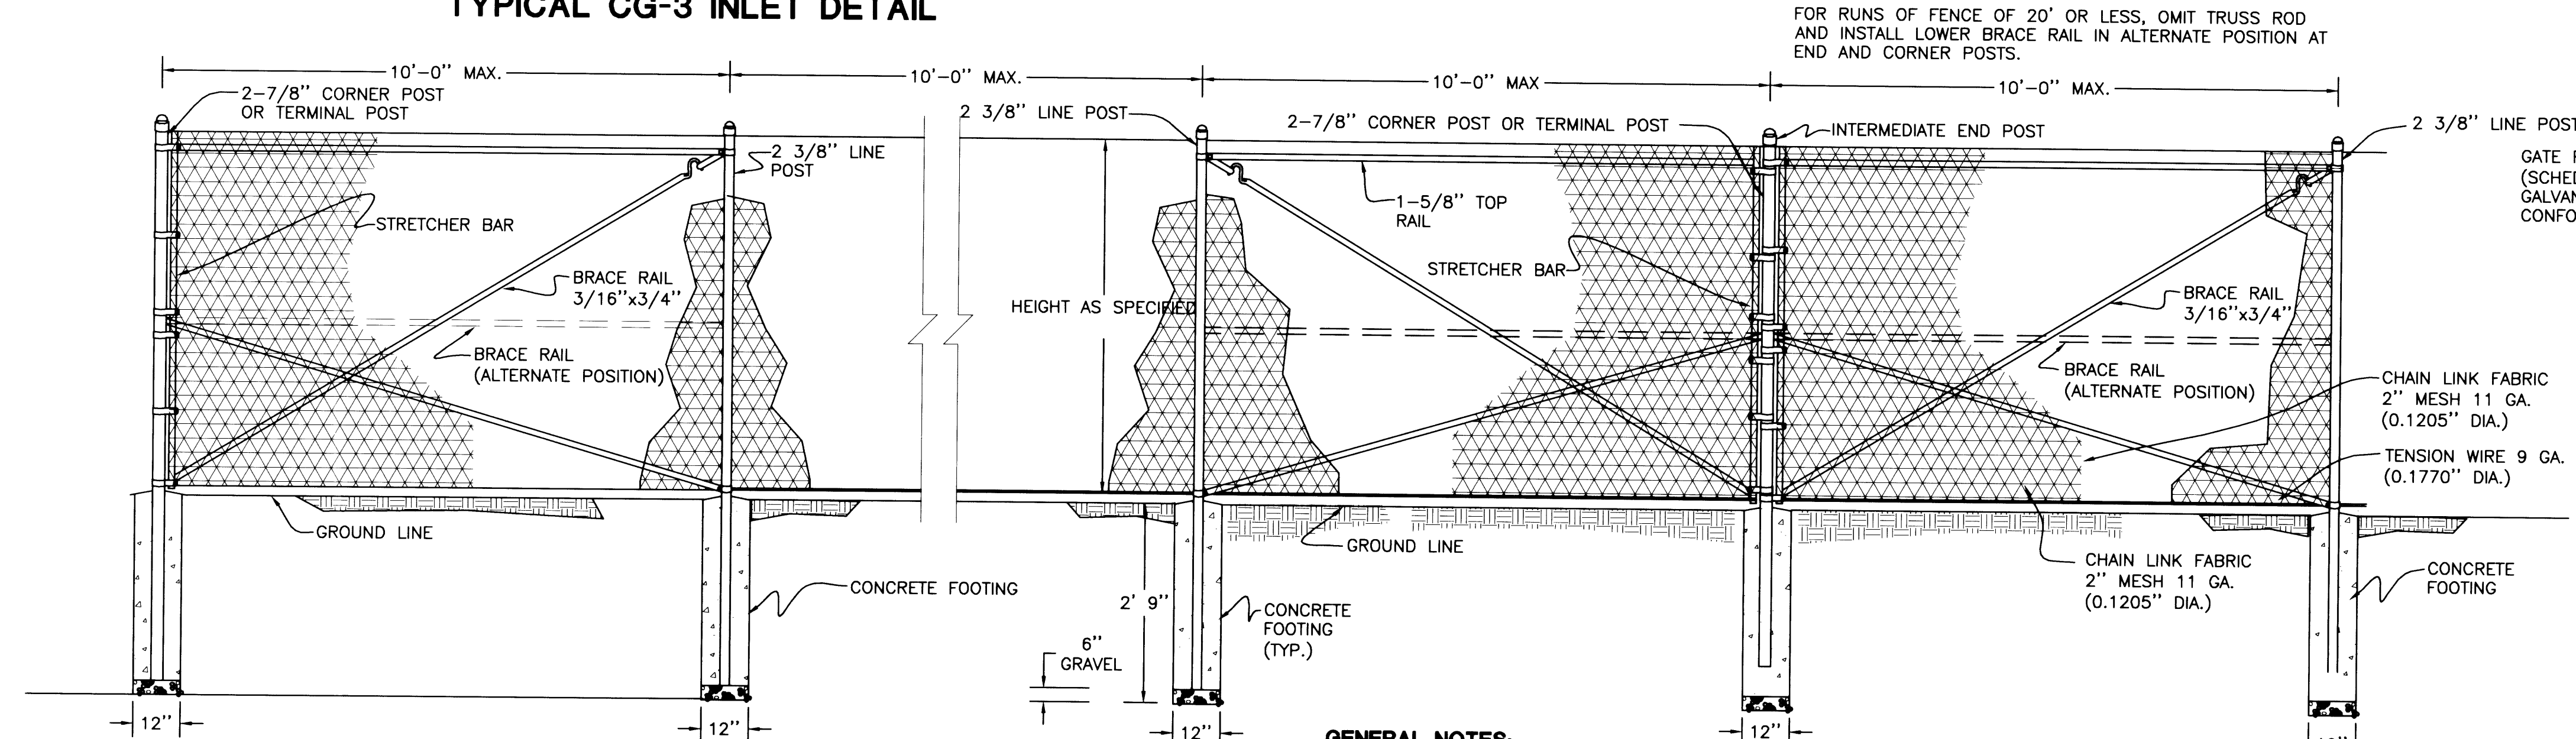

CHAIN LINK FENCE TYPE CL-4R, CL-5R, AND CL-6R

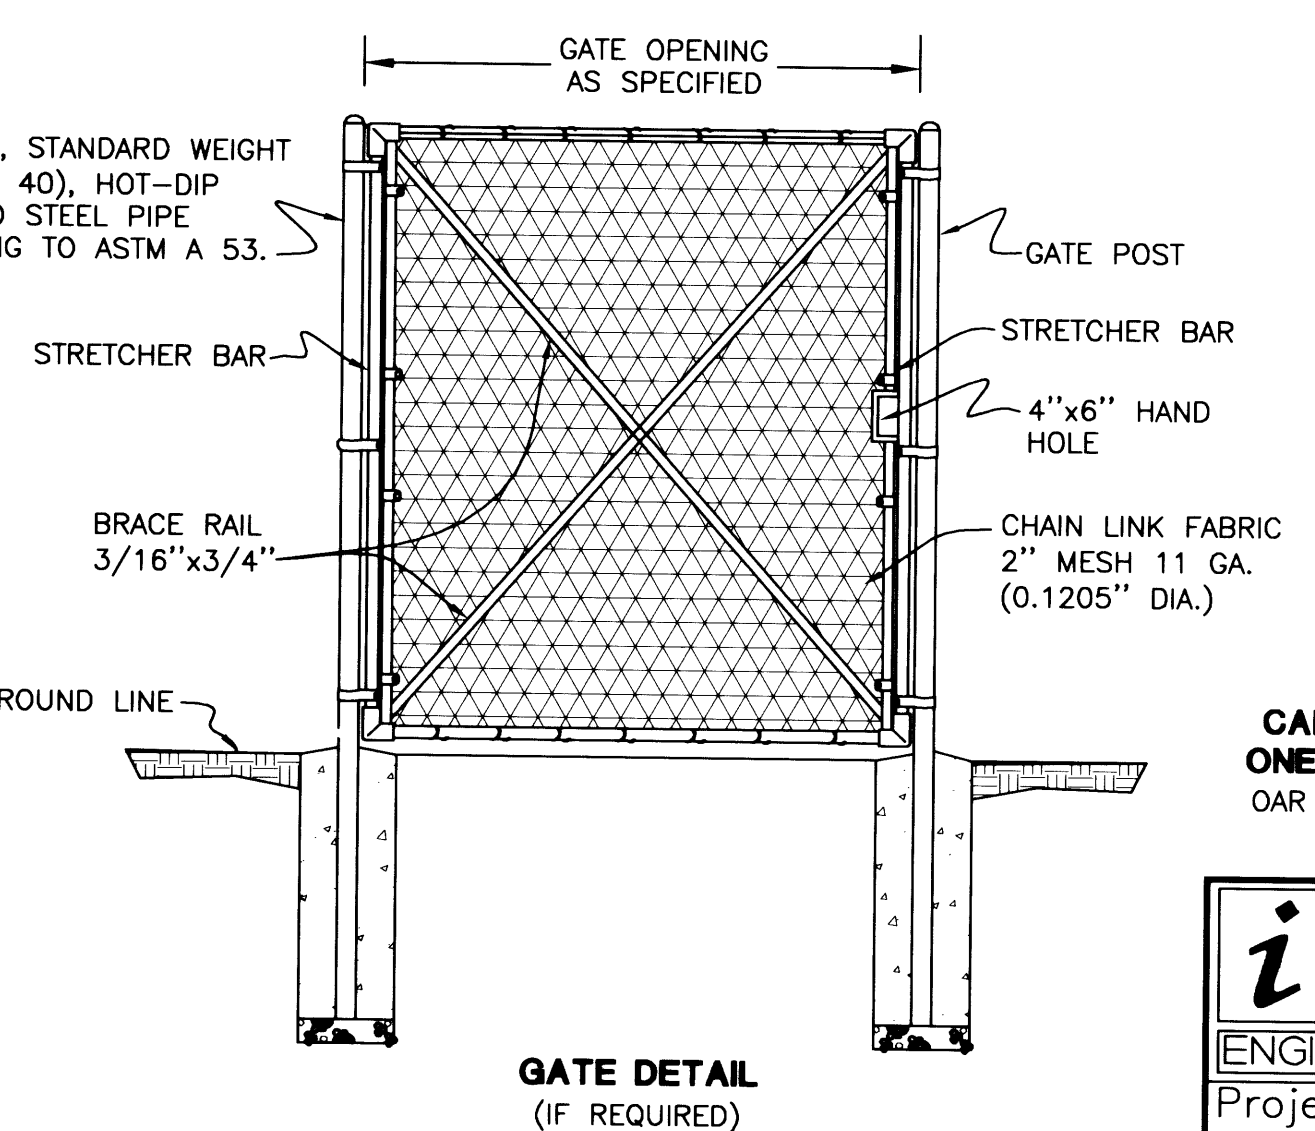

GATE DETAIL (F REQUIRED)

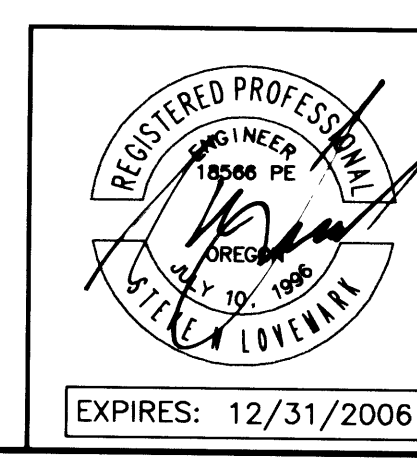

Rev.	Date	Dwg	Description
1	6/23/06	JDL	AS-BUILT

CALL BEFORE YOU DIG 1
ONE CALL: (800) 332-2344
 OAR 952-001-0010 THROUGH
 OAR 952-001-0090

i.e. ENGINEERING
 741 SE Jackson Street
 Roseburg, Oregon 97470
 PHONE (541) 673-0166
 FAX (541) 440-9392
 iemail@ieengineering.com

Project Name: **SOUTH PARK SUBDIVISION**
 Title: **DETAILS**
 DES JPM PROJECT NO. 106-04
 DWG ANV DATE: MARCH 21, 2005
 CHK SNL SCALE: NONE
 APP SNL SHEET: 6 OF 8