



FILED  
 Date: 1-17-2007 By: JLP  
 This survey consists of:  
 Map:  
 Narrative:  
 Corner Rpt:  
 DOUGLAS COUNTY  
 SURVEYOR

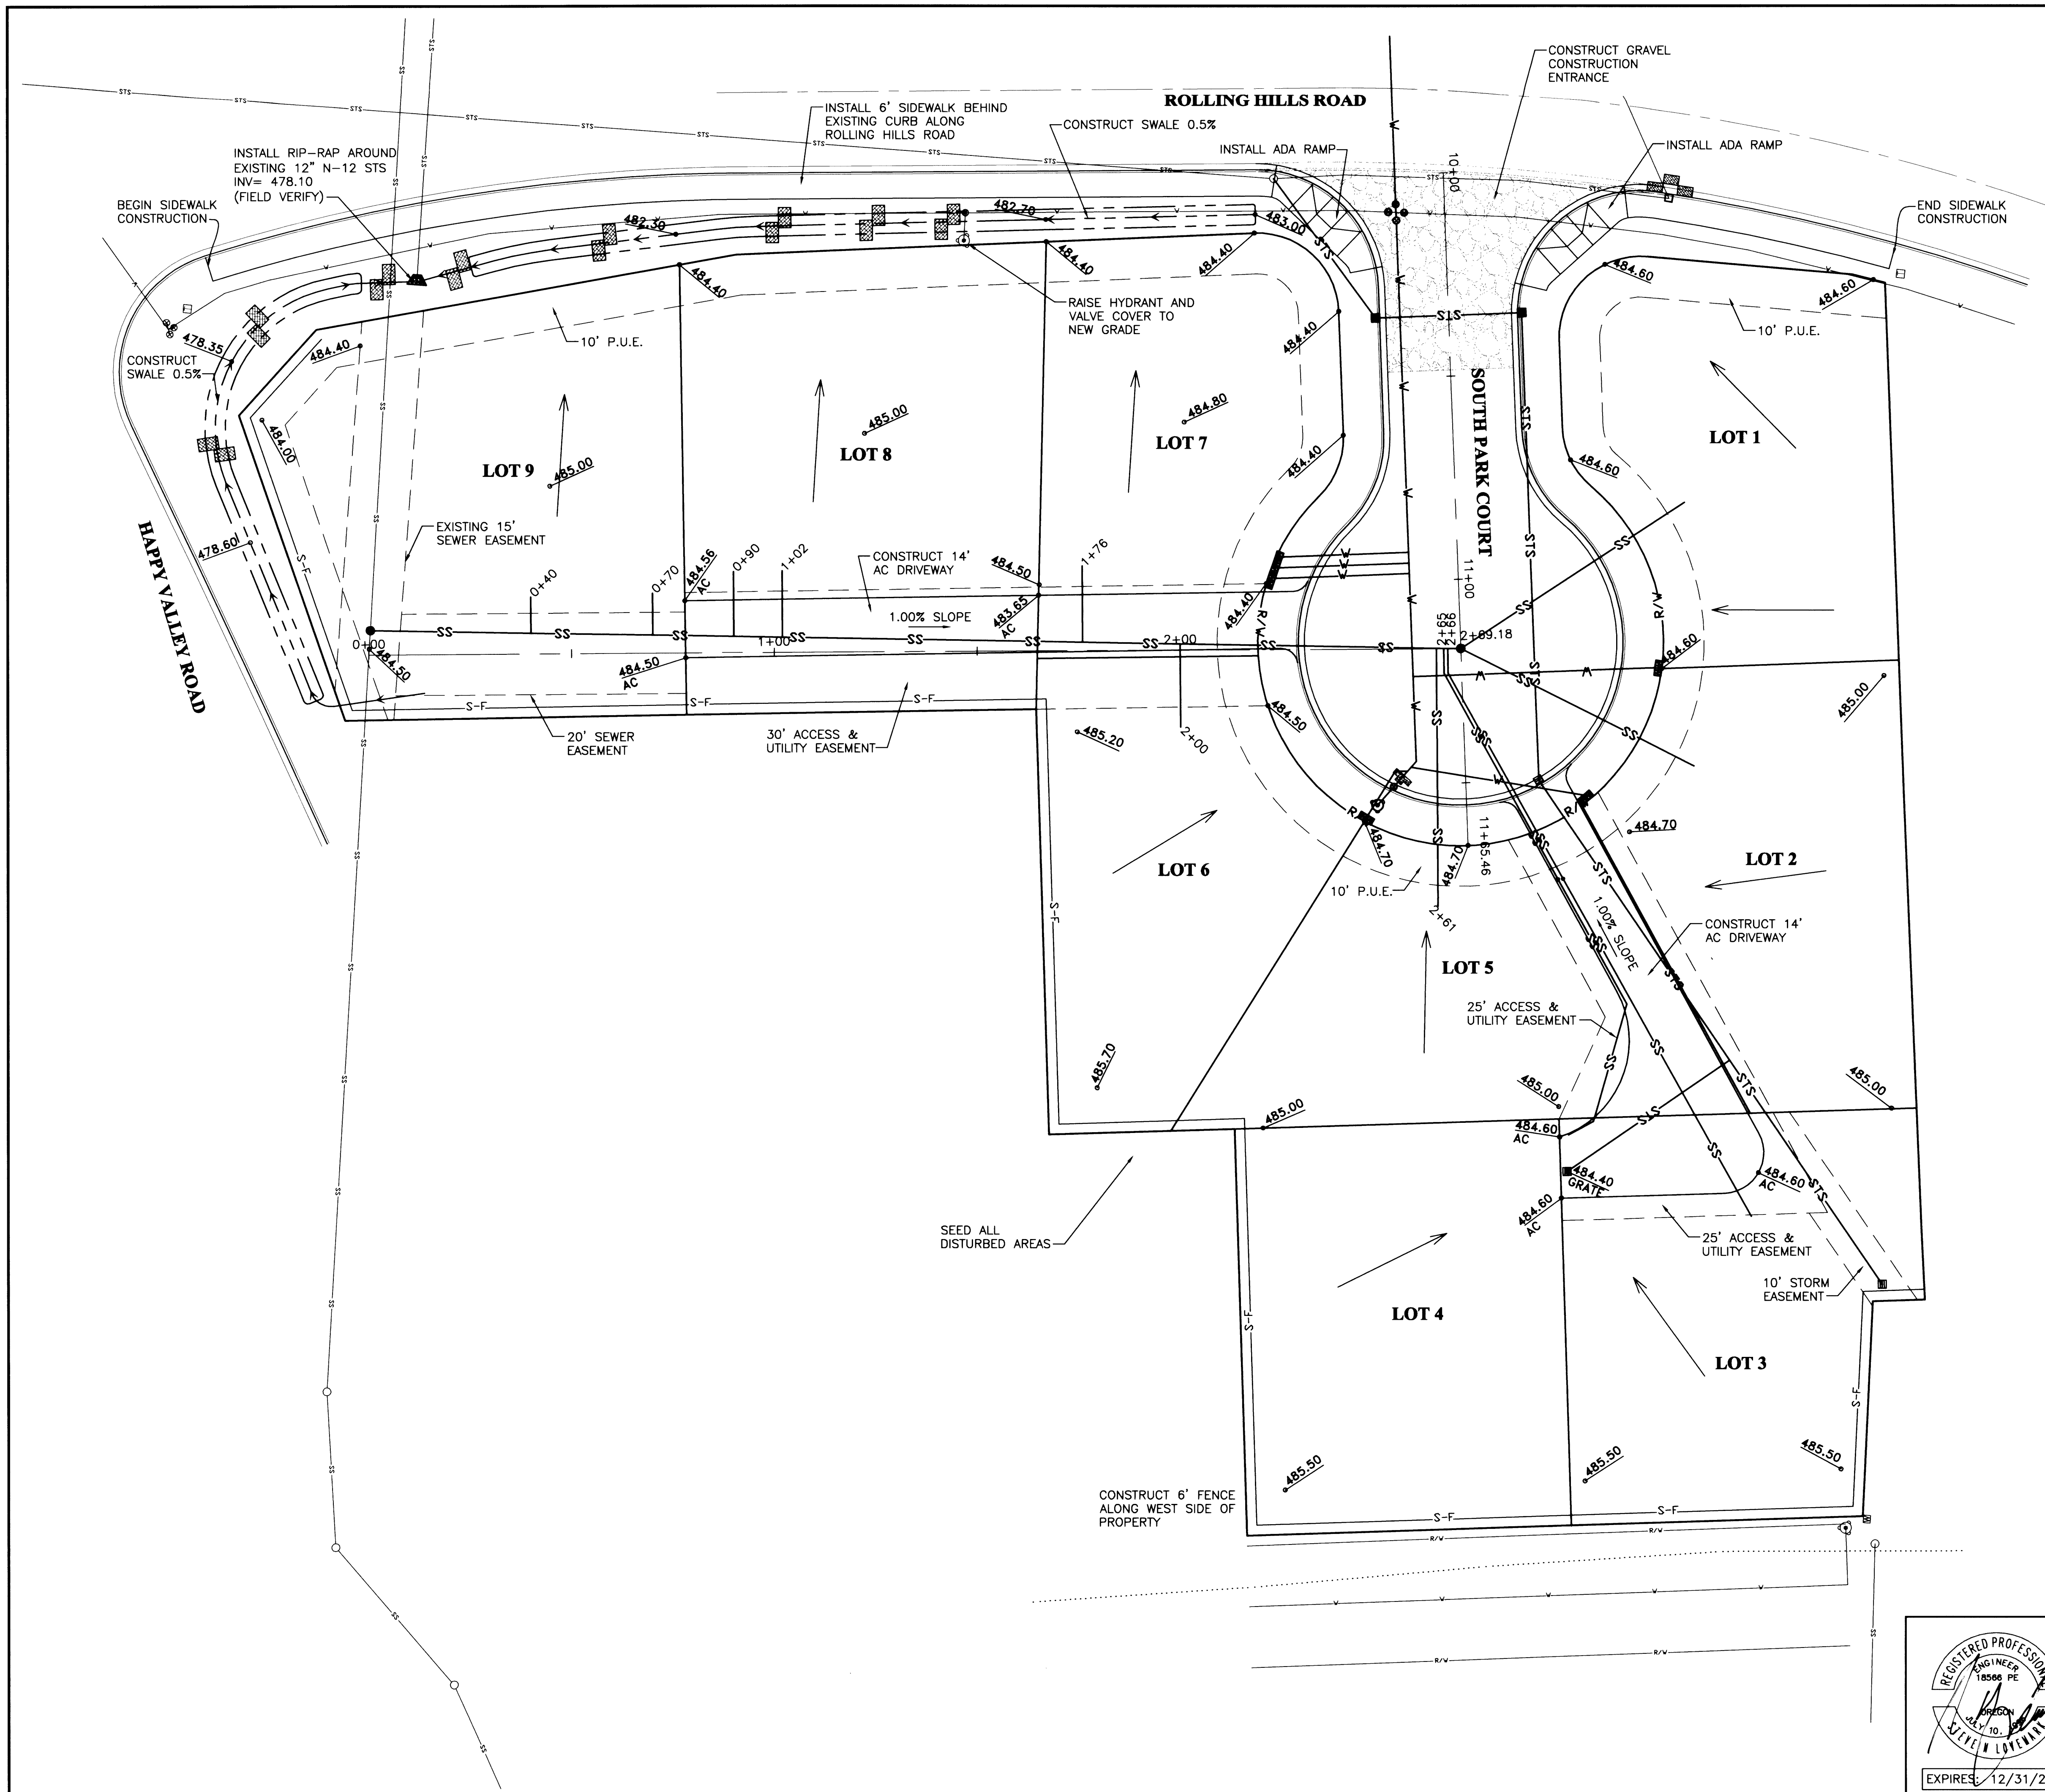


EROSION SHEET LEGEND:  
 ORIGINAL ELEV. - - - - -  
 DESIGN ELEV. - - - - -  
 SILT FENCE - S-F - - - - -  
 SEDIMENT BARRIER [Symbol]  
 INLET PROTECTION [Symbol]  
 DIRECTION OF DRAINAGE ←

NOTE:  
 PROJECT IS LOCATED WITHIN THE  
 100-YEAR FLOOD BOUNDARY

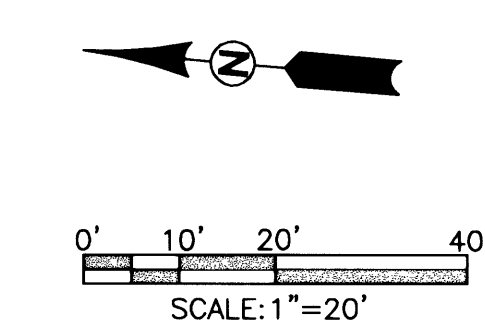

CALL BEFORE YOU DIG I  
 ONE CALL: (800) 332-2344  
 OAR 952-001-0010 THROUGH  
 OAR 952-001-0090

**i.e.**  
 ENGINEERING  
 741 SE Jackson Street  
 Roseburg, Oregon 97470  
 PHONE (541) 673-0166  
 FAX (541) 440-9392  
 Email: iemail@ieengineering.com

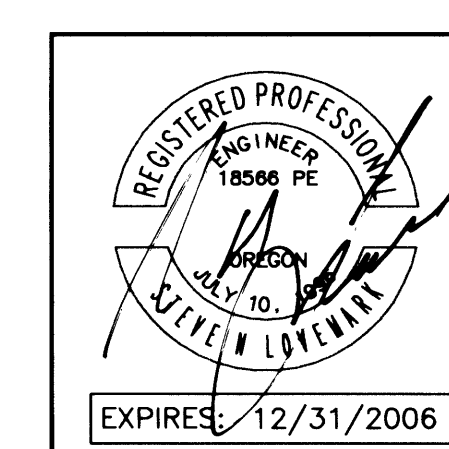

Rev.	Date	Dwg	Description
1	6/23/06	JDL	AS-BUILT

Project Name: SOUTH PARK SUBDIVISION	
Title: GRADING AND EROSION	
DES JPM	PROJECT NO. 106-04
DWG ANV	DATE: MARCH 21, 2005
CHK SNL	SCALE: AS SHOWN
APP SNL	SHEET: 3 OF 8

Co.Rd. # 375L M.P. 0.00 - 0.02 DO NOT DUPLICATE

**CO. RD. #375L GRADING AND EROSION**

R375EROS