



**CALL BEFORE YOU DIG 1**  
**ONE CALL: (800) 332-2344**  
 OAR 952-001-0010 THROUGH  
 OAR 952-001-0090

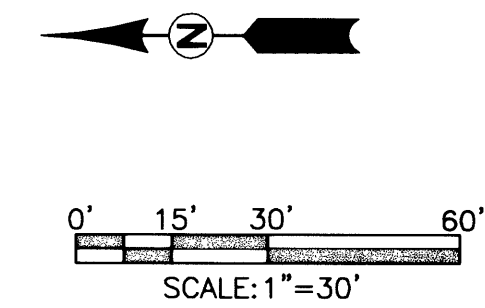

**i.e.** ENGINEERING  
 505 SE Main Street  
 Roseburg, Oregon 97470  
 PHONE (541) 673-0166  
 FAX (541) 440-9392  
 jemail@ieengineering.com

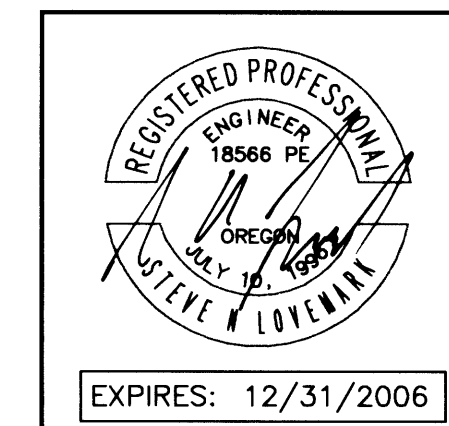

Rev.	Date	Dwg	Description
1	11/22/05	ANV	AGENCY REVIEW
2	2/10/06	BWC	RE-ALIGN RD, MOVE UTILITIES
4	11/10/06	ANV	AS-BUILTS

Project Name: **BUNTING COURT SUBDIVISION**  
 Title: **OVERALL / EROSION CONTROL**  
 DES JPM PROJECT NO. 973-14  
 DWG BWC DATE: OCTOBER 06, 2005  
 CHK SNL SCALE: AS SHOWN  
 APP SNL SHEET: 2 OF 8

**CO. RD. #375M EROSION CONTROL**

R375MEROS