


CALL BEFORE YOU DIG I
ONE CALL: (800) 332-2344
 OAR 952-001-0010 THROUGH
 OAR 952-001-0090

0' 10' 20' 40'
 SCALE: 1"=20'

FILED
 Date: 9-4-2007 By: JP
 This survey consists of: 8 BS
 Map: Co. RD 375 M
 Narrative:
 Corner Rpt:
DOUGLAS COUNTY
SURVEYOR

i.e. ENGINEERING
 505 SE Main Street
 Roseburg, Oregon 97470
 PHONE (541) 673-0166
 FAX (541) 440-9392
 iemail@ieengineering.com

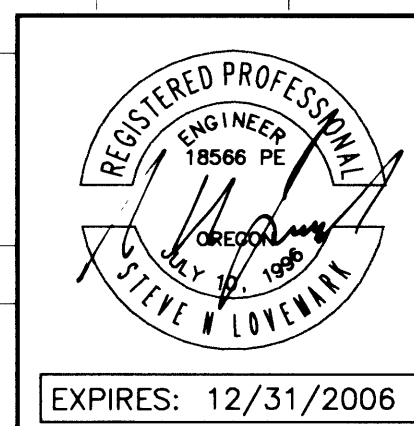

Rev.	Date	Dwg	Description
1	11/22/05	ANV	AGENCY REVIEW
2	2/10/06	BWC	RE-ALIGN RD, MOVE UTILITIES
3	4/11/06	BWC	WATERLINE TIE IN REVISION
4	11/10/06	ANV	AS-BUILTS

Project Name:
BUNTING COURT SUBDIVISION
 Title:
**BUNTING COURT
 PLAN & PROFILE**
 DES JPM PROJECT NO. 973-14
 DWG BWC DATE: OCTOBER 06, 2005
 CHK SNL HORIZ. 1"=20'
 APP SNL SCALE: VERT. 1"=5'
 SHEET: 4 OF 8

Co. Rd. # 375 M MP. 0.00 - 0.04 DO NOT DUPLICATE

CO. RD. #375M PLAN & PROFILE

R375MPLN