


**i.e.**  
ENGINEERING  
505 SE Main Street  
Roseburg, Oregon 97470  
PHONE (541) 673-0166  
FAX (541) 440-9392  
iemail@ieengineering.com

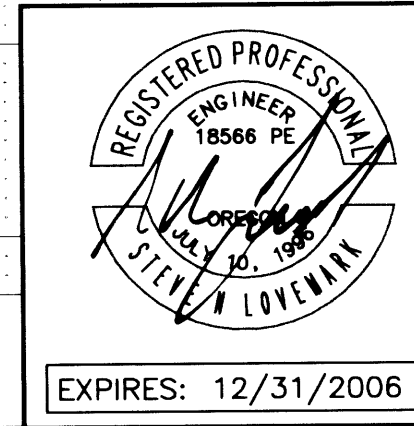

Rev.	Date	Dwg	Description
1	7/1/05	JDL	AGENCY REVIEW
2	4/13/06	JDL	AS-BUILT PHASE 1A
3	8/9/06	NRJ	AS-BUILT PHASE 1B

Project Name: RIVER CREST ESTATES 2 PHASE 1  
 Title: OTHELLO PLAN AND PROFILE  
 DES DMA PROJECT NO. 1944-0312  
 DWG JDL DATE: MAY 20, 2005  
 1"=20'  
 CHK SNL SCALE: 1"=5'  
 APP SNL SHEET: 7 OF 18

375N0000