
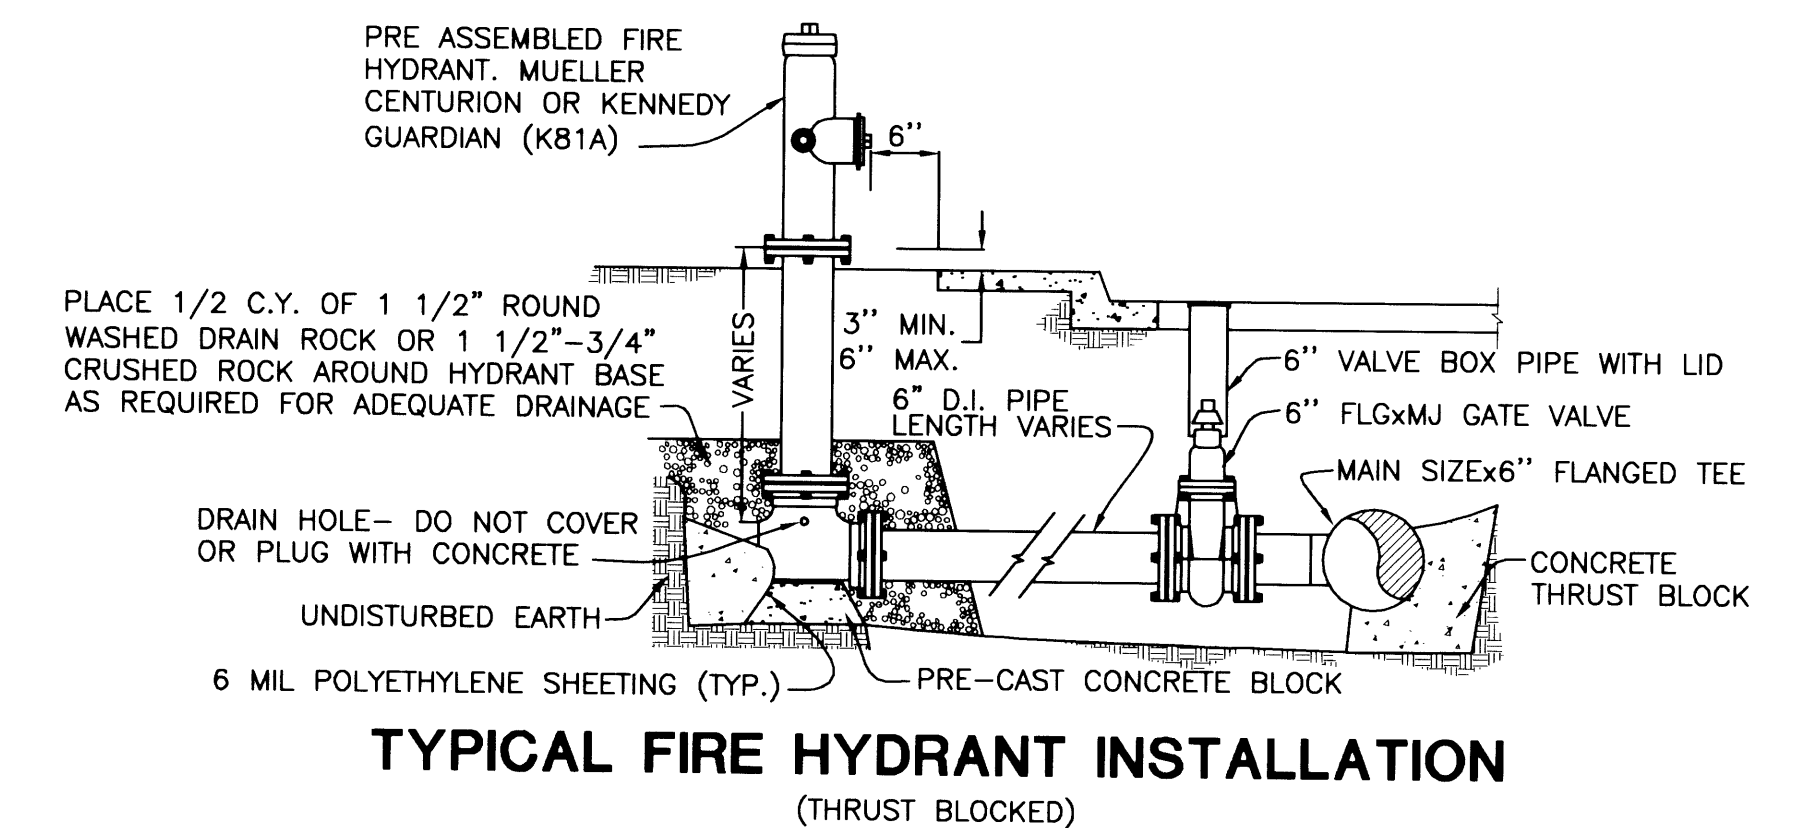
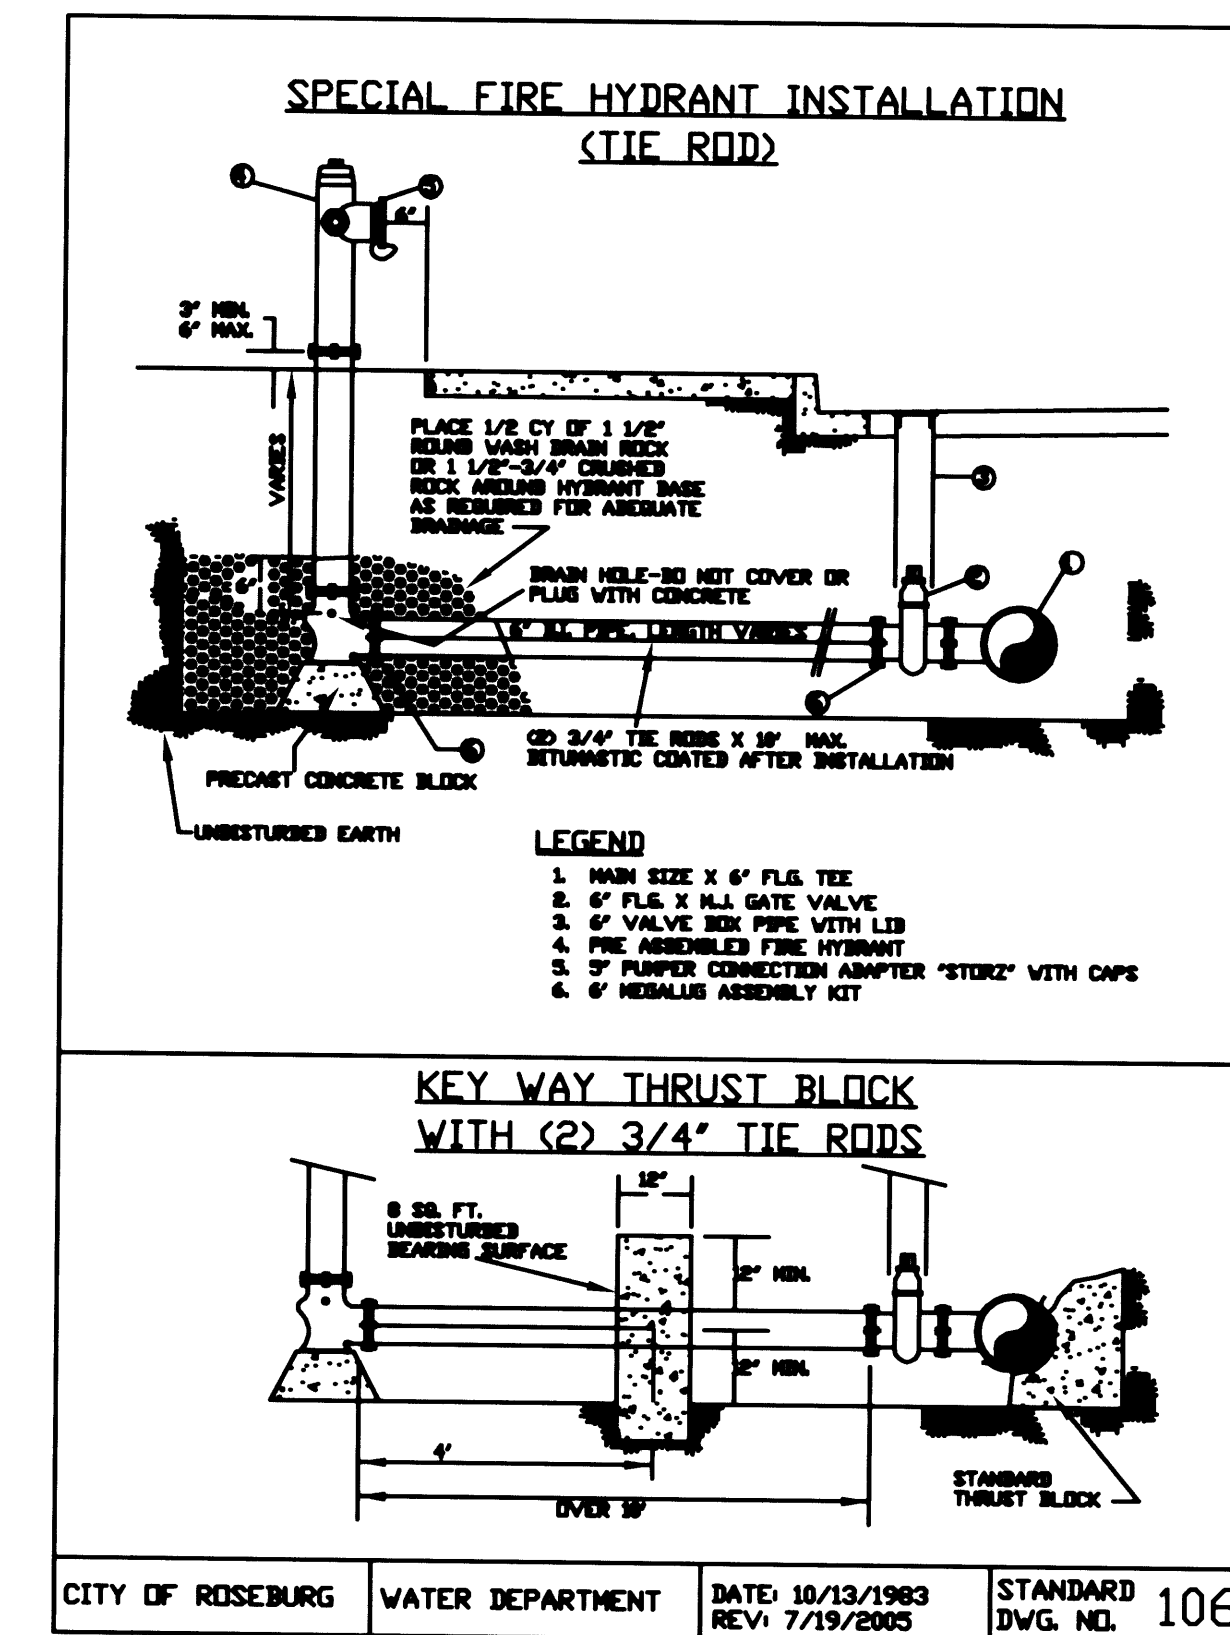
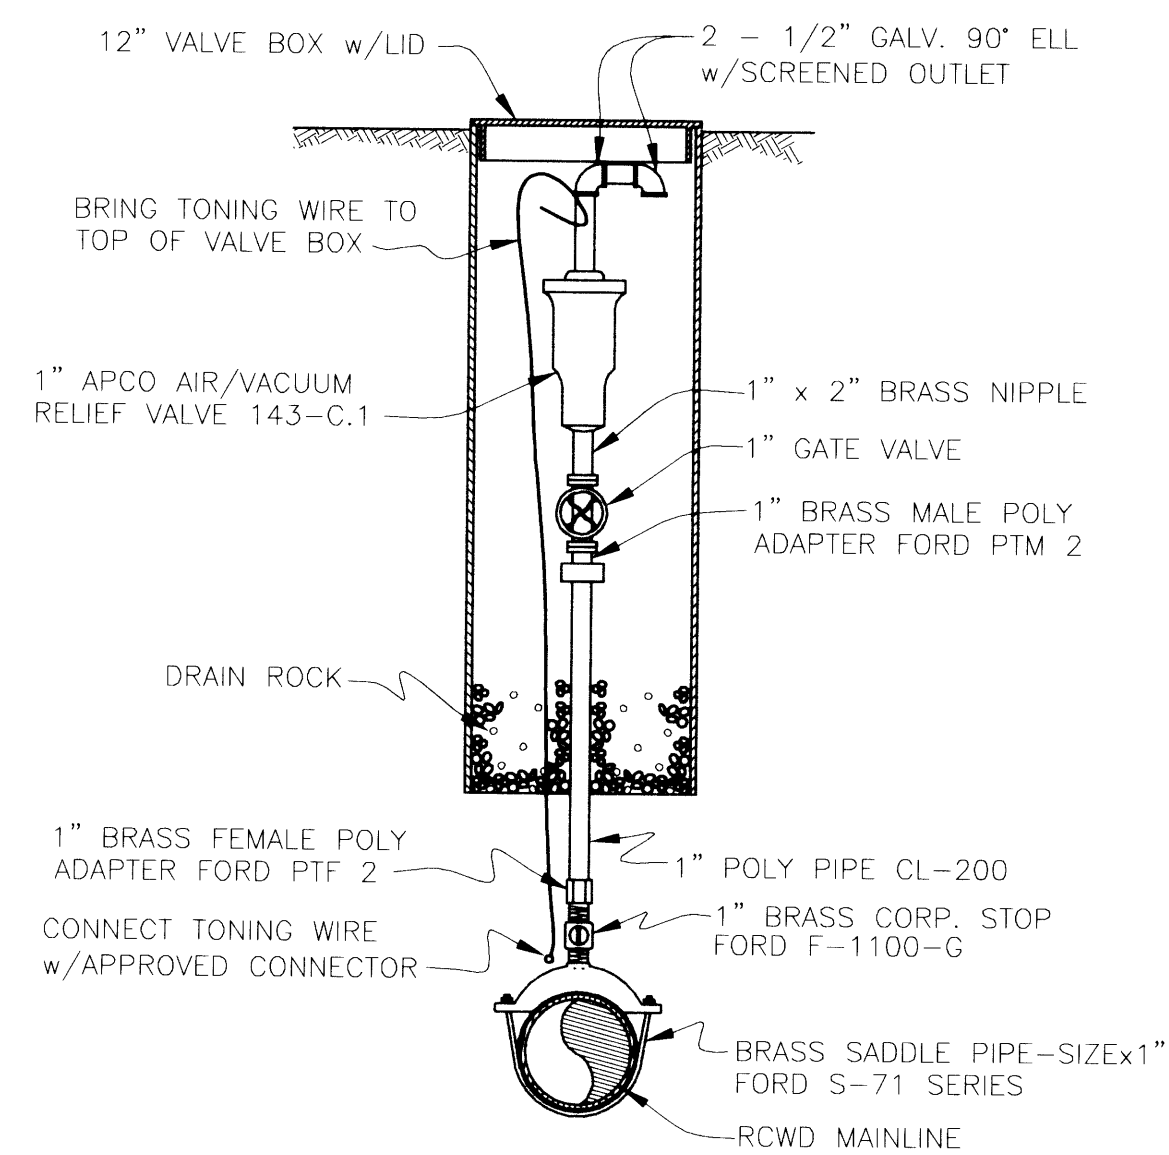
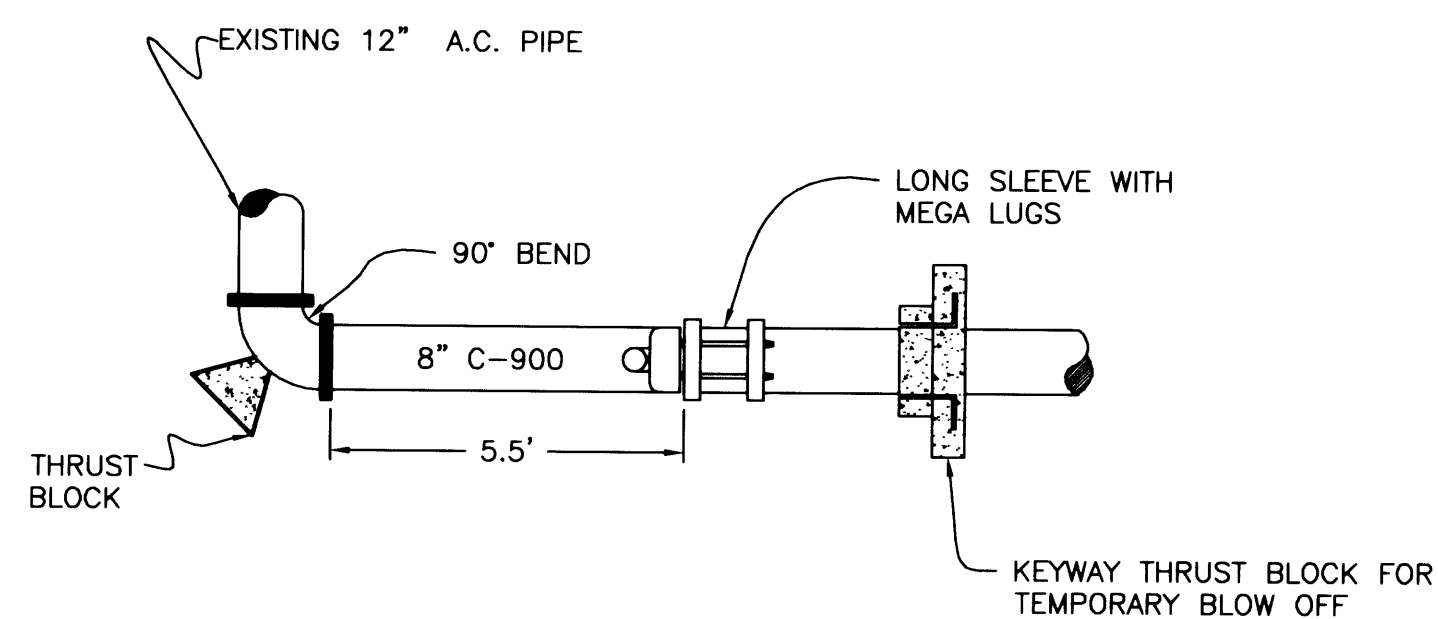
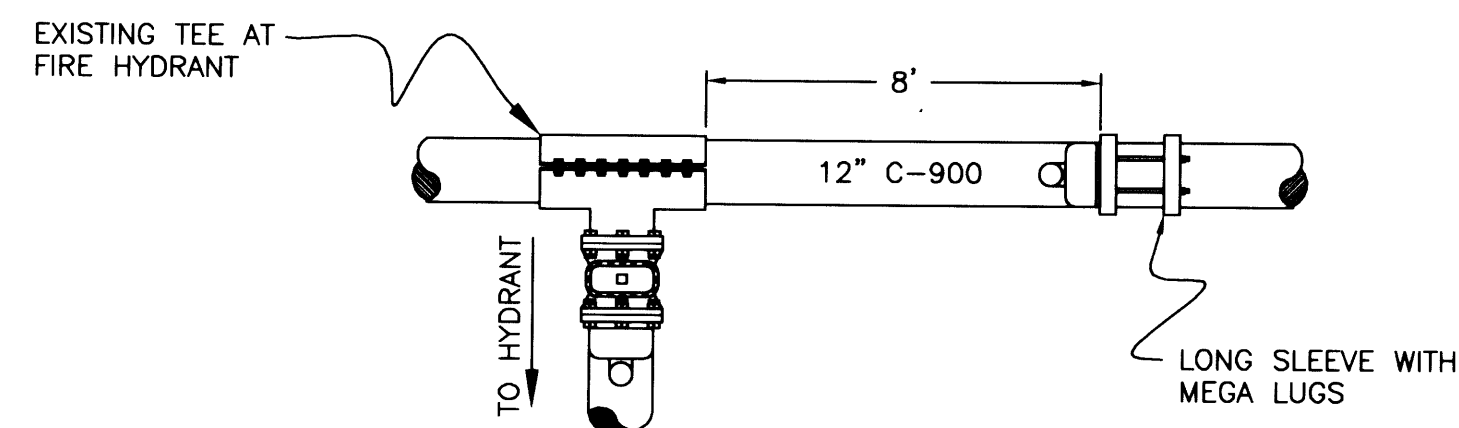
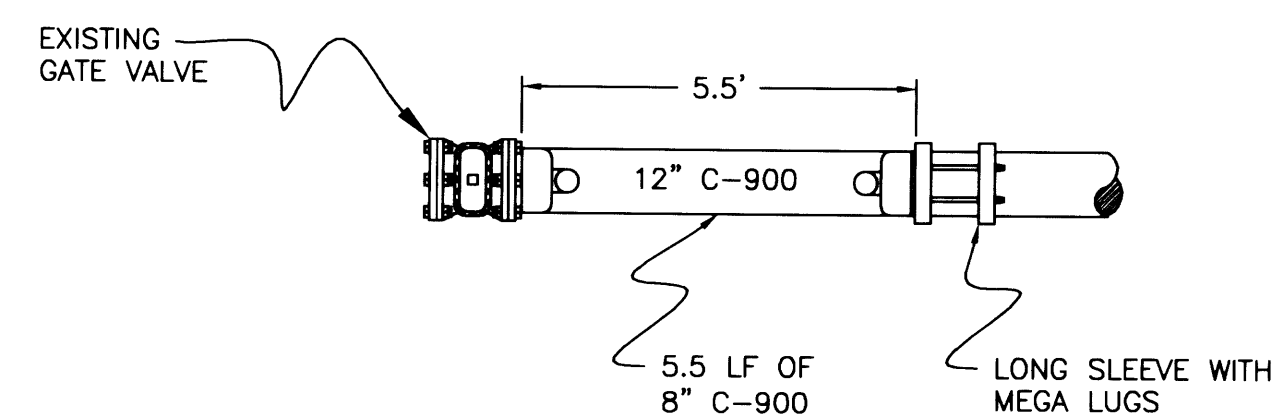


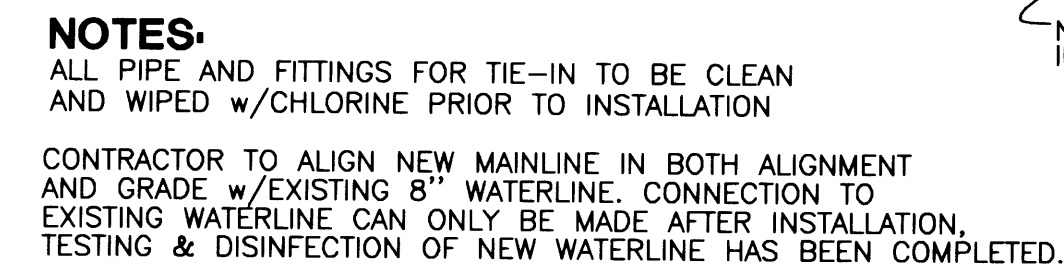

**CALL BEFORE YOU DIG I
ONE CALL® (800) 332-2344**
OAR 952-001-0010 THROUGH
OAR 952-001-0090

	505 SE Main Street Roseburg, Oregon 97470 PHONE (541) 673-0166 FAX (541) 440-9392 iemail@ieengineering.com
	Project Name:

	Rev.	Date	Dwg	Description	RIVER CREST ESTATES 2 PHASE 1		
	1	7/1/05	JDL	AGENCY REVIEW	Title:		
	2	4/13/06	JDL	AS-BUILT PHASE 1A	DETAILS		
	3	8/9/06	NRJ	AS-BUILT PHASE 1B	DES DMA	PROJECT NO. 1944-03t2T5	
					DWG JDL	DATE: MAY 20, 2005	
					CHK SNL	SCALE: AS SHOWN	
EXPIRES: 12/31/2006					APP SNL	SHEET: 16 OF 18	

Co. Rd. # 366, 375J, 375N, 375O, 288B, 288C, 288D

**DETAIL SHEET CO. RDS. 366 375J
375N 375O 288B 288C 288D**

DO NOT DUPLICATE

375288D3