


FILED
Date: 3/19/2008 By: J.P.
This Survey consists of:
Map _____
Narrative _____
Corner Rpt. _____
DOUGLAS COUNTY
SURVEYOR

HATCH KEY
PHASE 1A

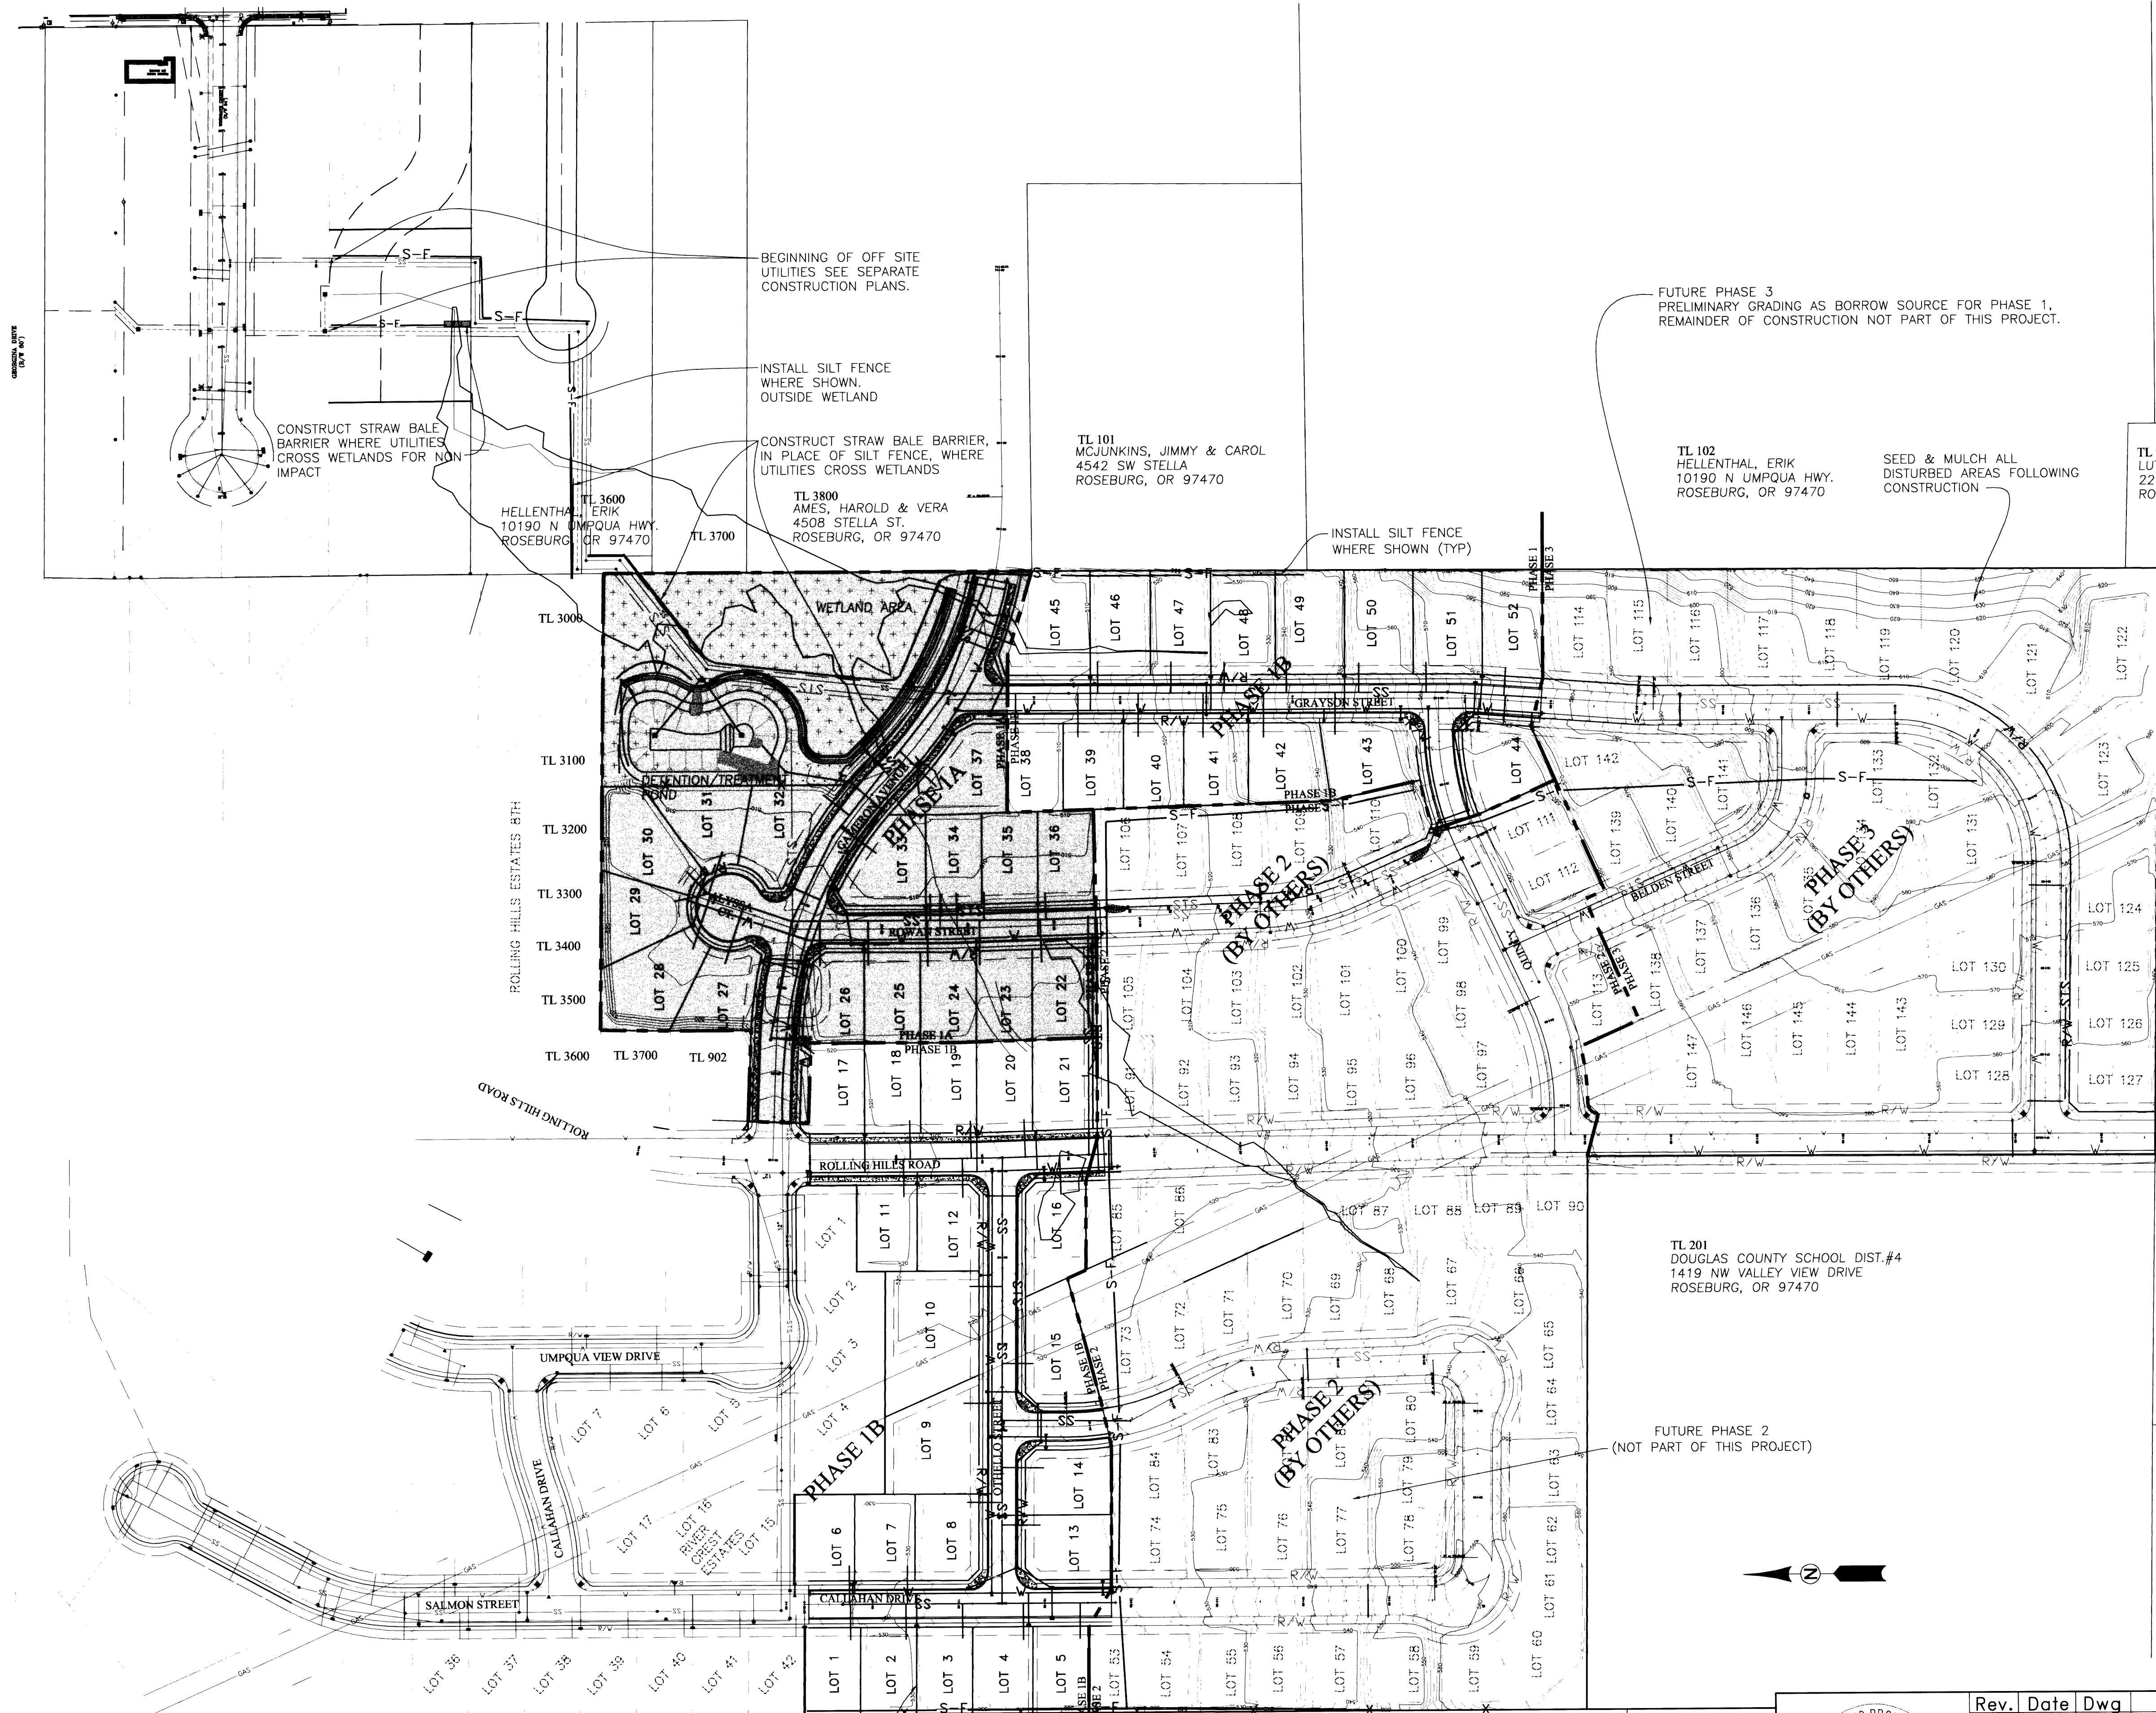

TL 900
LUTHER, TODD & JENNIFER
224 FISK LANE
ROSEBURG, OR 97470

TL 100
BODFIELD, ARLENE
2548 SW LANDERS LN.
ROSEBURG, OR 97470

TL 4800
CALKINS, GARY & KATHRYN
14229 SPANAWAY LOOP RD.
TACOMA, WA 98444

TL 301
DOUGLAS COUNTY SCHOOL DIST.#4
1419 NW VALLEY VIEW DRIVE
ROSEBURG, OR 97470

TL 401
DOUGLAS COUNTY SCHOOL DIST.#4
1419 NW VALLEY VIEW DRIVE
ROSEBURG, OR 97470

TL 102
HELLENTHAL, ERIK
10190 N UMPQUA HWY.
ROSEBURG, OR 97470

TL 101
MCJUNKINS, JIMMY & CAROL
4542 SW STELLA
ROSEBURG, OR 97470

TL 3800
AMES, HAROLD & VERA
4508 STELLA ST.
ROSEBURG, OR 97470

TL 3600
HELLENTHAL, ERIK
10190 N UMPQUA HWY.
ROSEBURG, OR 97470

TL 201
DOUGLAS COUNTY SCHOOL DIST.#4
1419 NW VALLEY VIEW DRIVE
ROSEBURG, OR 97470

FUTURE PHASE 2
(NOT PART OF THIS PROJECT)


SEED & MULCH ALL
DISTURBED AREAS
FOLLOWING CONSTRUCTION

INSTALL SILT FENCE
WHERE SHOWN (TYP)

TL 700
WPI #4 LLC
4610 HOLEGATE
ROSEBURG, OR 97470

TL 402
WPI #4 LLC
4610 HOLEGATE ST.
ROSEBURG, OR 97470

TL 300
SCHEVERS, RONNIE
4620 SE HOLEGATE
ROSEBURG, OR 97470

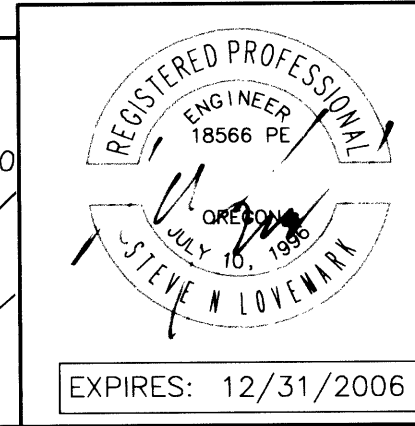

Rev.	Date	Dwg	Description
1	7/1/05	JDL	AGENCY REVIEW
2	4/13/06	JDL	AS-BUILT PHASE 1A
3	8/9/06	NRJ	AS-BUILT PHASE 1B

i.e. ENGINEERING
505 SE Main Street
Roseburg, Oregon 97470
PHONE (541) 673-0166
FAX (541) 440-9392
Email: iemail@ieengineering.com

Project Name: RIVER CREST ESTATES 2 PHASE 1
Title: PHASE 1, 2, & 3
FG CONTOURS & EROSION CONTROL
DES DMA PROJECT NO. 1944-0312
DWG JDL DATE: MAY 20, 2005
CHK SNL SCALE: AS SHOWN
APP SNL SHEET: 3 OF 18

Co. Rd. # 366, 375J, 375N, 375O, 288B, 288C, 288D

F.G. CONTOURS & EROSION CONTROL CO. RDS.
366 375J 375N 375O 288B 288C 288D

DO NOT DUPLICATE

375288ER