
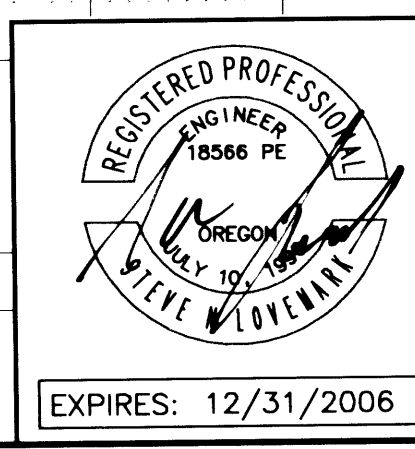
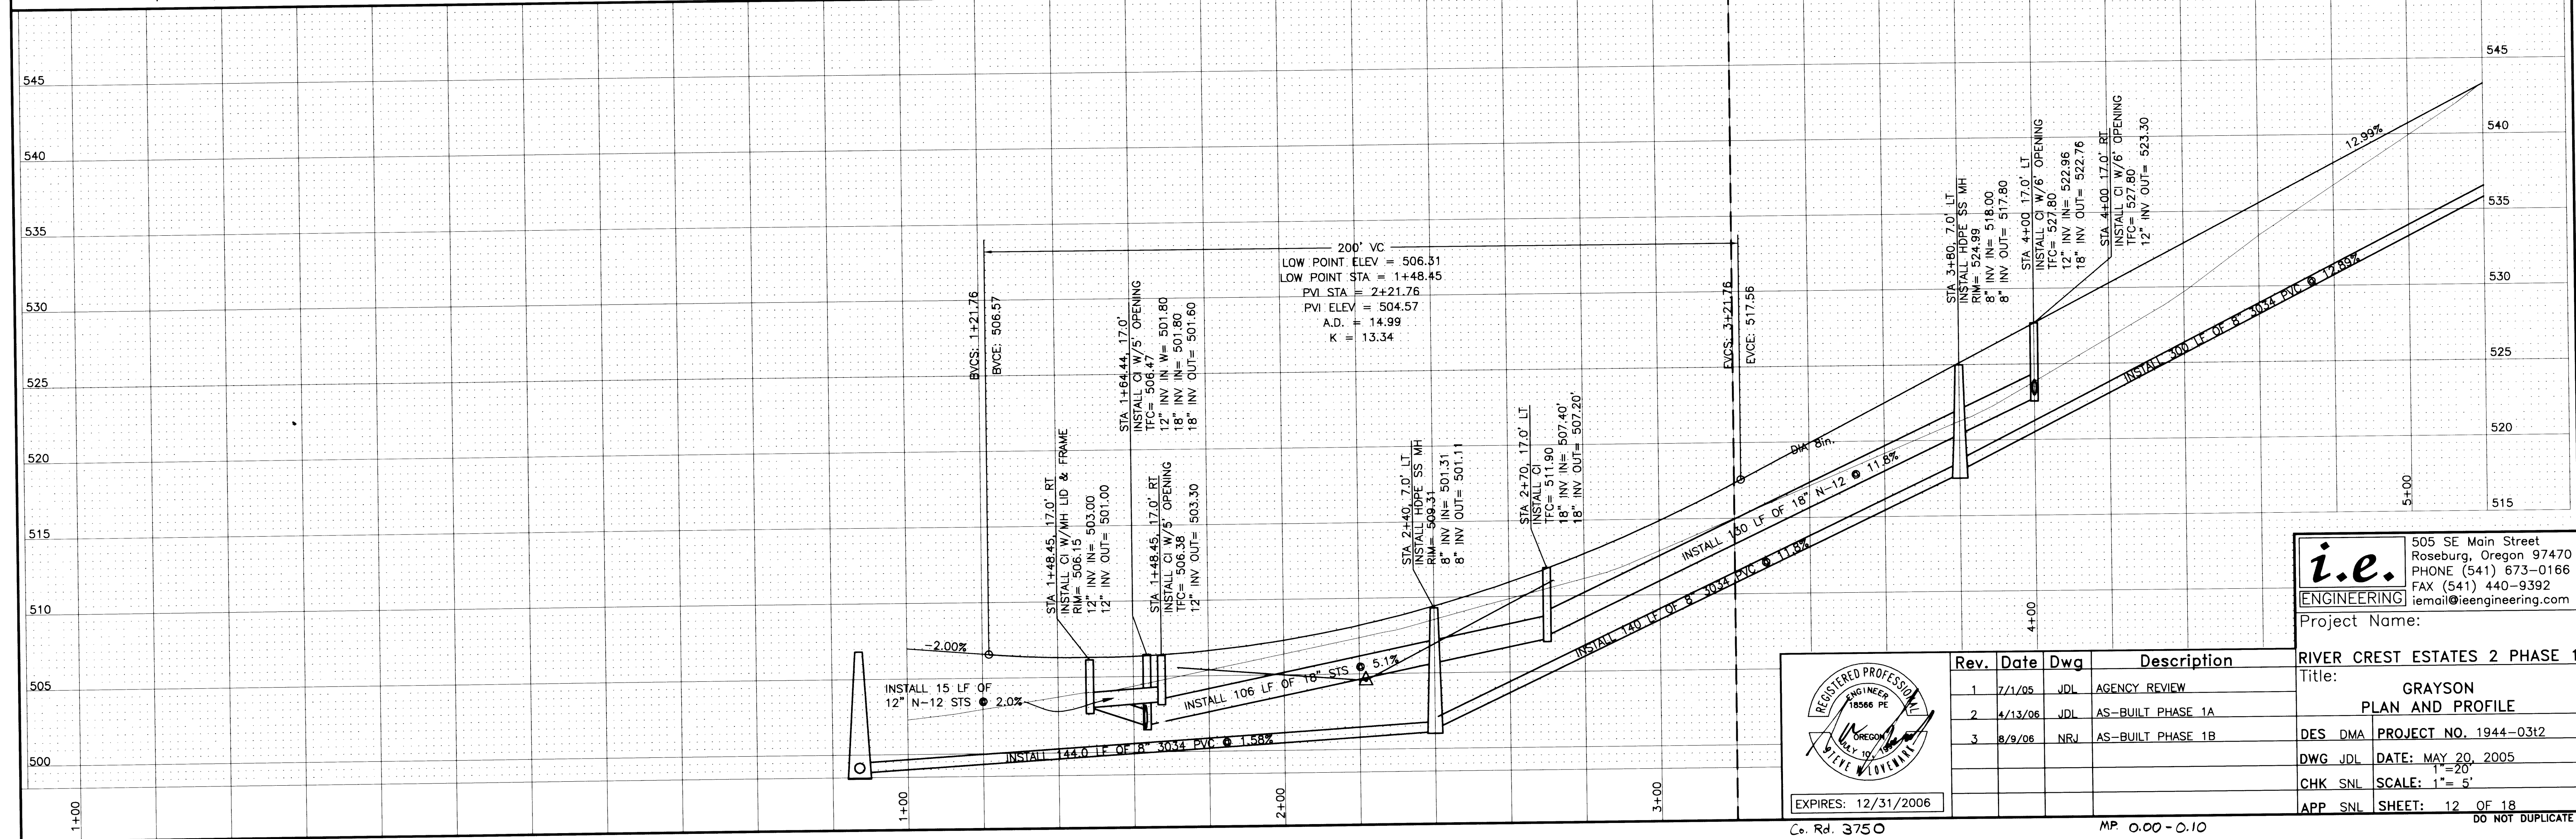


FILED
 Date: 3/19/2006 By: JF
 This survey consists of:
 Map:
 Narrative:
 Corner Rpt:
 DOUGLAS COUNTY
 SURVEYOR

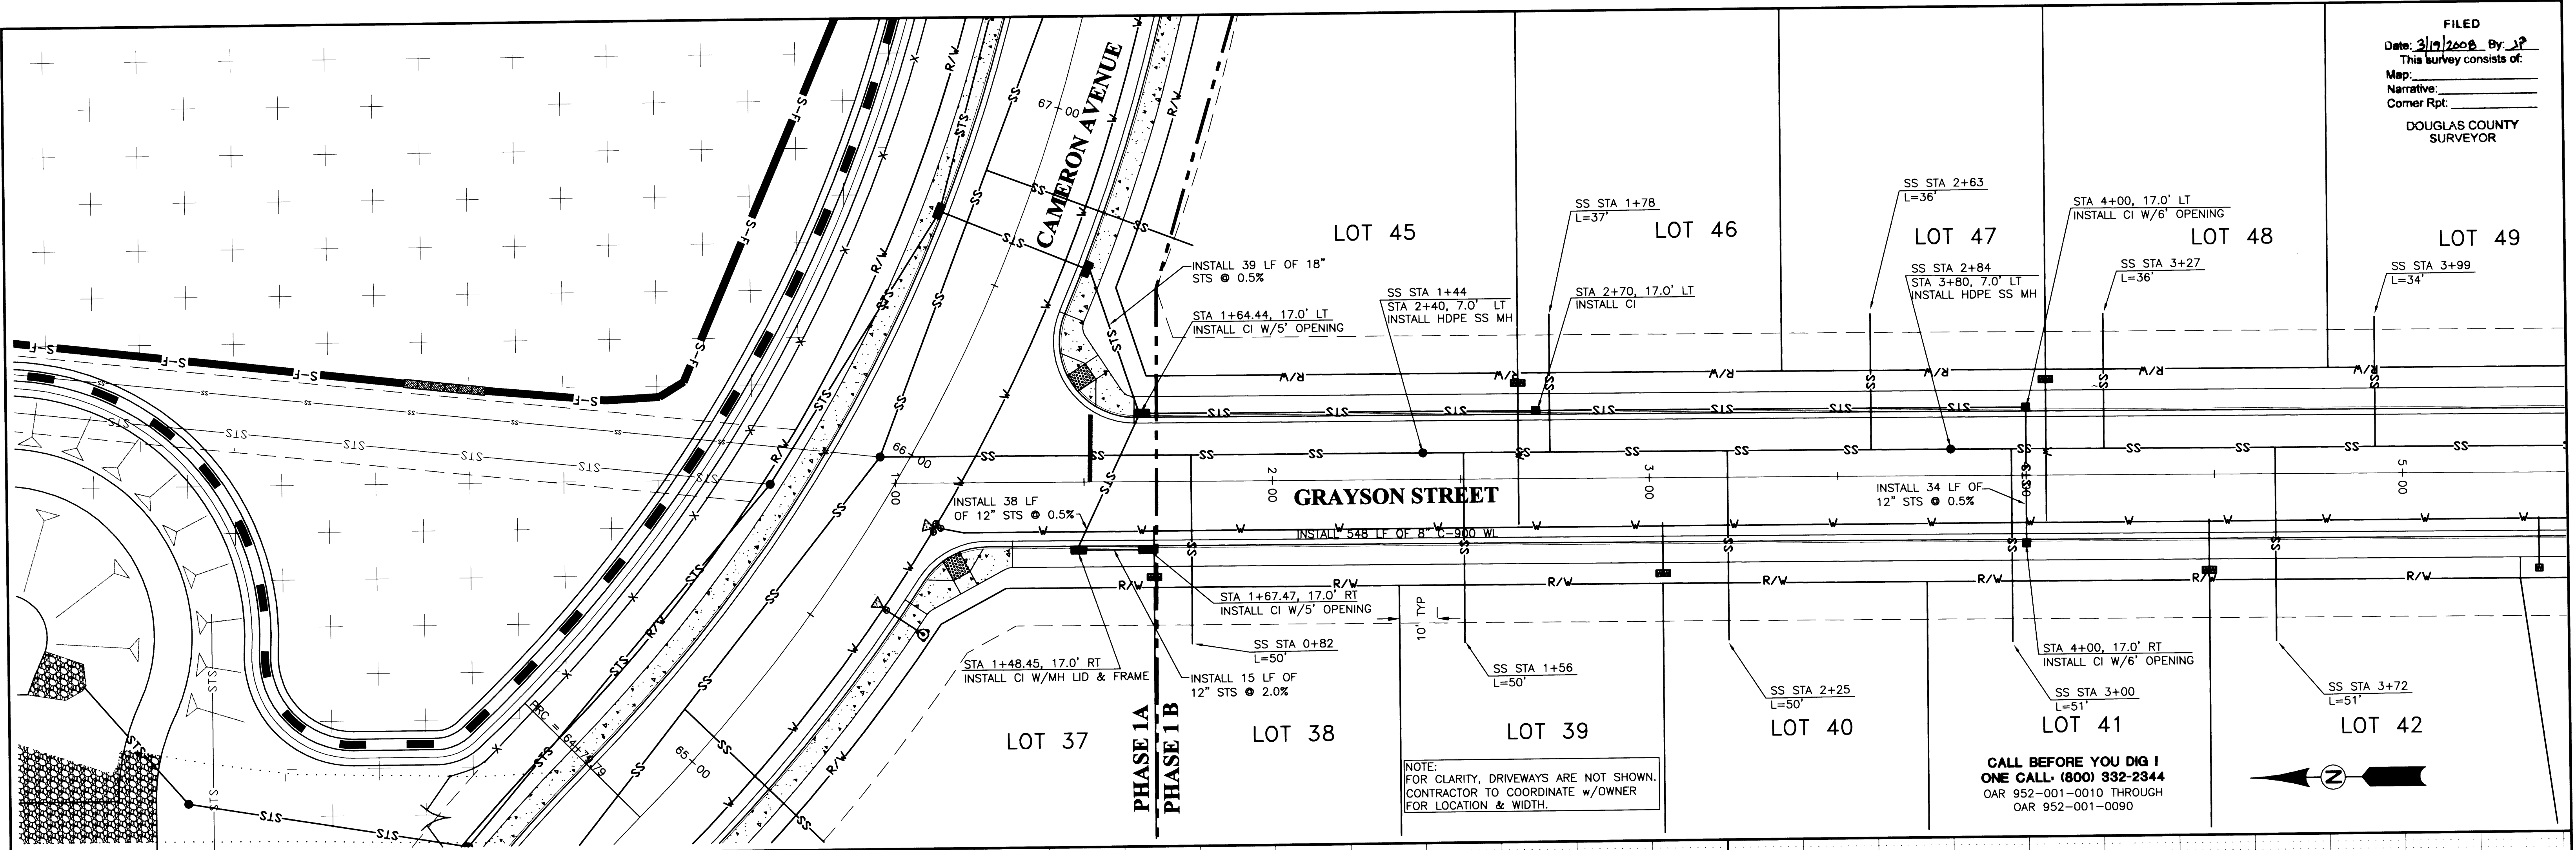

Rev.	Date	Dwg	Description
1	7/1/05	JDL	AGENCY REVIEW
2	4/13/06	JDL	AS-BUILT PHASE 1A
3	8/9/06	NRV	AS-BUILT PHASE 1B

i.e. ENGINEERING
 505 SE Main Street
 Roseburg, Oregon 97470
 PHONE (541) 673-0166
 FAX (541) 440-9392
 iemail@ieengineering.com

Project Name: RIVER CREST ESTATES 2 PHASE 1
 Title: GRAYSON PLAN AND PROFILE
 DES DMA PROJECT NO. 1944-0312
 DWG JDL DATE: MAY 20, 2005
 1"=20'
 CHK SNL SCALE: 1"= 5'
 APP SNL SHEET: 12 OF 18
 DO NOT DUPLICATE

CO. RD. 3750 PLAN & PROFILE

37500000