
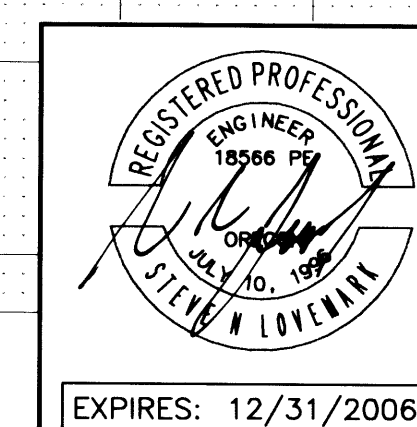


NOTE:  
 FOR CLARITY, DRIVEWAYS ARE NOT SHOWN.  
 CONTRACTOR TO COORDINATE w/OWNER  
 FOR LOCATION & WIDTH.

**CALL BEFORE YOU DIG I**  
**ONE CALL (800) 332-2344**  
 OAR 952-001-0010 THROUGH  
 OAR 952-001-0090

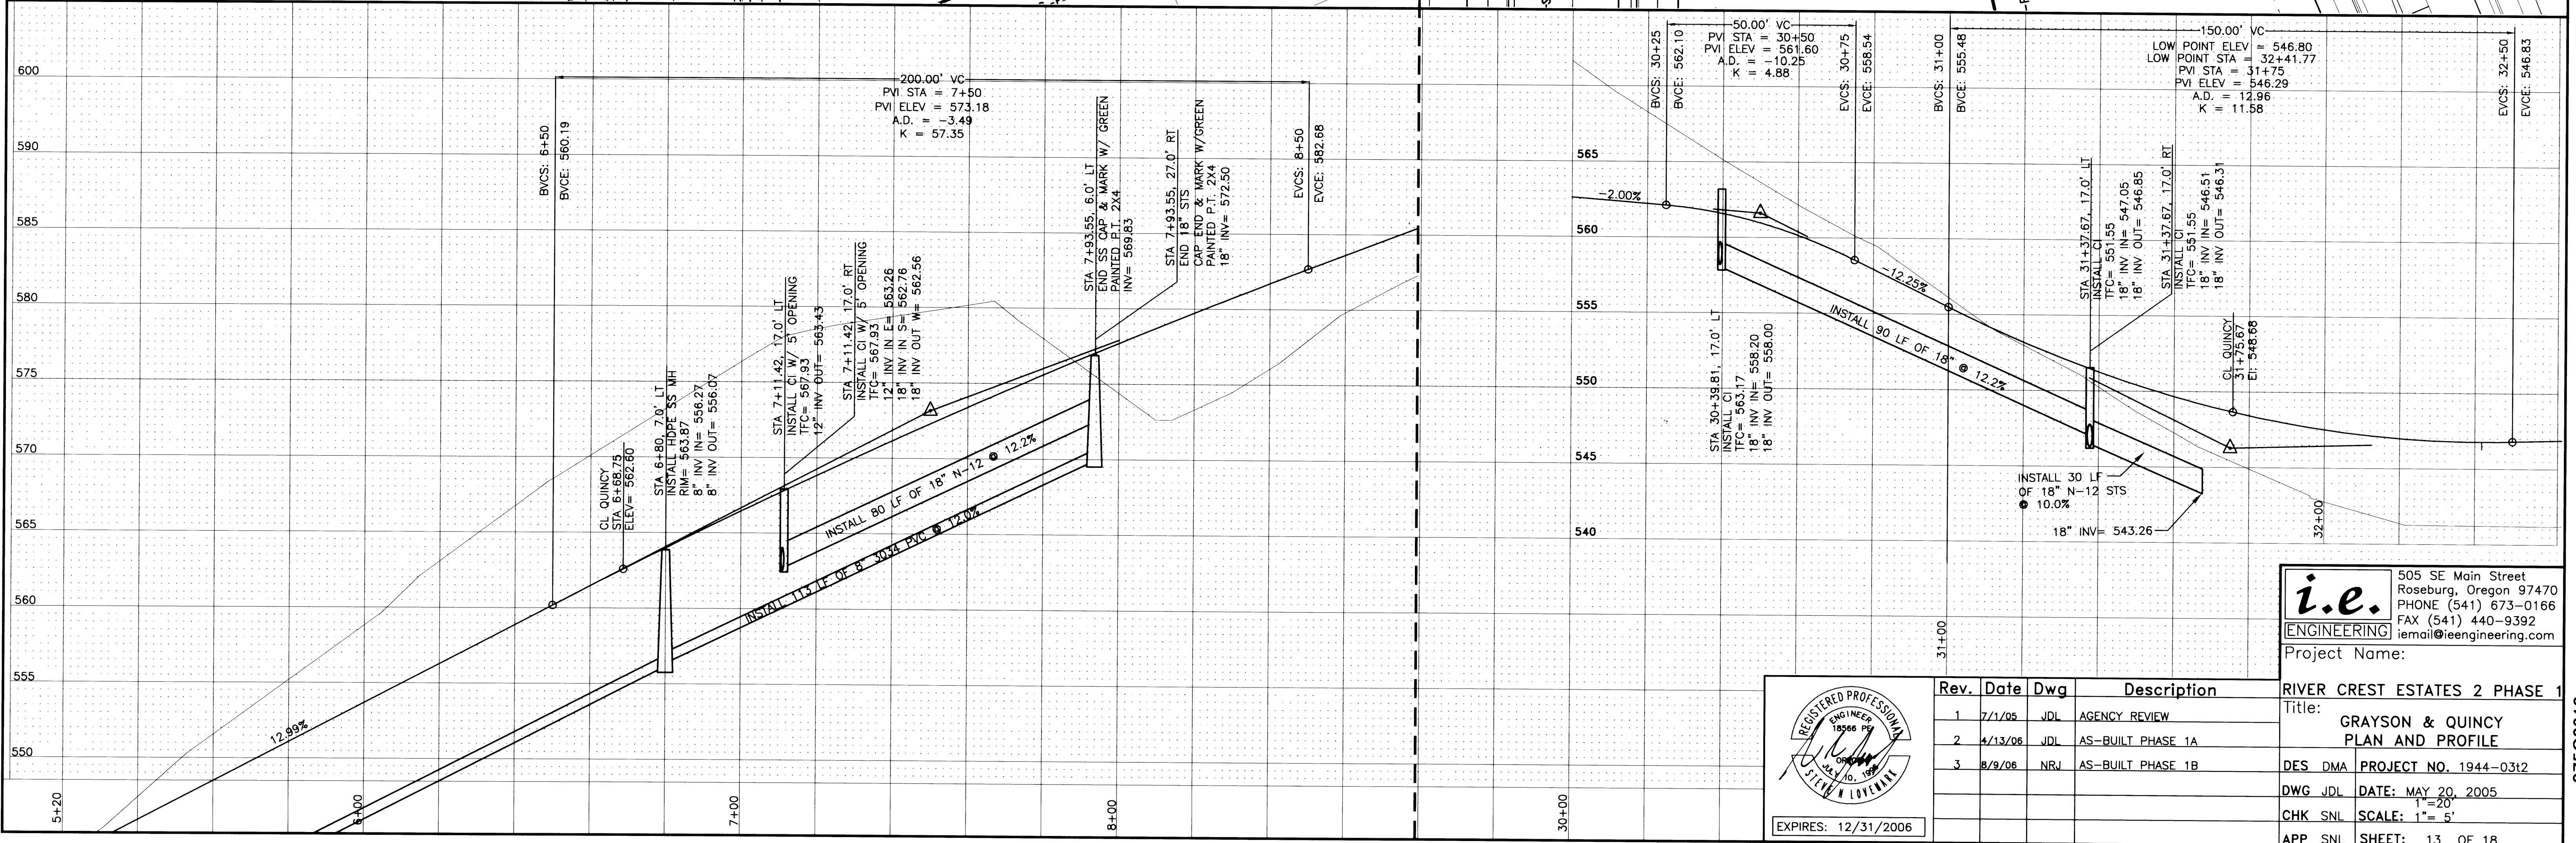

Rev.	Date	Dwg	Description
1	7/1/05	JDL	AGENCY REVIEW
2	4/13/06	JDL	AS-BUILT PHASE 1A
3	8/9/06	NRJ	AS-BUILT PHASE 1B

**i.e.**  
 ENGINEERING  
 505 SE Main Street  
 Roseburg, Oregon 97470  
 PHONE (541) 673-0166  
 FAX (541) 440-9392  
 Email: iemail@ieengineering.com

Project Name:  
 RIVER CREST ESTATES 2 PHASE 1  
 Title:  
 GRAYSON & QUINCY  
 PLAN AND PROFILE  
 DES DMA PROJECT NO. 1944-0312  
 DWG JDL DATE: MAY 20, 2005  
 CHK SNL SCALE: 1"= 5'  
 APP SNL SHEET: 13 OF 18

Co. Rd. \* 3750

MIP 0.10 - 0.13

DO NOT DUPLICATE

**CO. RD. 3750 PLAN & PROFILE**

37500010