


LEGEND:

SITE BOUNDARY	---
EXISTING RIGHT-OF-WAY	---
EXISTING CENTER LINE	---
EXISTING LOT LINE	---
EXISTING EASEMENT LINE	---
EXISTING CURB LINE	---
EXISTING SIDEWALK LINE	---
PHASE LINE	---
EXISTING GAS LINE	---
PROPOSED RIGHT-OF-WAY	---
PROPOSED CENTER LINE	---
PROPOSED LOT LINE	---
PROPOSED EASEMENT LINE	---
PROPOSED CURB LINE	---
PROPOSED SIDEWALK LINE	---
PROPOSED 2' CONTOUR LINE	---
PROPOSED 10' CONTOUR LINE	---
PROPOSED INLET PROTECTION	---
PROPOSED SEDIMENT FENCE	---

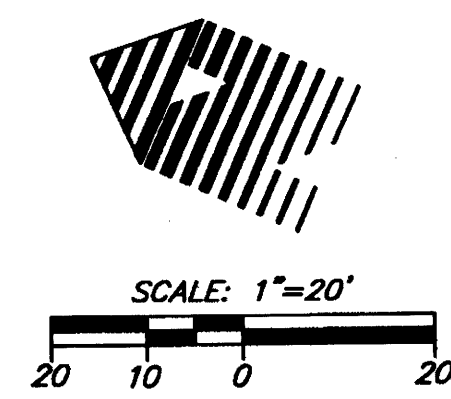

Co. Rd. #375Q MP 0.00 - 0.02

CO. RD. 375Q



DATE: 10/10/08
 DRAWN: I.MDB
 DESIGNED: I.MDB
 CHECKED: I.KBR
 PROJECT #: HAY68800

FILED
 Date: 10/10/08 By: JL
 This survey consists of:
 Name:
 Corner Rpt:
 DOUGLAS COUNTY
 SURVEYOR

BELDEN DR. GRADING PLAN STA 2+00.00 - 2+96.17
RIVER CREST ESTATES 2 - PHASE 2
HAYDEN HOMES
 Green District, Oregon

AS-BUILT
 BASED ON CHANGES
 IDENTIFIED DURING
 CONSTRUCTION
 AS OF 3/7/08



BELDEN GRADING PLAN
 SHEET NUMBER
C219
 OF 8 SHEETS

W R G I N C
DESIGN
 5415 SW Weagata Dr, Ste 100 Portland, OR 97221
 Tel. 503.419.2500 Fax. 503.419.2800
 PLANNERS • ENGINEERS • LANDSCAPE ARCHITECTS • SURVEYORS

GP375000