


SEE SHEET C225

SEE SHEET C225

FILED
 Date: 10/2/2008 By: JC
 This survey consists of:
 Map:
 Narrative:
 Corner Rpt:
 DOUGLAS COUNTY
 SURVEYOR

W R G
 D E S I G N E R S
 545 SW Weatgate Dr, Ste 100 Portland, OR 97221
 Tel. 503.418.2500 Fax. 503.418.2600
 PLANNERS • ENGINEERS • LANDSCAPE ARCHITECTS • SURVEYORS


BELDEN DR. STORM PLAN STA 2+00.00 - 2+96.17
 RIVER CREST ESTATES 2 - PHASE 2
 HAYDEN HOMES
 Green District, Oregon

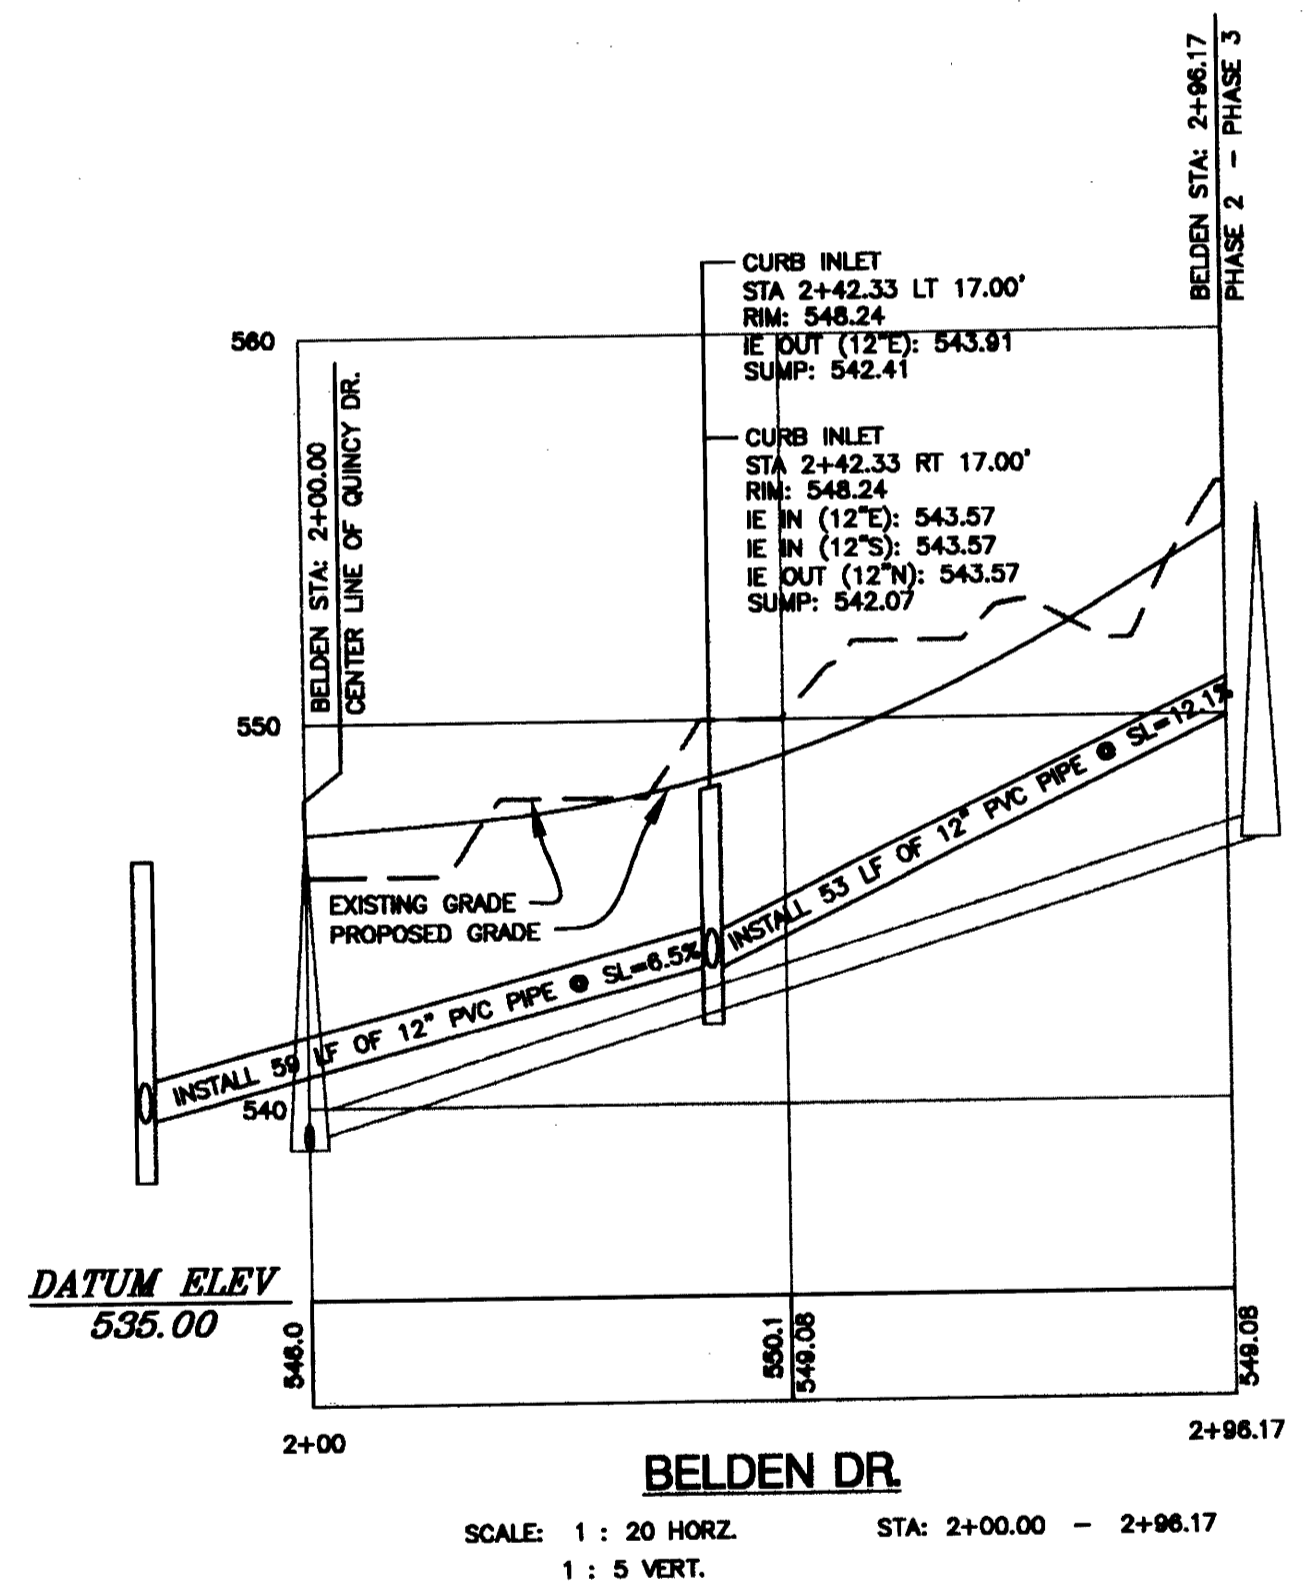

STORM DRAINAGE NOTES:
 ① INSTALL 34LF OF 12" PVC PIPE @ SL=1.0%

LEGEND:

- SITE BOUNDARY
- EXISTING RIGHT-OF-WAY
- EXISTING CENTER LINE
- EXISTING LOT LINE
- EXISTING EASEMENT LINE
- EXISTING CURB LINE
- EXISTING SIDEWALK LINE
- PHASE LINE
- EXISTING GAS LINE
- EXISTING STORM LINE
- EXISTING CURB INLET
- EXISTING SANITARY MANHOLE
- EXISTING SANITARY LINE
- PROPOSED RIGHT-OF-WAY
- PROPOSED CENTER LINE
- PROPOSED LOT LINE
- PROPOSED EASEMENT LINE
- PROPOSED CURB LINE
- PROPOSED SIDEWALK
- PROPOSED STORM LINE
- PROPOSED CURB INLET
- PROPOSED SANITARY MANHOLE
- PROPOSED SANITARY LINE
- PROPOSED WATER LINE
- PROPOSED WATER VALVE
- PROPOSED WATER METER
- PROPOSED FIRE HYDRANT

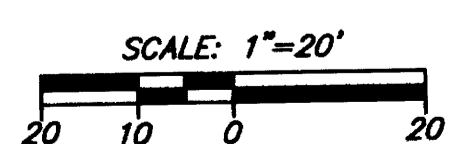

Co. Rd. # 375Q MP 0.00 - 0.02

CO. RD. 375Q

AS-BUILT

BASED ON CHANGES IDENTIFIED DURING CONSTRUCTION AS OF 3/7/08



DATE 13/12/08
 DRAWN I MDS
 DESIGNED I MDS
 CHECKED I KBR
 PROJECT # HAY08000

SHEET TITLE
 BELDEN STORM PLAN

SHEET NUMBER
 C226

OF 8 SHEETS

SS375Q00