




12" WATER LINE CONNECTION - PLAN
SCALE: 1"=40'

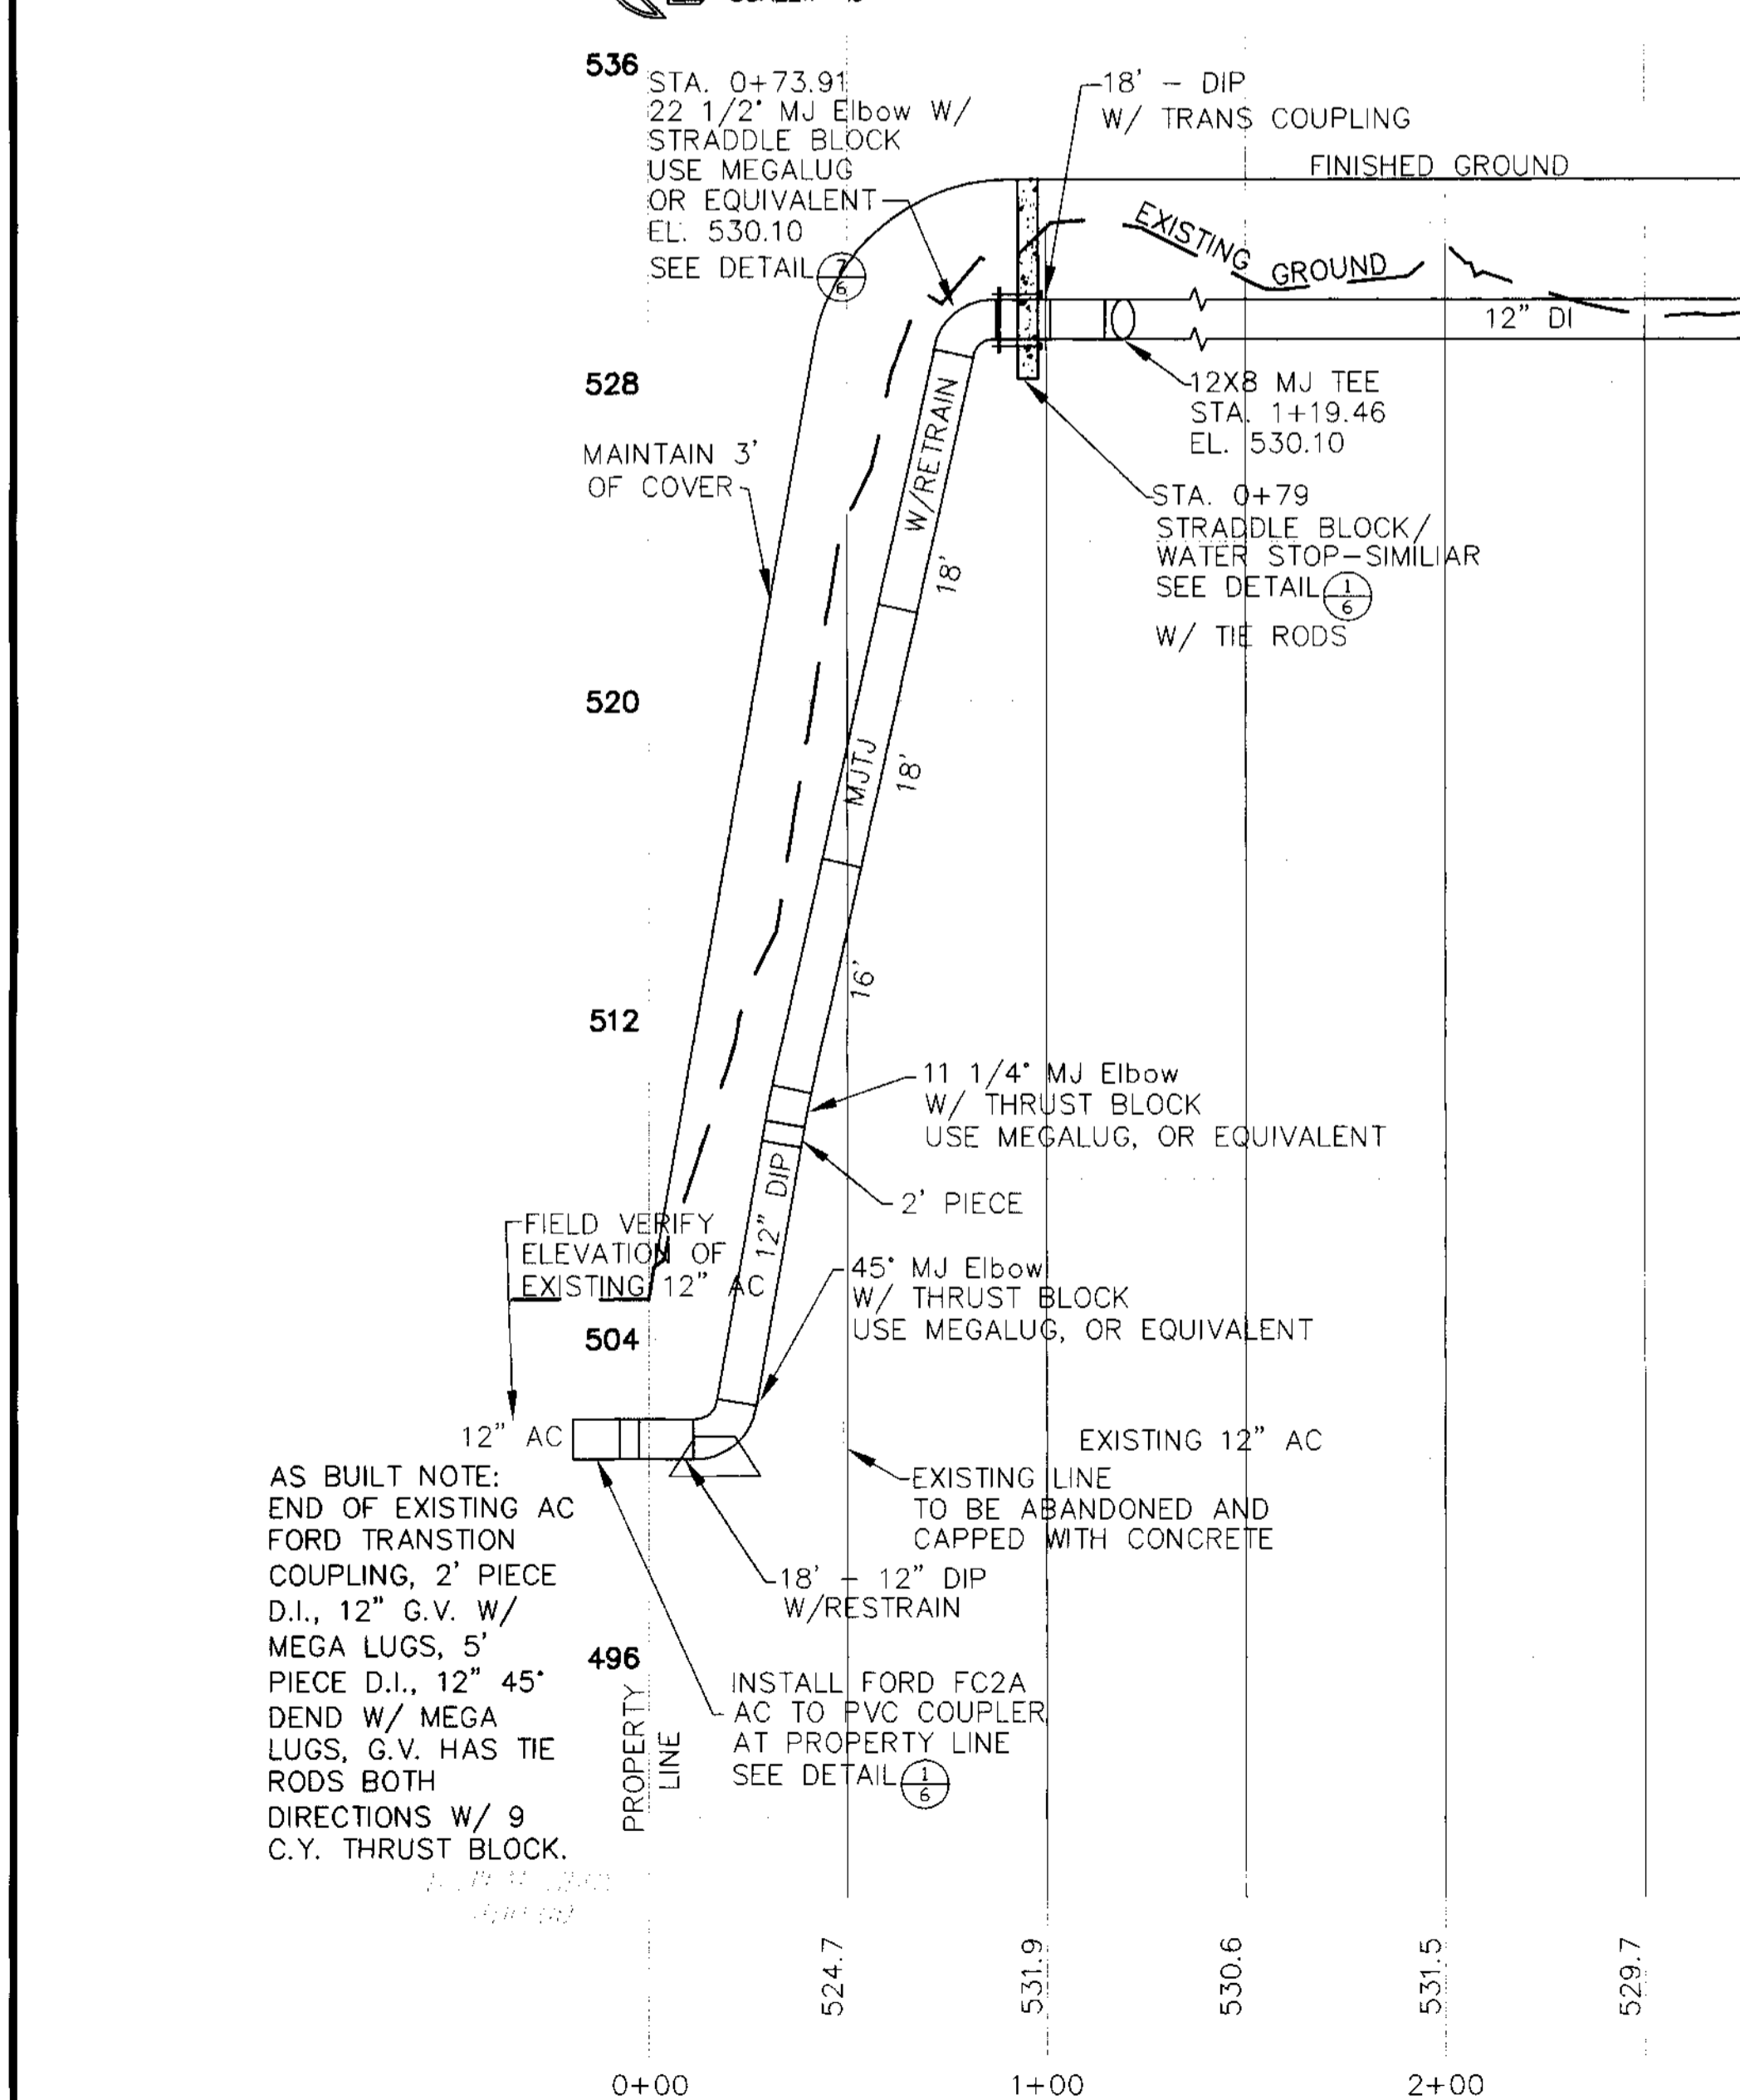

12" WATER LINE CONNECTION - PROFILE
SCALE: HORIZ. 1"=40', VERT. 1"=4'

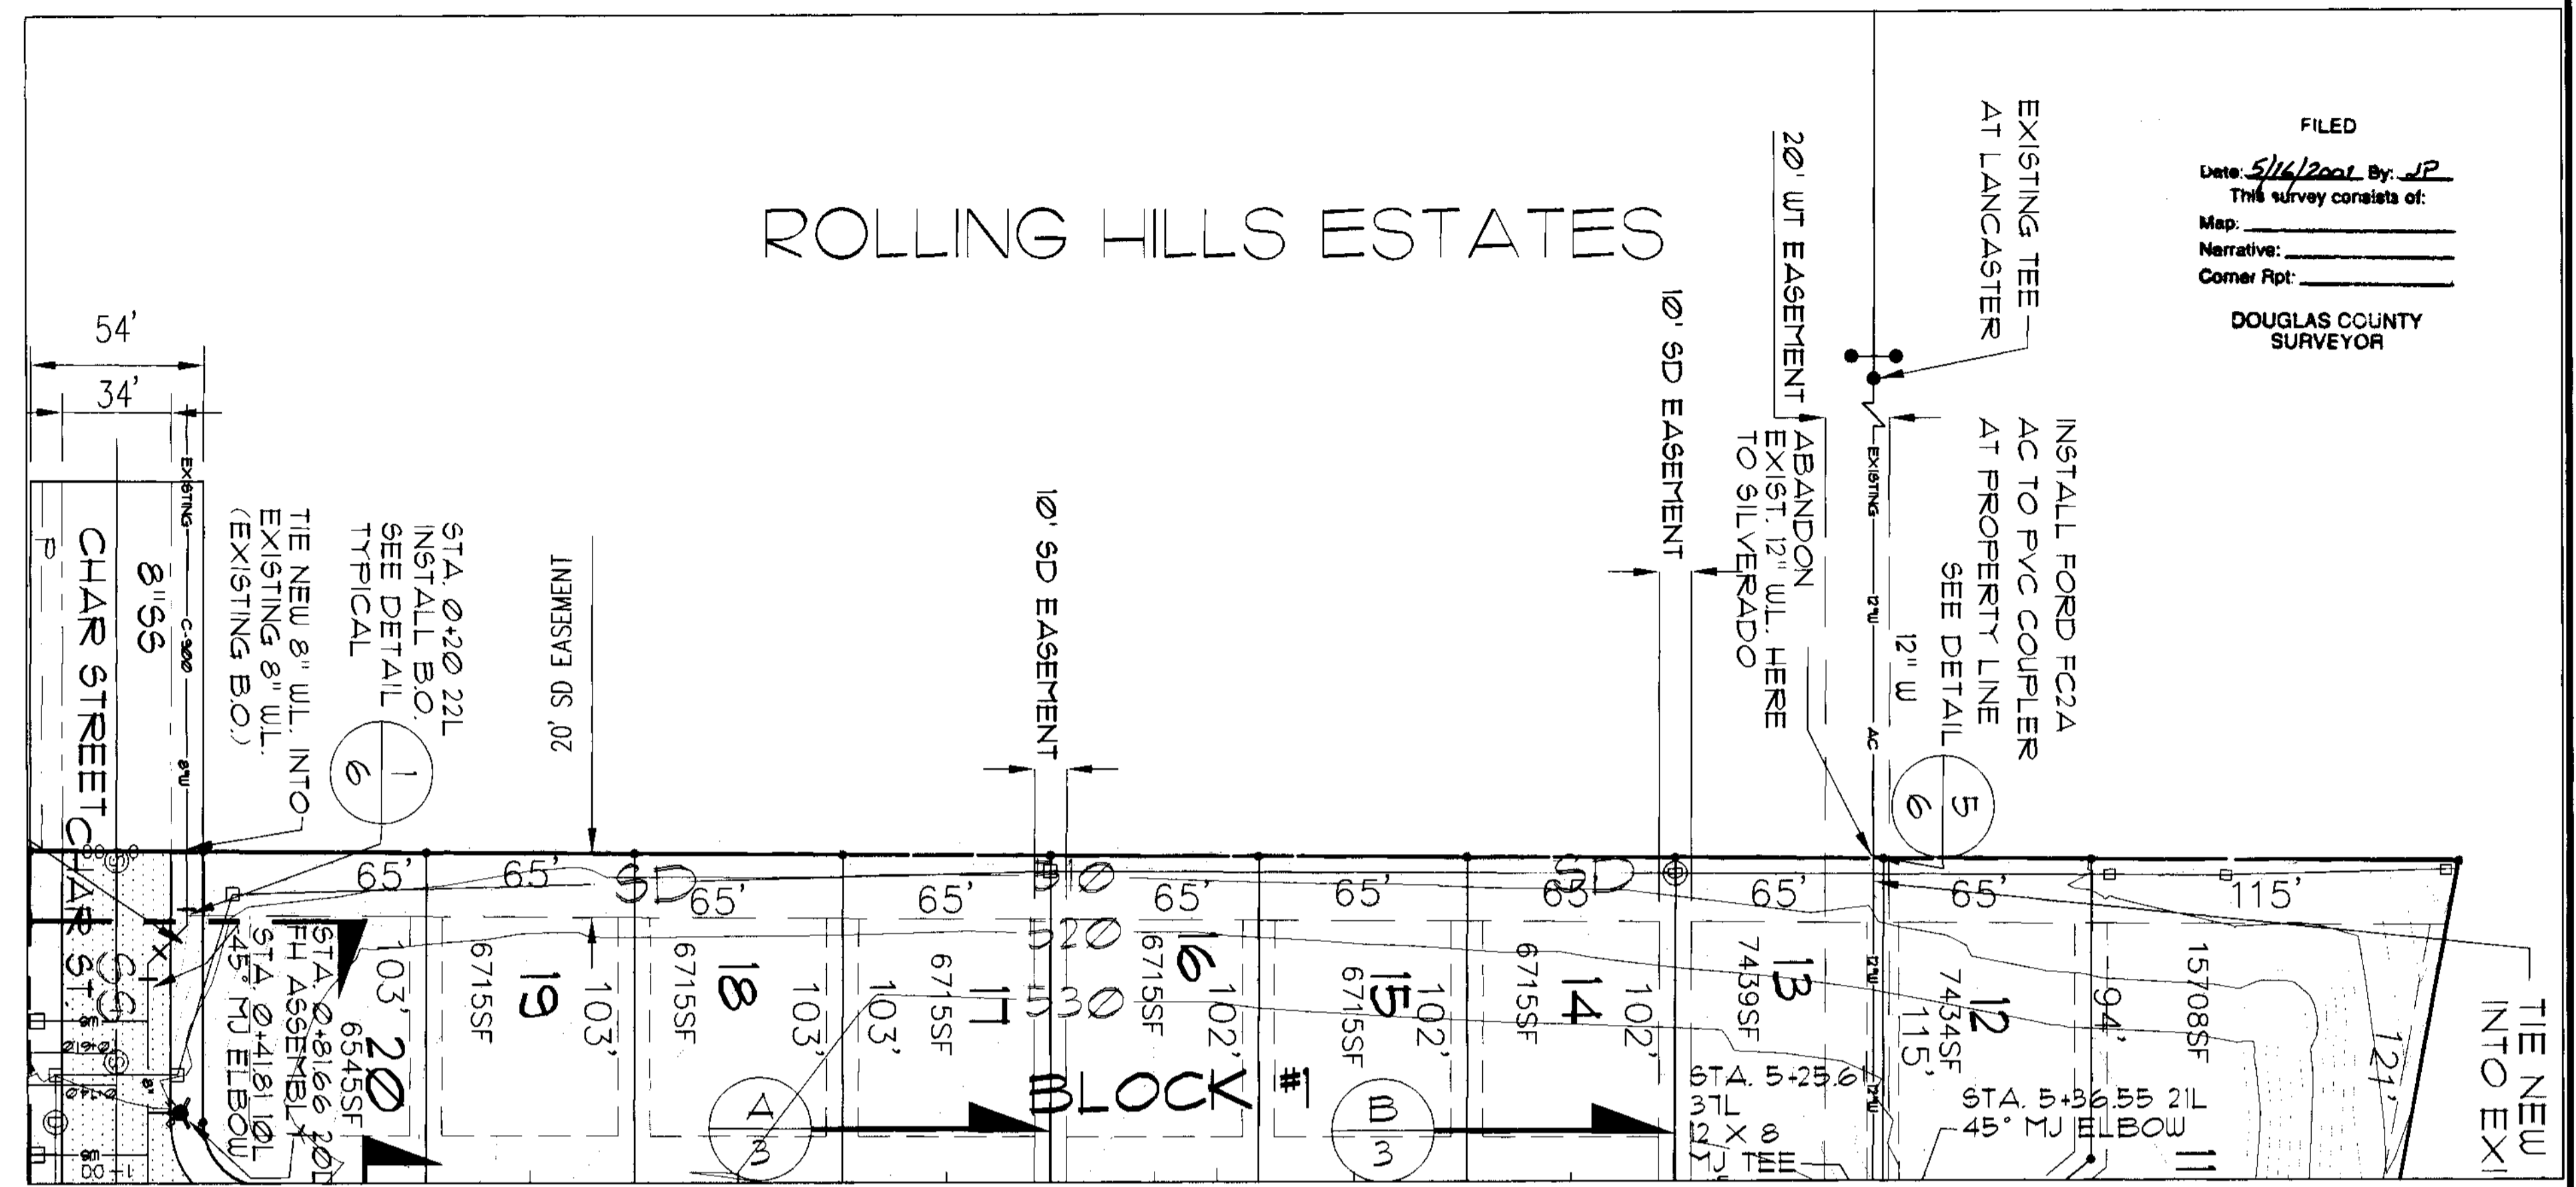


NORTH STORY - PLAN
SCALE: 1"=40'

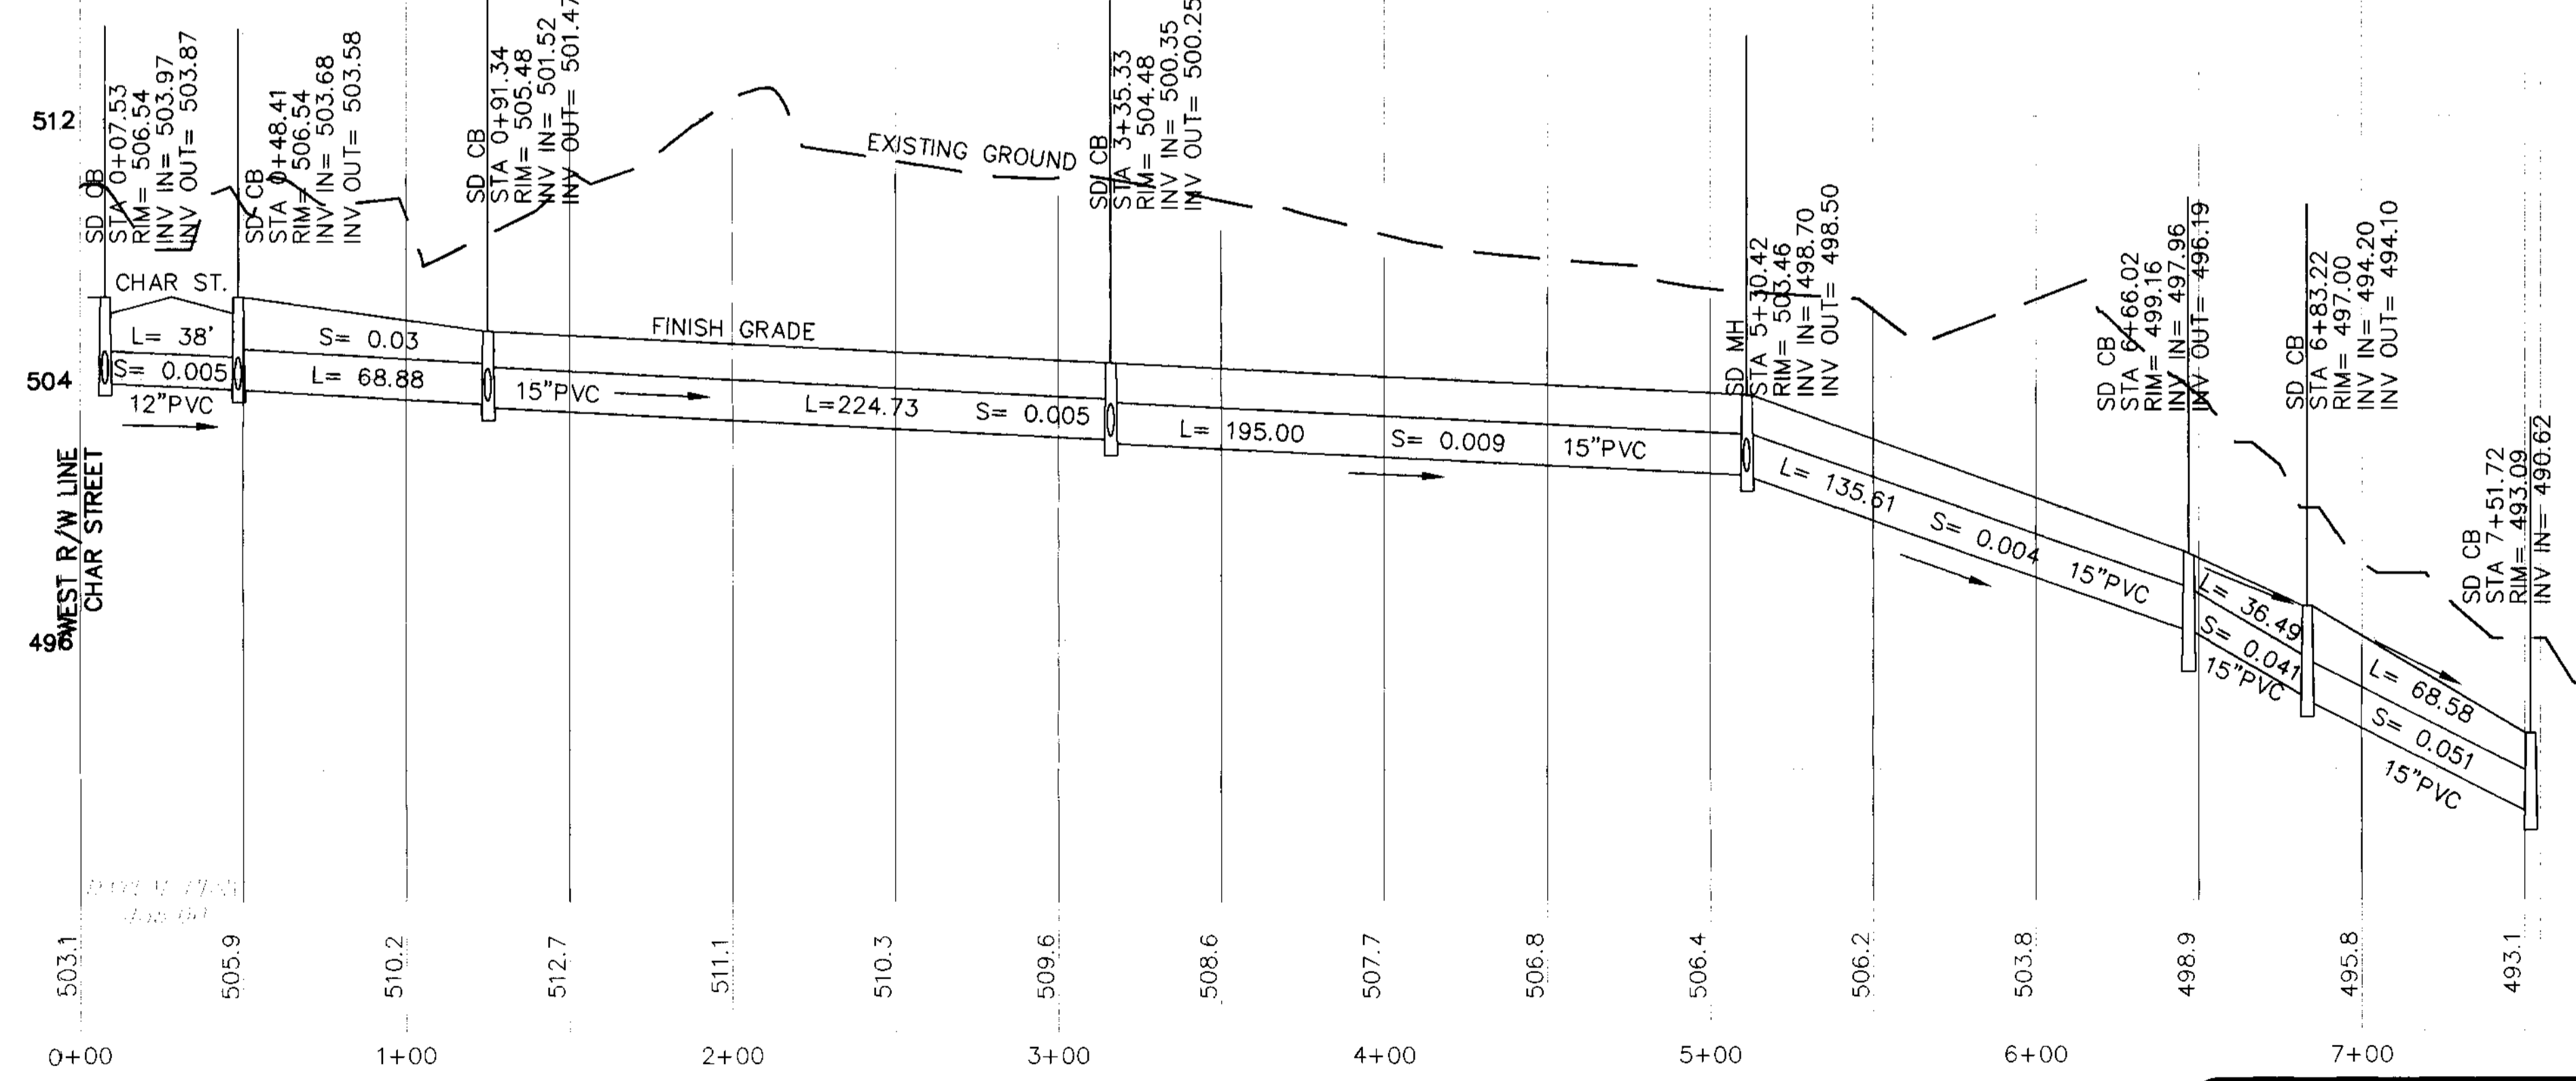


NORTH STORY - PROFILE
SCALE: HORIZ. 1"=40', VERT. 1"=4'

FILED
Date: 5/16/2001 By: JP
This survey consists of:
Map:
Narrative:
Corner Rpt:
DOUGLAS COUNTY SURVEYOR

REVISIONS	
STORM DRAIN	1/23/99
REVISED WATERLINE PER R.C.M.D.	2/19/99
REVISED WATER AND SANITARY	2/15/99
REVISED CHAR ALIGNMENT	2/24/00
REVISED PER "AS-BUILT" MARKUPS	2/19/00

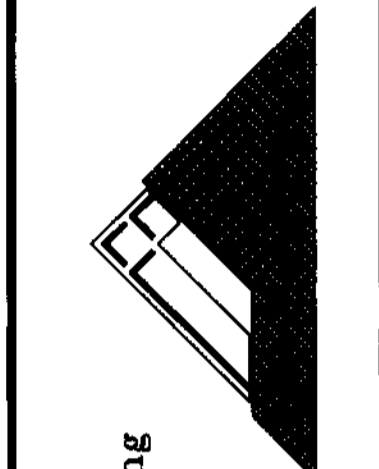

T.J. BOSSARD, INC.
Civil & Structural Engineering
183 N.W. "D" Street
Grants Pass, OR. 97526
TEL.: (541) 479-5774
FAX: (541) 471-6084

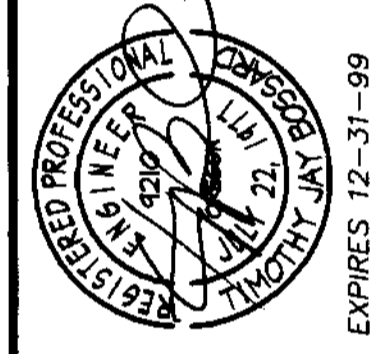

RIVERVIEW SUBDIVISION
NORTH STORY LINE PLAN/PROFILE
WATER LINE PLAN/PROFILE
THE BURDETTE LOVING TRUST
280 EAST DELMAR AVENUE, SUITE 100
PASADENA, CALIFORNIA 91101

DRAWN BY: L.V.
CHECKED BY:
DATE: 8/23/99
SCALE: AS SHOWN
CADDFILE: 99-0494A_PS
JOB NO.: 99-049
SHEET 5 OF 10

375HWATR