


i.e.
ENGINEERING

Project Name:
RIVER CREST ESTATES

Title:
PLAN AND PROFILE
DES DMA PROJECT NO. 1944-01
DWG BWC DATE: MAY 4, 2004
CHK SNL SCALE: 1"=5'
APP SNL SHEET: 7 OF 13

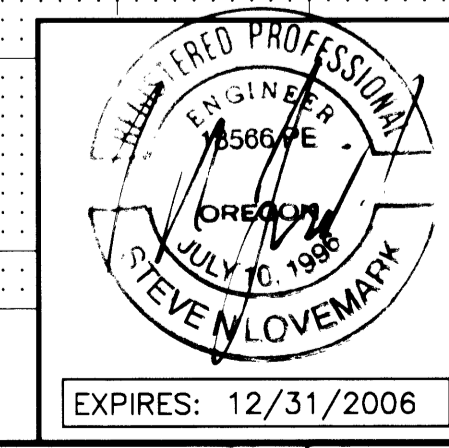

Rev.	Date	Dwg	Description
1	6/2/04	BWC	COUNTY & AGENCY REVIEW
2	1/17/05	ANV	AS-BUILTS

Co. Rd. # 375 J M.P. 0.00 - 0.11

R375J001

DO NOT DUPLICATE