



FILED
 Date: 3-7-2006 By: JLP
 This survey consists of:
 Map:
 Name:
 Corner rpt:
 DOUGLAS COUNTY
 SURVEYOR

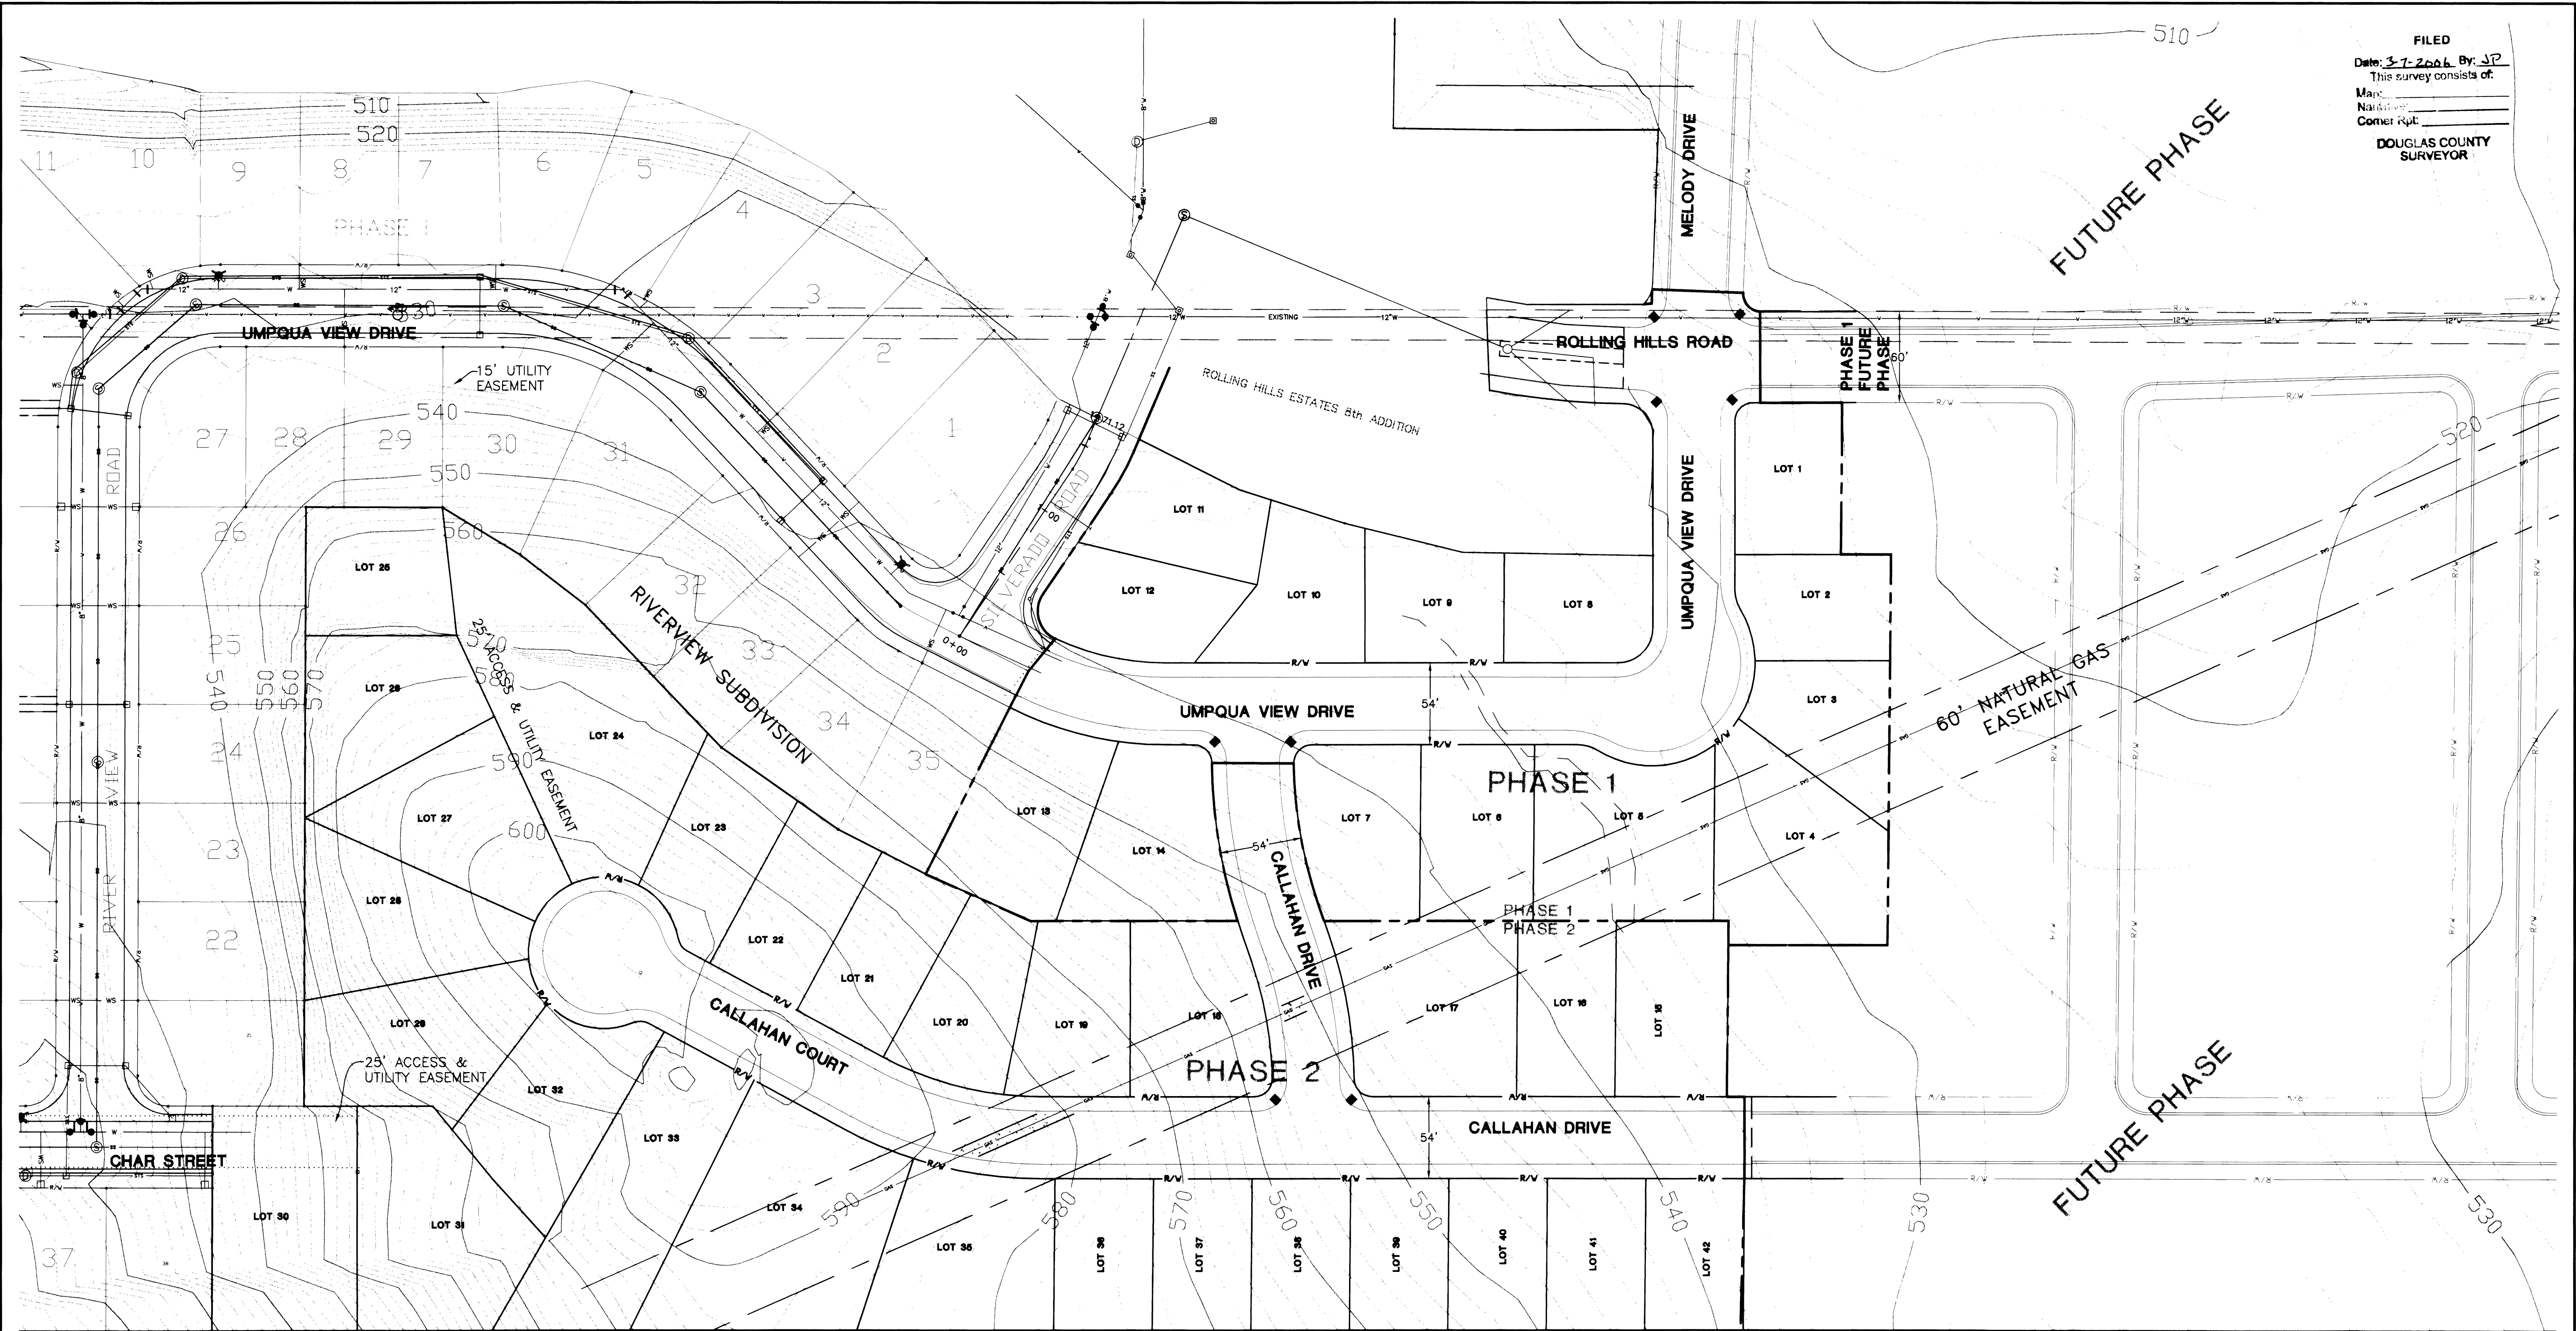

UGB


EXCLUSIVE FARM USE

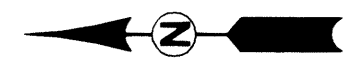

0' 25' 50' 100'
 SCALE: 1"=50'

NOTE:
 FOR CLARITY, DRIVEWAYS ARE NOT SHOWN.
 CONTRACTOR TO COORDINATE w/OWNER
 FOR LOCATION & WIDTH.

CALL BEFORE YOU DIG I
 ONE CALL (800) 332-2344
 JAR 952-001-0010 THROUGH
 OAR 952-001-0090

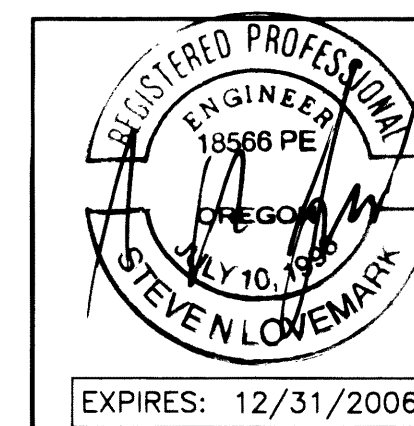

Rev.	Date	Dwg	Description
1	6/2/04	BWC	COUNTY & AGENCY REVIEW
2	1/17/05	ANV	AS-BUILTS

i.e. ENGINEERING
 741 SE Jackson Street
 Roseburg, Oregon 97470
 PHONE (541) 673-0166
 FAX (541) 440-9392
 Email: ieengineering.com

Project Name: RIVER CREST ESTATES

Title: EXISTING TOPOGRAPHY

DES DMA	PROJECT NO. 1944-01
DWG BWC	DATE: MAY 4, 2004
CHK SNL	SCALE: AS SHOWN
APP SNL	SHEET: 2 OF 13

Co. Rd. # 375H, 375J, 375K M.P. 0.00-0.24, 0.00-0.11, 0.00-DO NOT DUPLICATE 0.10

R37510PO