


DATE	
BY	
REVISION	
NO.	
DATE	
BY	
REVISION	
NO.	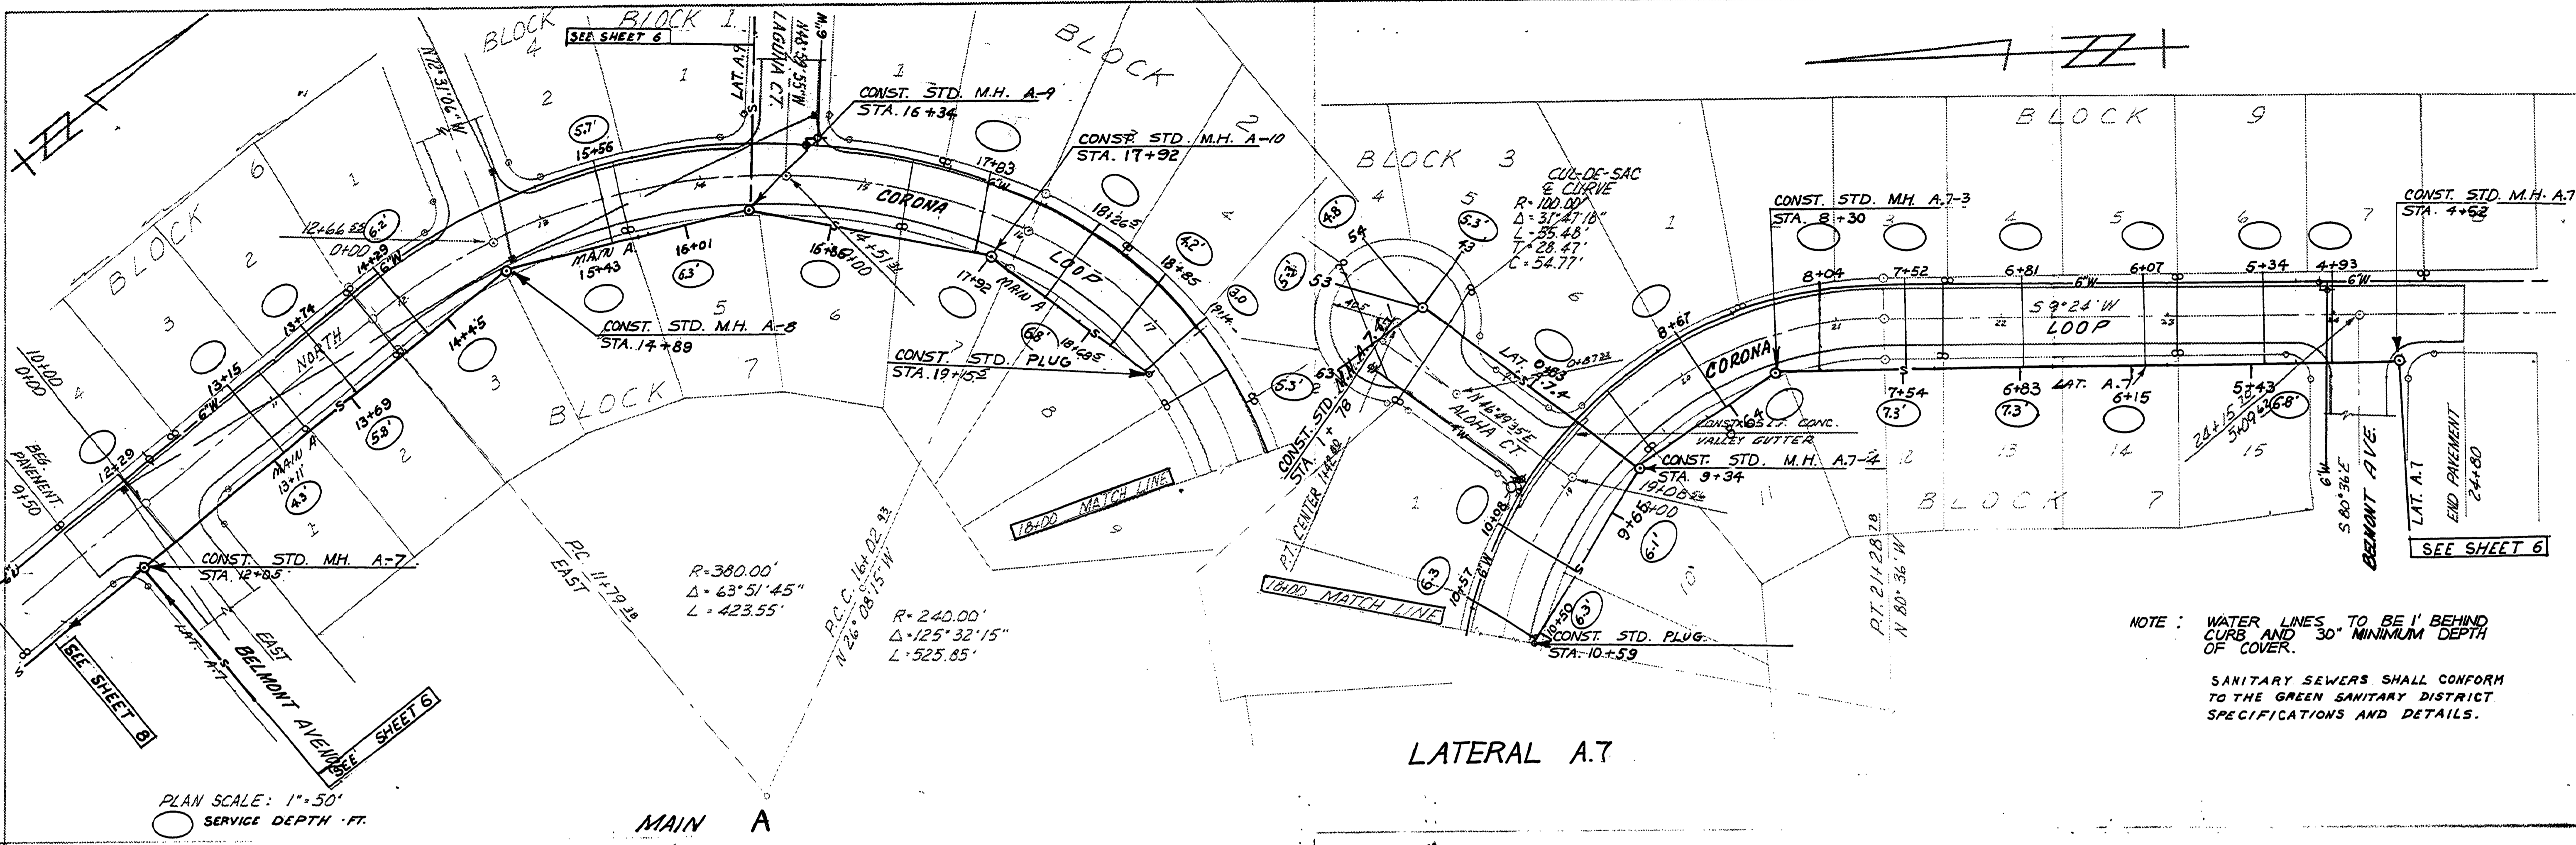
PLAN SCALE: 1"=50'
 ○ SERVICE DEPTH - FT.

NOTE: WATER LINES TO BE 1' BEHIND CURB AND 30" MINIMUM DEPTH OF COVER.
 SANITARY SEWERS SHALL CONFORM TO THE GREEN SANITARY DISTRICT SPECIFICATIONS AND DETAILS.

HORIZ. SCALE: 1"=50'
 VERT. SCALE: 1"=10'

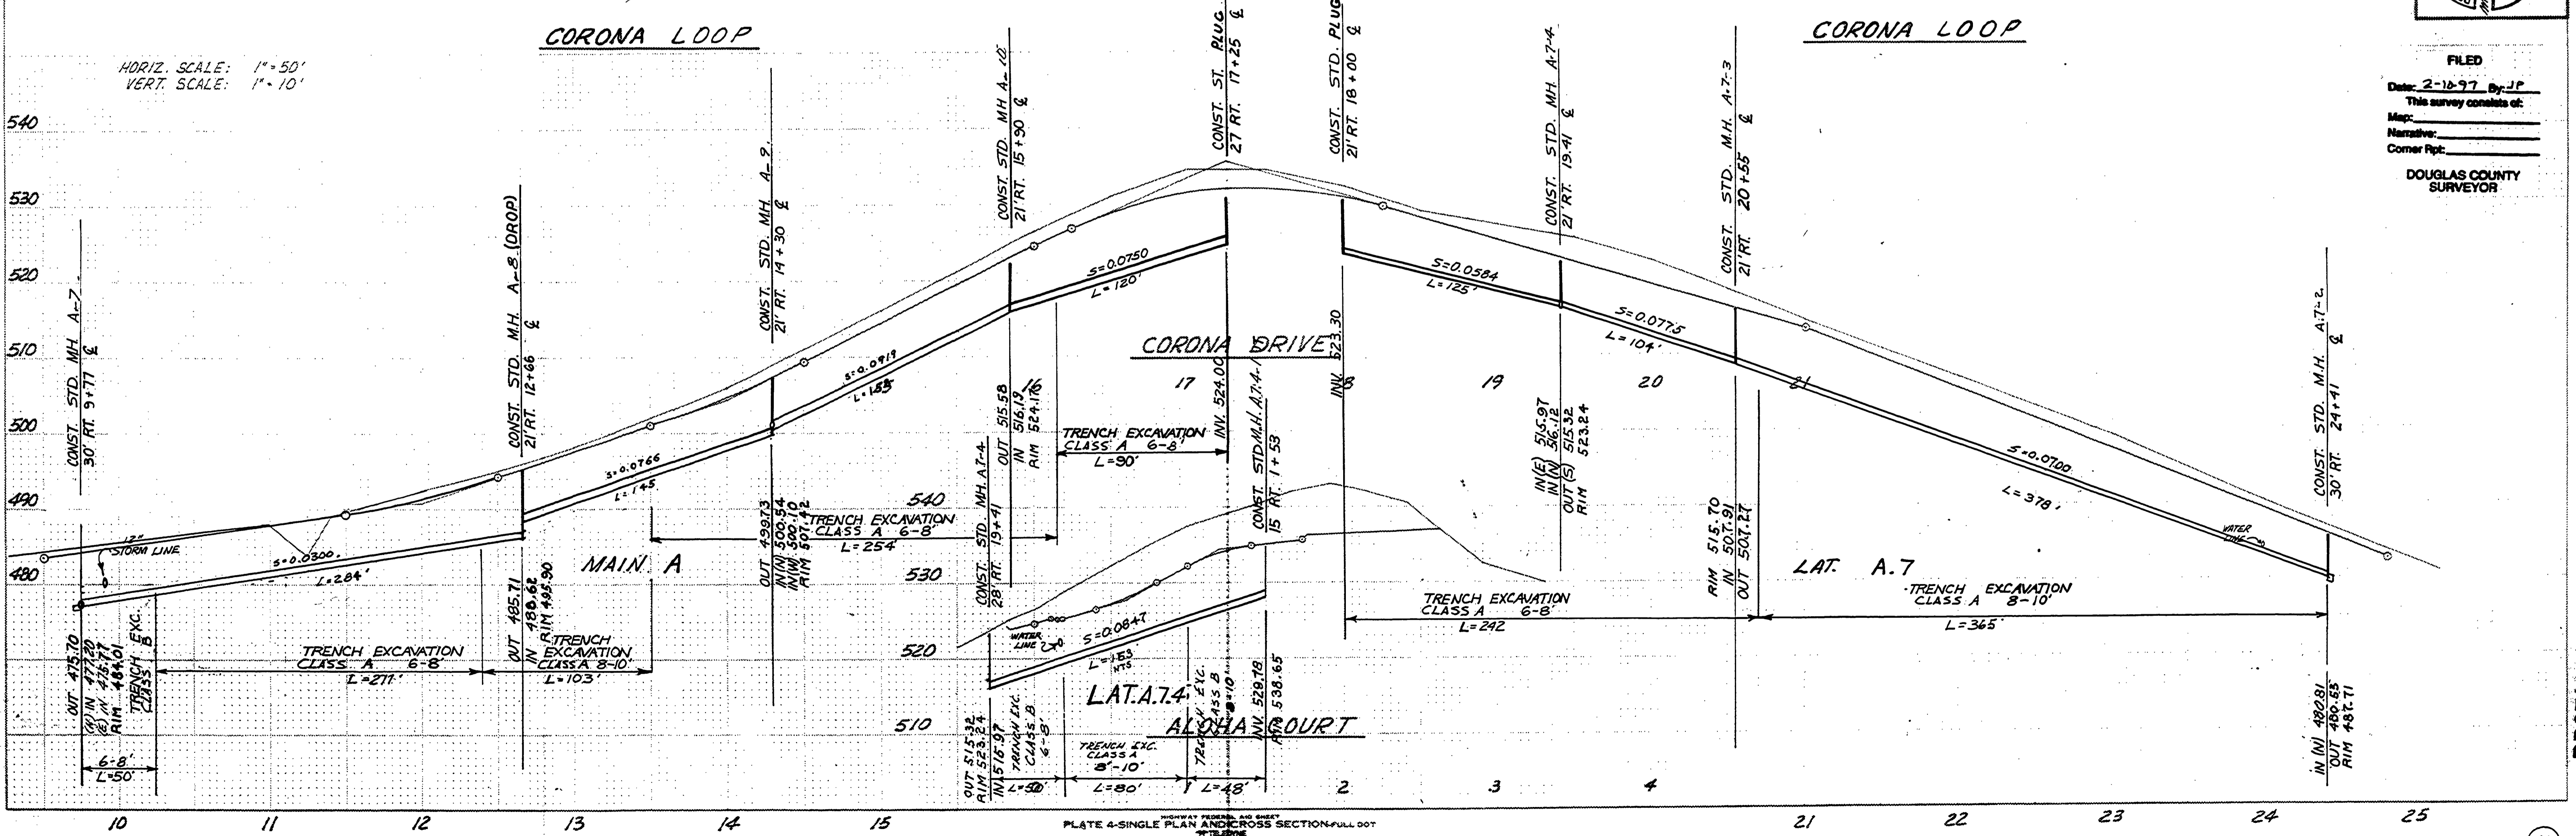


PLATE 4-SINGLE PLAN AND CROSS SECTION-FULL DOT
 PRINTED IN U.S.A.

5
 SHEET OF 10
 PROJ # 16-0300
 DATE JUNE '79
 SCALE: HORIZ. 1"=50'
 VERT. 1"=10'
 DWS 16-3

HOWARD BURDETTE
 SANTA MARIA ESTATES
 SANITARY SEWER & WATER

RECORD DWG
 NO. DATE REVISION BY/APPD.

DES. HOS. DR. M.D.P. CHK. M.L.T. APPD. M.L.T.

ALPHA AND OMEGA ENGINEERS

FILED
 Date: 2-16-97 By: JP
 This survey consists of:
 Map:
 Narrative:
 Corner Ppt:
 DOUGLAS COUNTY SURVEYOR

RD378007