


FILED
 Date: 2-10-97 By: J.P.
 This survey consists of:
 Map:
 Narrative:
 Corner Rpt:


DOUGLAS COUNTY
 SURVEYOR

SHEET OF 10	8
PROJECT #	16.0302
DATE AUG. 1979	
SCALE: HORIZ. 1"=50'	
VERT. 1"=10'	
DWG. NO.	16-3
BY	APFD
REVISION	
DR. MODY	CHK. MLT
APPD. MLT	

ALPHA AND OMEGA ENGINEERS



REGISTERED PROFESSIONAL ENGINEER
 STATE OF OREGON
 No. 21,342
 MARY L. MANNING

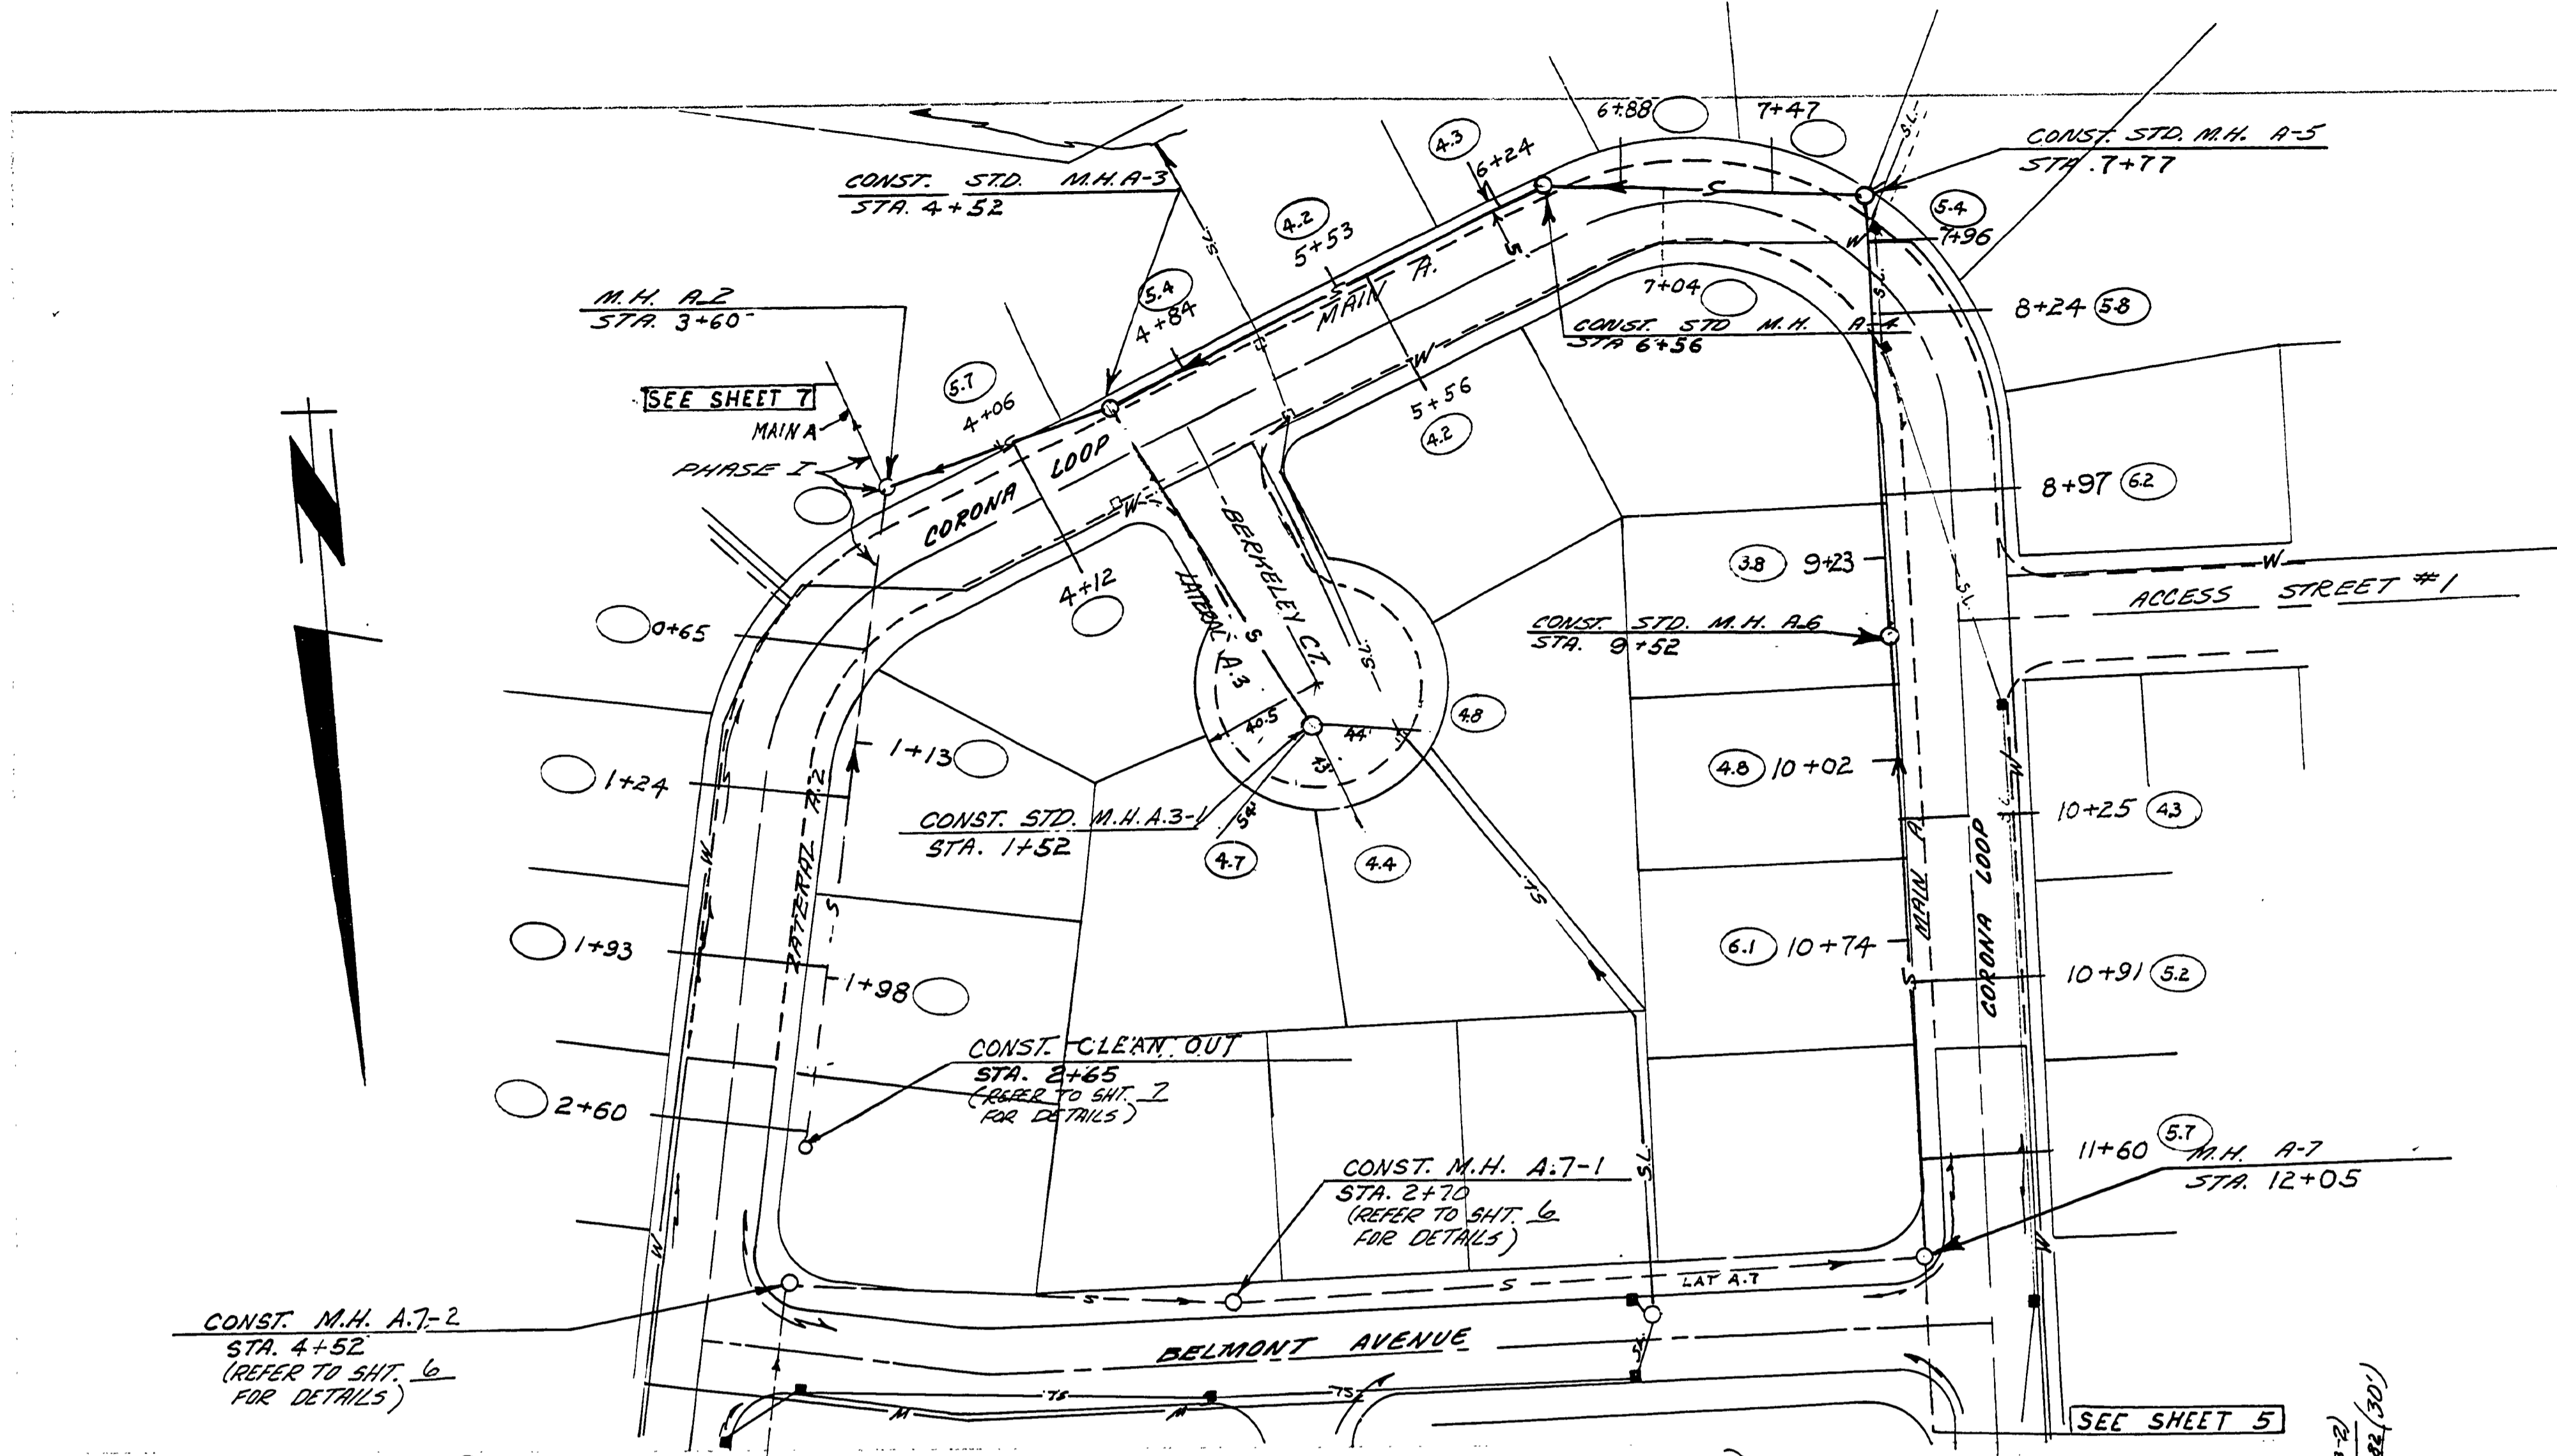

PLAN SCALE 1"=50'
 ○ SERVICE DEPTH - FT.

- NOTE:
1. CONSTRUCTION SHALL NOT COMMENCE UNTIL APPROVALS FROM GREEN SANITARY AND D.E.C. ARE RECEIVED.
 2. ALL WORK AND MATERIALS MUST CONFORM TO THE GREEN SANITARY STANDARDS AND SPECIFICATIONS. THIS SHEET SHALL BE PART OF THE FINAL 'RECORD DRAWINGS' SUBMITTED ON PHASE I OF THE SANTA MARIA ESTATES.
 3. SEE PHASE II, SHEET 2 FOR STORM LINE SHOWN THIS PAGE ON CORONA DRIVE.

