


AS-CONSTRUCTED 9-10-79
 KERMANSHAH ADDITION DOUGLAS CO, OREGON

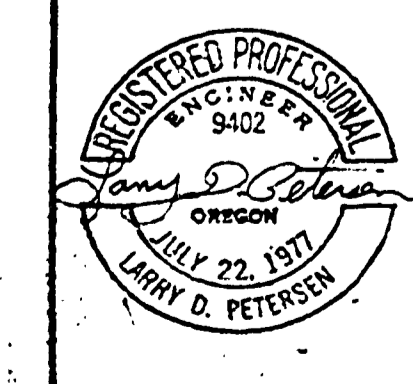

WATER LINE PLAN		
SUBDIVIDER: GARDNER AND ROSBACH		
SCALE: 1" = 60'	DATE: SEPTEMBER 1978	JOB NO. E-78-16
SURVEY:	BARNES SURVEYING & ENGINEERING, INC.	
DESIGN: L.D.P.	2565 STATE ST.	
DRAWN BY: J.M.P.	SALEM, OREGON 97301	
CHECKED: L.D.P.	SHEET	8
	OF 11	

M.P. 0.00-0.26 #381 1980

00000023