




BARNES SURVEYING & ENGINEERING, INC. SALEM, OREGON

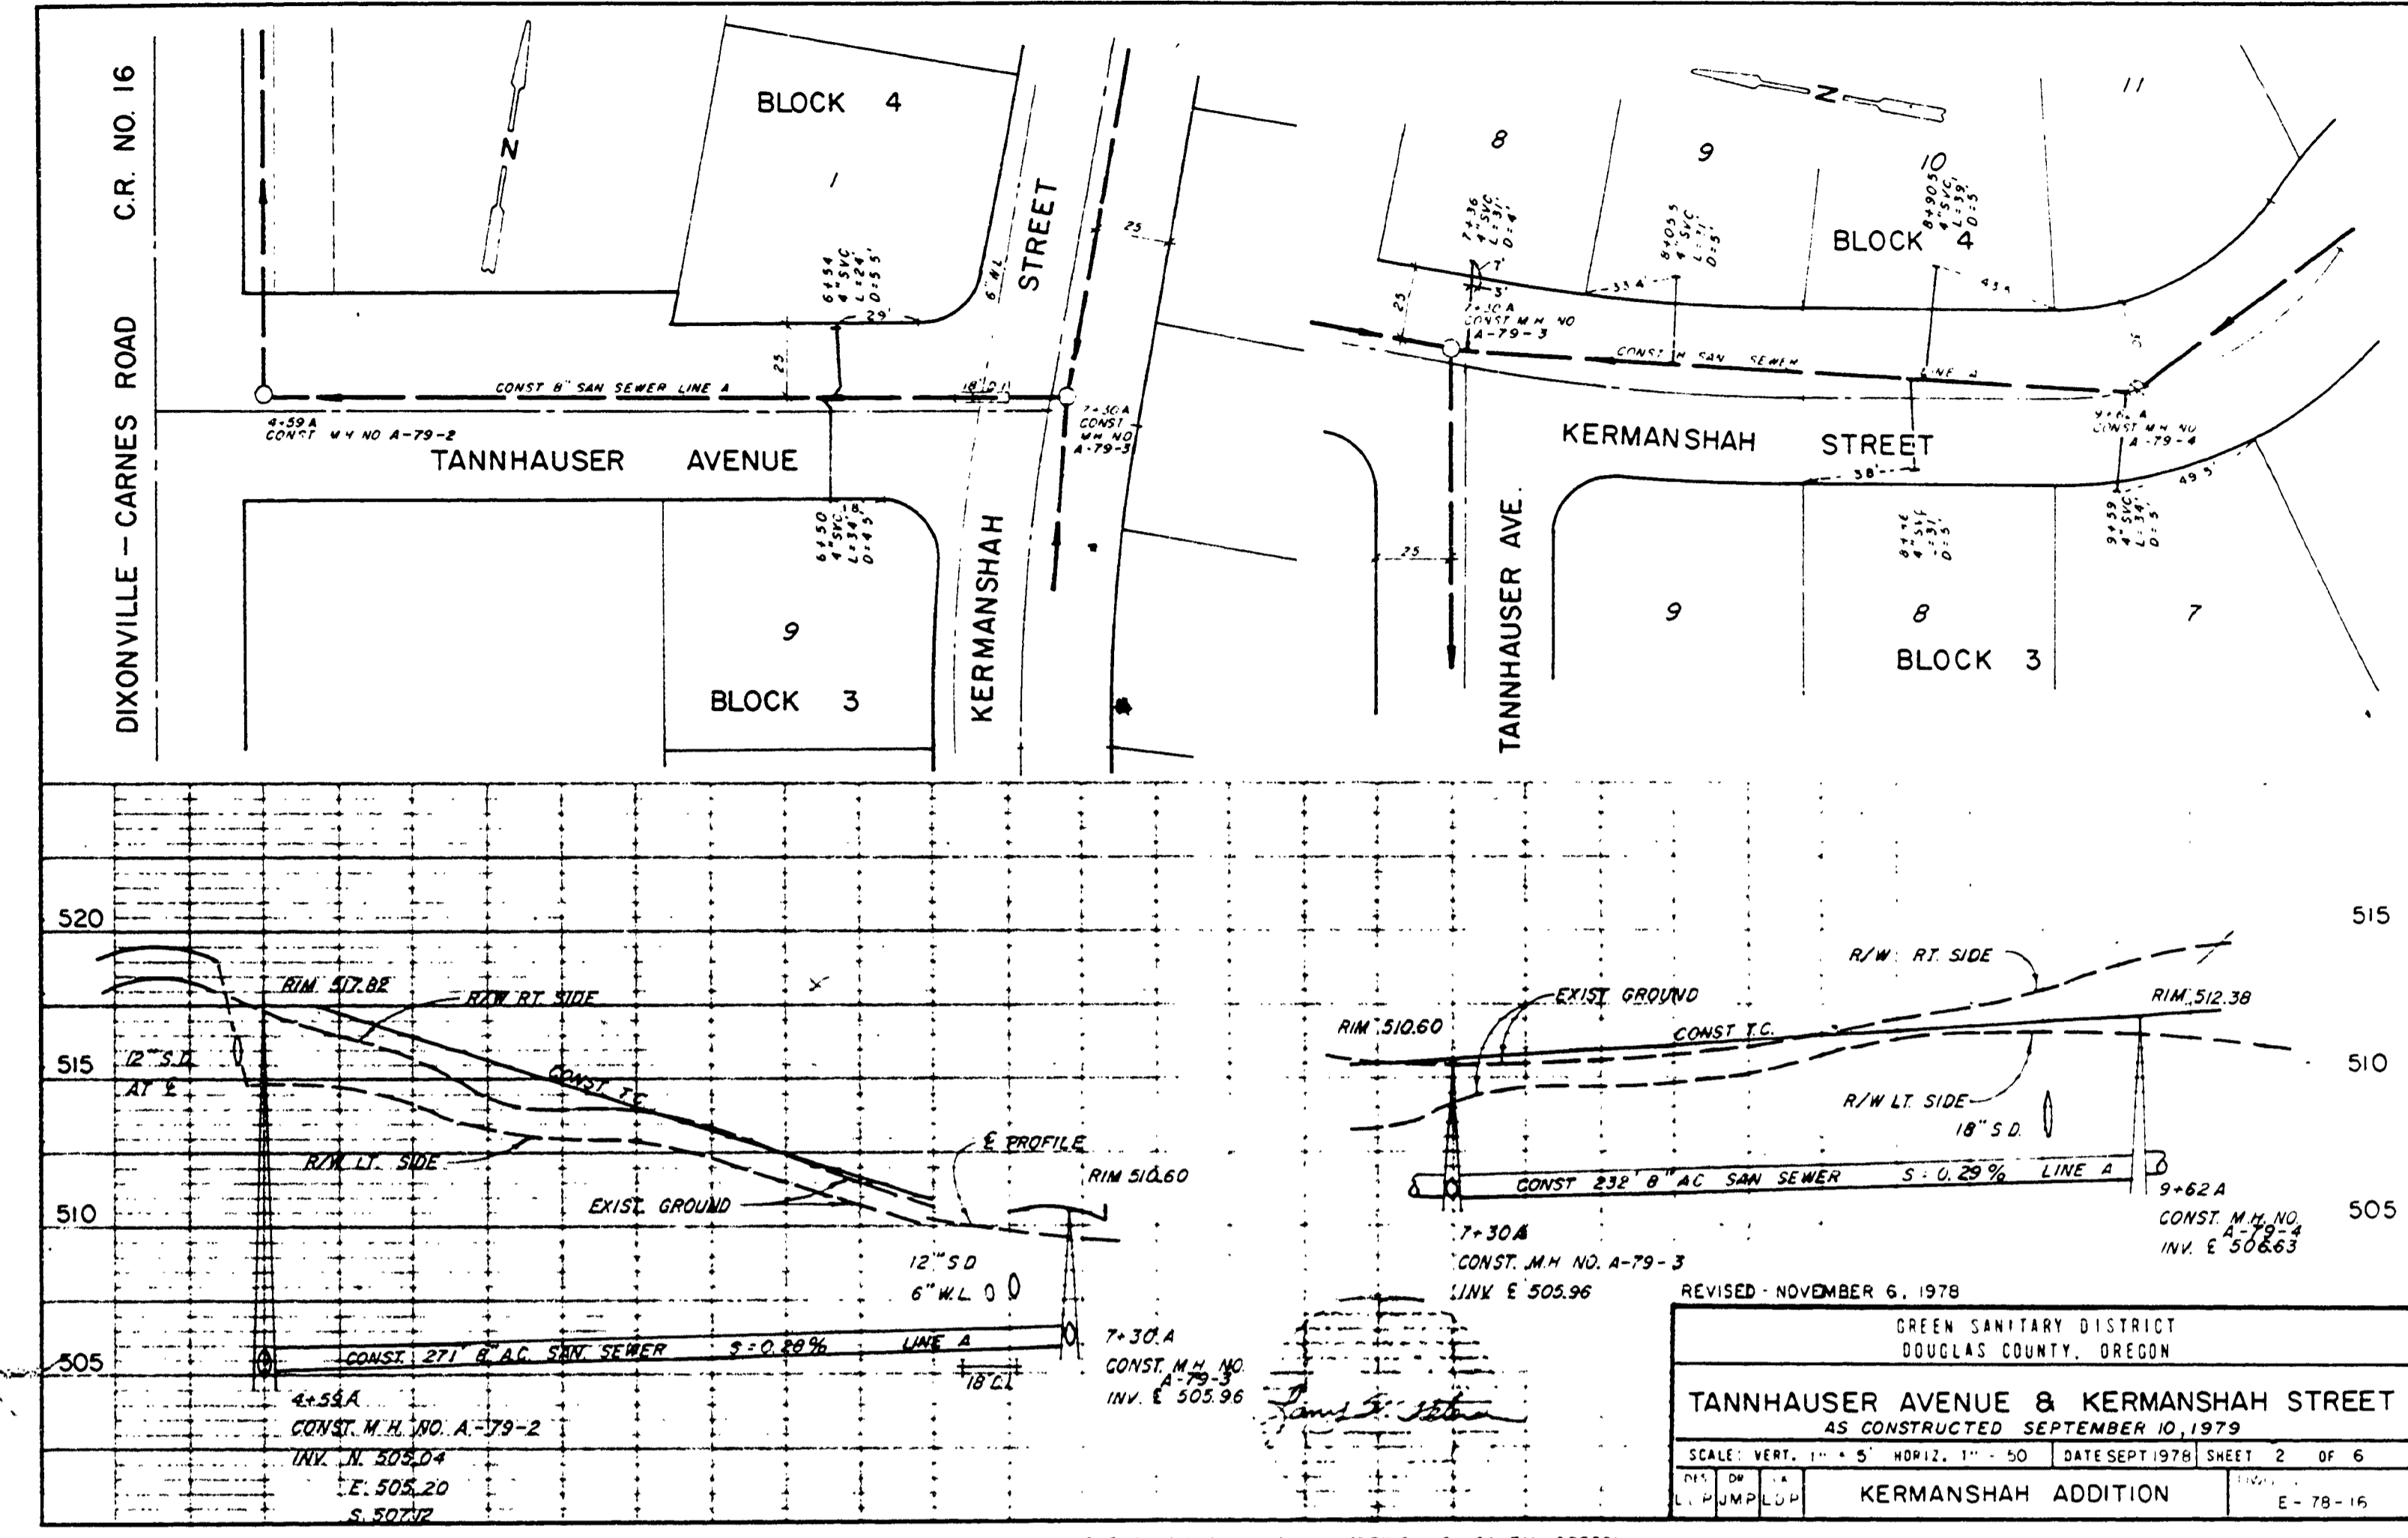

BARNES SURVEYING & ENGINEERING, INC. SALEM, OREGON

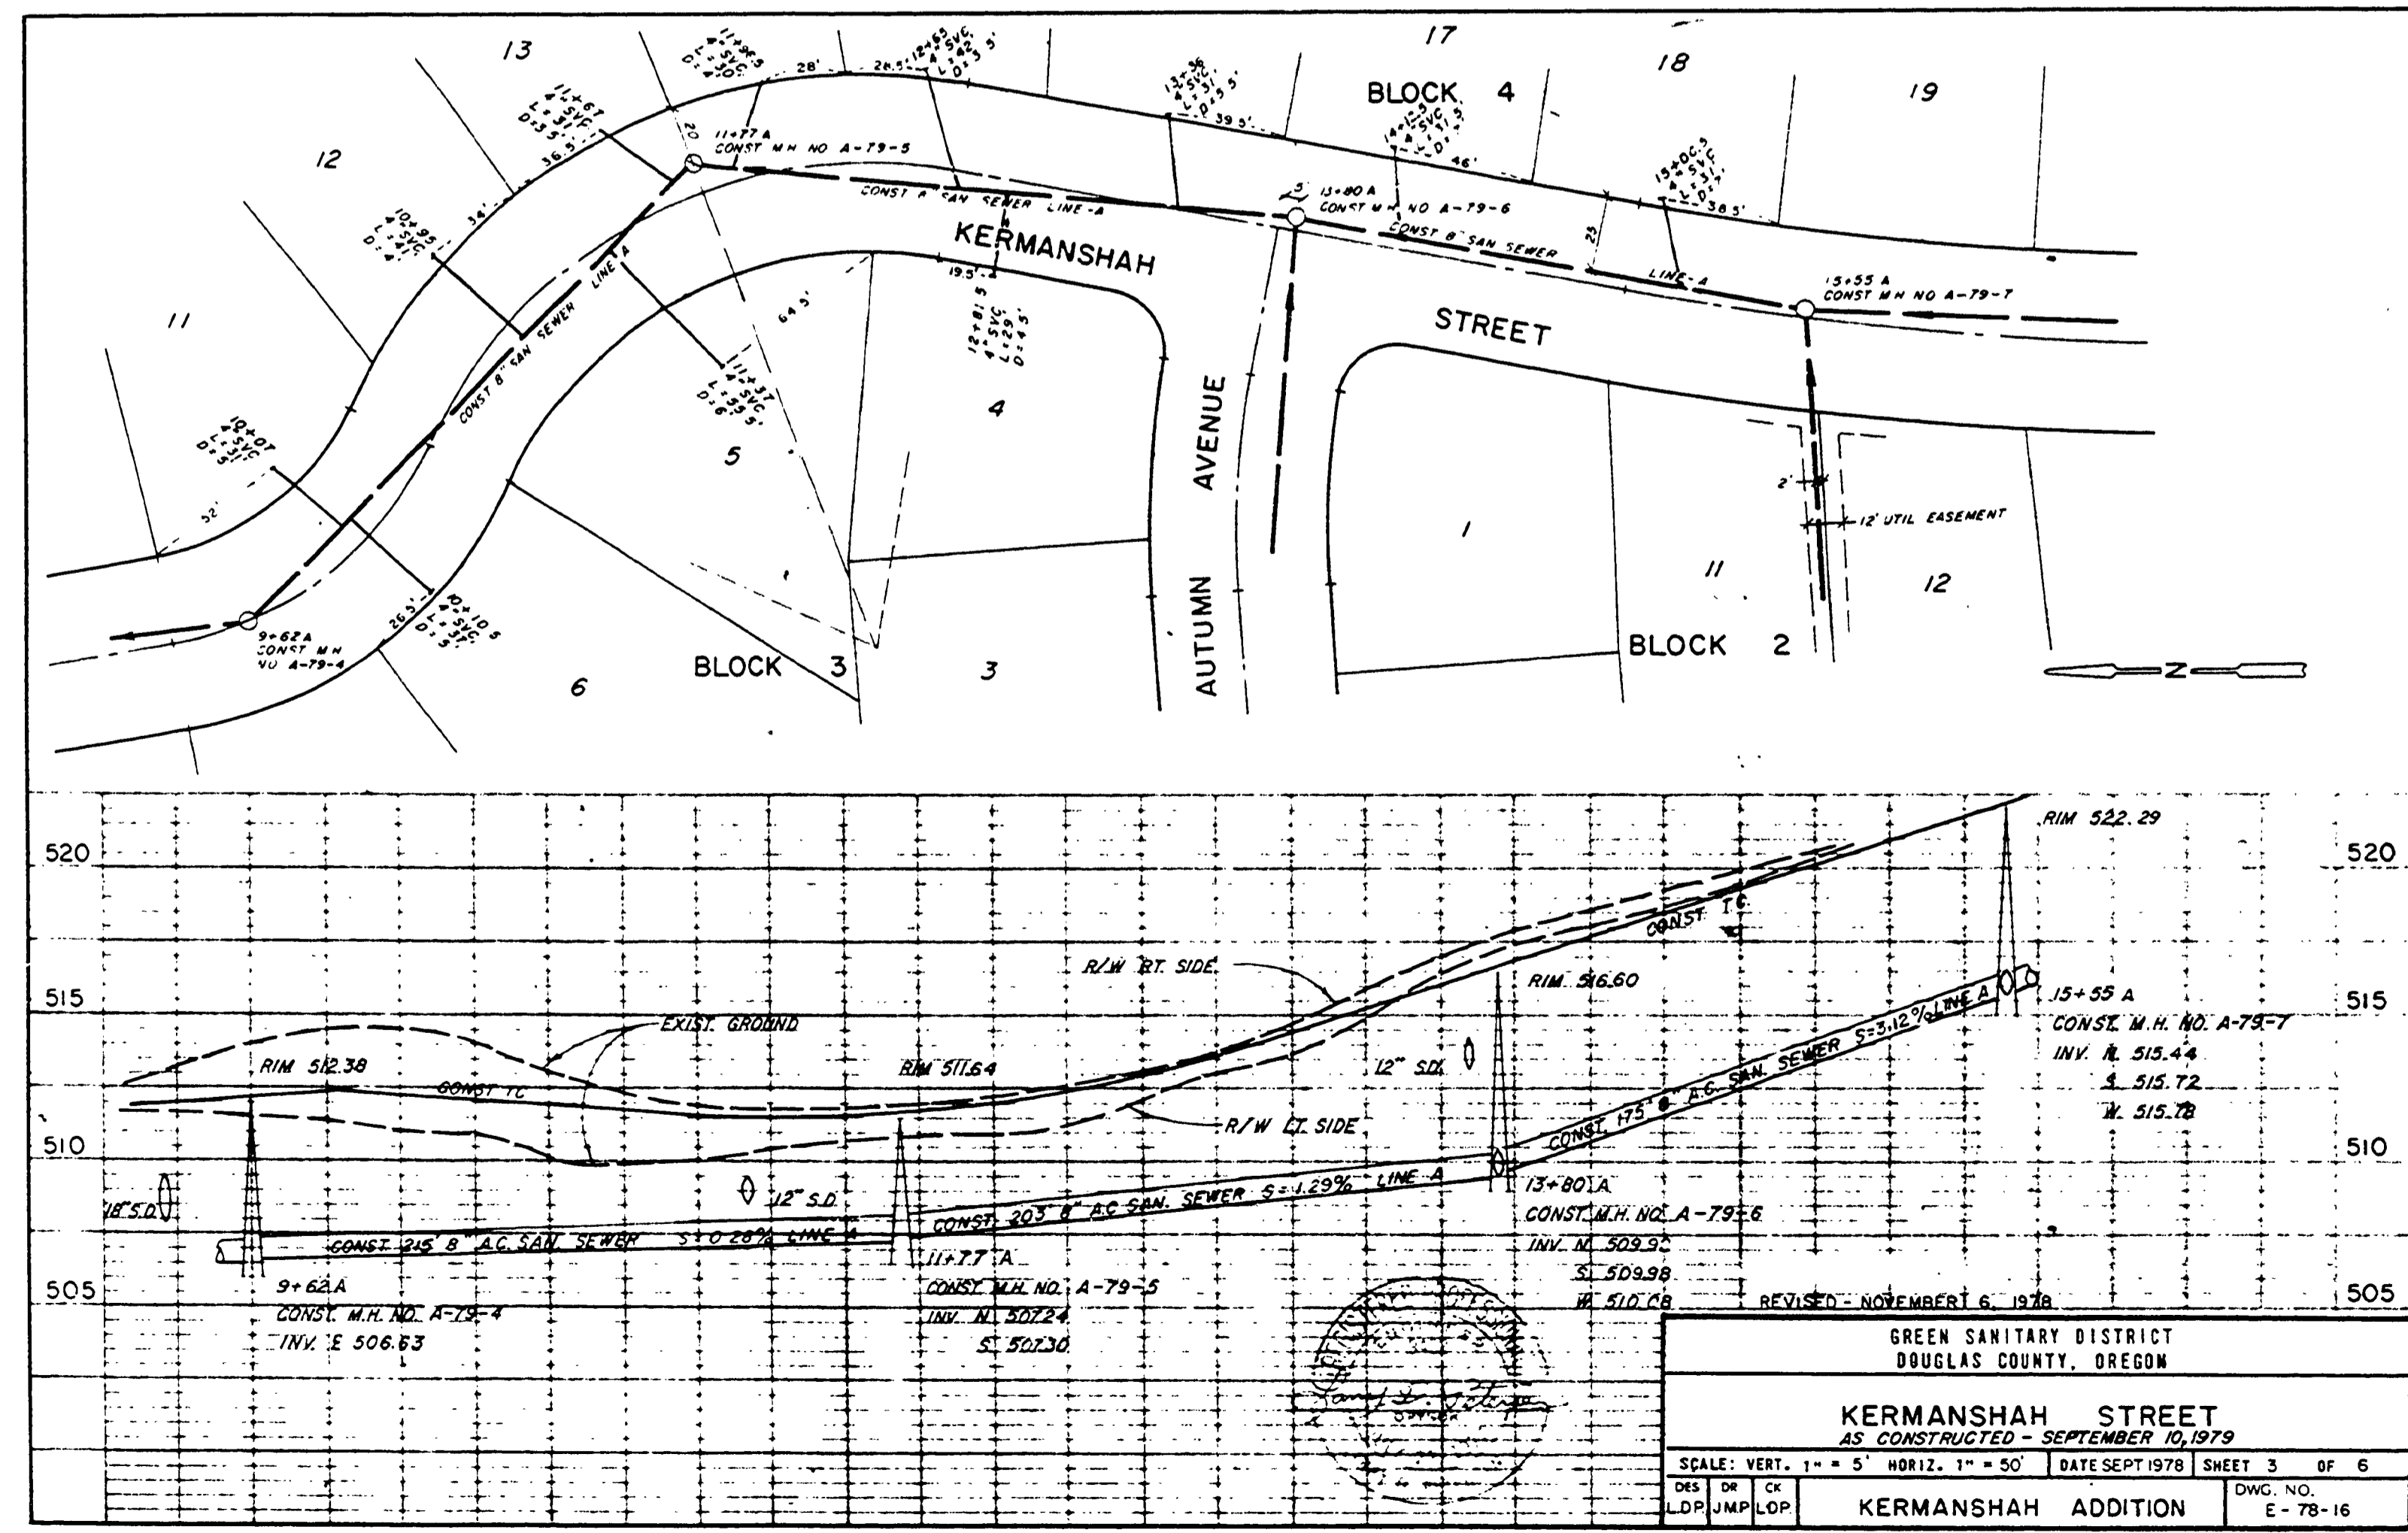

BARNES SURVEYING & ENGINEERING, INC. SALEM, OREGON

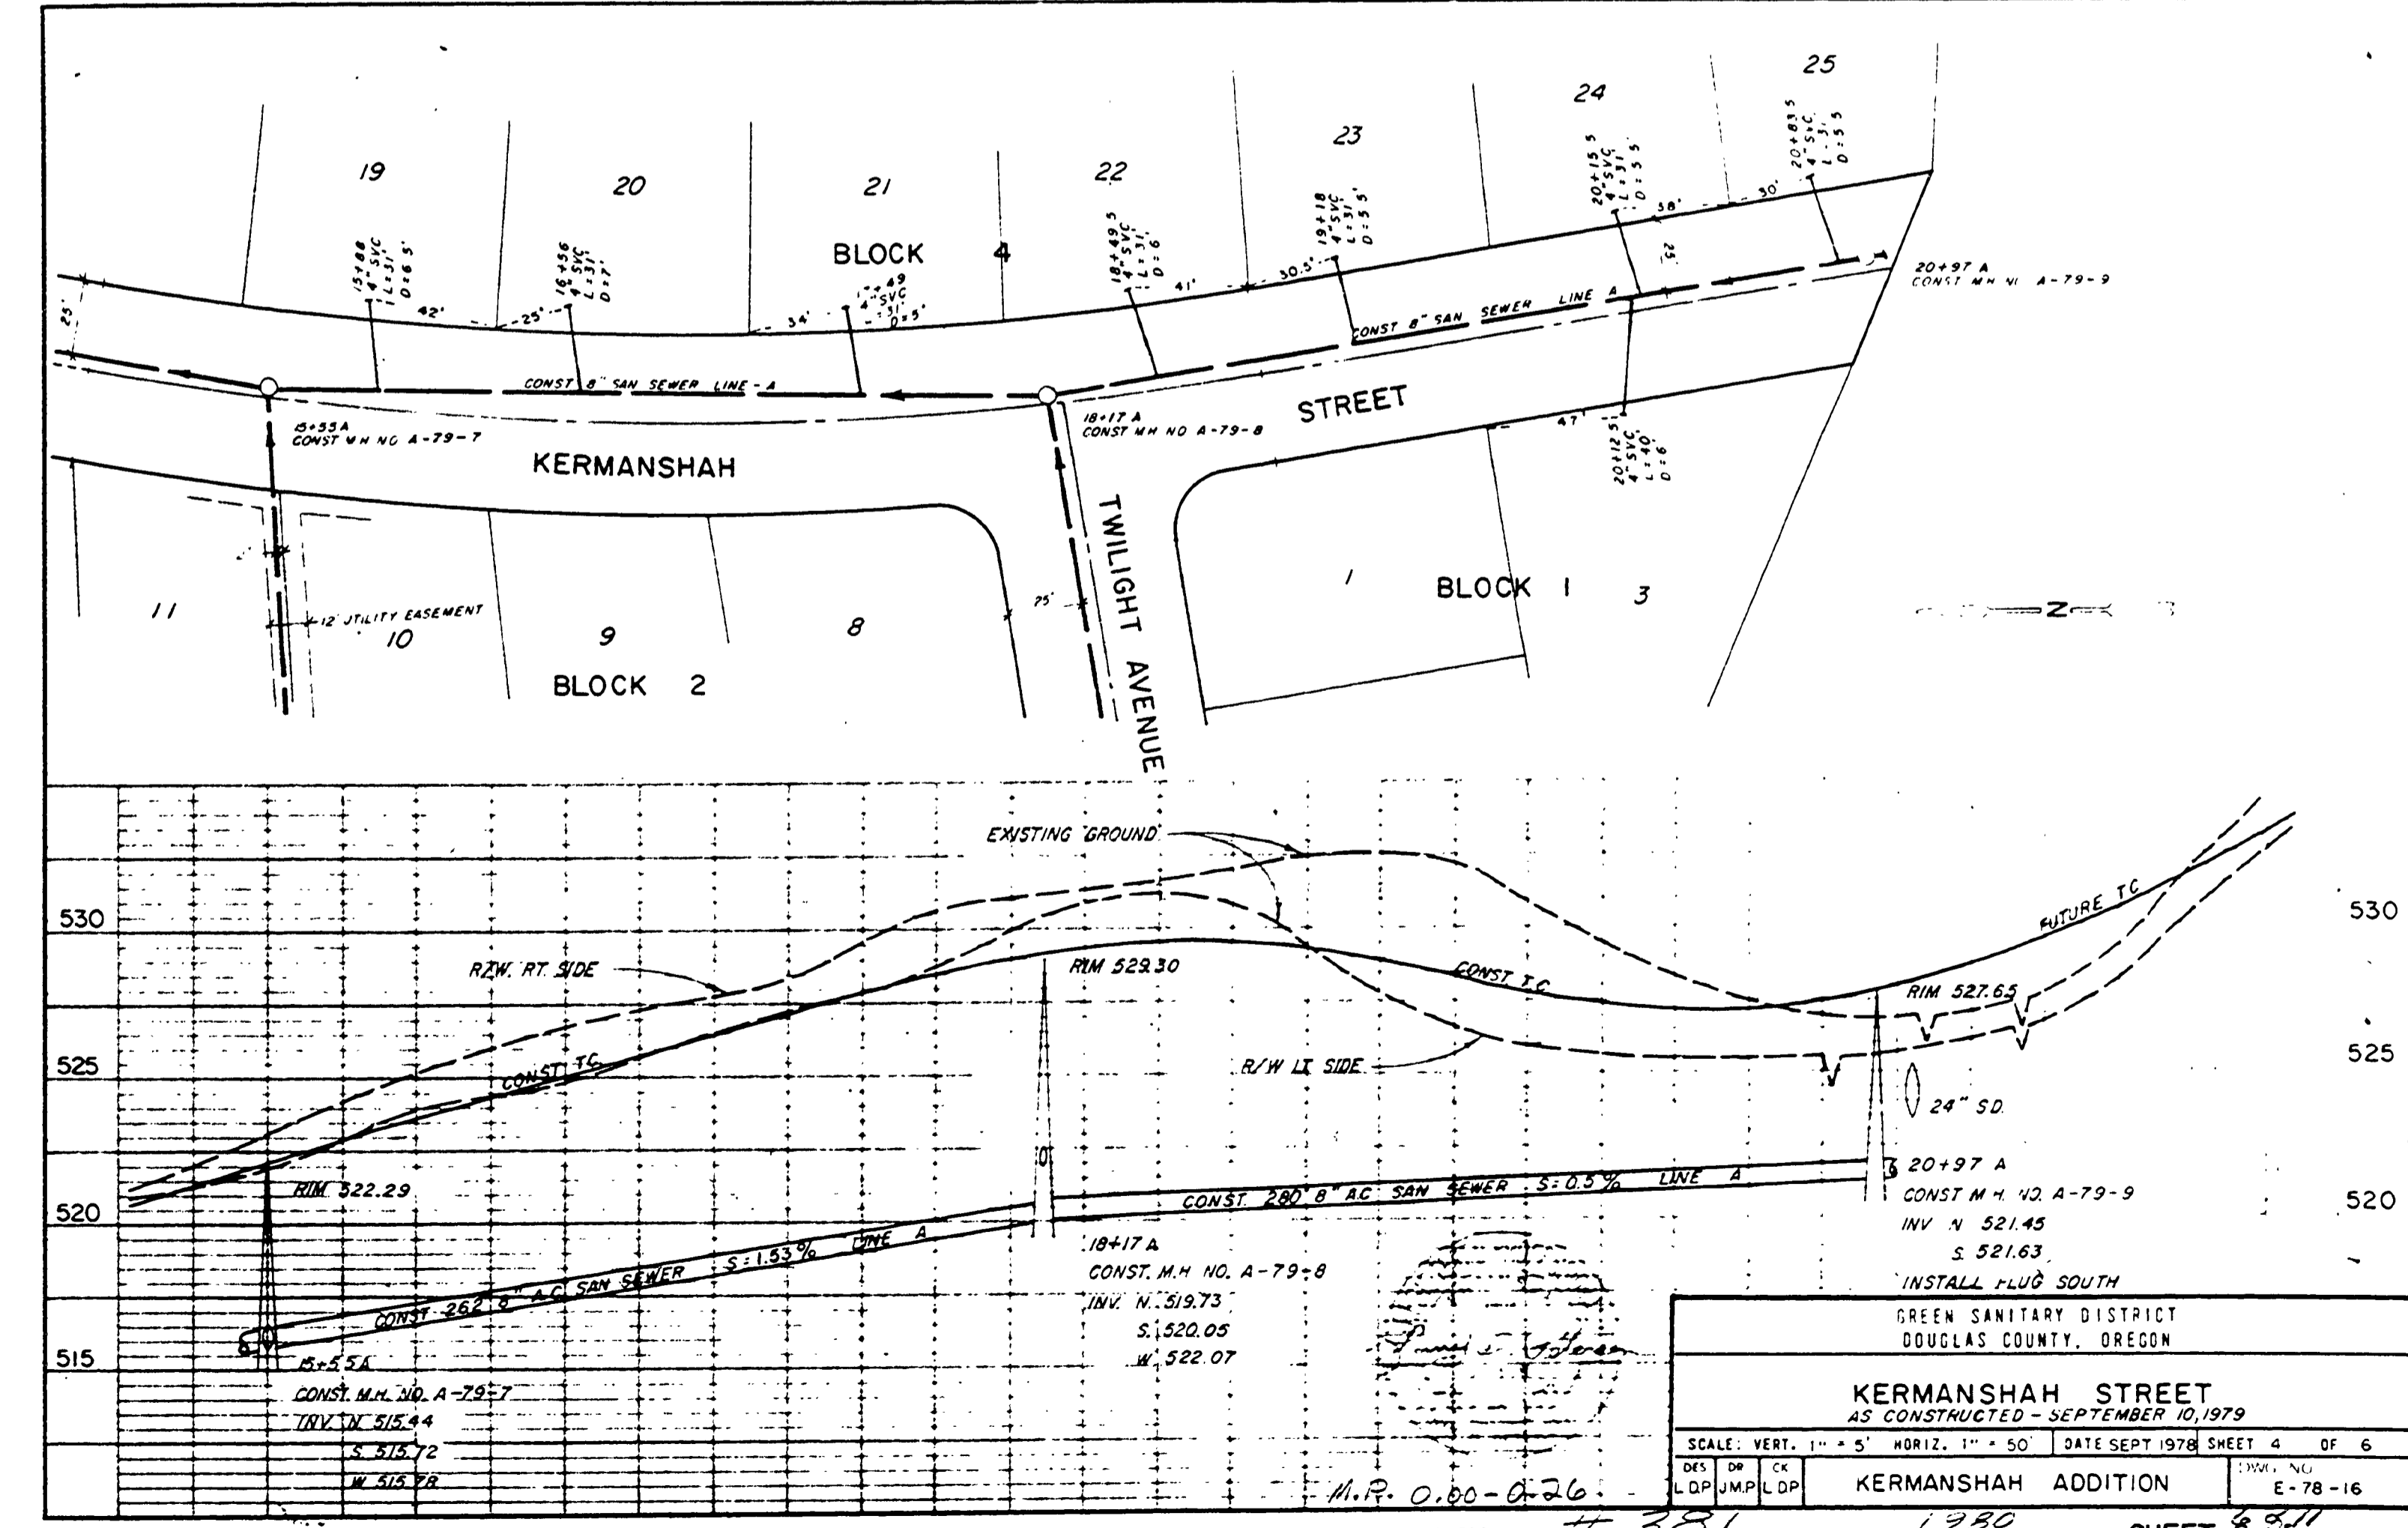

BARNES SURVEYING & ENGINEERING, INC. SALEM, OREGON

00000025

14