
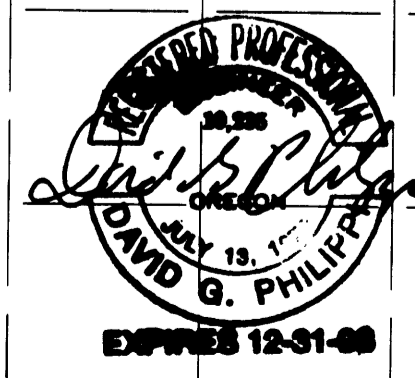


FILED

Date: 7-28-1999 By: JF
This survey consists of: 13 sheets
Map:
Narrative:
Corner Pkt:

DOUGLAS COUNTY
SURVEYOR

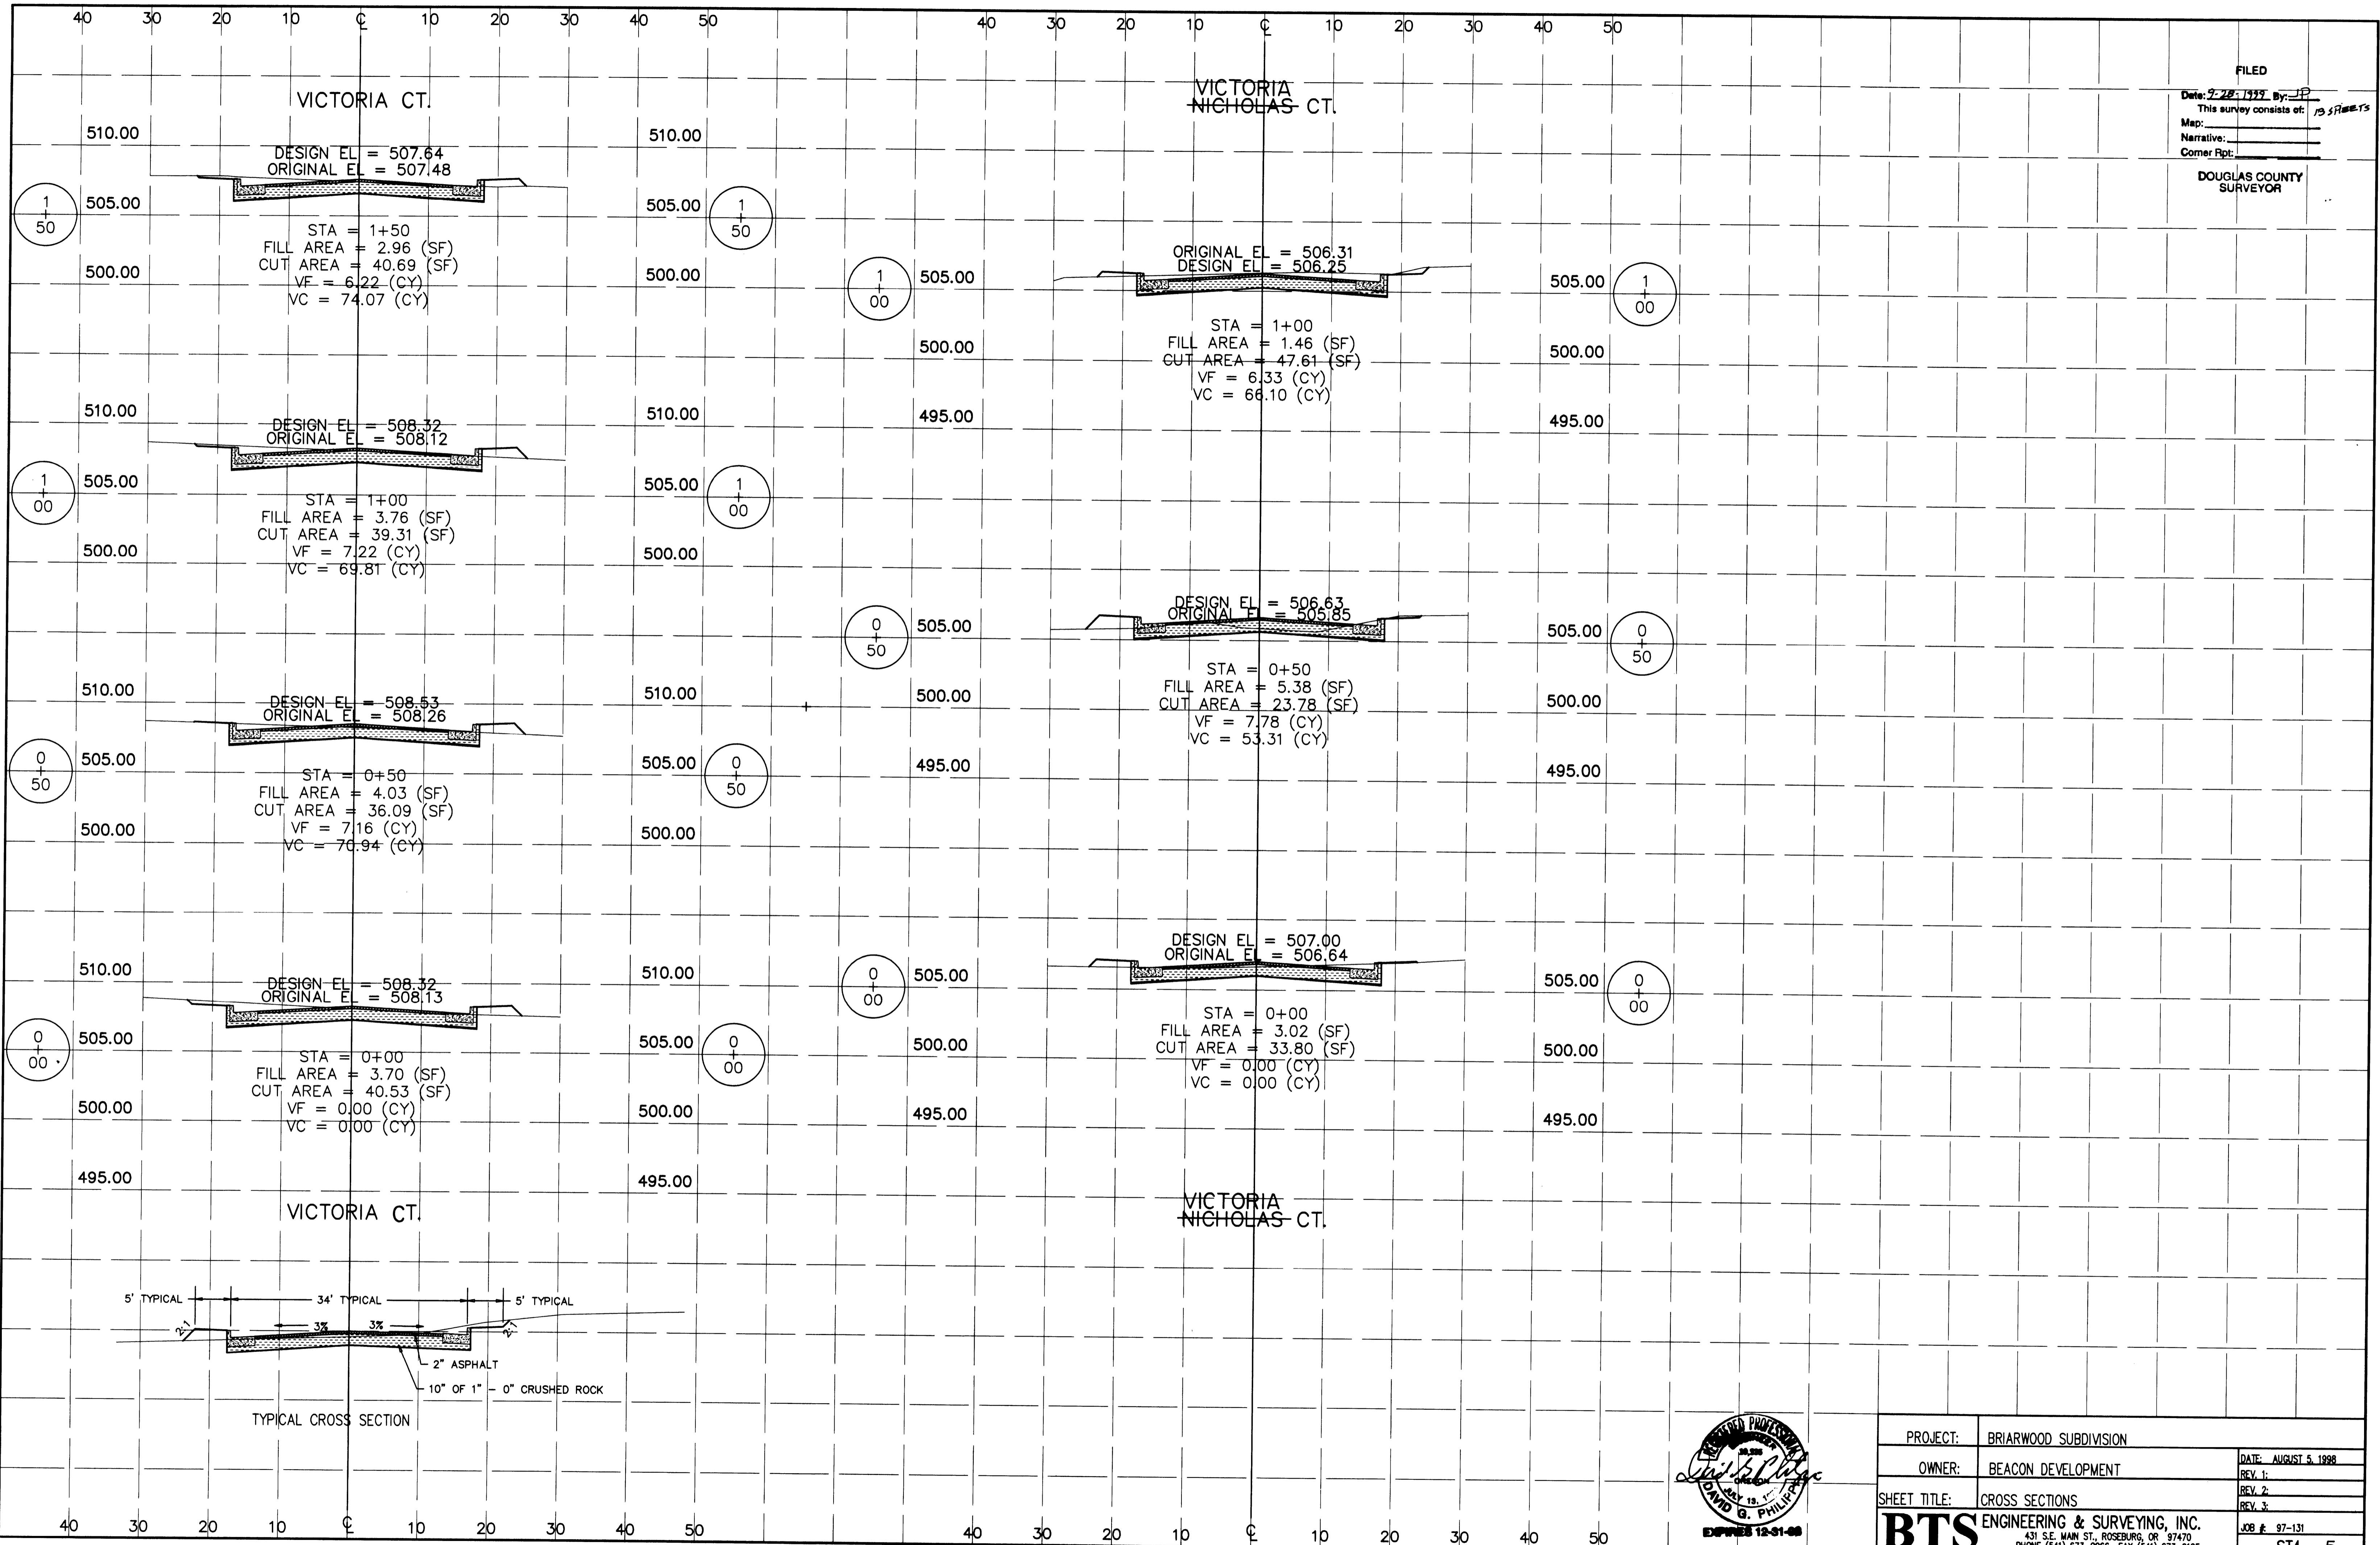

PROJECT:	BRIARWOOD SUBDIVISION	DATE:	AUGUST 5, 1998
OWNER:	BEACON DEVELOPMENT	REV. 1:	
SHEET TITLE:	CROSS SECTIONS	REV. 2:	
BTS ENGINEERING & SURVEYING, INC.		REV. 3:	
431 S.E. MAIN ST., ROSEBURG, OR 97470		JOB #:	97-131
PHONE (541) 673-0966 FAX (541) 673-0105		SHEET:	ST4 OF 5

CO. RD. # 381D
SHEET 5 OF 13

XSECT200

106