




TANHAUSER AVE. SEWERLINE

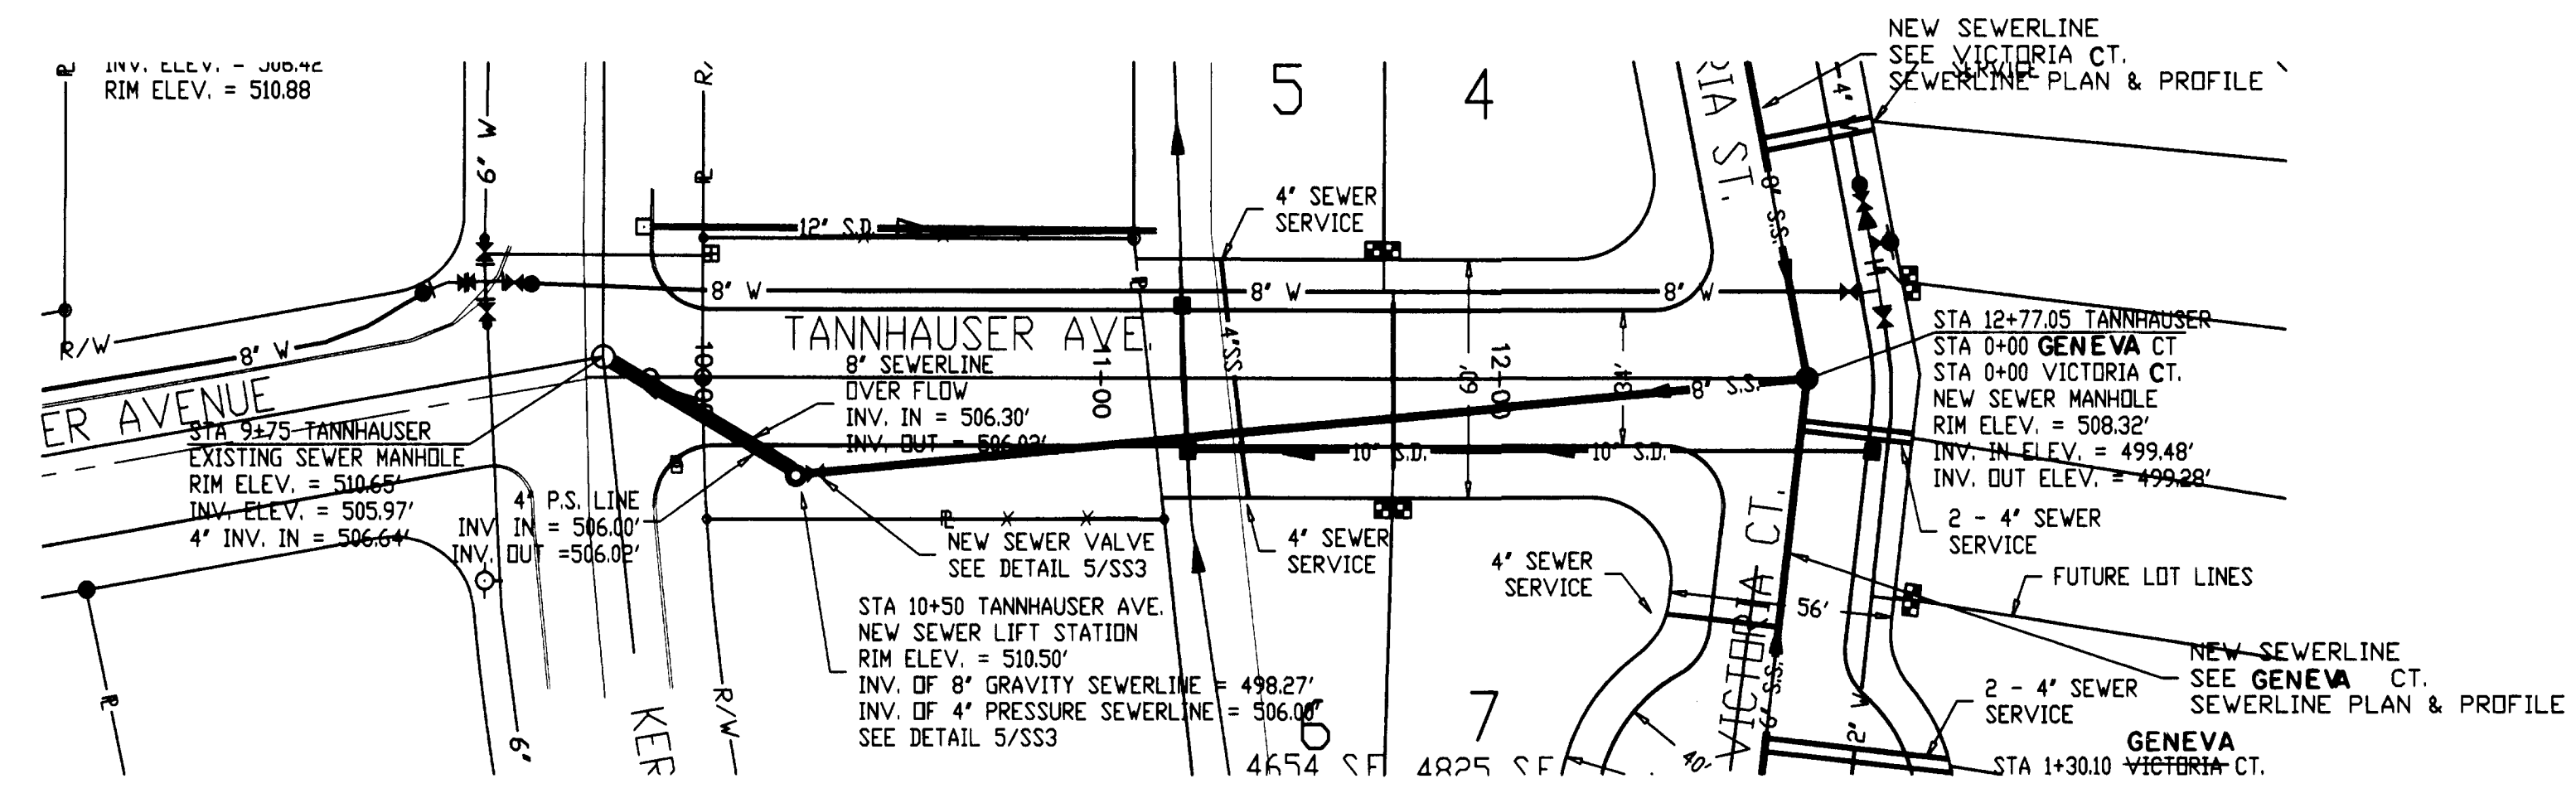

SCALES:
1" = 40' HOR
1" = 5' VER

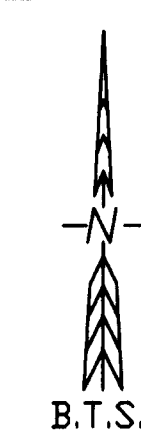


GENEVA VICTORIA CT. SEWERLINE

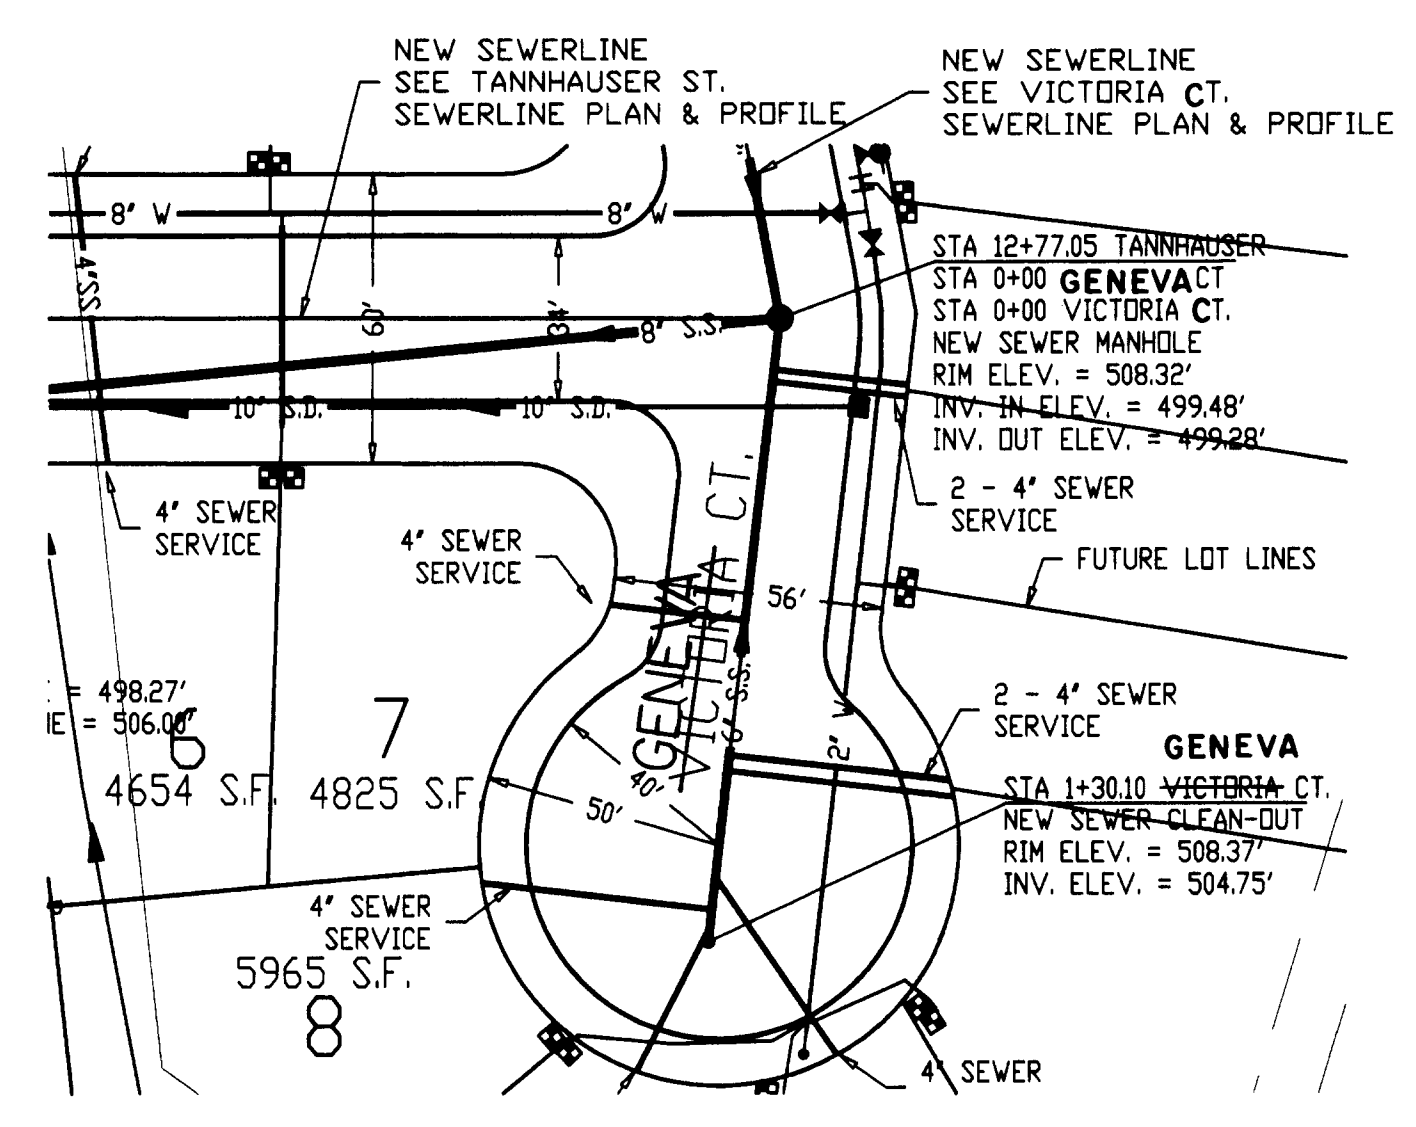

SCALES:
1" = 40' HOR
1" = 5' VER



VICTORIA CT. SEWERLINE

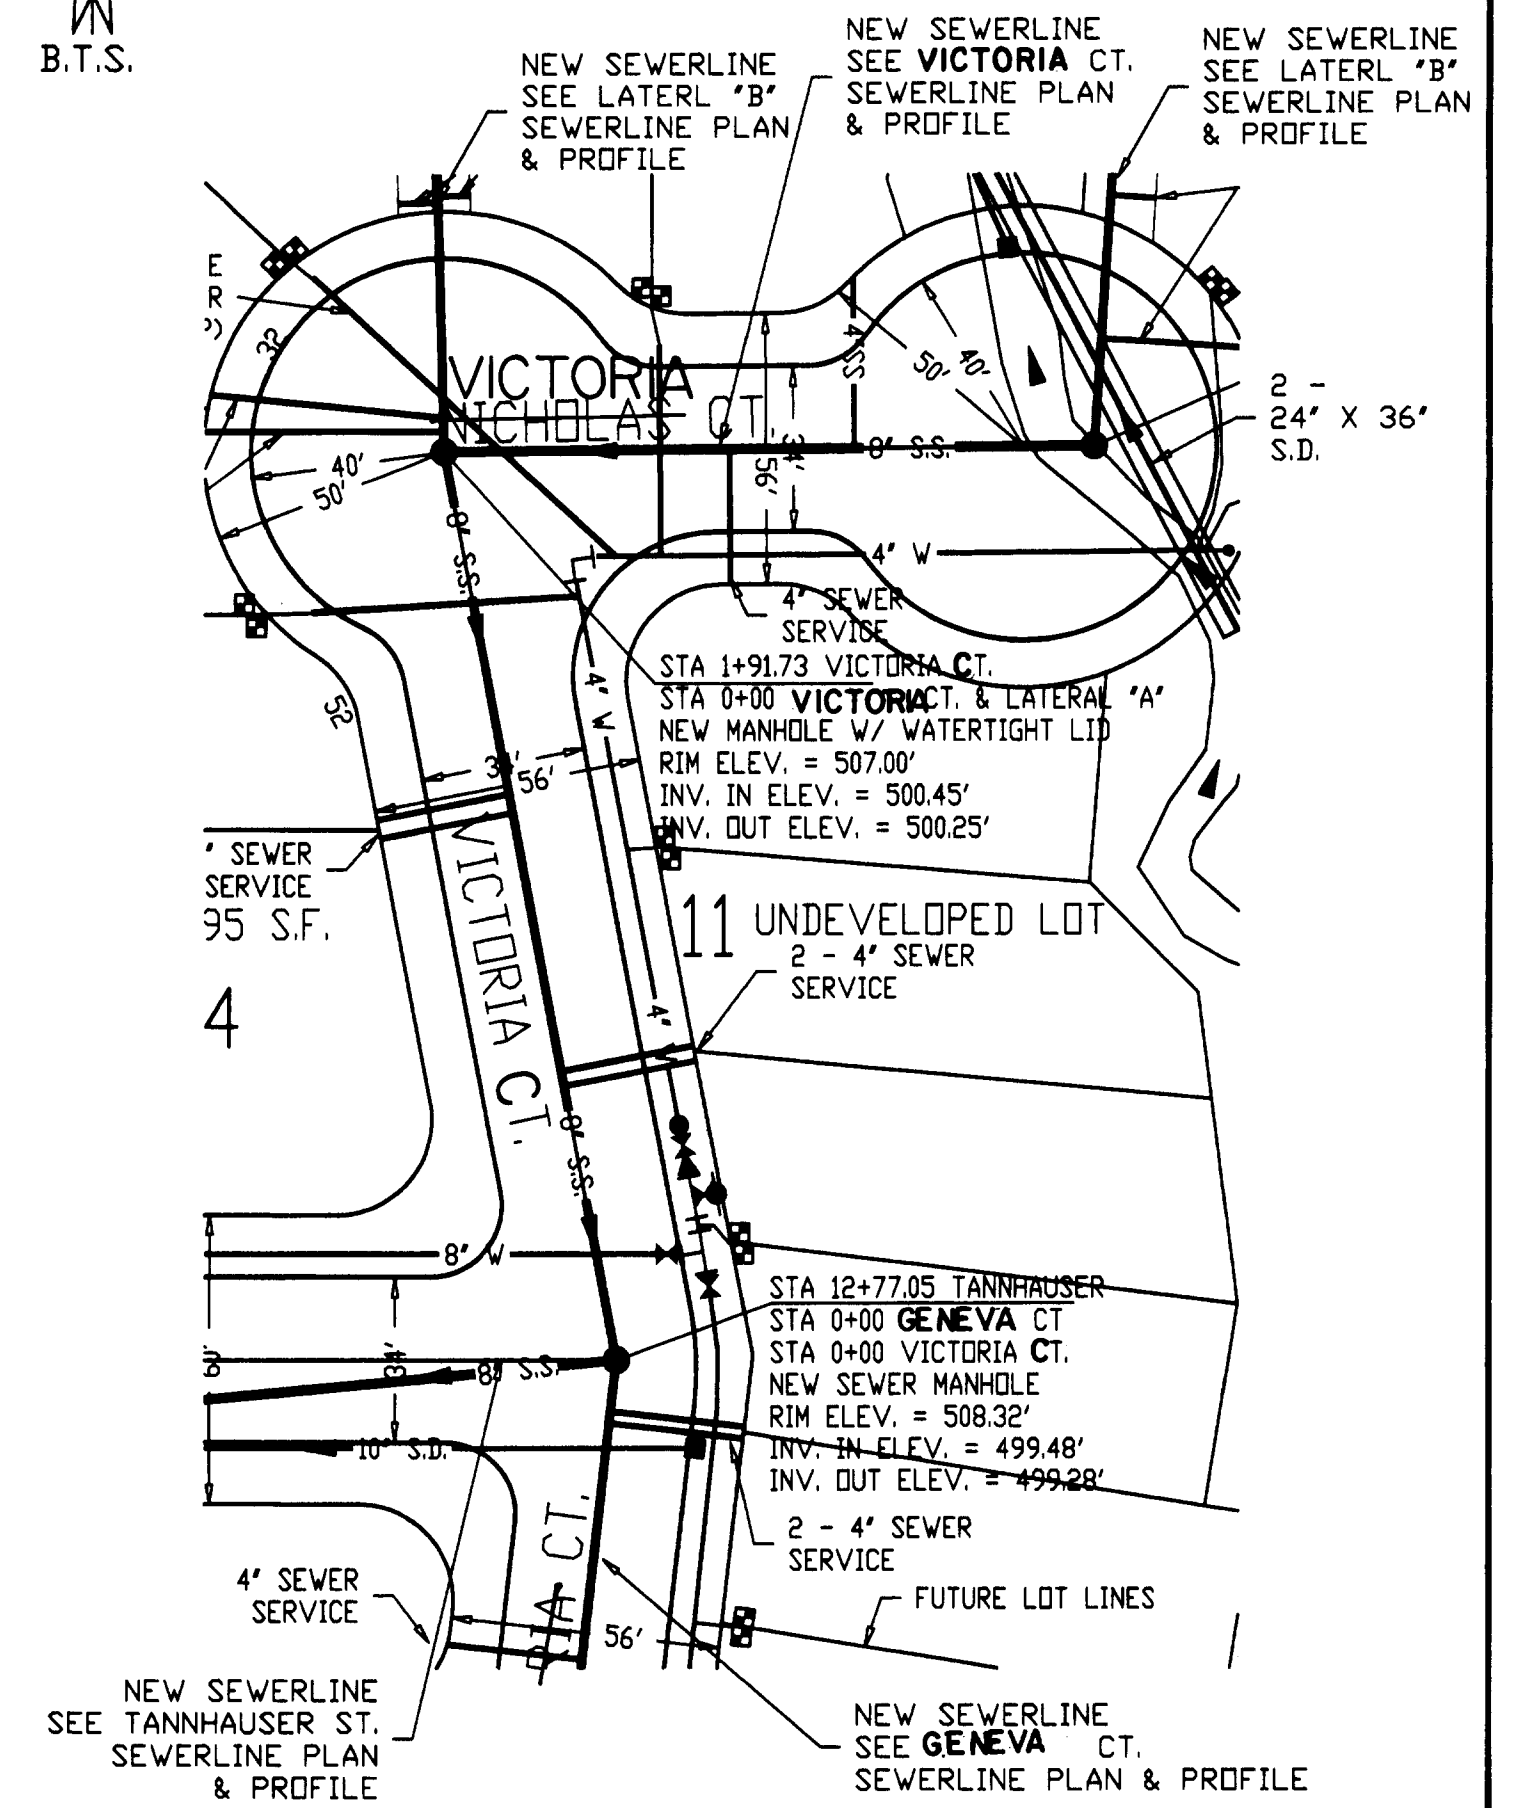


SCALES:
1" = 40' HOR
1" = 5' VER


FILED
Date: 2-29-1998 By: J.P.
This survey consists of: 13 sheets
Map: _____
Narrative: _____
Corner Rpt: _____

DOUGLAS COUNTY SURVEYOR


TANHAUSER AVE. SEWERLINE

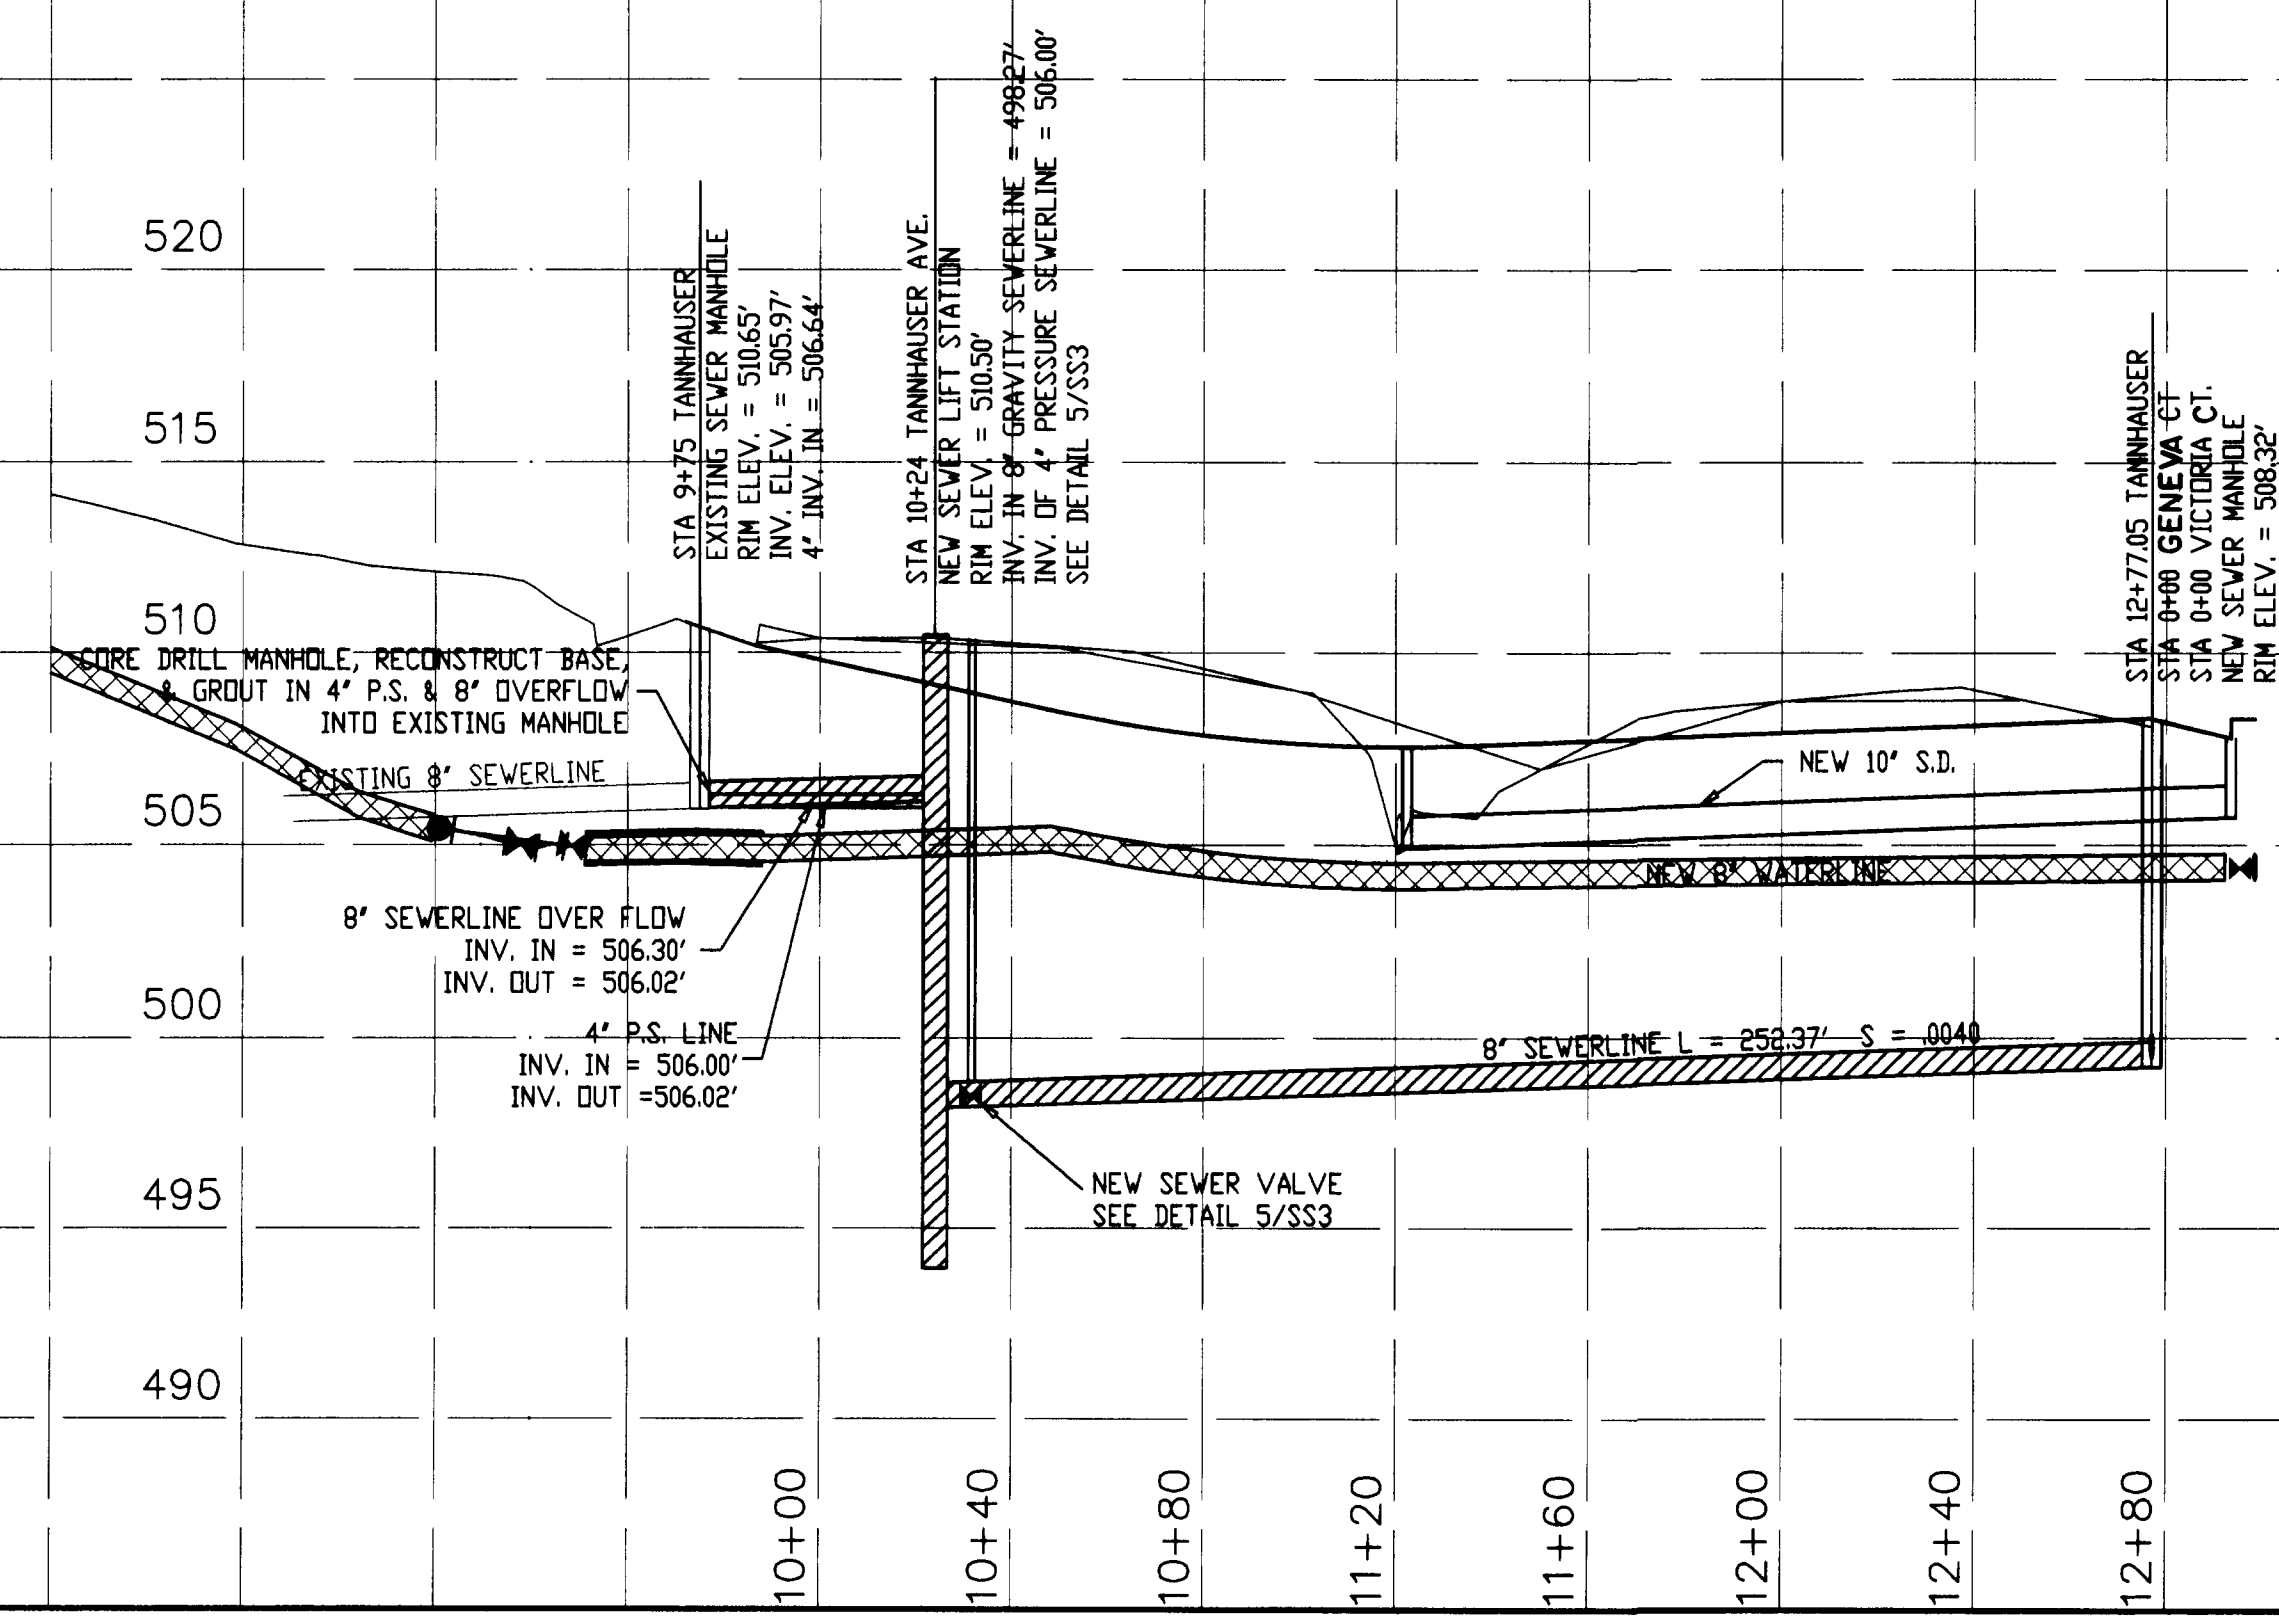

GENEVA VICTORIA CT. SEWERLINE

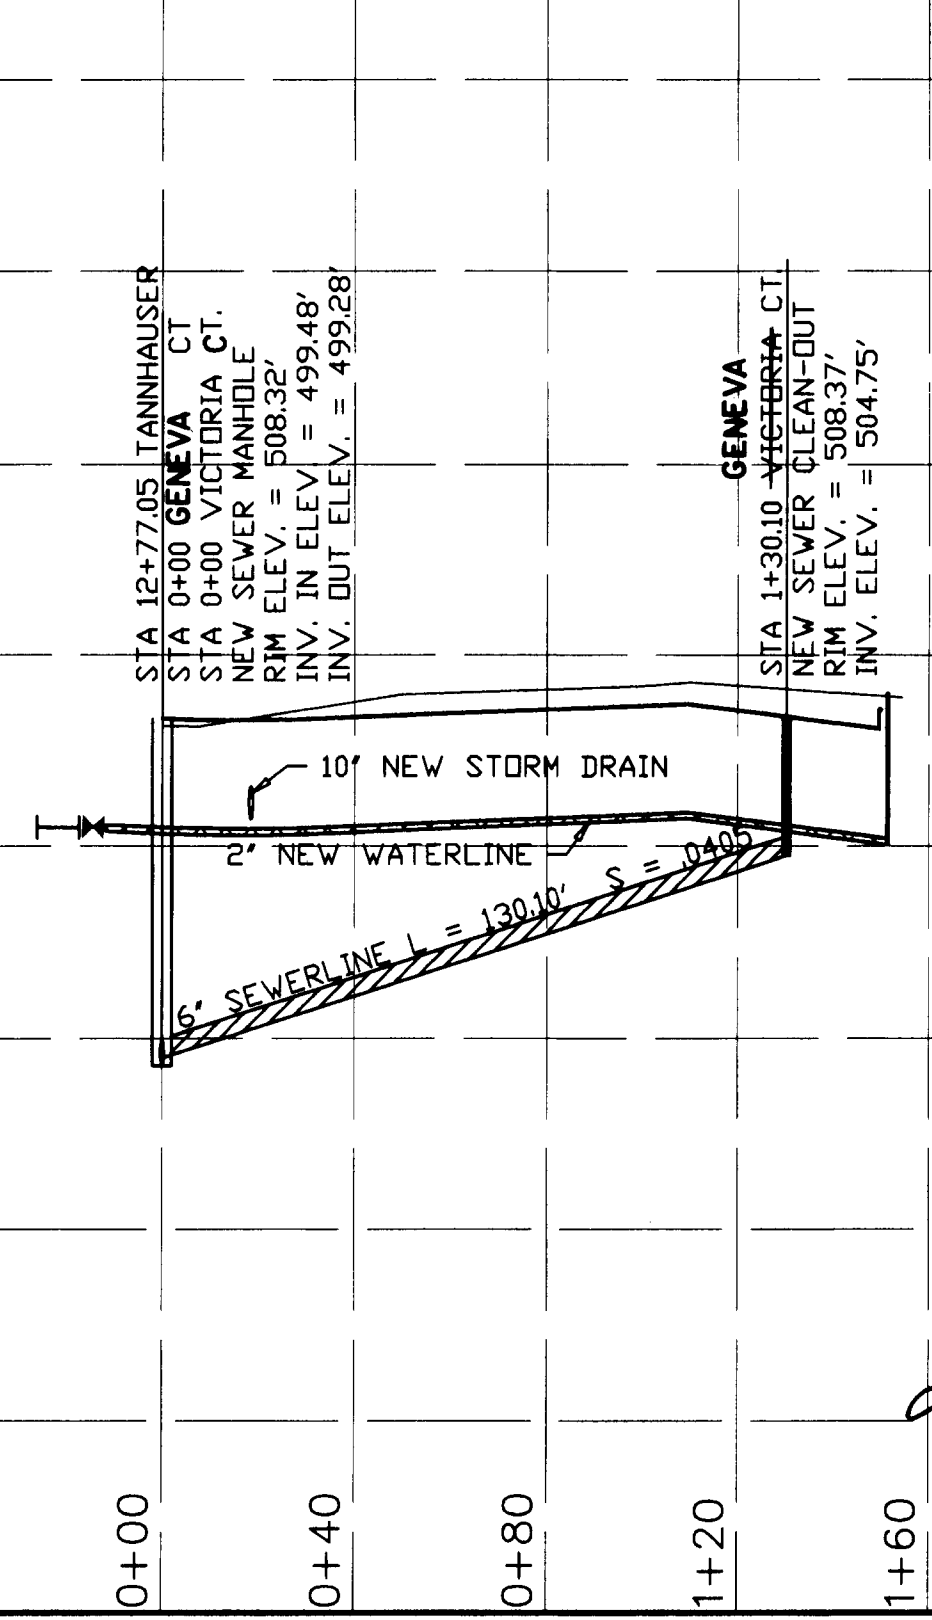

VICTORIA CT. SEWERLINE

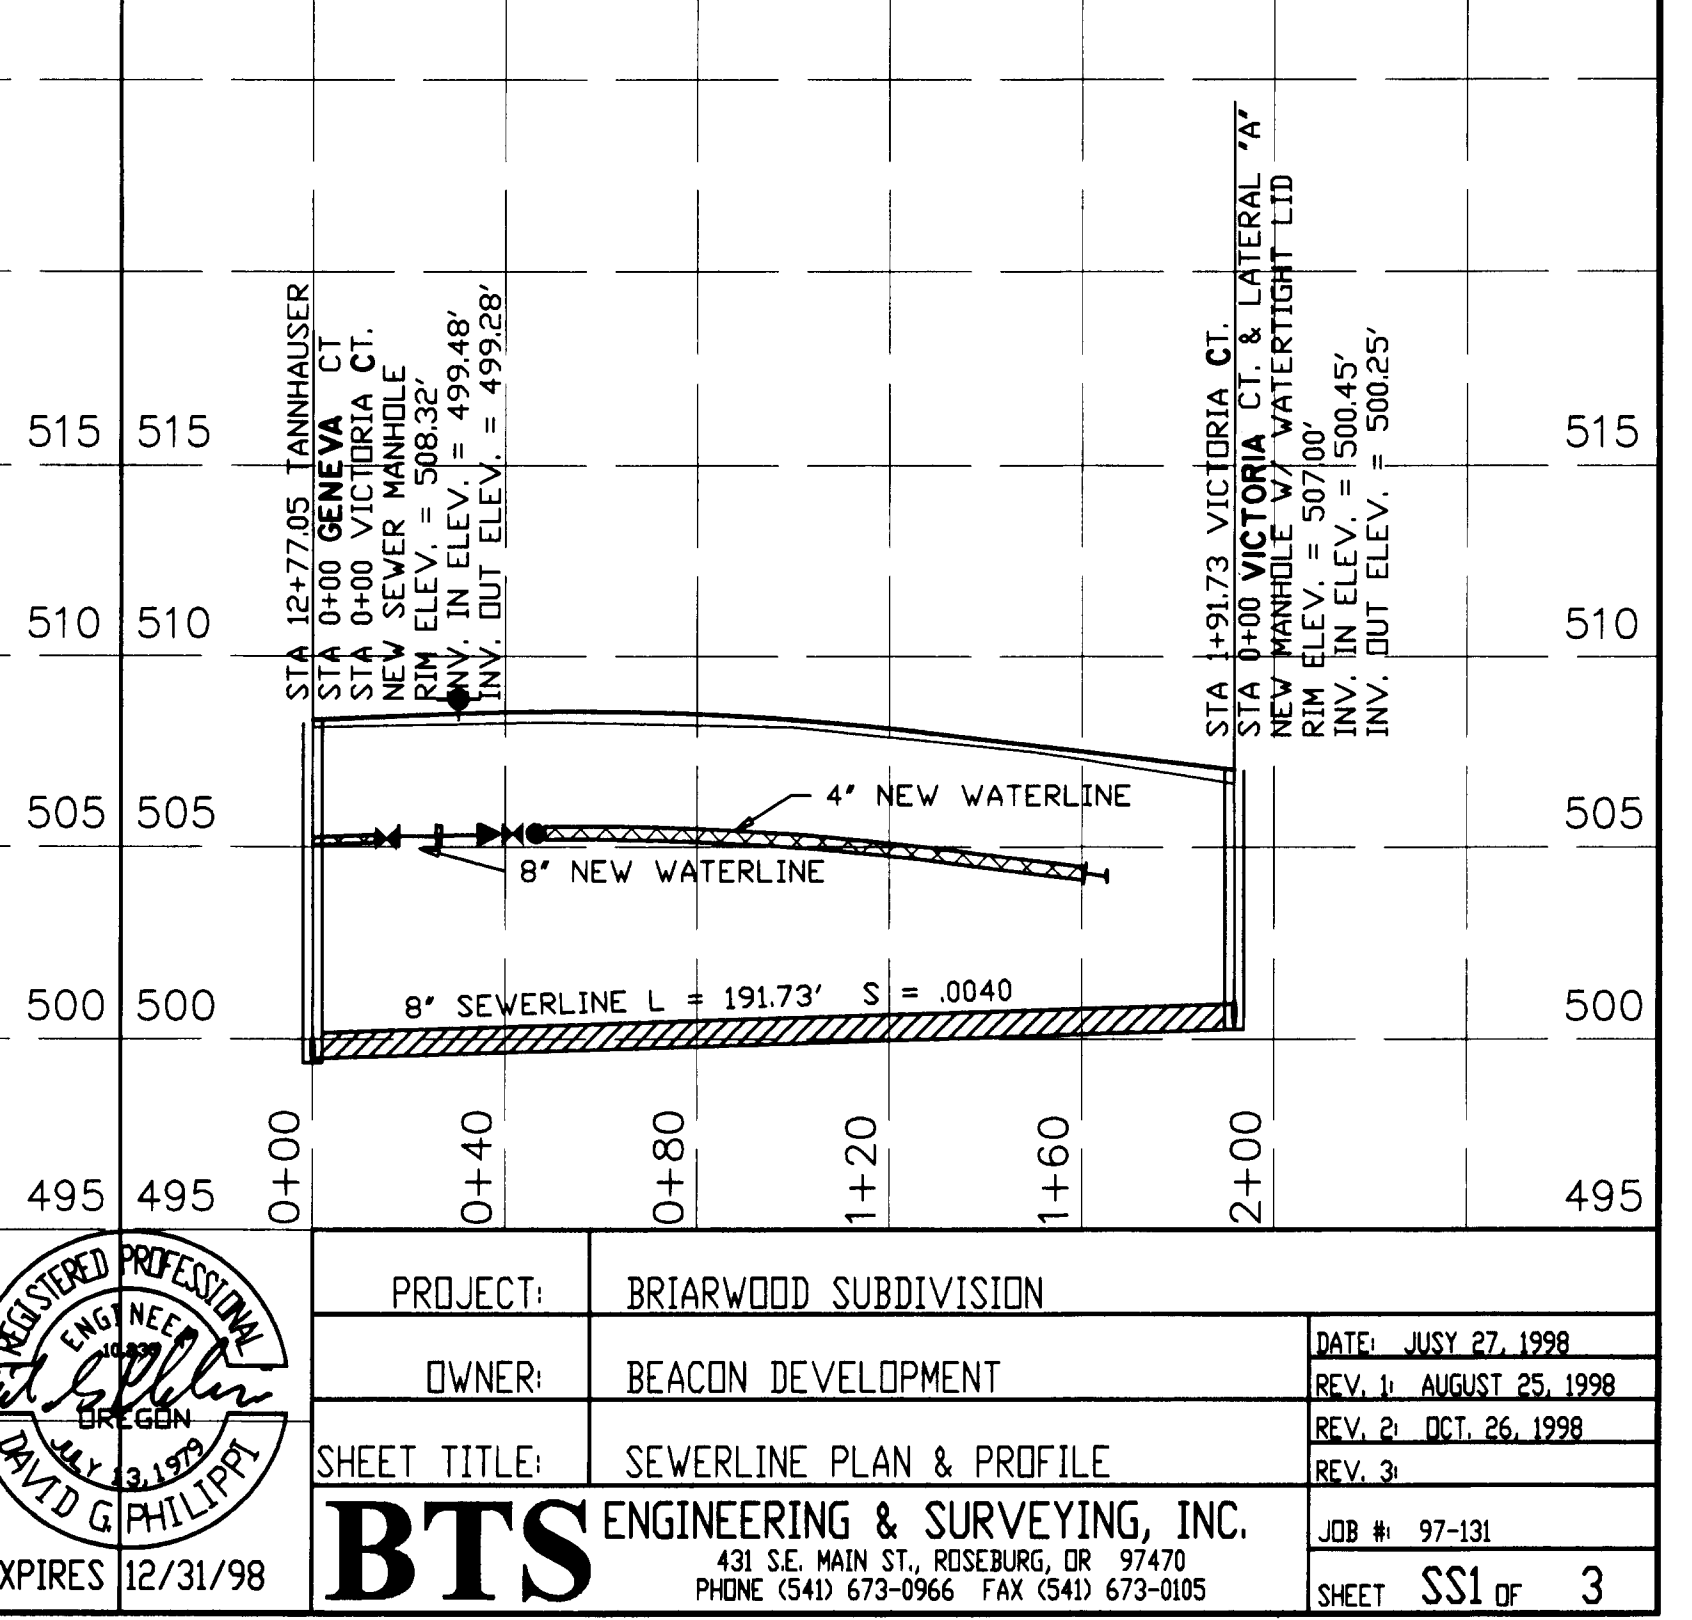

REGISTERED PROFESSIONAL ENGINEER
DAVID G. PHILLIPS
EXPIRES 12/31/98

PROJECT:	BRIARWOOD SUBDIVISION	DATE:	JULY 27, 1998
OWNER:	BEACON DEVELOPMENT	REV. 1:	AUGUST 25, 1998
SHEET TITLE:	SEWERLINE PLAN & PROFILE	REV. 2:	OCT. 26, 1998
BTS ENGINEERING & SURVEYING, INC.	431 S.E. MAIN ST., ROSEBURG, OR 97470	REV. 3:	
PHONE (541) 673-0966 FAX (541) 673-0105		JOB #:	97-131
		SHEET:	SS1 OF 3

381SEWR1